


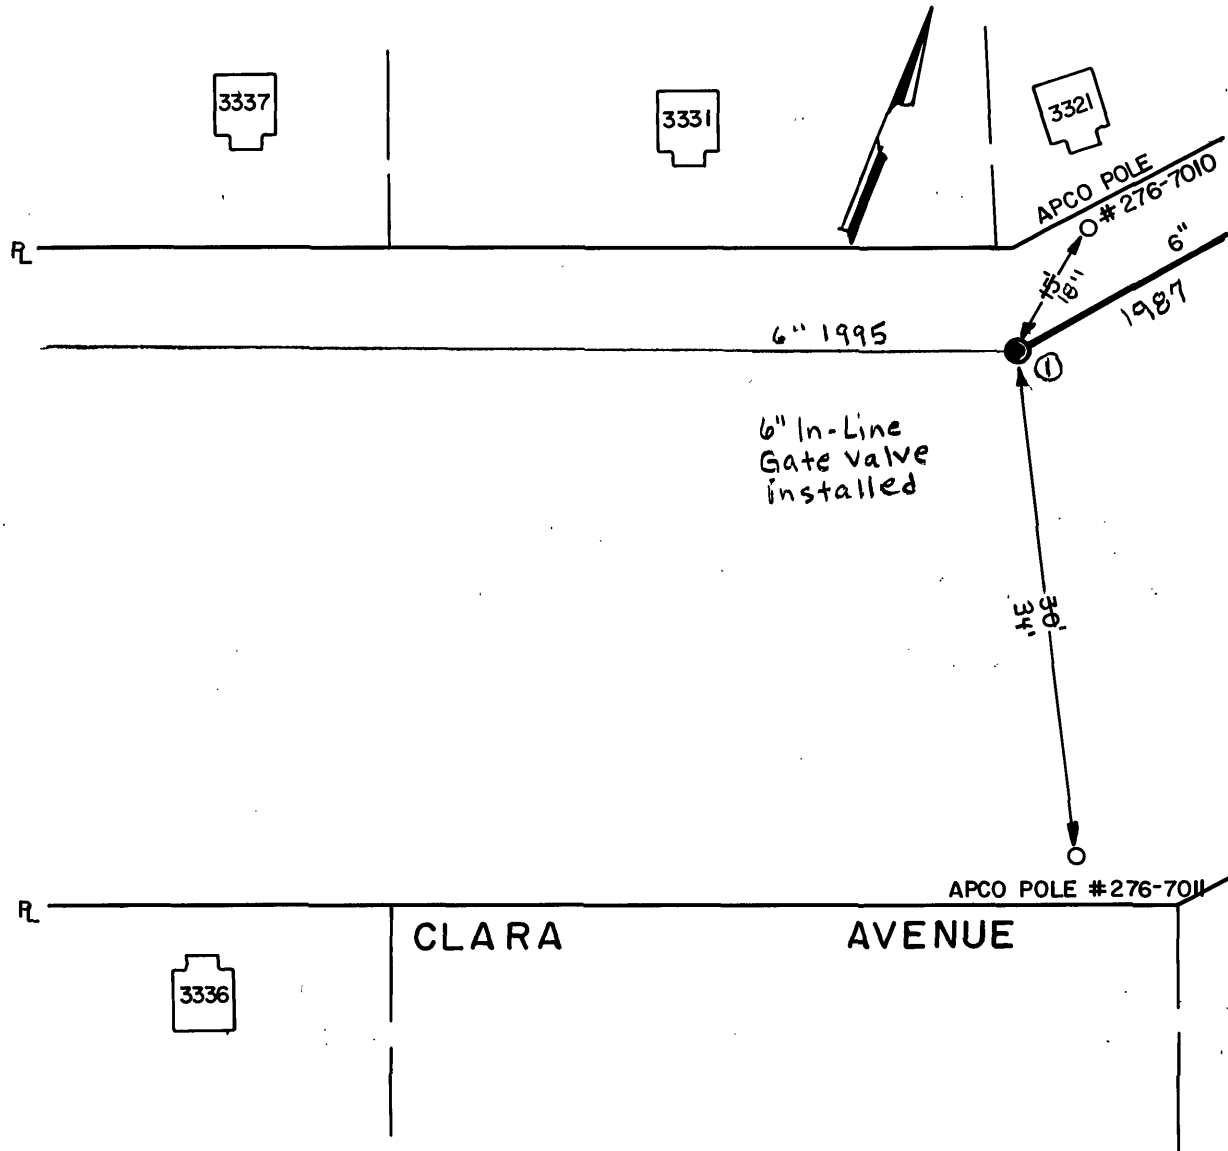

DATE	NO.	SIZE	MAKE	OPEN	TURNS
1987	1	2"	BLOW-OFF	R	
1995	1	6"		R	27

CITY OF ROANOKE - WATER DEP'T.	
VALVE DIAGRAM	
CLARA AVENUE	
SEC. MAP 505	S.W.
DATE:	PAGE NO.