

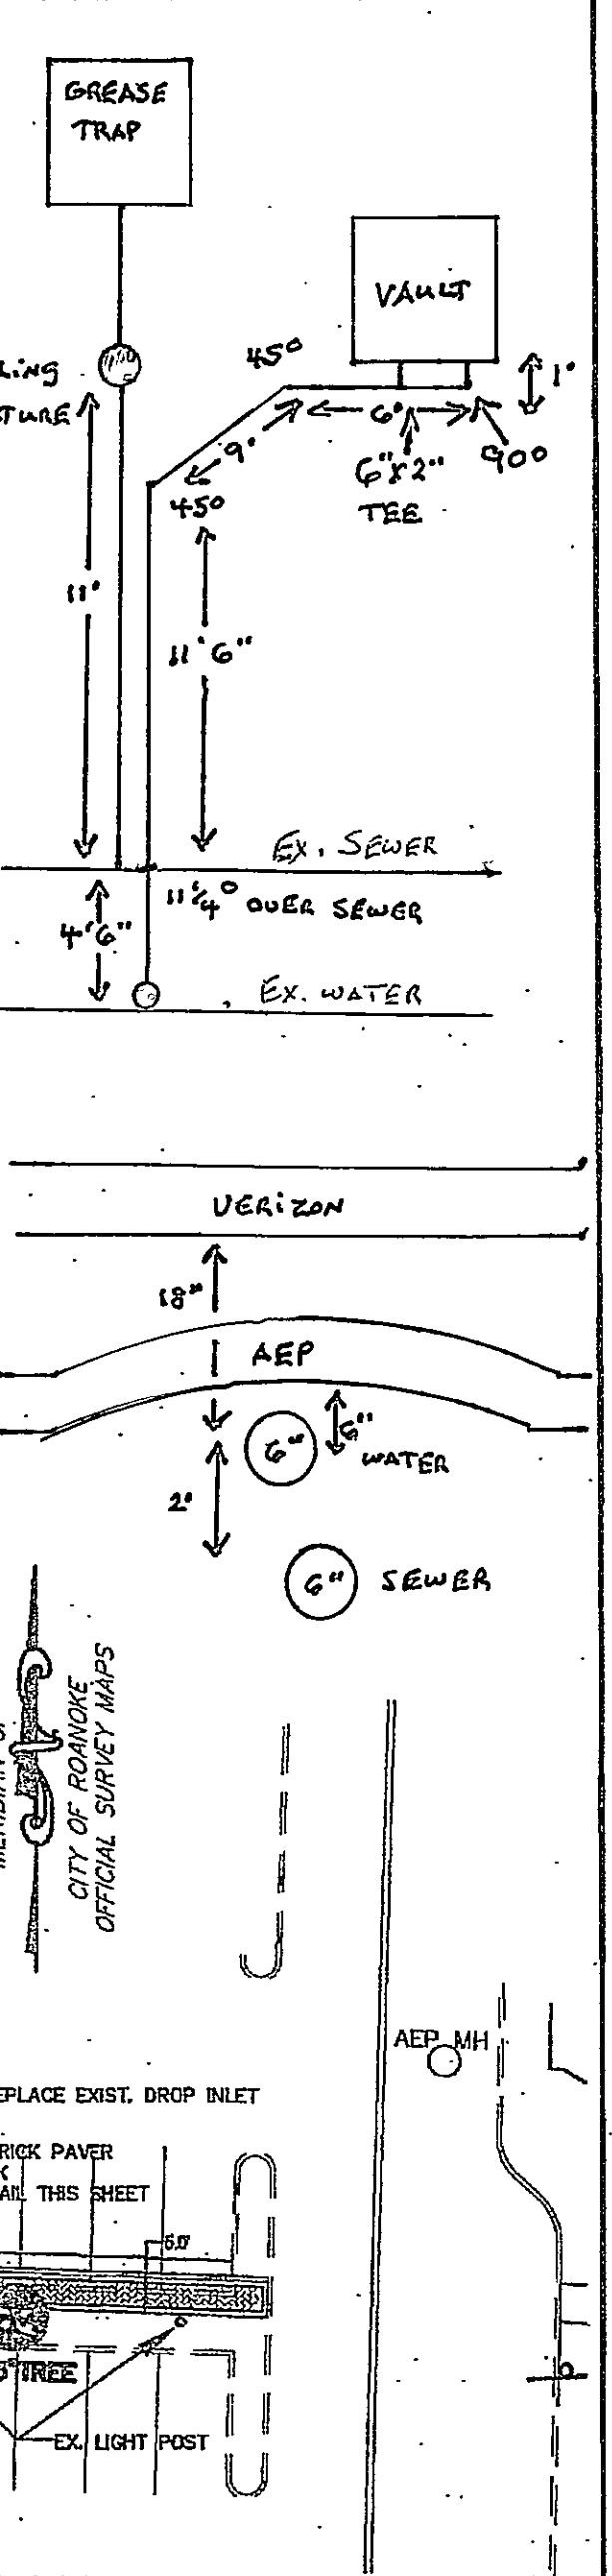
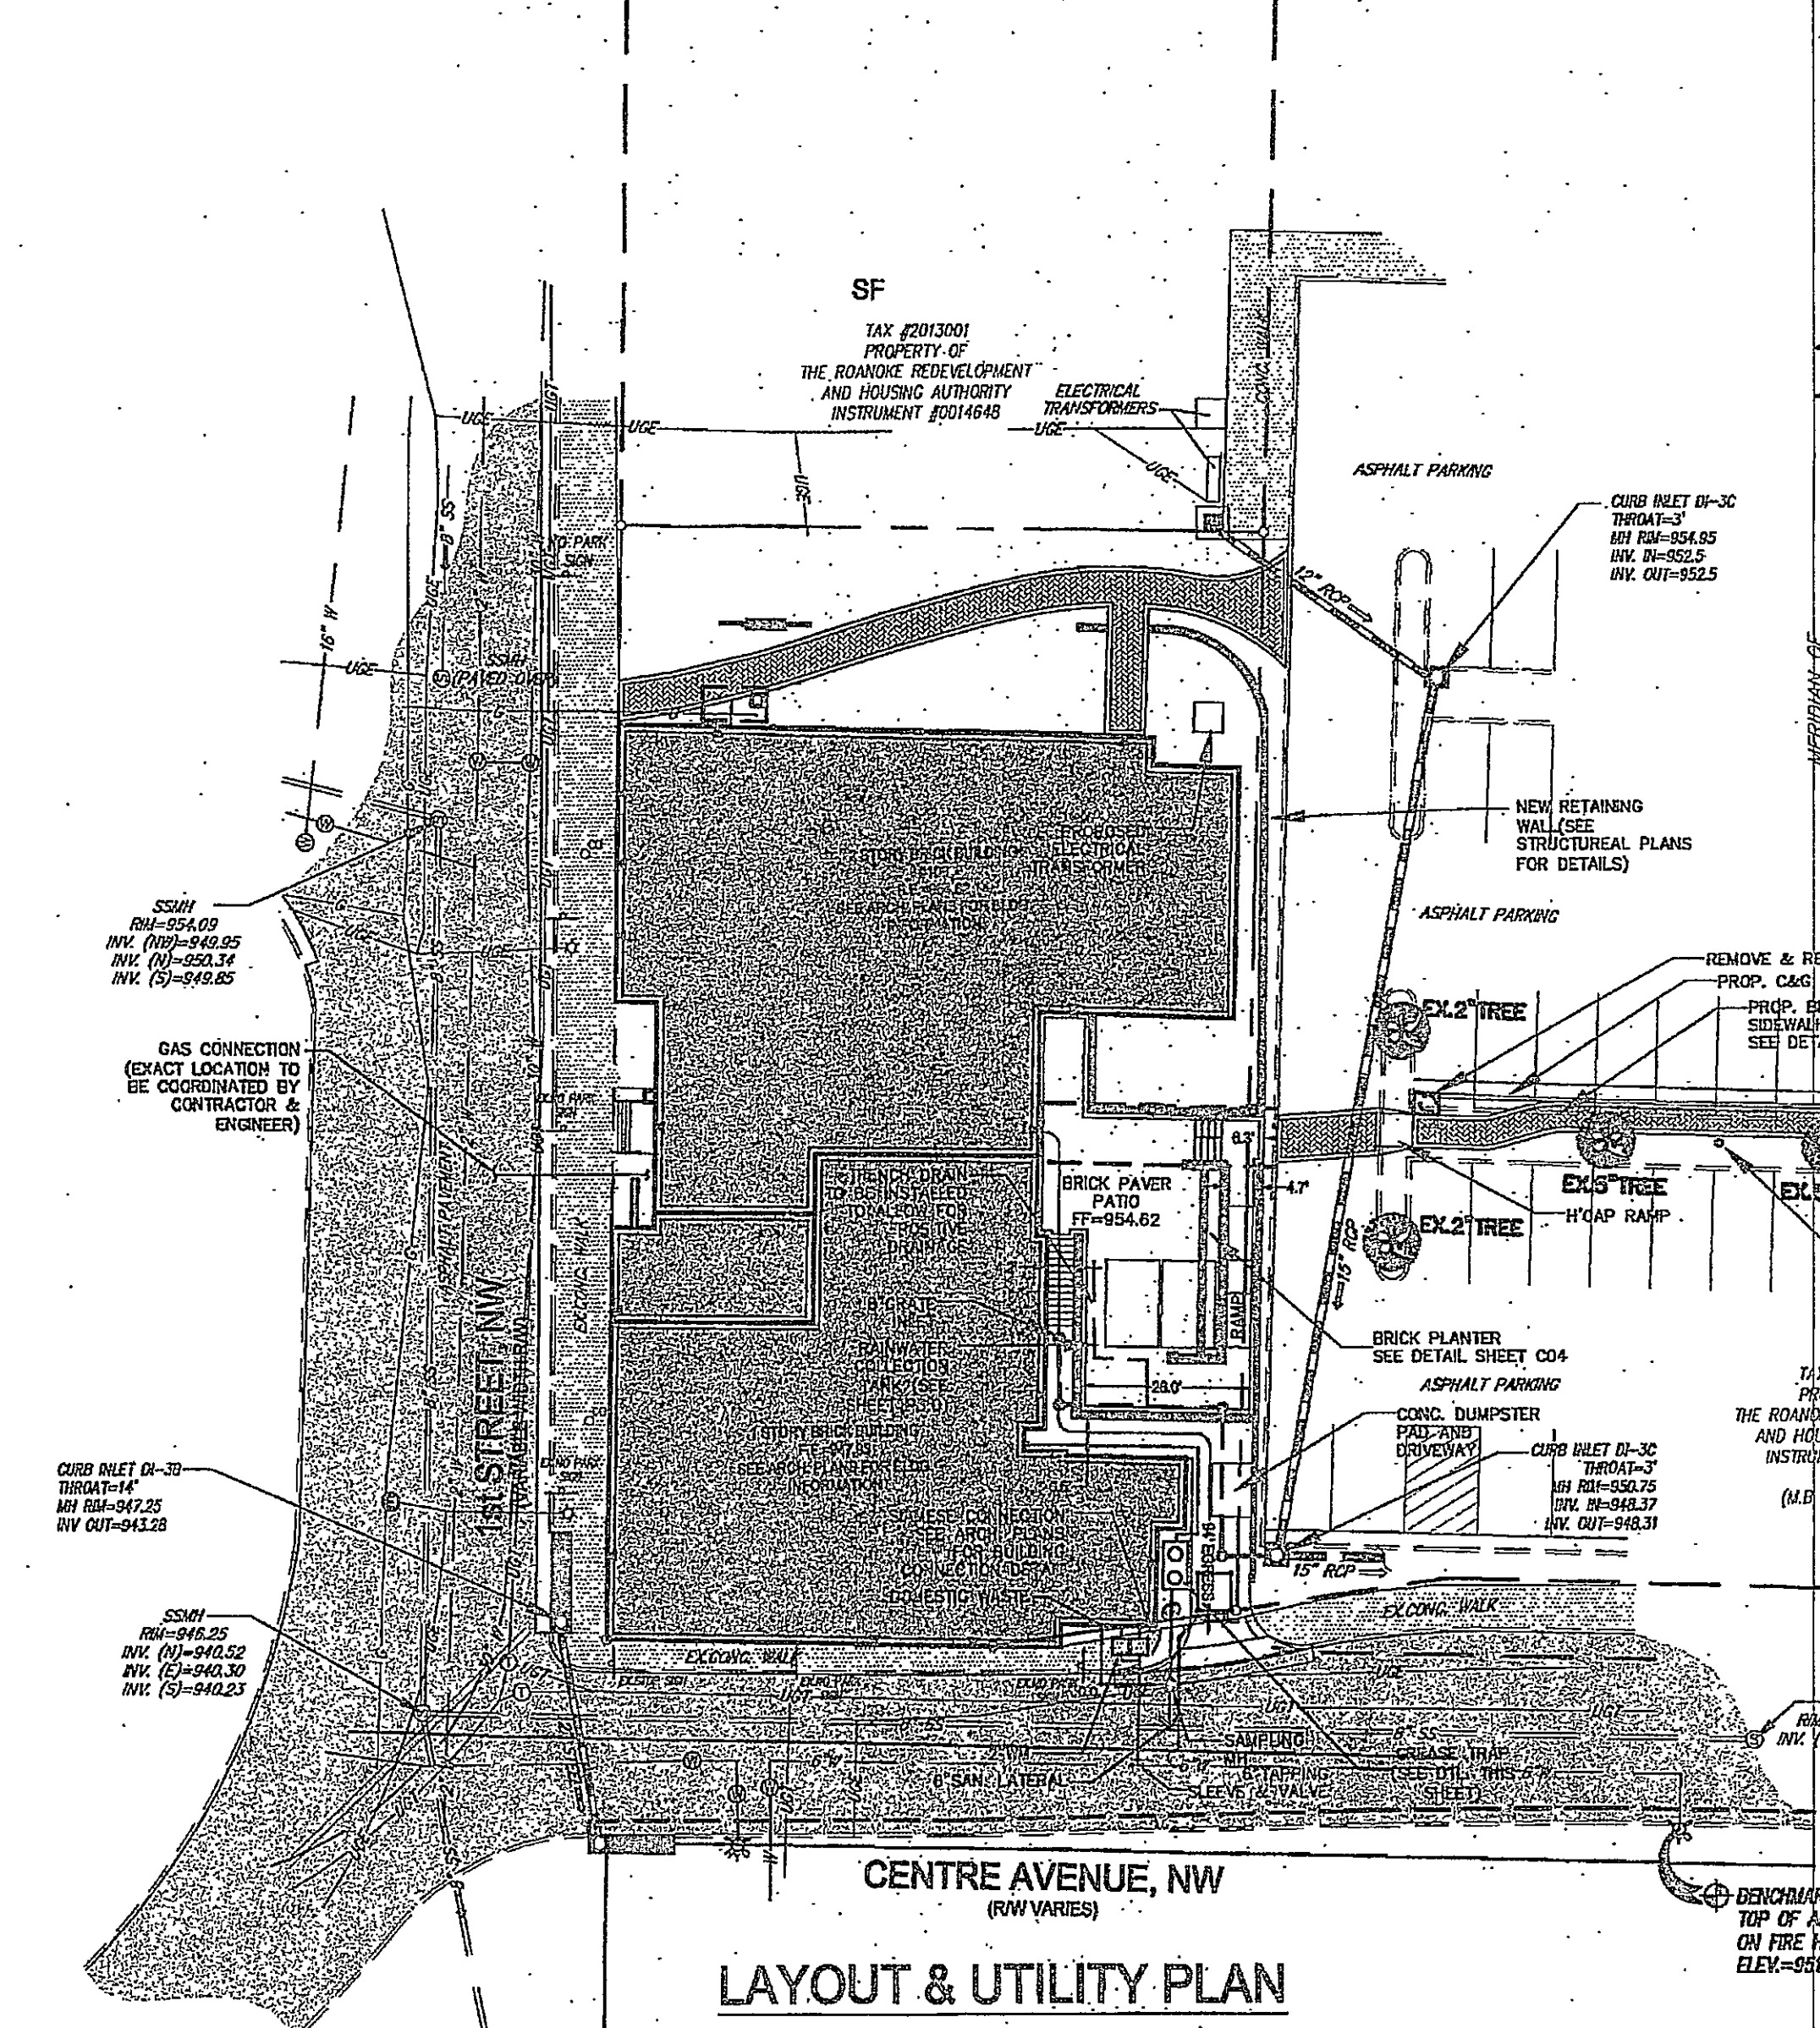
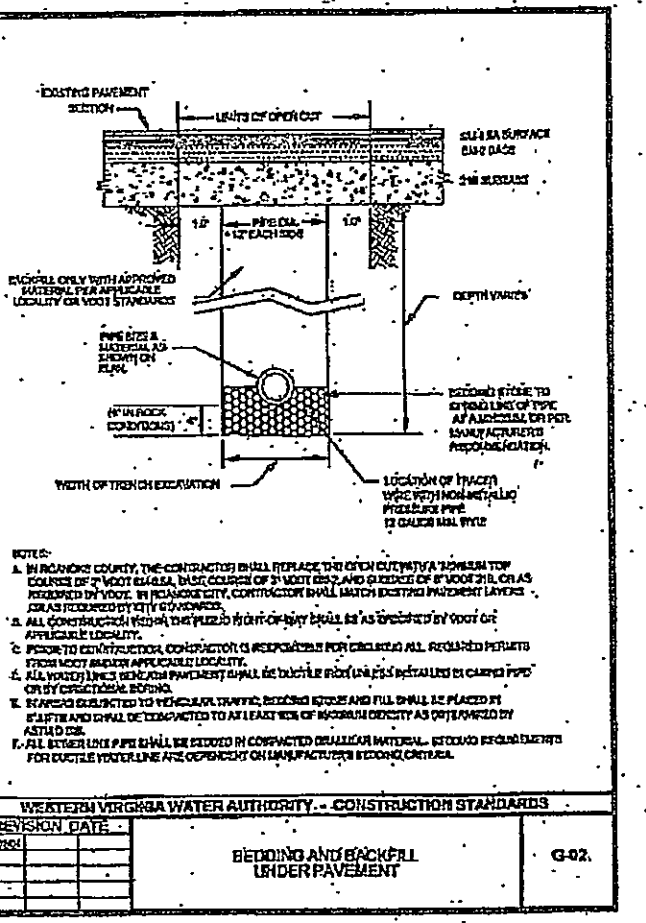
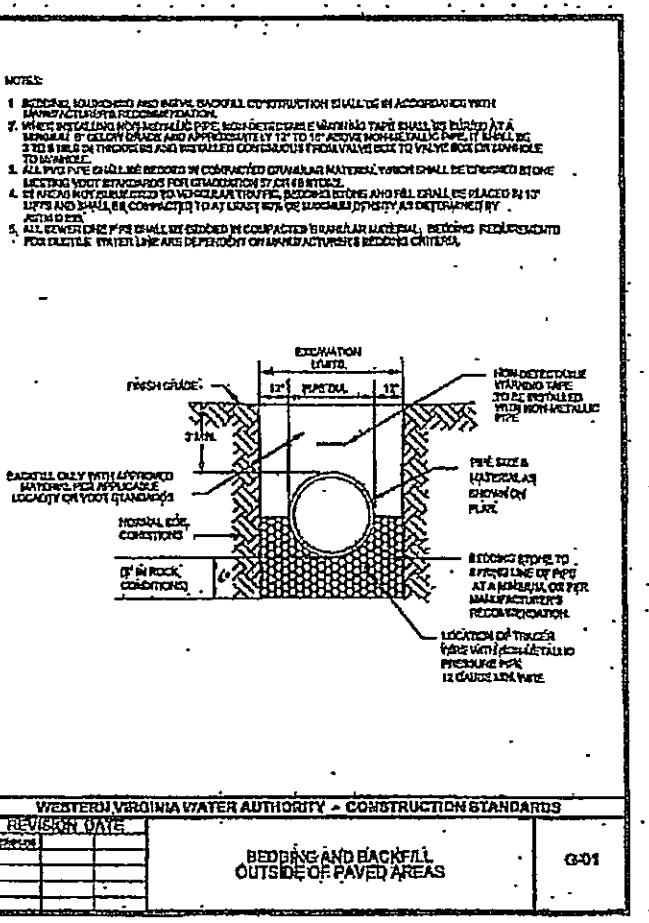
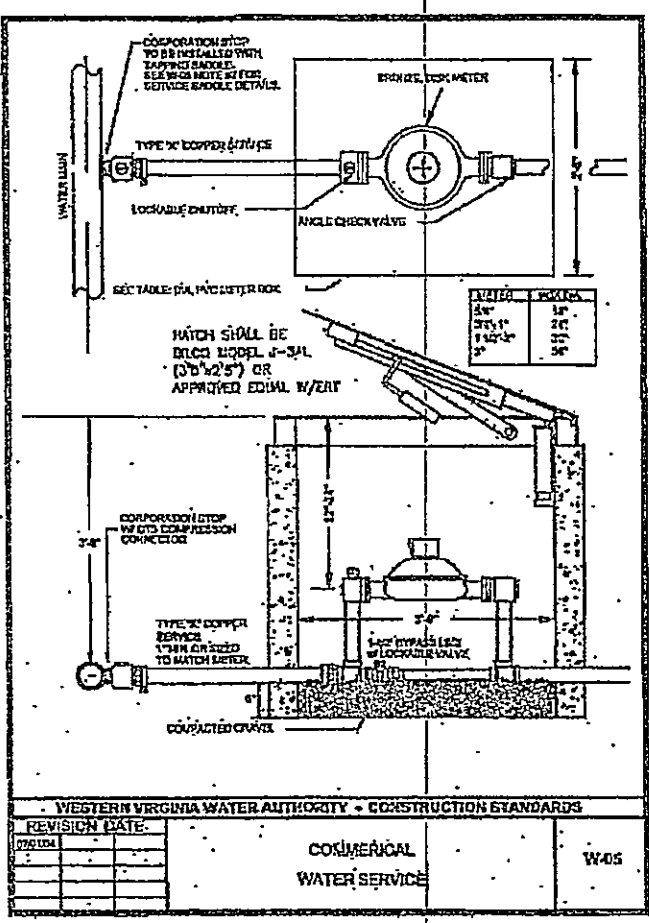
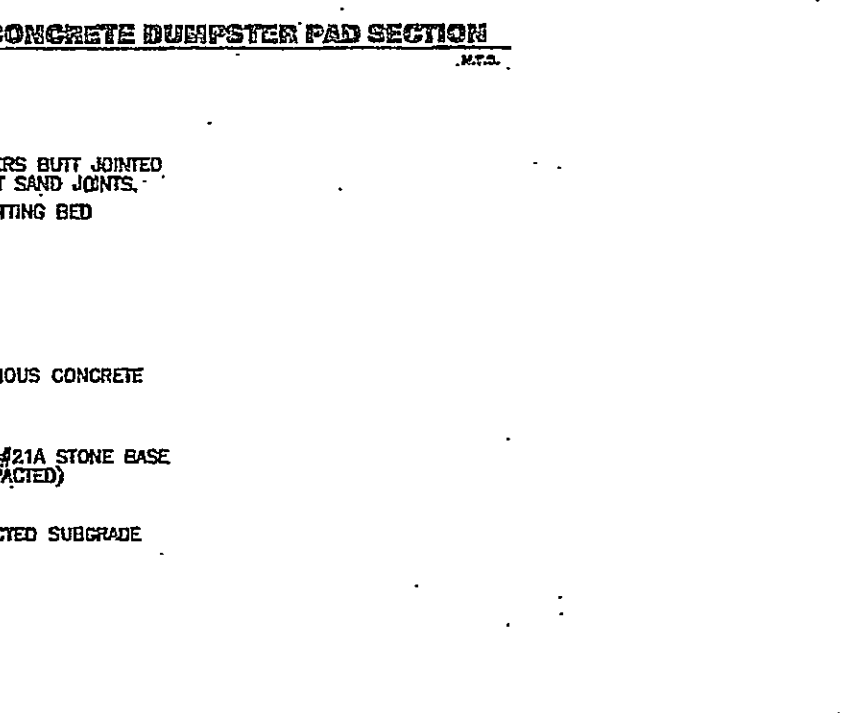
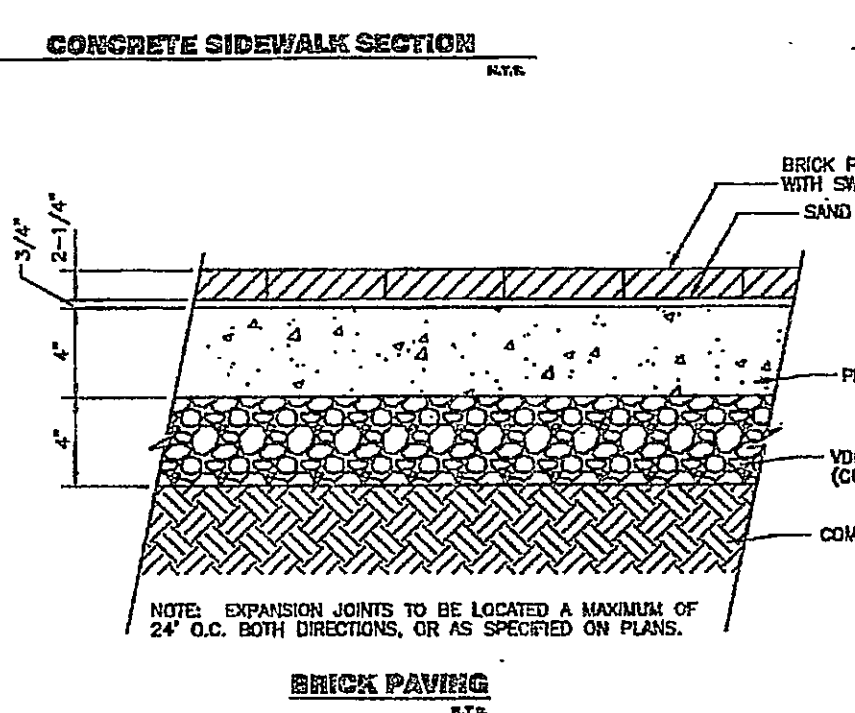
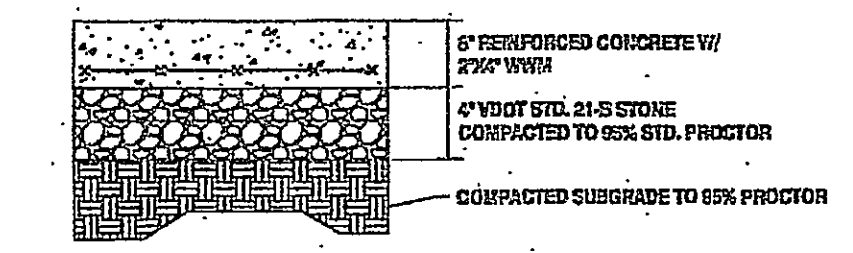
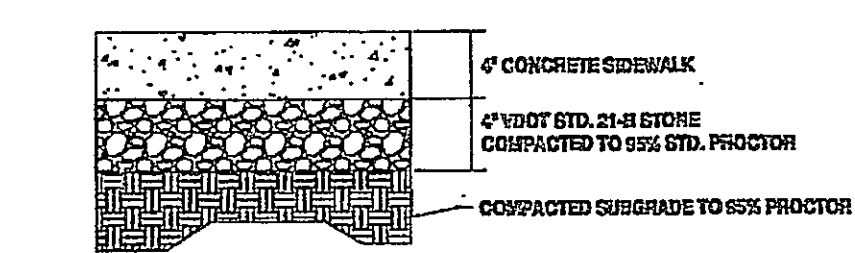
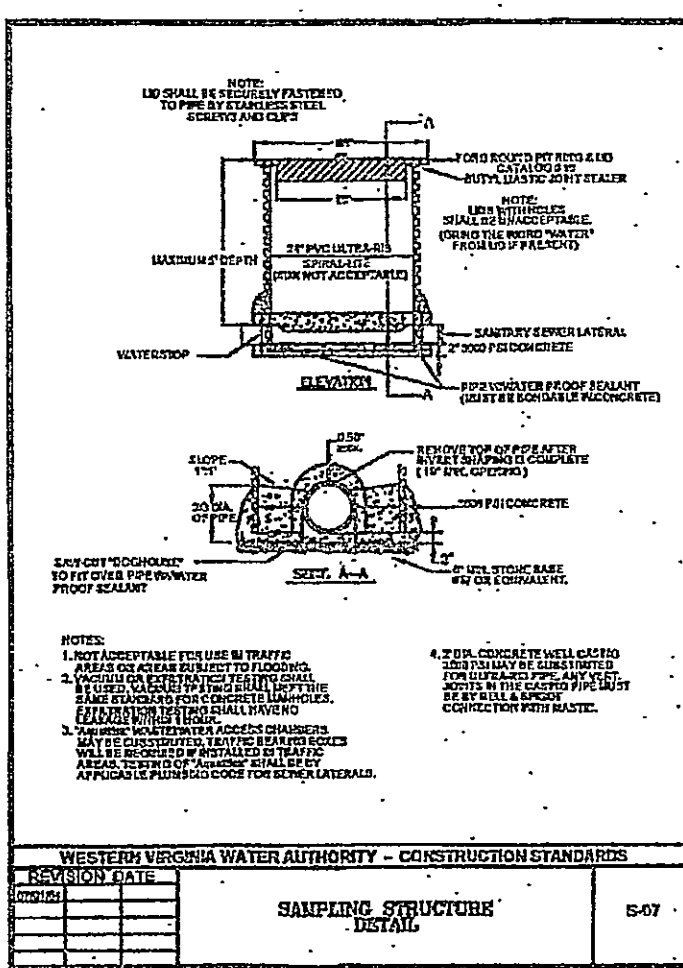
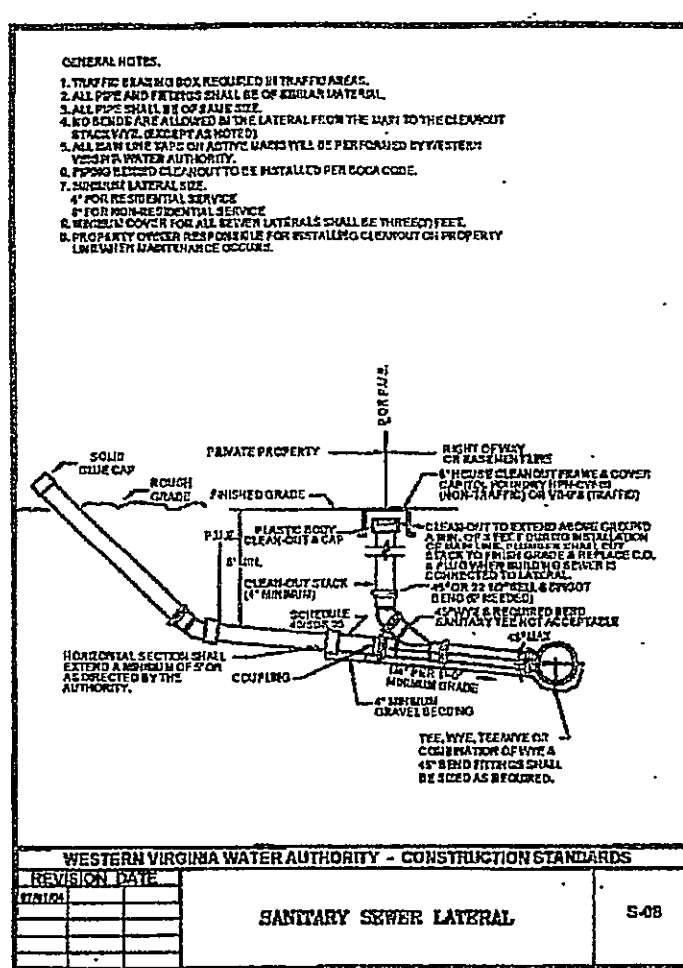


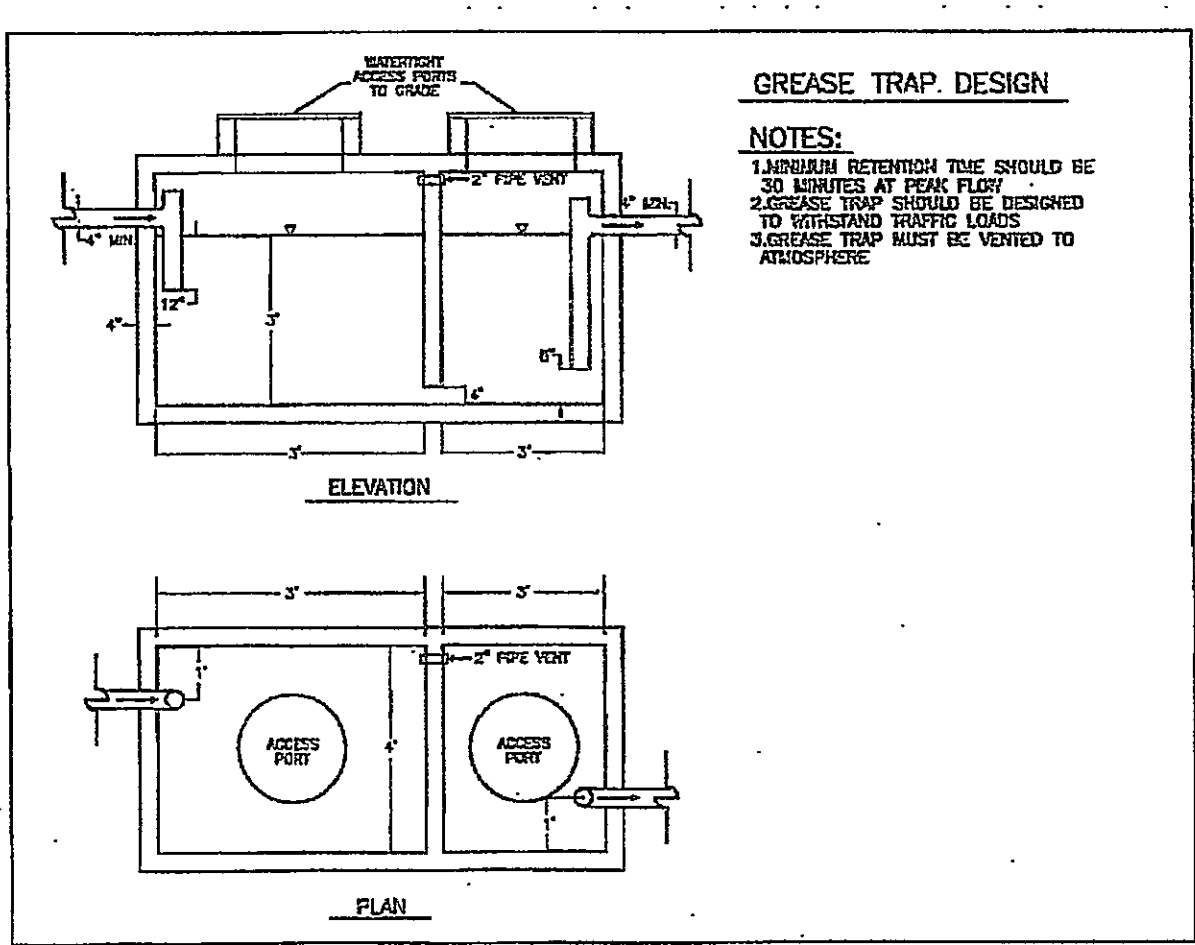

* All Bends ARE
 Mega Lug

as BUILT 8-28-07
 H.O.R.

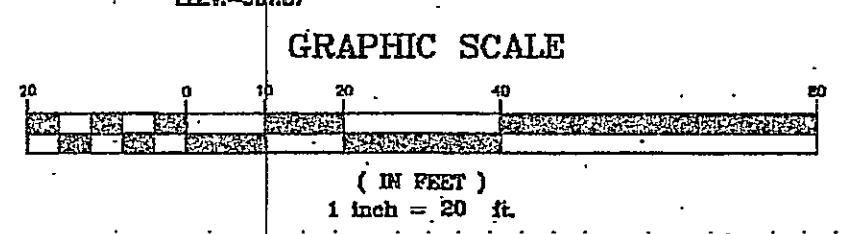

SmithLewis
 ARCHITECTURE

18 W. Kirt Avenue SW
 Roanoke, VA 24011
 540 343 6500
 540 343 2003

STANGL
 ENGINEERING

300 W Main Street, Suite 302
 Charlottesville, VA 22903
 434 298 6105
 434 298 6557

MANN & ASSOCIATES, INC.

300 Market Street
 Roanoke, Virginia 24011
 Voice: 540 344 5511
 Fax: 540 344 0235

PARKER DESIGN GROUP, PC
 ENGINEERS ARCHITECTS SURVEYORS

816 Boulevard
 Salem, Virginia 24153
 Phone: 540 387 1153
 Fax: 540 389 5767

RMS
 RMS ENGINEERING LLC

1200 West Riverdale Drive
 Salem, Virginia 24153
 (540) 376 6700 (fax)
 (540) 376 6700 (cell)

DAY & KINDER
 CONSULTING
 ENGINEERS, PLLC

P.O. BOX 26087
 3239 ELECTRIC ROAD, BUILDING C
 ROANOKE, VIRGINIA 24018
 PHONE: 540 774 5706
 FAX: 540 772 3366
 COMM. NO. 05 062

SEAL OF THE
 COMMONWEALTH OF VIRGINIA
 CLAUDE MOORE, JR.
 No. 000855
 5/1/06
 c:\grogen\sparker\4.com

FINAL CONSTRUCTION
 DOCUMENTS

Claude Moore
 Education Complex
 First Street
 Roanoke, VA 24011

LAYOUT & UTILITY
 PLAN

PROJECT NUMBER: 051011
 ISSUED: 05-17-05
 DRAWN BY: JCG
 CHECKED BY: GL
 FILENAME: DG PR: 505092-0

C03