



Vertical Curve Data for Crescent Ridge Road, SW

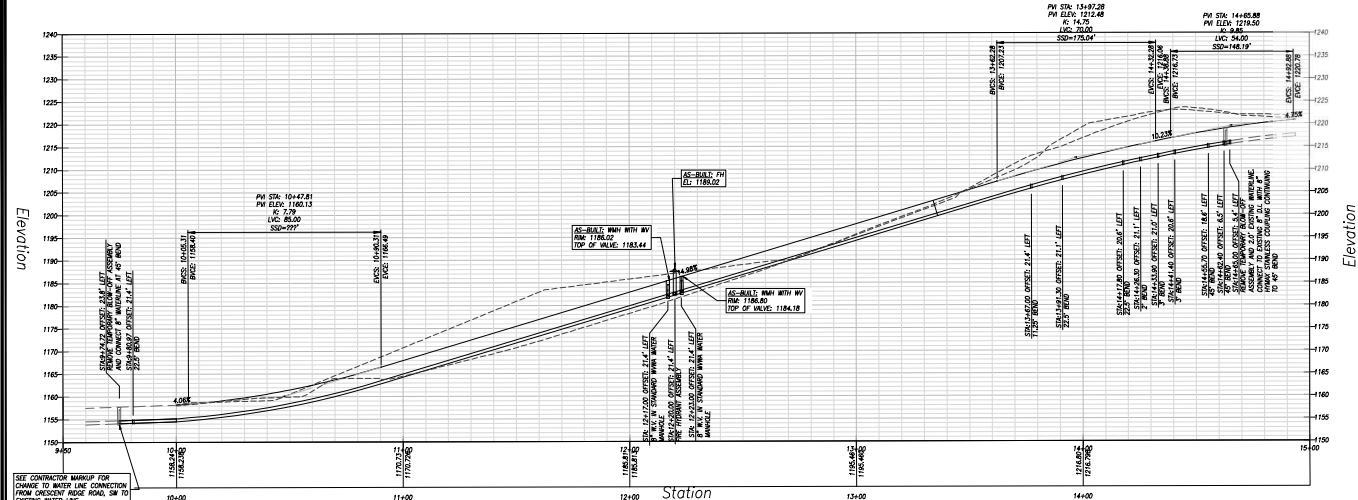

ROAD & WATERLINE PROFILE
CRESCENT RIDGE ROAD, SW
SCALE: H=1"=20'
V=1"=10'

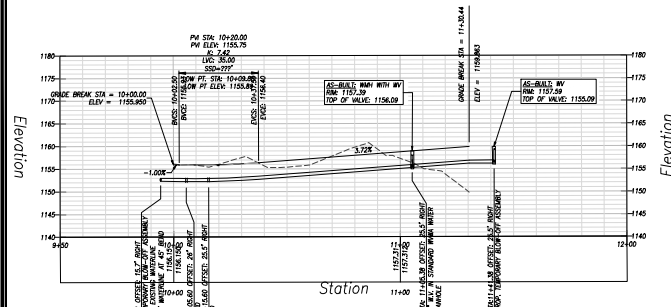

ROAD PROFILE & WATERLINE
GREENWAY DRIVE EXTENSION
SCALE: H=1"=20'
V=1"=10'

AS-BUILT



No.	Description	Date

COLONIAL GREEN
CITY OF ROANOKE - VIRGINIA
ROAD & WATER
PROFILES AS-BUILT

GRAPHIC SCALE
PROJECT: 21019
C-000