
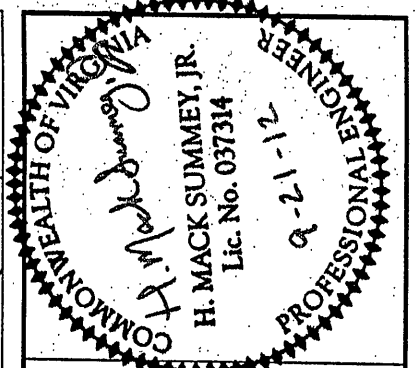
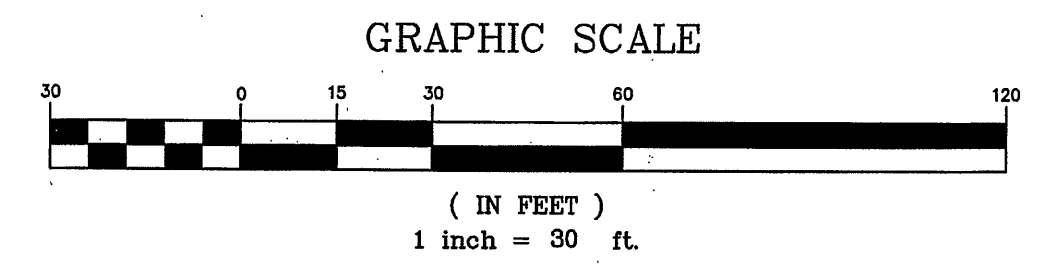
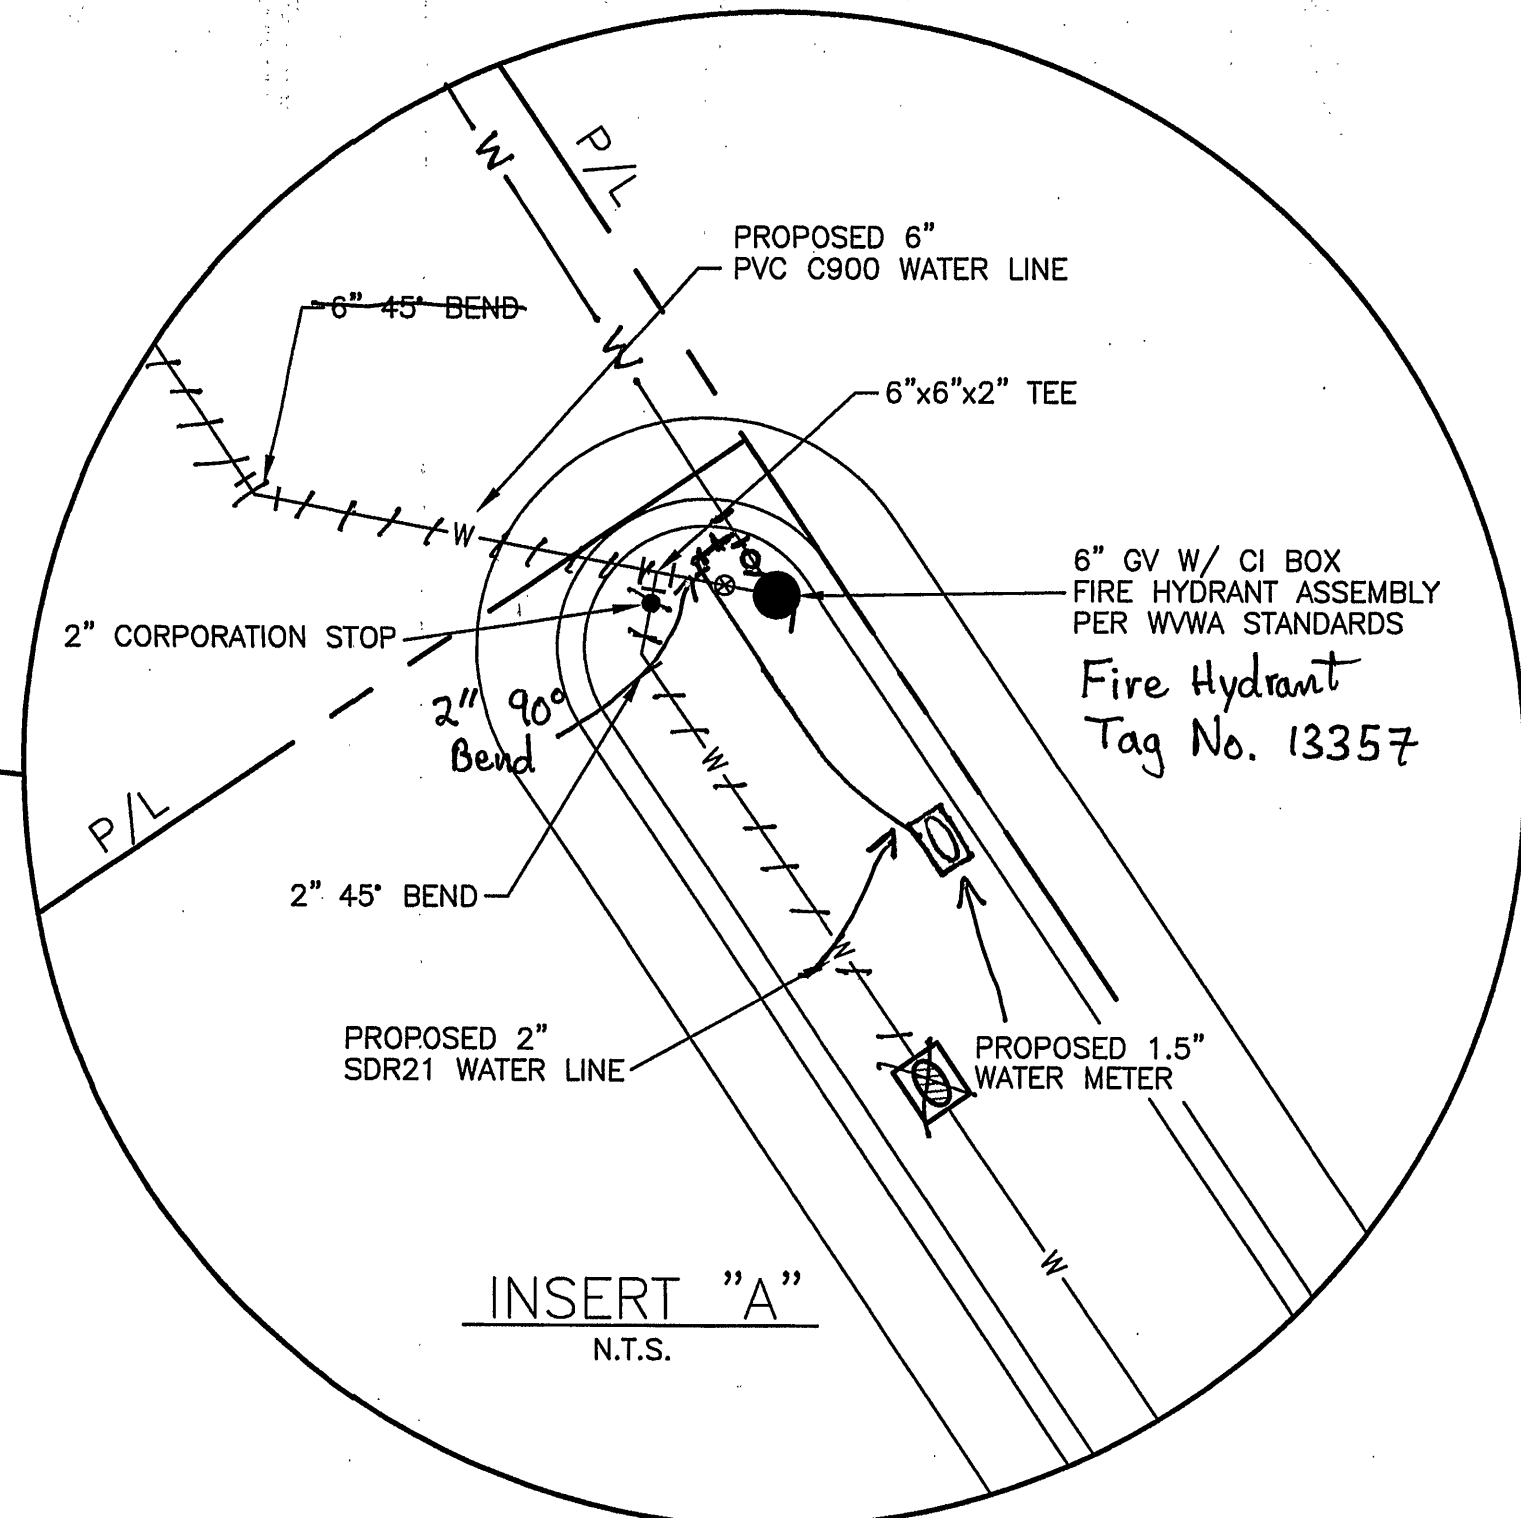


**WATER LINE NOTE**  
 FIRE HYDRANT & WATER LINE MUST BE FIELD LOCATED & VERIFIED PRIOR TO CONSTRUCTION. THE WWA RESERVES THE RIGHT TO FIELD ADJUST CONNECTIONS AS FIELD CONDITIONS WARRANT.

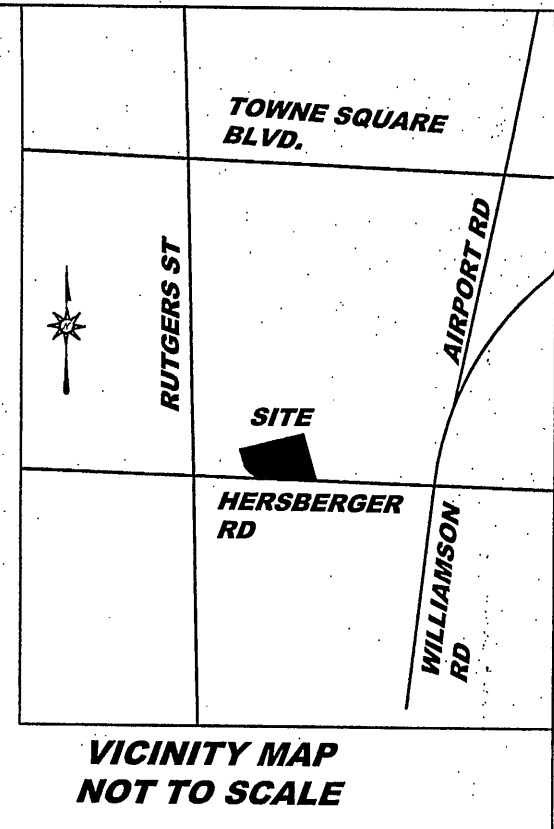

**Summey Engineering Associates, PLLC**  
 Engineering - Land Planning - Consulting  
 PO Box 968  
 Asheville, NC 27204  
 Phone: 336-328-0902 Fax: 336-328-0922  
 Email: mac@seabro.com

| Date     | Description          | By  |
|----------|----------------------|-----|
| 08.20.12 | REVISED WWA COMMENTS | JOP |

**WATER CONNECTION PLAN**  
**COOKOUT RESTAURANT**  
 1423 HERSHBERGER ROAD, N W  
 ROANOKE, VIRGINIA

|             |             |
|-------------|-------------|
| Scale:      | NOTED       |
| Date:       | APRIL, 2012 |
| Drawn By:   | NK          |
| Checked By: | HMSJ        |
| Job No.:    | E-2262      |

APPROVED  
 SEP 24 ZWJ

Sheet No.  
**C-3B**  
 3 of 11

As-Built 12.21.12 K. Winslow