
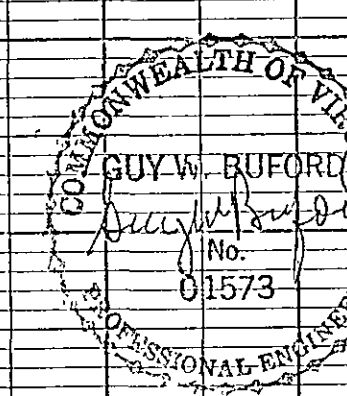
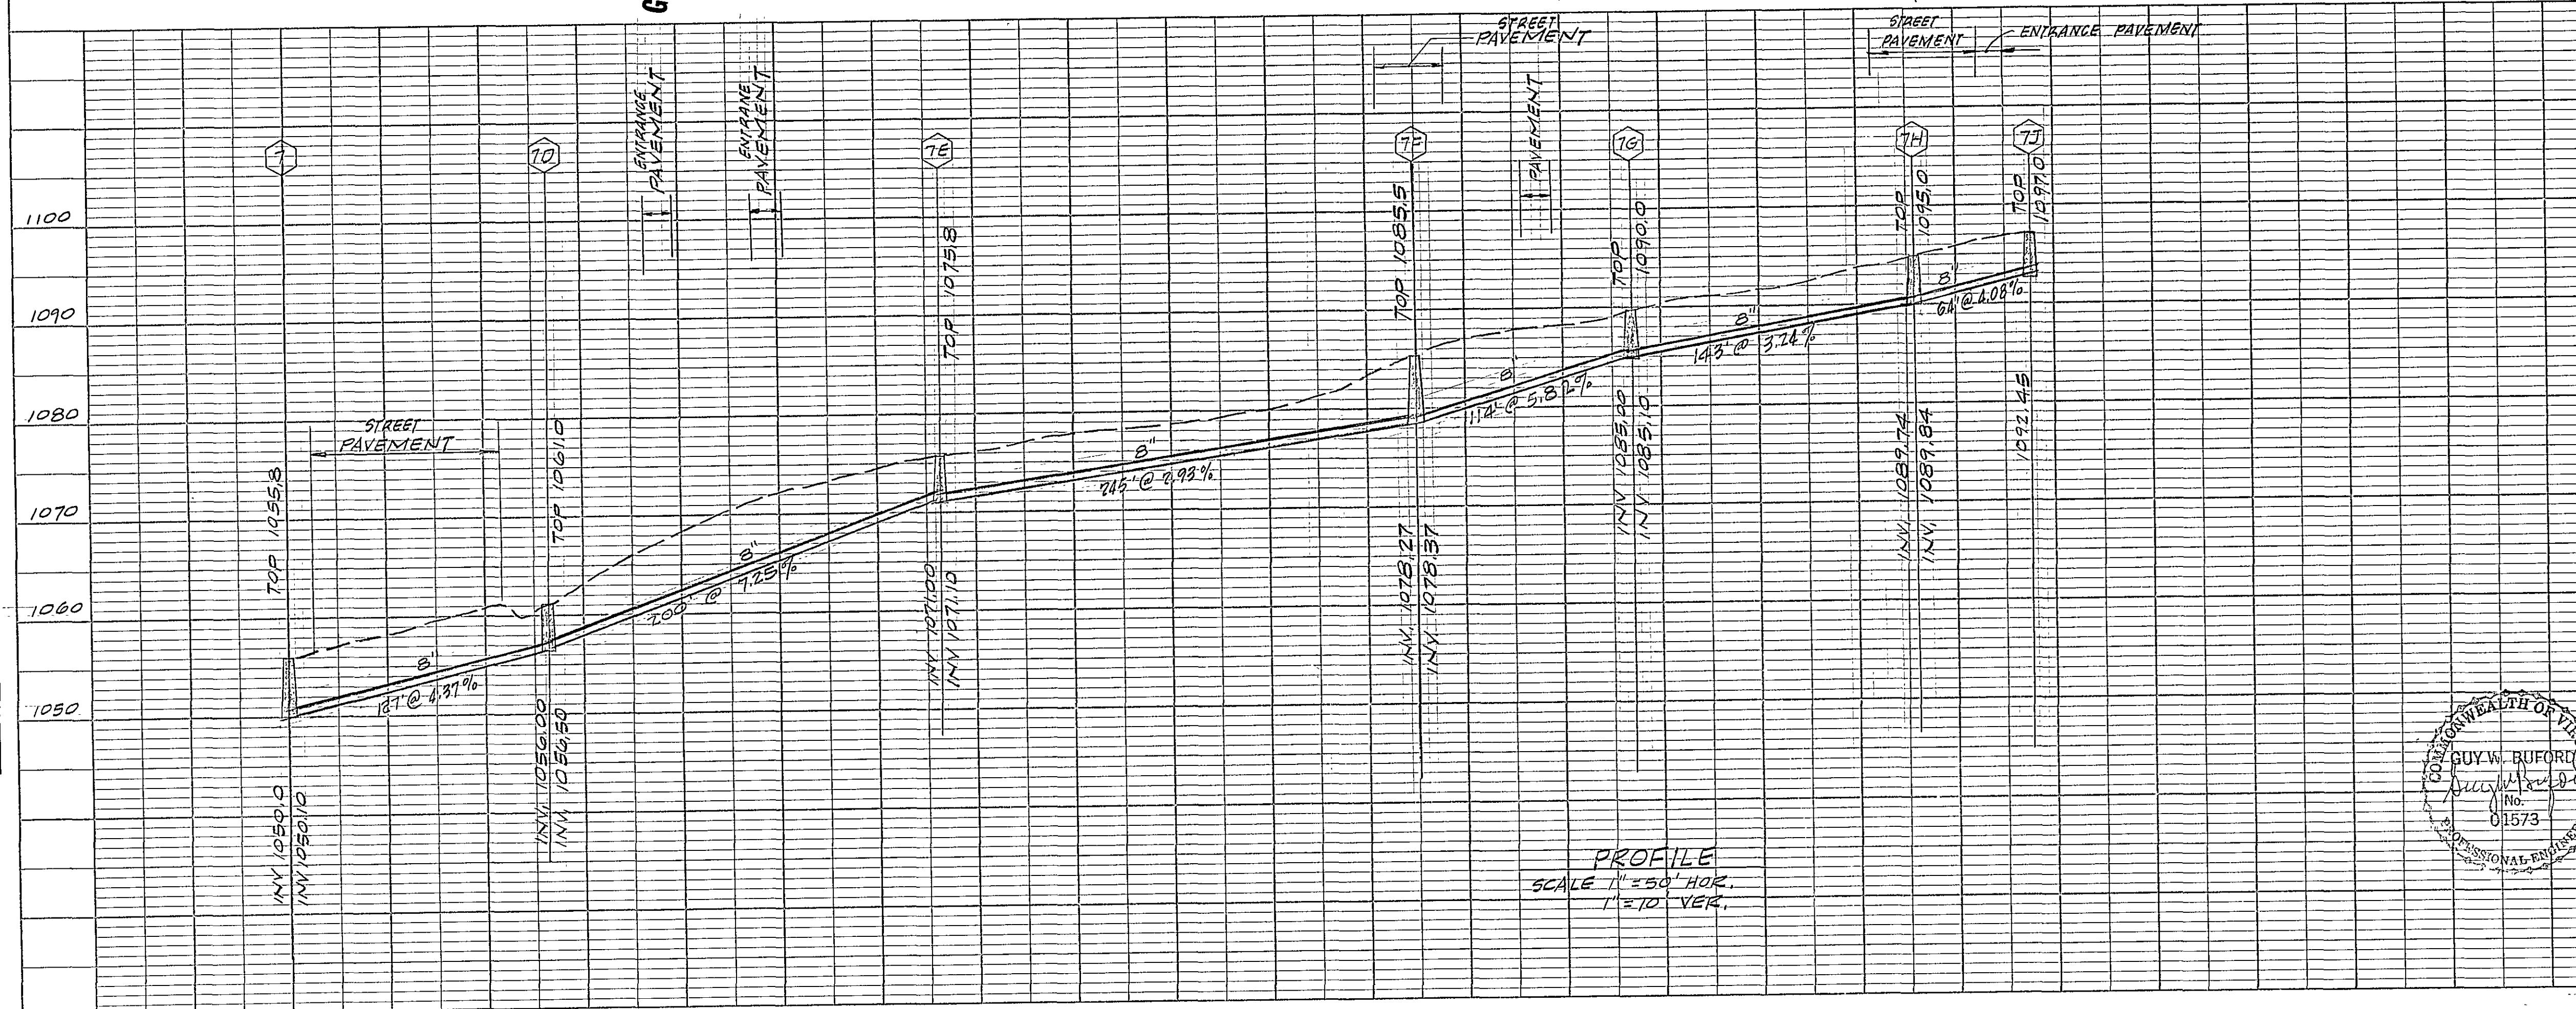
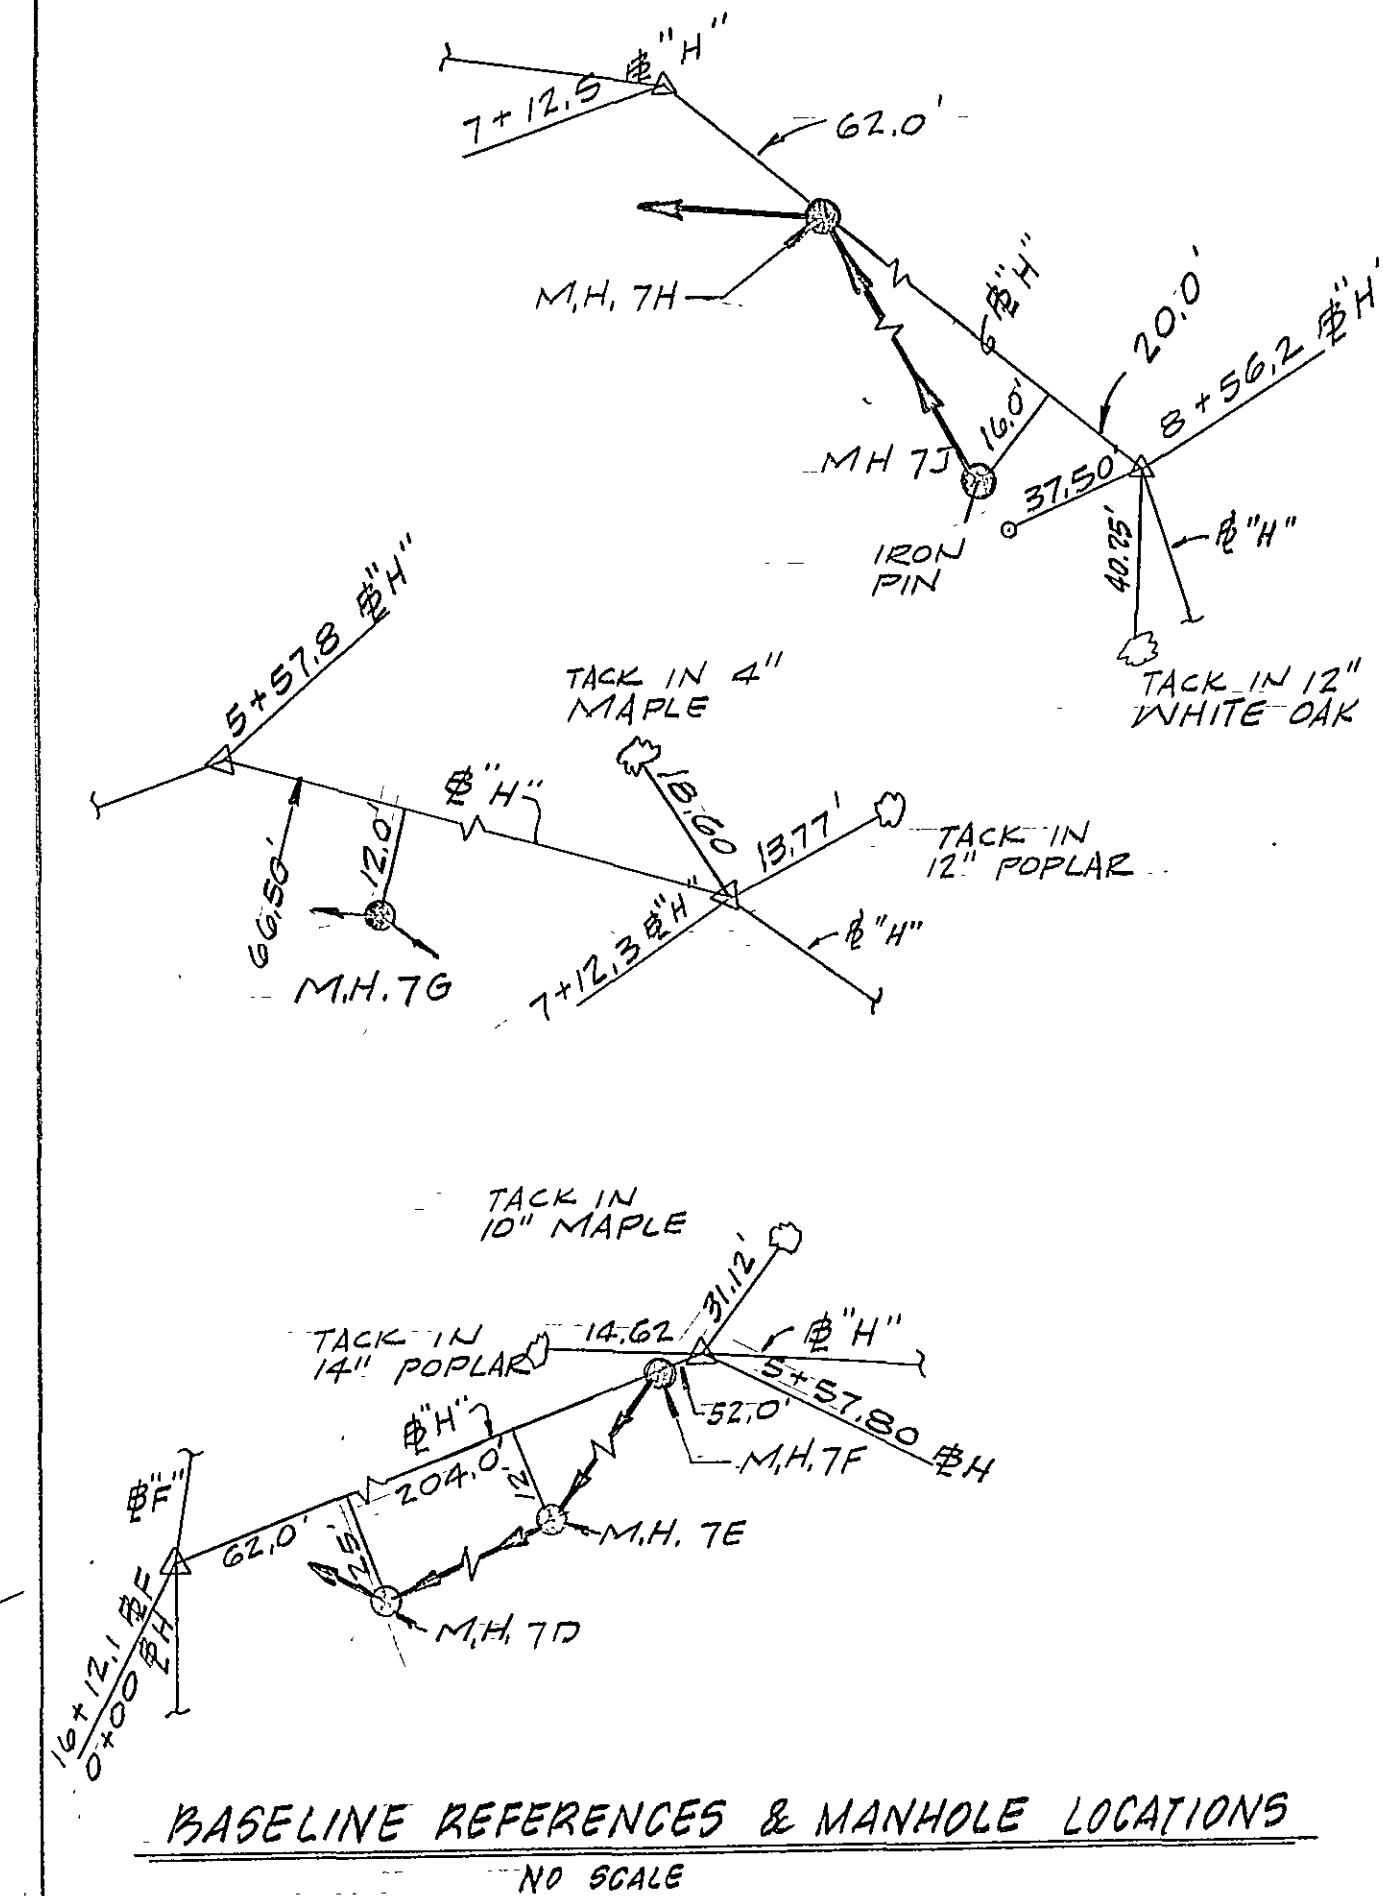


PLAN	DATE
SURVEYED	
NOTE BOOK	
ALIGNED CHECKED	
RT OF WAY CHECKED	
NO	

PROFILE	DATE
SURVEYED	
NOTE BOOK	
GRADES CHECKED	
STRUCTURE NOTING CH'D.	
NO	

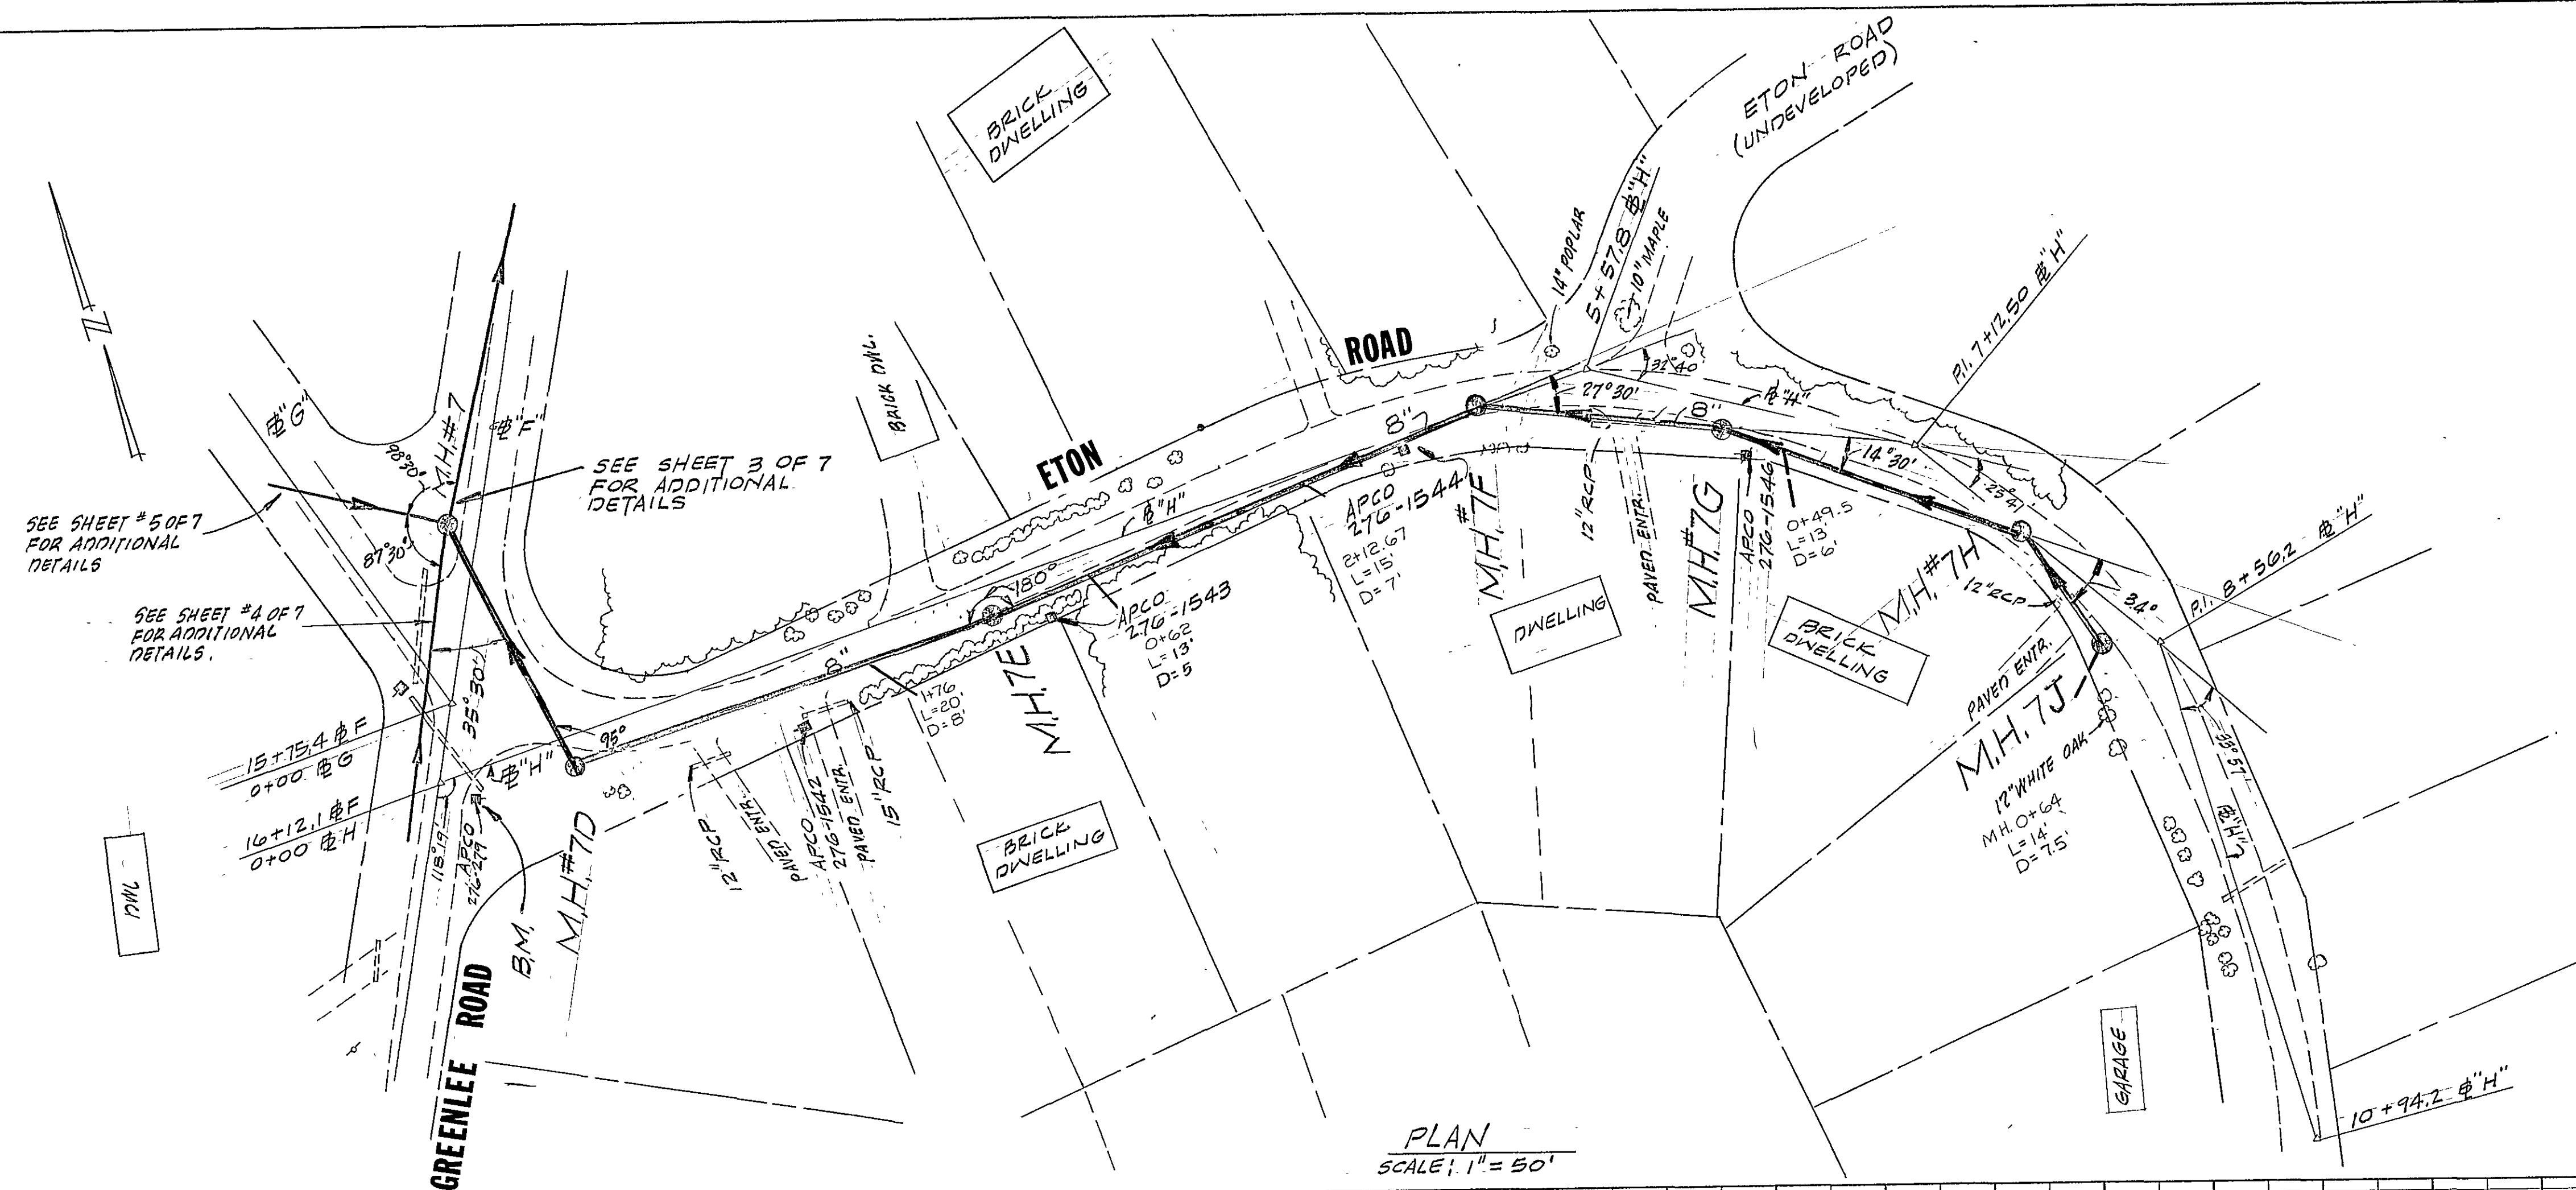

BENCHMARK: RR, NAIL IN APCO POLE
270-279, 17.5 FT. LEFT
STATION 10+16.8
ELEV. 1060.39

AS BUILT

CRAVENS-BARNHART
SEWAGE COLLECTION SYSTEM

PROJECT II
LINE H

CITY OF ROANOKE, VIRGINIA

SCALE: AS NOTED DATE: 17 OCTOBER

BUFORD T. LUMSDEN & ASSOCIATES, P.C.
CERTIFIED LAND SURVEYORS
ROANOKE, VIRGINIA

PLAN NO. 5699 SHEET 6 OF 7