


NOTES


1. OWNER OF RECORD: FRALIN & WALDRON, INC.
2. LEGAL REFERENCES: INST.#180003101
3. TAX MAP NUMBERS: 88(10)3
4. THIS SURVEY WAS PERFORMED WITHOUT THE BENEFIT OF A TITLE REPORT AND IS SUBJECT TO INFORMATION WHICH MAY BE DISCLOSED BY SUCH.
5. PROPERTY IS IN F.E.M.A. DEFINED X-UNSHADED ZONE.

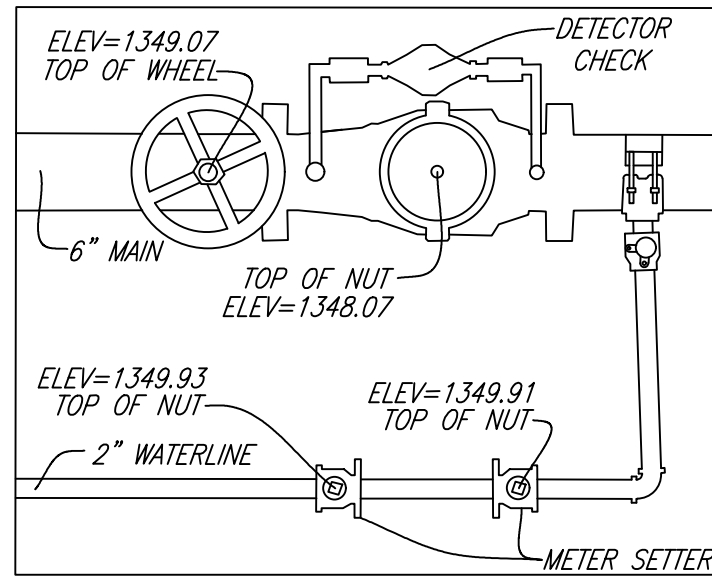

VAULT DETAIL
NOT TO SCALE

CURVE TABLE				
CURVE	RADIUS	LENGTH	CHD BEARING	CHD LENGTH
E-C1	15.00'	17.64'	S 28°11'53" E	16.64'
				67°22'32"

LINE TABLE		
LINE	BEARING	DISTANCE
E-L1	S 13°06'27" W	7.59'

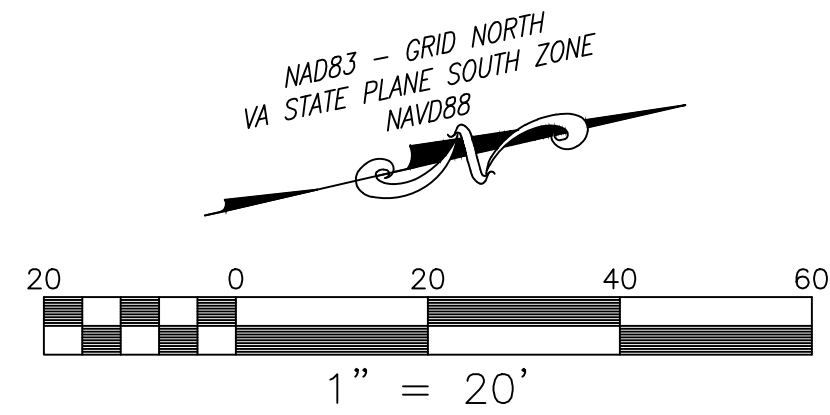


**BALZER
& ASSOCIATES**
PLANNERS / ARCHITECTS
ENGINEERS / SURVEYORS

Roanoke / Richmond
New River Valley
Shenandoah Valley

www.balzer.cc

1208 Corporate Circle
Roanoke, VA 24018
540.772.9580

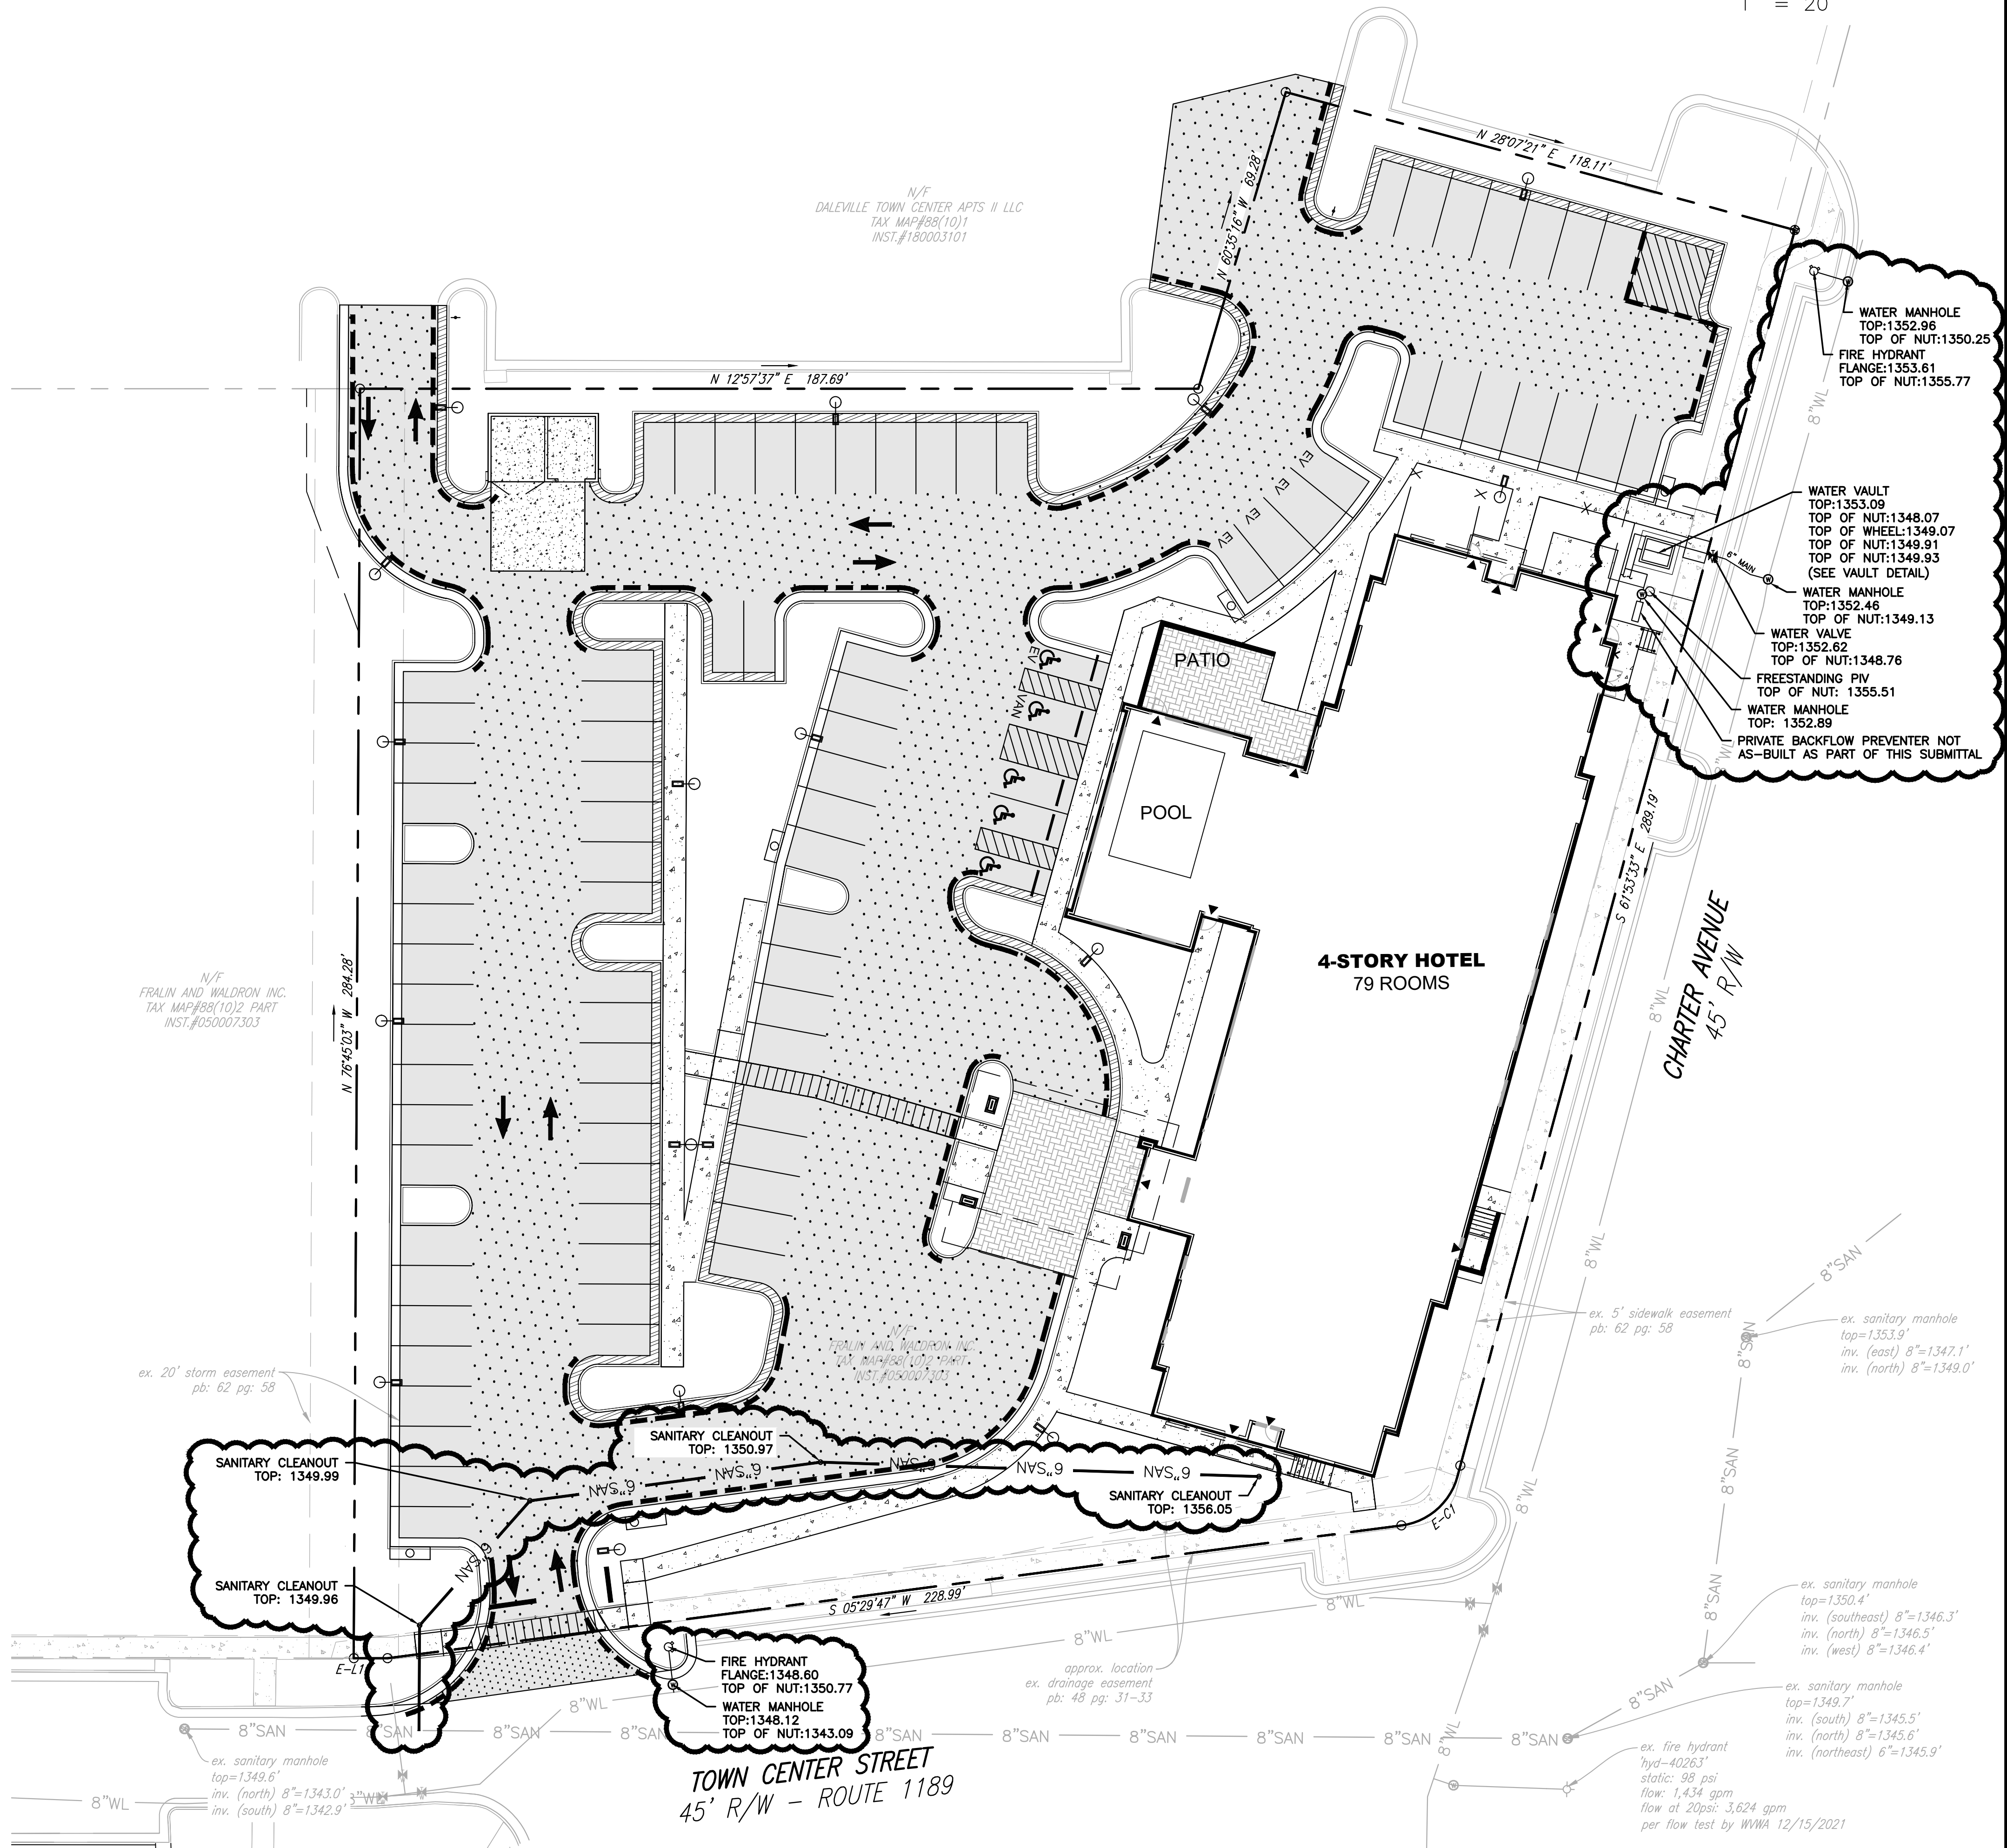

HAMPTON INN BY HILTON - DTC

WWA AS-BUILT PLAN

AMSTERDAM DISTRICT
TOWN CENTER ST DALEVILLE, VIRGINIA

DRAWN BY: EJP
DESIGNED BY: EJP
CHECKED BY: DSH
DATE: 10/28/2024
SCALE: 1"=20'
REVISIONS:

AS-BUILT
PROJECT NO. 04220074.00