




| STRUCTURE TABLE |                                      |                                                    |                            |
|-----------------|--------------------------------------|----------------------------------------------------|----------------------------|
| STRUCTURE NAME  | DETAILS                              | PIPPS IN                                           | PIPPS OUT                  |
| 1               | Ex. 4th Eccentric MW<br>RW = 1320.50 | Ex 6" PVC IN = 1318.6<br>6" P" PVC IN = 1319.30    | Ex 6" PVC INV OUT = 1318.6 |
| 2               | 4 In. PVC Cleanout<br>RW = 1324.53   | 6" PVC INV IN = 1319.87                            | 6" PVC INV OUT = 1319.87   |
| 3               | 60 In Drop MW<br>RW = 1336.36        | 6" PVC INV IN = 1336.37                            | 6" PVC INV OUT = 1320.51   |
| 4               | 4 In. PVC Cleanout<br>RW = 1338.36   | 6" PVC INV IN = 1338.63<br>6" PVC INV IN = 1320.50 | 6" PVC INV OUT = 1335.50   |
| GREASE TRAP     | GREASE TRAP<br>RW = 1341.0           | 6" PVC INV IN = 1326.00                            | 6" PVC INV OUT = 1336.00   |
| 5               | 48 In Eccentric MW<br>RW = 1345.61   | 6" PVC INV IN = 1335.67                            | 6" PVC INV OUT = 1335.67   |
| 6               | 4 In. PVC Cleanout<br>RW = 1341.64   | 6" PVC INV IN = 1338.30                            | 6" PVC INV OUT = 1338.30   |
| 7               | 4 In. PVC Cleanout<br>RW = 1346.00   | 6" PVC INV IN = 1336.70                            | 6" PVC INV OUT = 1336.70   |

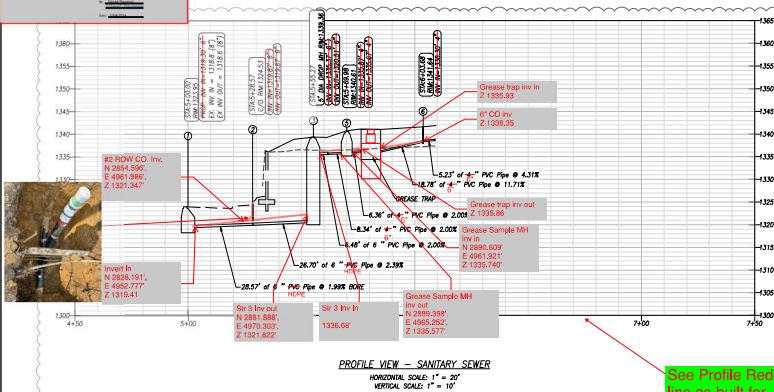