



This document, including the drawings and any other information contained herein, is the property of Engineering Concepts, Inc. and shall be used only for the specific project and shall not be used for any other project without the written consent of Engineering Concepts, Inc. The user assumes all liability for the use of this information.

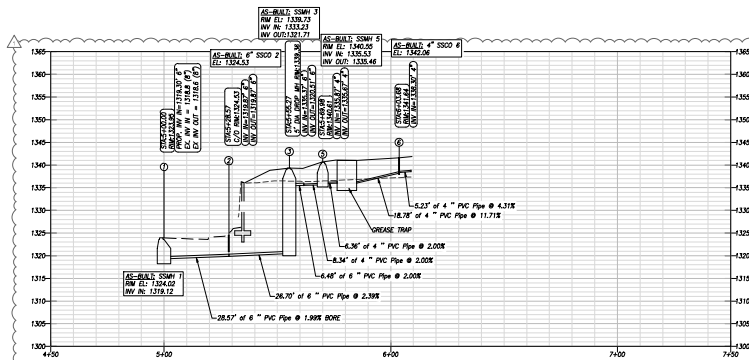

PROFILE VIEW - SANITARY SEWER
HORIZONTAL SCALE: 1" = 20'
VERTICAL SCALE: 1" = 10'

STRUCTURE TABLE			
STRUCTURE NAME	DETAILS	PIPES IN	PIPES OUT
1	EX. 48" Concrete MH RM = 1323.95	EX 8" PVC IN = 1318.8 PR 6" PVC INV IN = 1319.30	EX 8" PVC INV OUT = 1319.8
2	4 in. PVC Cleanout RM = 1324.53	6" PVC INV IN = 1319.87	6" PVC INV OUT = 1319.87
3	60 in Drop MH RM = 1330.36	6" PVC INV IN = 1335.37	6" PVC INV OUT = 1335.51
4	4 in. PVC Cleanout RM = 1335.36	4" PVC INV IN = 1335.50 6" PVC INV IN = 1335.50	6" PVC INV OUT = 1335.50
GREASE TRAP	GREASE TRAP RM = 1341.0	4" PVC INV IN = 1336.00	4" PVC INV OUT = 1336.00
5	48 in Concrete MH RM = 1345.61	4" PVC INV IN = 1335.87	4" PVC INV OUT = 1335.87
6	4 in. PVC Cleanout RM = 1347.64	4" PVC INV IN = 1338.30	4" PVC INV OUT = 1338.30
7	4 in. PVC Cleanout RM = 1349.00	6" PVC INV IN = 1336.70	6" PVC INV OUT = 1336.70

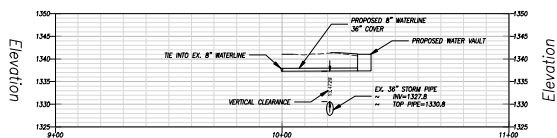

PROFILE VIEW - WATERLINE SERVICE
HORIZONTAL SCALE: 1" = 20'
VERTICAL SCALE: 1" = 10'



Description		Date
1	COUNTY COMMENTS	12/28/22
2	REVISIONS	12/28/22
3	SEWER PROFILE	6/2/23

DTC SOUTH VILLAGE
DEVELOPMENT
UTILITY PROFILES



GRAPHIC SCALE
PROJECT: 22002
C-17