


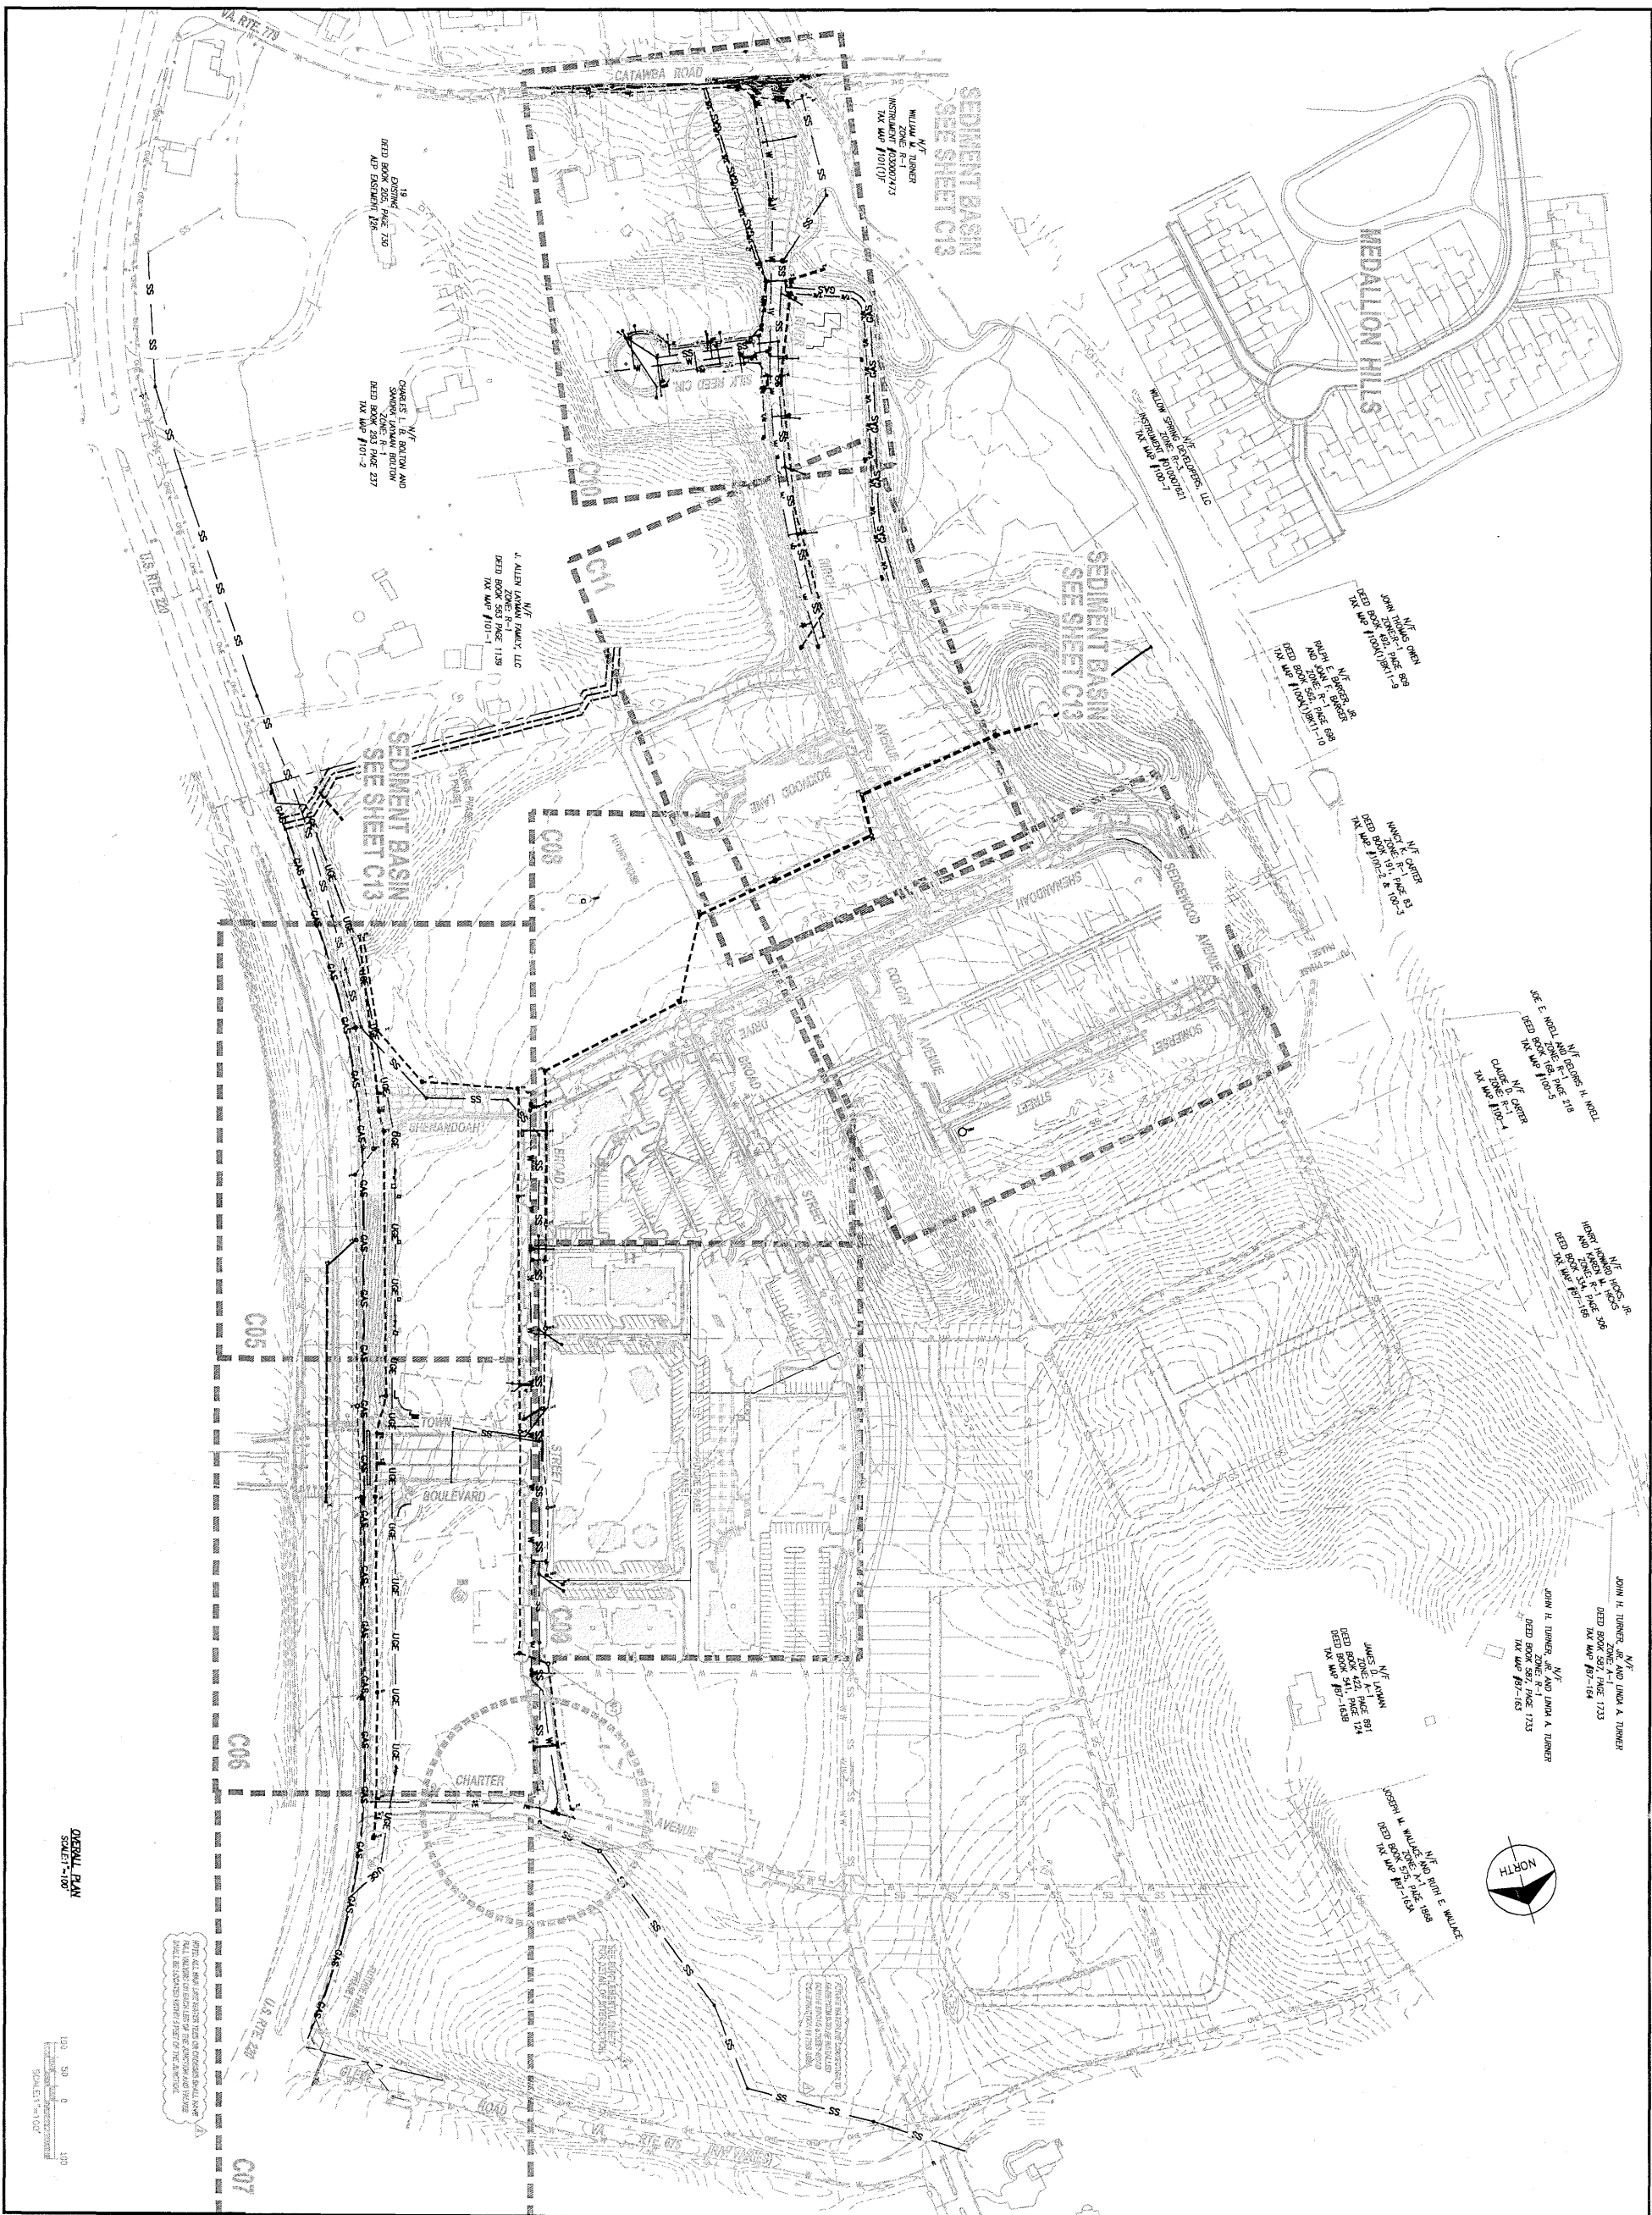

OVERALL PLAN
SCALE: 1"=100'

100 50 0 50 100
SCALE: 1"=100'

C-04

SHEET

PROJECT FRALIN AND WALDRON
DALEVILLE TOWN CENTER

DRAWING OVERALL PLAN

AS-BUILT



ENGINEERING
CONCEPTS, INC.
"Creating Success"

23 S. Roanoke Street, P.O. Box 619
Roanoke, Virginia 24060
540.473.1233 FAX 540.473.1254

DATE 5/8/08
PROJECT 03083
DESIGNED RHW
DRAWN MSMJ
CHECKED RHW

REVISIONS
MARK DATE

REVISIONS
BY

VAUPOUT DESIGN DEVELOPMENT REVISIONS
NOTES/COMMENTS, VERR, DESIG COMMENTS
DESCRIPTION