


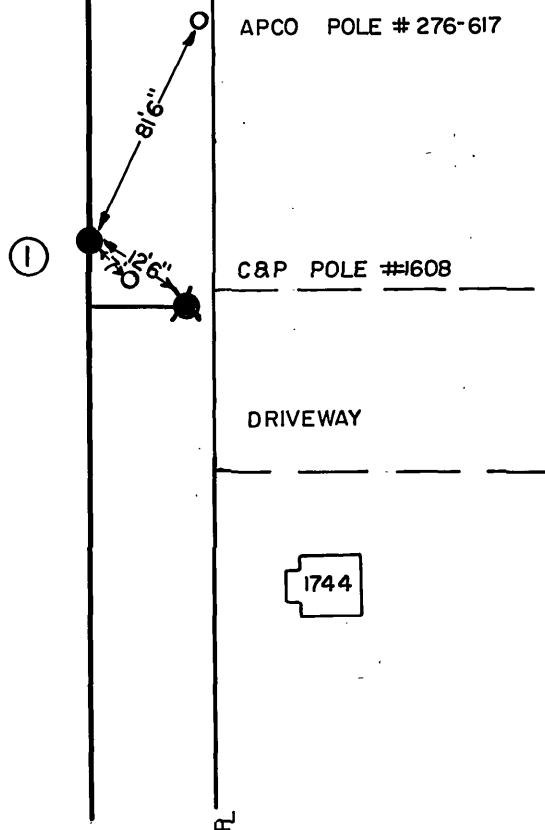

DEYERLE ROAD

— TO RENFIELD DR. P. L.

[illegible]

CITY OF ROANOKE - WATER DEP'T.

VALVE DIAGRAM

1700 BLK. DEYERLE RD.

NORTH OF RENFIELD DR.

SEC. MAP 507

S.W.

DATE:

PAGE NO.