


AS BUILT: \$ GENERAL  
Dec 15, 2011  
David W. Jones

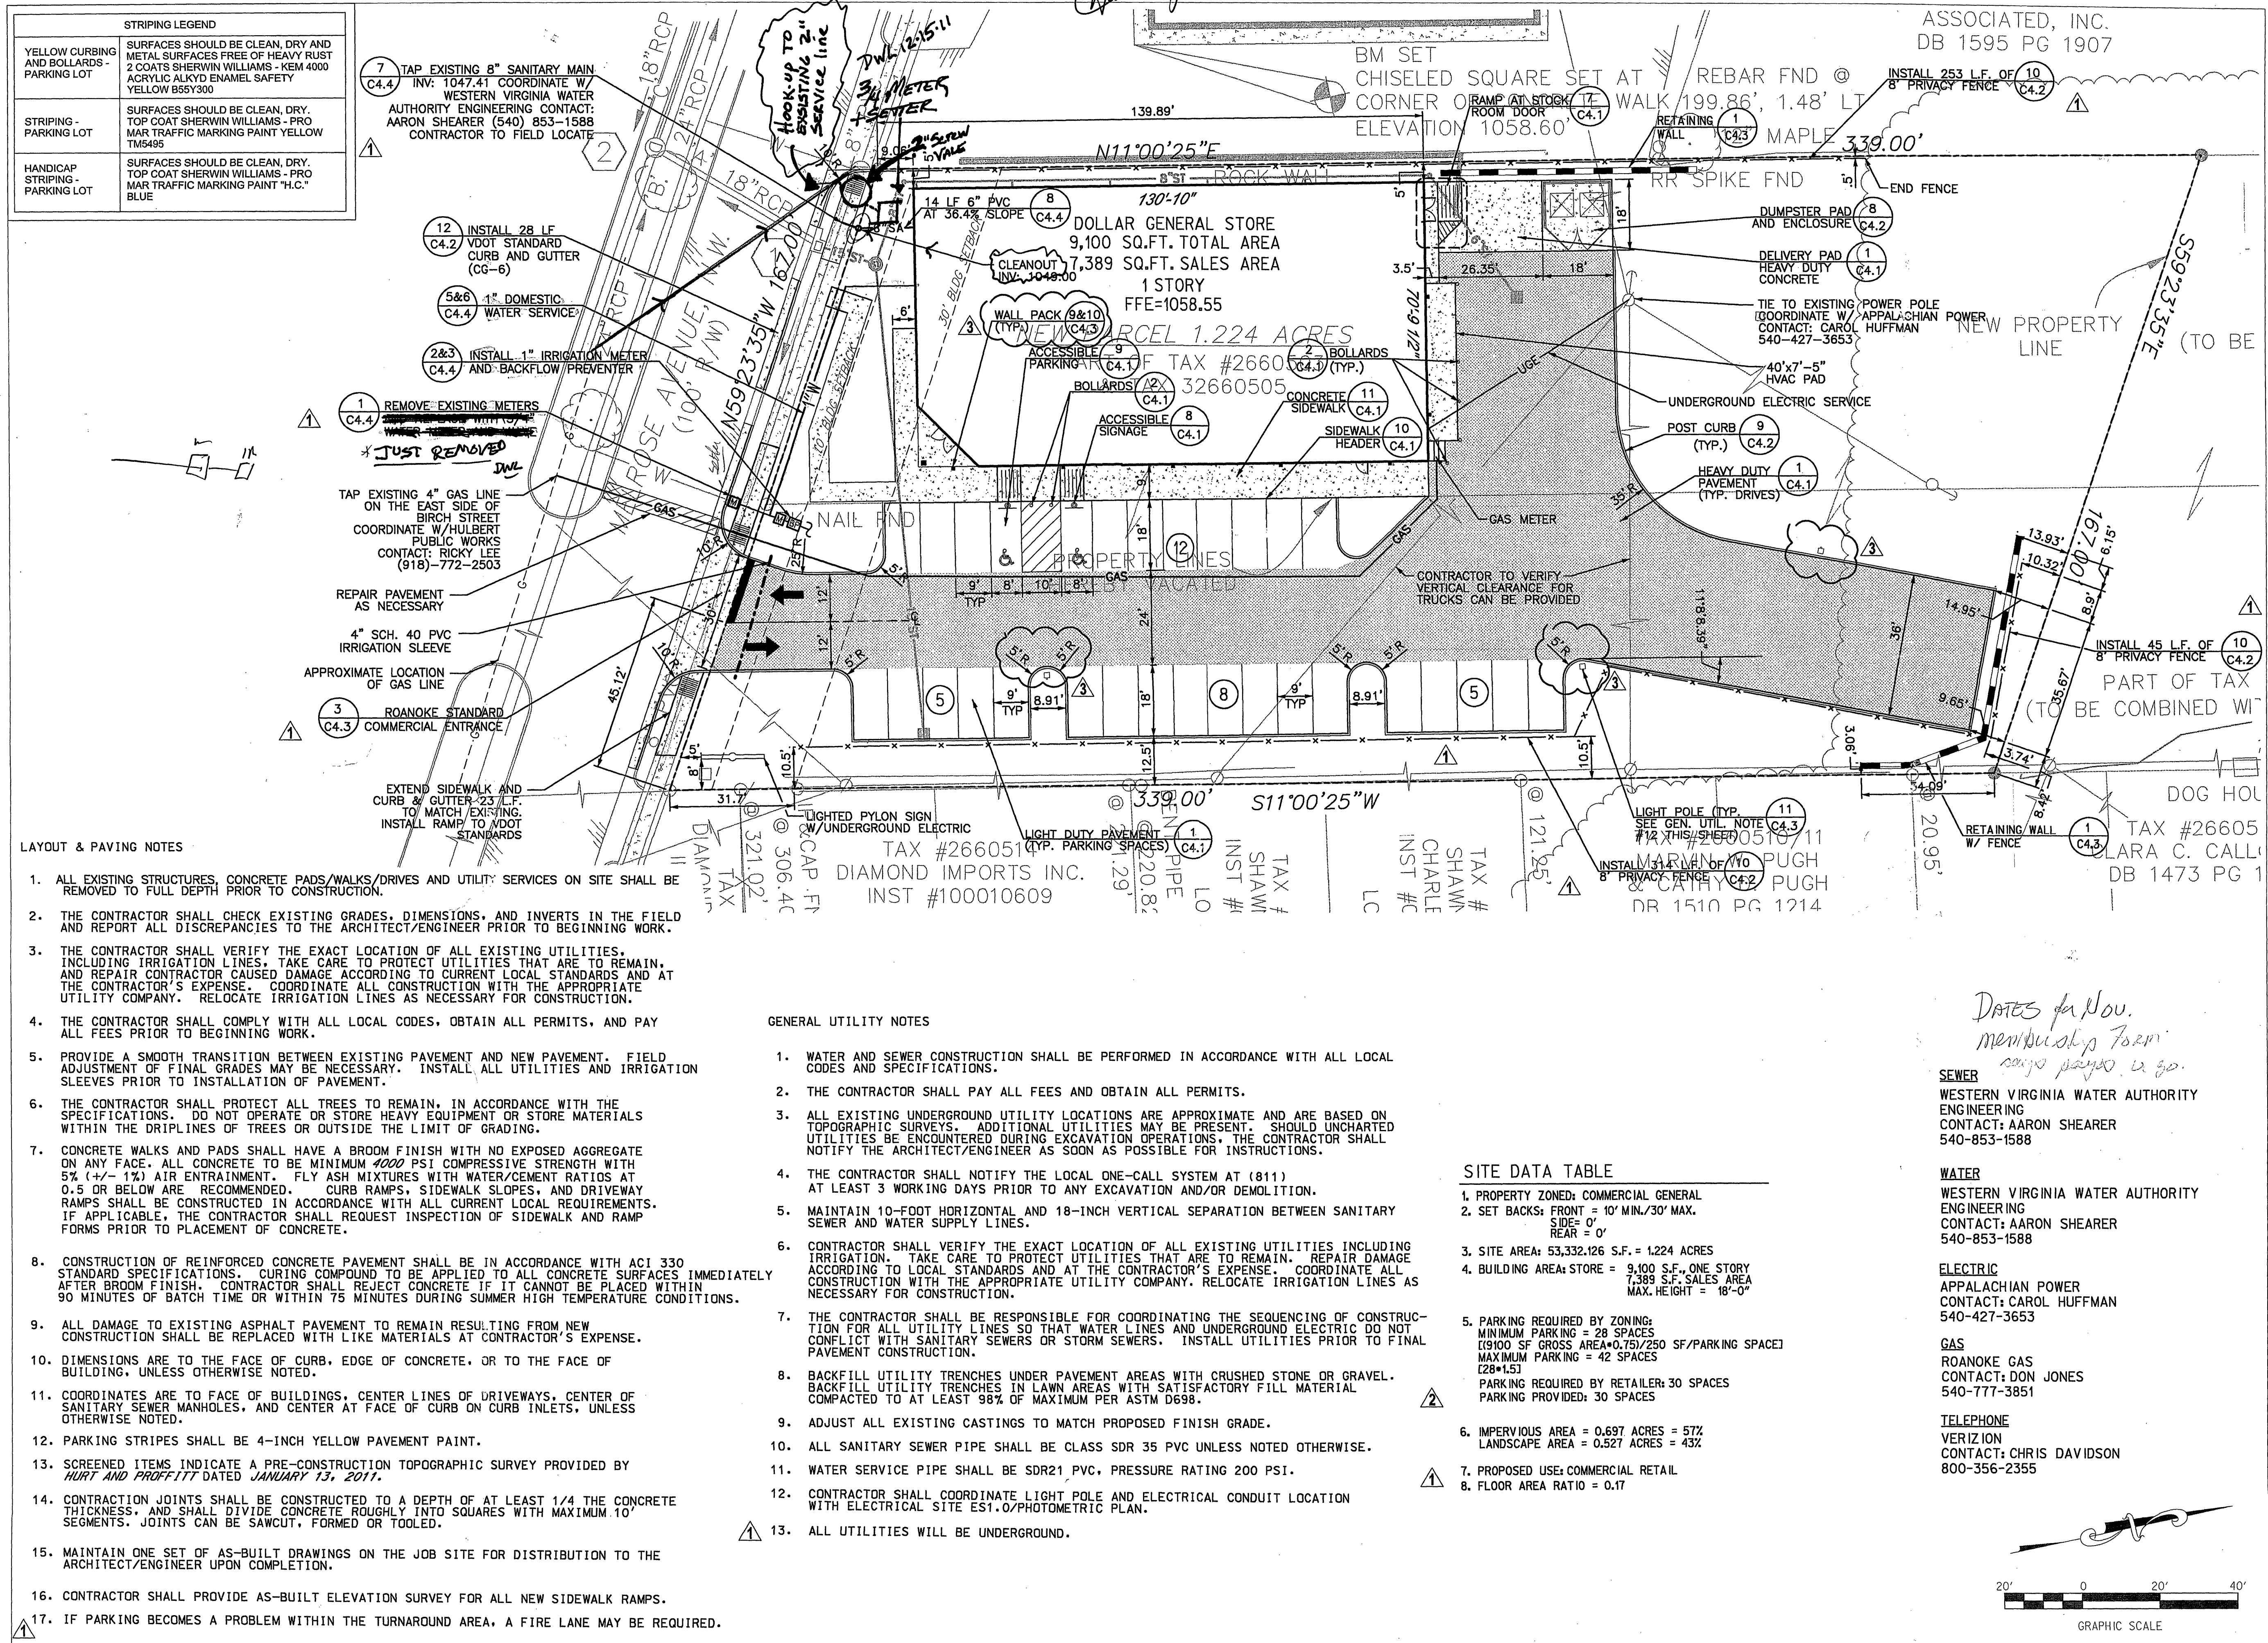

**MJM ARCHITECTS**  
105 BROADWAY 4TH FLOOR  
NASHVILLE, TN 37201  
(p) 615.244.8170  
(f) 615.244.8141  
www.mjmarsh.com

**ARCHITECTURE  
PLANNING  
ENGINEERING  
GRAPHICS**

**AS BUILT: \$ GENERAL**  
Dec 15, 2011  
David W. Jones

**CIVIL ENGINEER**  
GRESHAM SMITH AND PARTNERS  
511 Union Street  
1400 Nashville City Center  
Nashville, Tennessee 37219  
Phone: (615) 770-8100  
GSP #27761.92

**GB**  
GBT REALTY CORPORATION  
201 Summit Drive Suite 110  
Brentwood, TN 37027  
615-378-4670  
Fax: 615-378-1111  
www.gbtrealty.com

**DOLLAR GENERAL**  
STORE #XXXXX

**ROANOKE,  
VA AT  
MELROSE**

**DOLLAR GENERAL PERMIT SET**  
04.06.11  
MJM 11015

1	CITY REVIEW COMMENTS	5.12.11
2	CITY REVIEW COMMENTS	6.14.11
3	CITY REVIEW COMMENTS	7.8.11

This drawing and the design shown is the property of the architect. The reproduction, copying or use of this drawing without their written consent is prohibited and any infringement will be subject to legal action.

**SITE LAYOUT  
PLAN**

**C2.1**

**SHEET**