


MERIDIAN OF PLANS FOR WASHINGTON HEIGHTS
WATERLINE REPLACEMENT PHASE 1 & 2

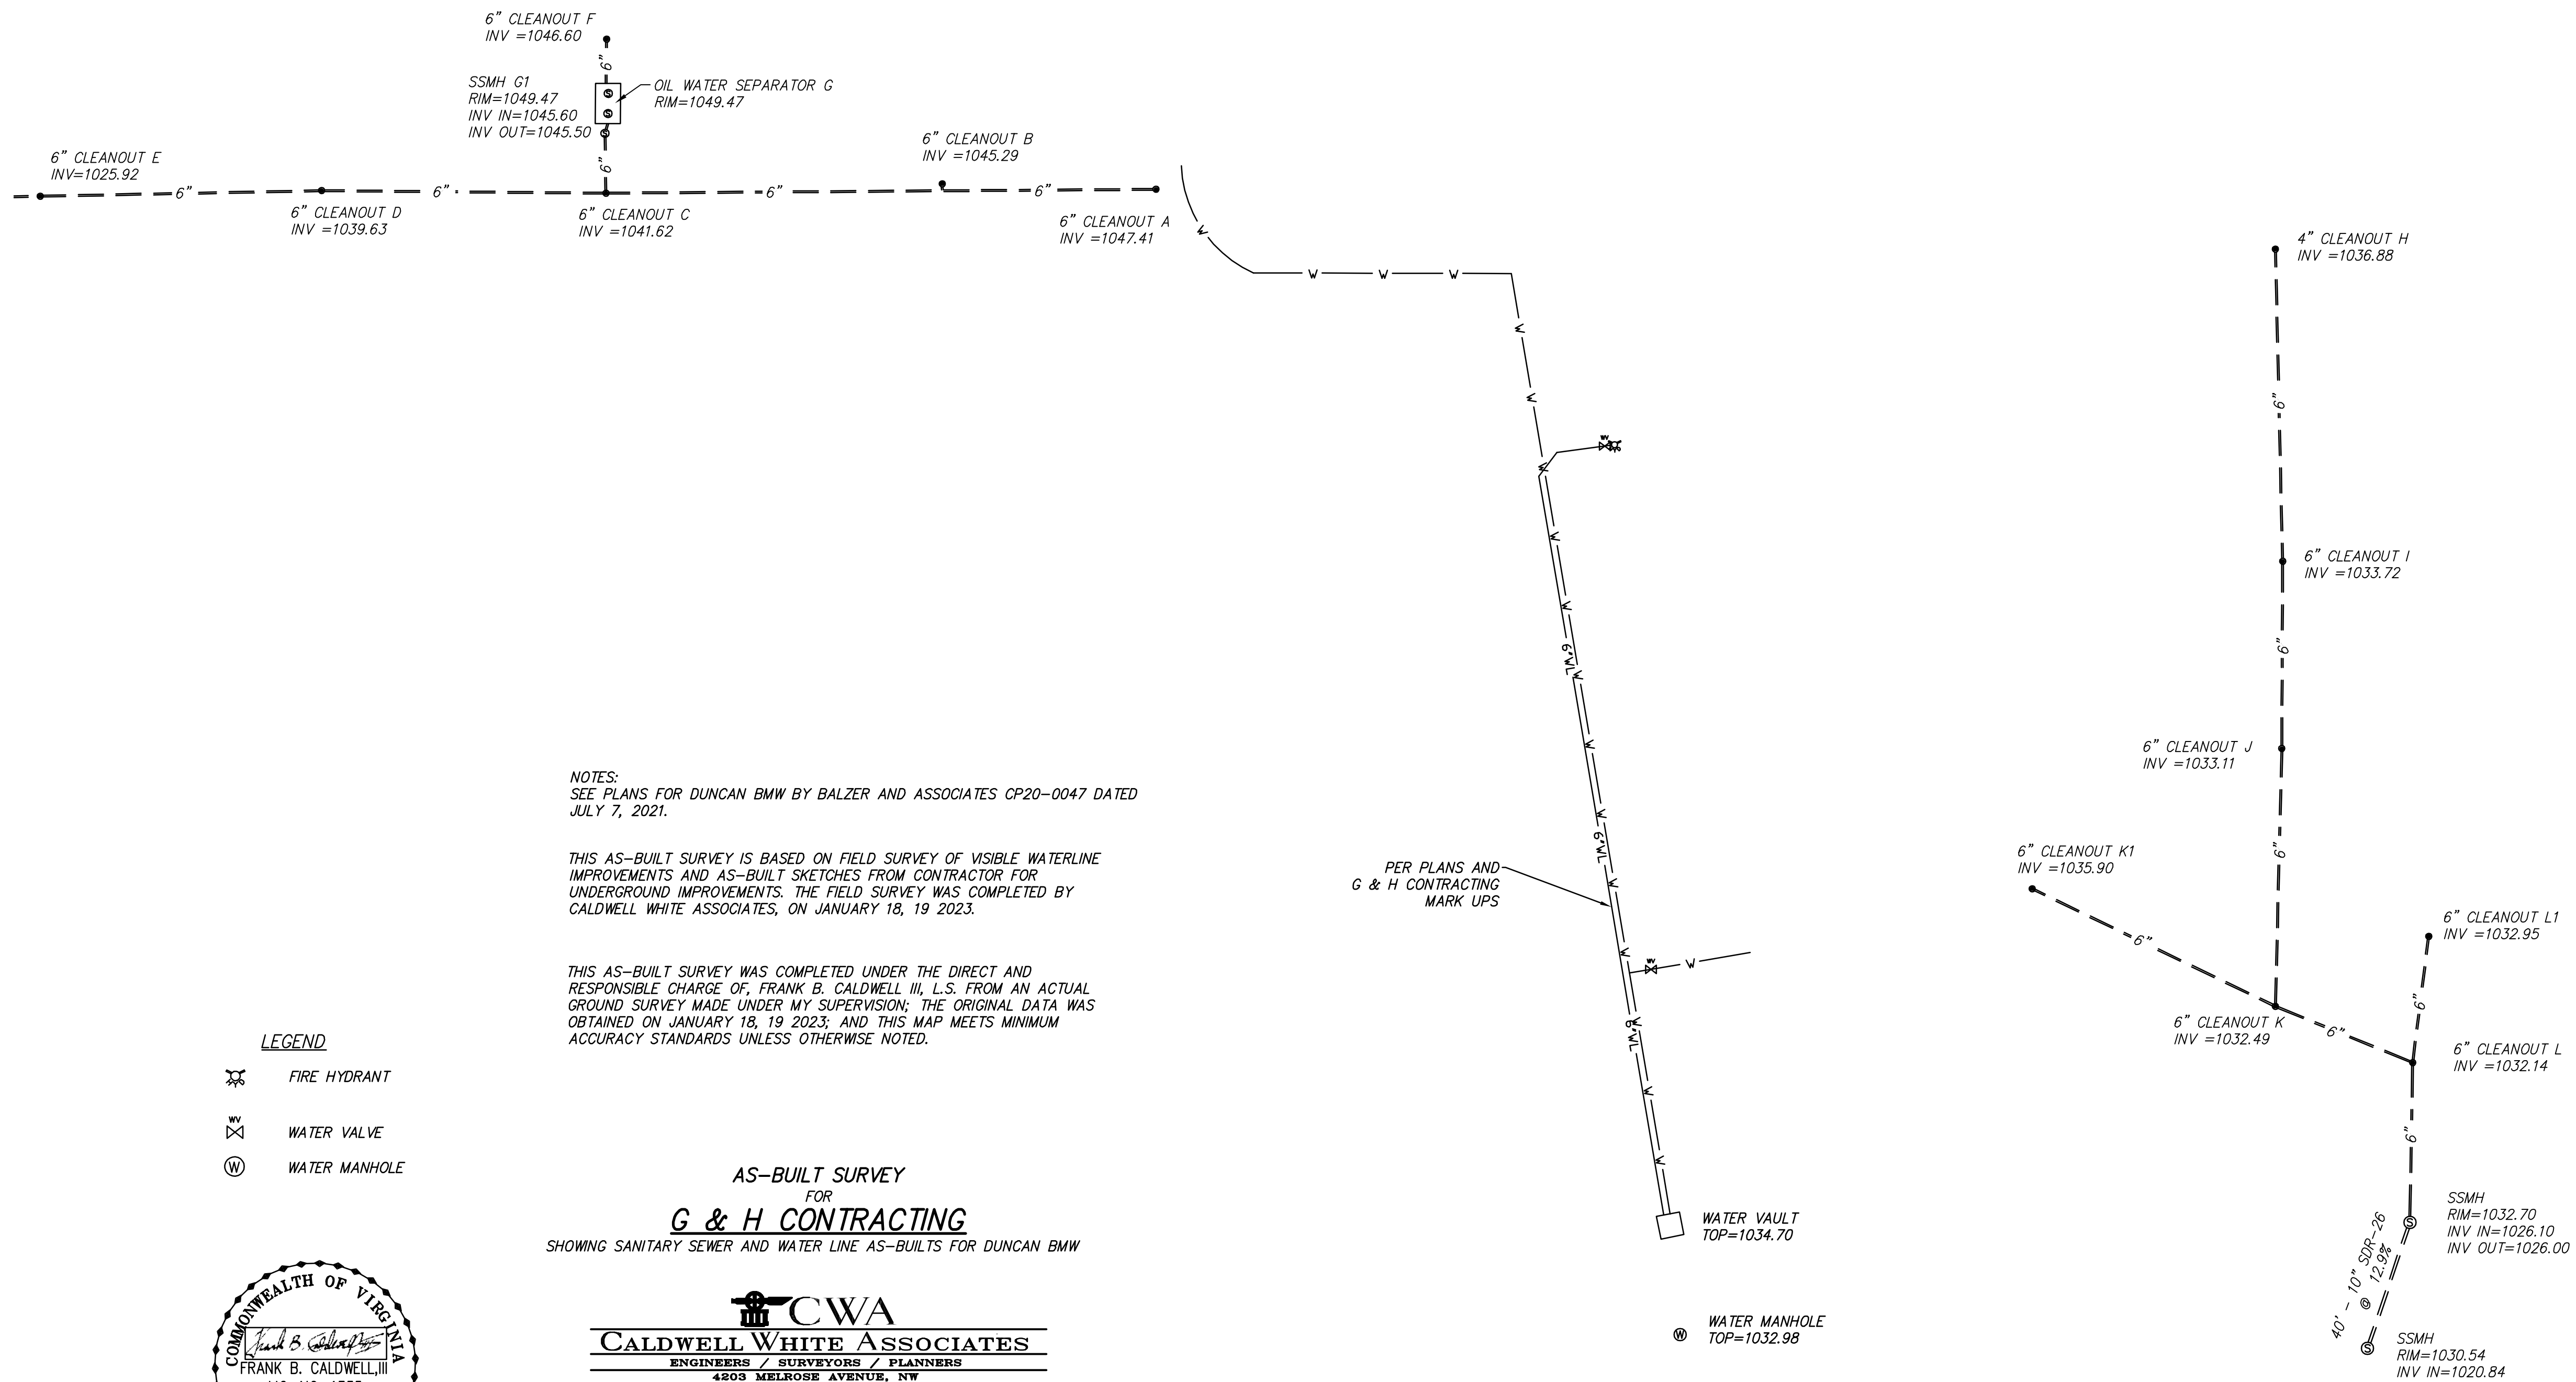


NOTES:
SEE PLANS FOR DUNCAN BMW BY BALZER AND ASSOCIATES CP20-0047 DATED
JULY 7, 2021.

THIS AS-BUILT SURVEY IS BASED ON FIELD SURVEY OF VISIBLE WATERLINE
IMPROVEMENTS AND AS-BUILT SKETCHES FROM CONTRACTOR FOR
UNDERGROUND IMPROVEMENTS. THE FIELD SURVEY WAS COMPLETED BY
CALDWELL WHITE ASSOCIATES, ON JANUARY 18, 19 2023.

THIS AS-BUILT SURVEY WAS COMPLETED UNDER THE DIRECT AND
RESPONSIBLE CHARGE OF, FRANK B. CALDWELL III, L.S. FROM AN ACTUAL
GROUND SURVEY MADE UNDER MY SUPERVISION; THE ORIGINAL DATA WAS
OBTAINED ON JANUARY 18, 19 2023; AND THIS MAP MEETS MINIMUM
ACCURACY STANDARDS UNLESS OTHERWISE NOTED.

- LEGEND**
- FIRE HYDRANT
 - WATER VALVE
 - WATER MANHOLE

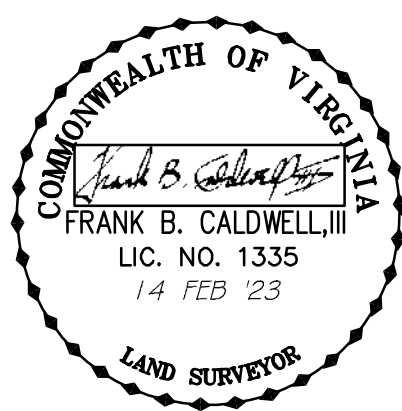

AS-BUILT SURVEY
FOR
G & H CONTRACTING
SHOWING SANITARY SEWER AND WATER LINE AS-BUILTS FOR DUNCAN BMW

CWA
CALDWELL WHITE ASSOCIATES
ENGINEERS / SURVEYORS / PLANNERS
4205 MELROSE AVENUE, NW
P.O. BOX 6260
ROANOKE, VIRGINIA 24017
(540) 366-8400 FAX: (540) 366-8702

DATE: FEBRUARY 10, 2023
W.O.: 21-0125

SCALE: 1"= 30'
N.B.: JW-42