


VICINITY MAP

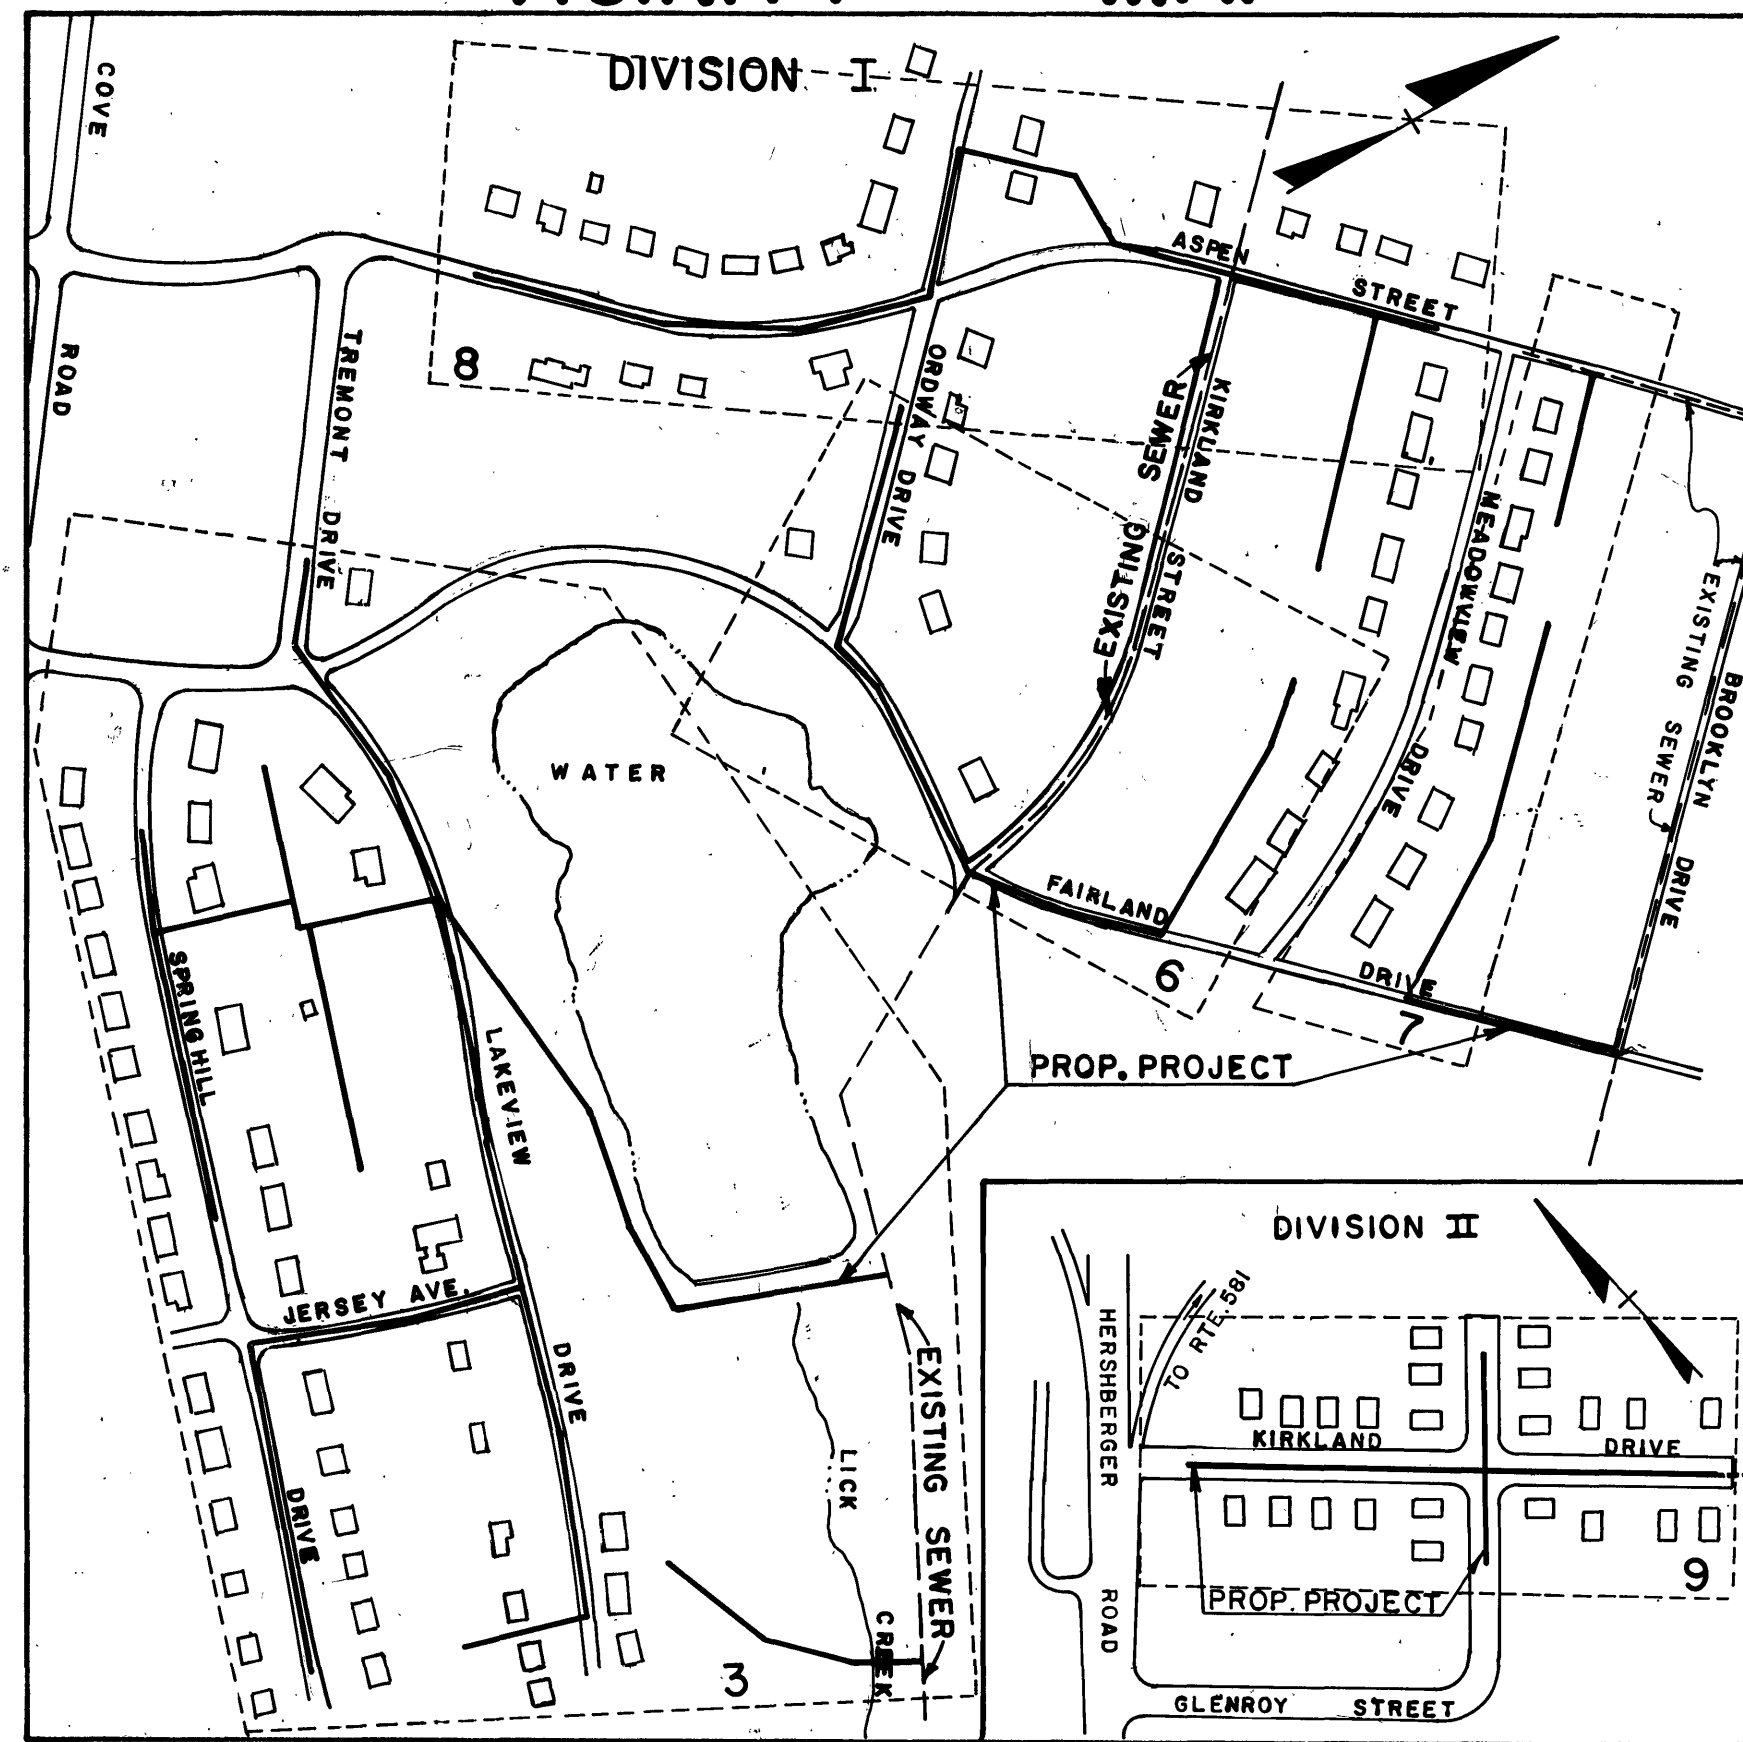

NOT TO SCALE

INDEX OF SHEETS

SHEET NO.	DESCRIPTION
1	COVER SHEET
2	QUANTITY SHEET
3	PLAN SHEET
4	PROFILE SHEET
5	PROFILE SHEET
6	PLAN & PROFILE SHEET
7	PLAN & PROFILE SHEET
8	PLAN & PROFILE SHEET
9	PLAN & PROFILE SHEET

AS BUILT

F.B. 580
P.C.S.



ROANOKE, VIRGINIA

OFFICE OF CITY ENGINEER
CONSTRUCTION PLAN

FOR

PROPOSED SANITARY SEWER TO
SERVE PORTIONS OF FAIRLAND LAKE AREA

AS BUILT

SHEET NO.	DATE	SHEET NO.	DATE
PLANS REVISED			

APPROVED FOR CONSTRUCTION	
9-27-76 DATE	Thomas A. Brady CITY ENGINEER
DATE	
DATE	
DATE	
3-75 DATE	George R. Duvall REVISED BY
3-75 DATE	Edna M. Cook, Jr. DESIGNED BY

APPROVED	
DATE	
APPROVED	
DATE	