


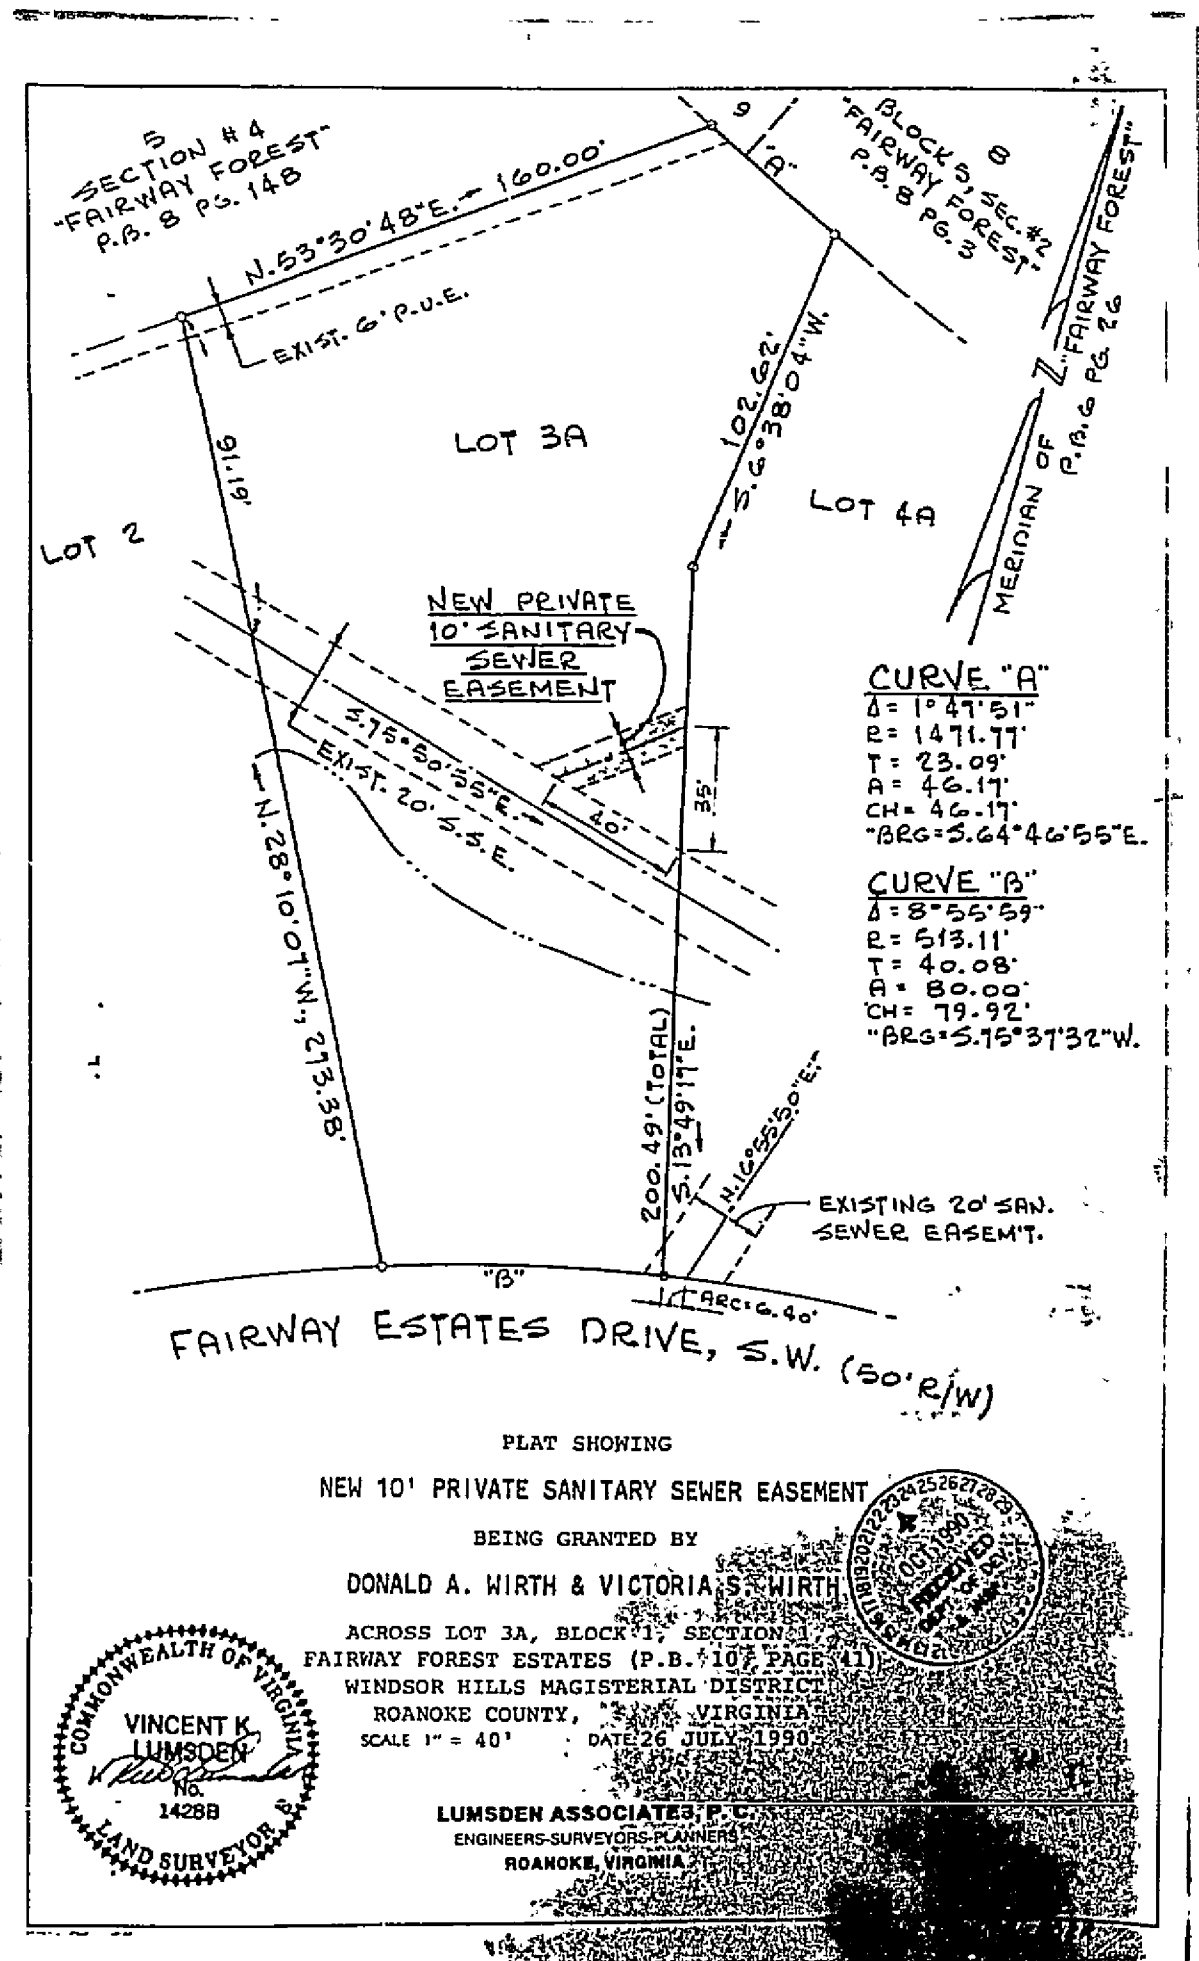

AS-BUILT 15 OCTOBER 1990 DEVELOPMENT PLANS FOR SECTION NO. 1 **FAIRWAY FOREST ESTATES** ROANOKE VIRGINIA

DATE: 15 AUGUST 1986

OWNER: R. WILLIAM REID BUILDER, INC.

APPROVALS:

DEVELOPMENT REVIEW COORDINATOR, ROANOKE COUNTY, VIRGINIA _____ DATE _____

RESIDENT ENGINEER, VIRGINIA DEPARTMENT OF HIGHWAYS & TRANSPORTATION _____ DATE _____

INDEX OF DRAWINGS

SHEET	DESCRIPTION
1	COVER SHEET
2	ROANOKE COUNTY STANDARD COVER SHEET
3	RECORD MAP (2 SHEETS)
4	NOTES & DETAILS
5	PLAN & PROFILE
6	SANITARY SEWER & STORM DRAIN PROFILES
7	EROSION CONTROL PLAN & DRAINAGE DIVIDES
8	ROANOKE COUNTY STANDARD EROSION CONTROL SHEET
9	ROANOKE COUNTY STANDARD SANITARY SEWER DETAIL SHEET
10	ROANOKE COUNTY STANDARD WATER DETAIL SHEET

