



1. THIS ASBUILT HAS BEEN PREPARED FROM AN ACTUAL FIELD SURVEY AS PER DATE OF THIS PLAT AND THERE ARE NO READILY APPARENT EASEMENTS OR ENCROACHMENTS EXCEPT AS SHOWN.
- 2.THE LOCATION OF THE W SHOWN HEREON WAS MARKED WITH BLUE PAINT BY THE CONTRACTER PRIOR TO THE SITE VISIT PERFORMED BY ARMSTRONG & ASSOCIATES, INC.
- 3.BUILDING & PARKING SHOWN PER PLAN INFORMATION



105 NORTH MAIN ST.
GRETN. VA 24537
434-656-1051

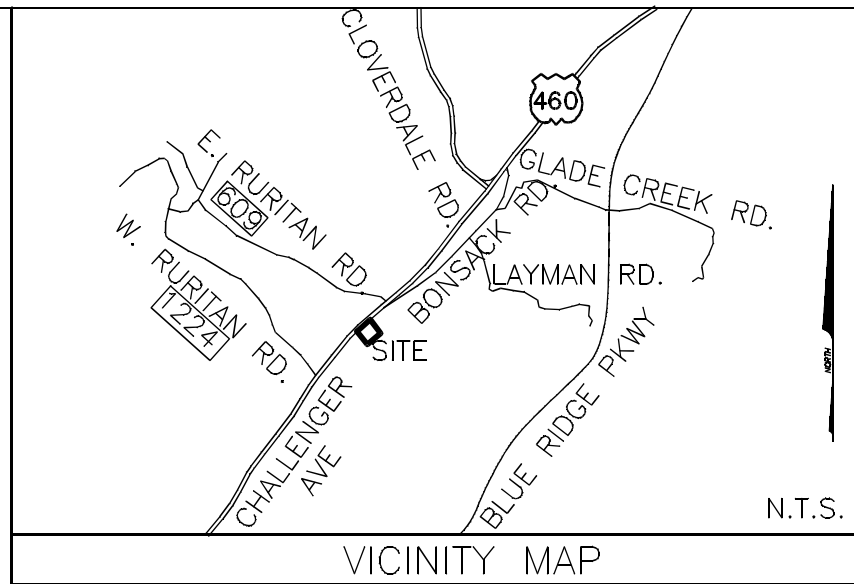

ARMSTRONGANDASSOCIATES.NET
ARMSTRONGLANDSURVEYING@GMAIL.COM

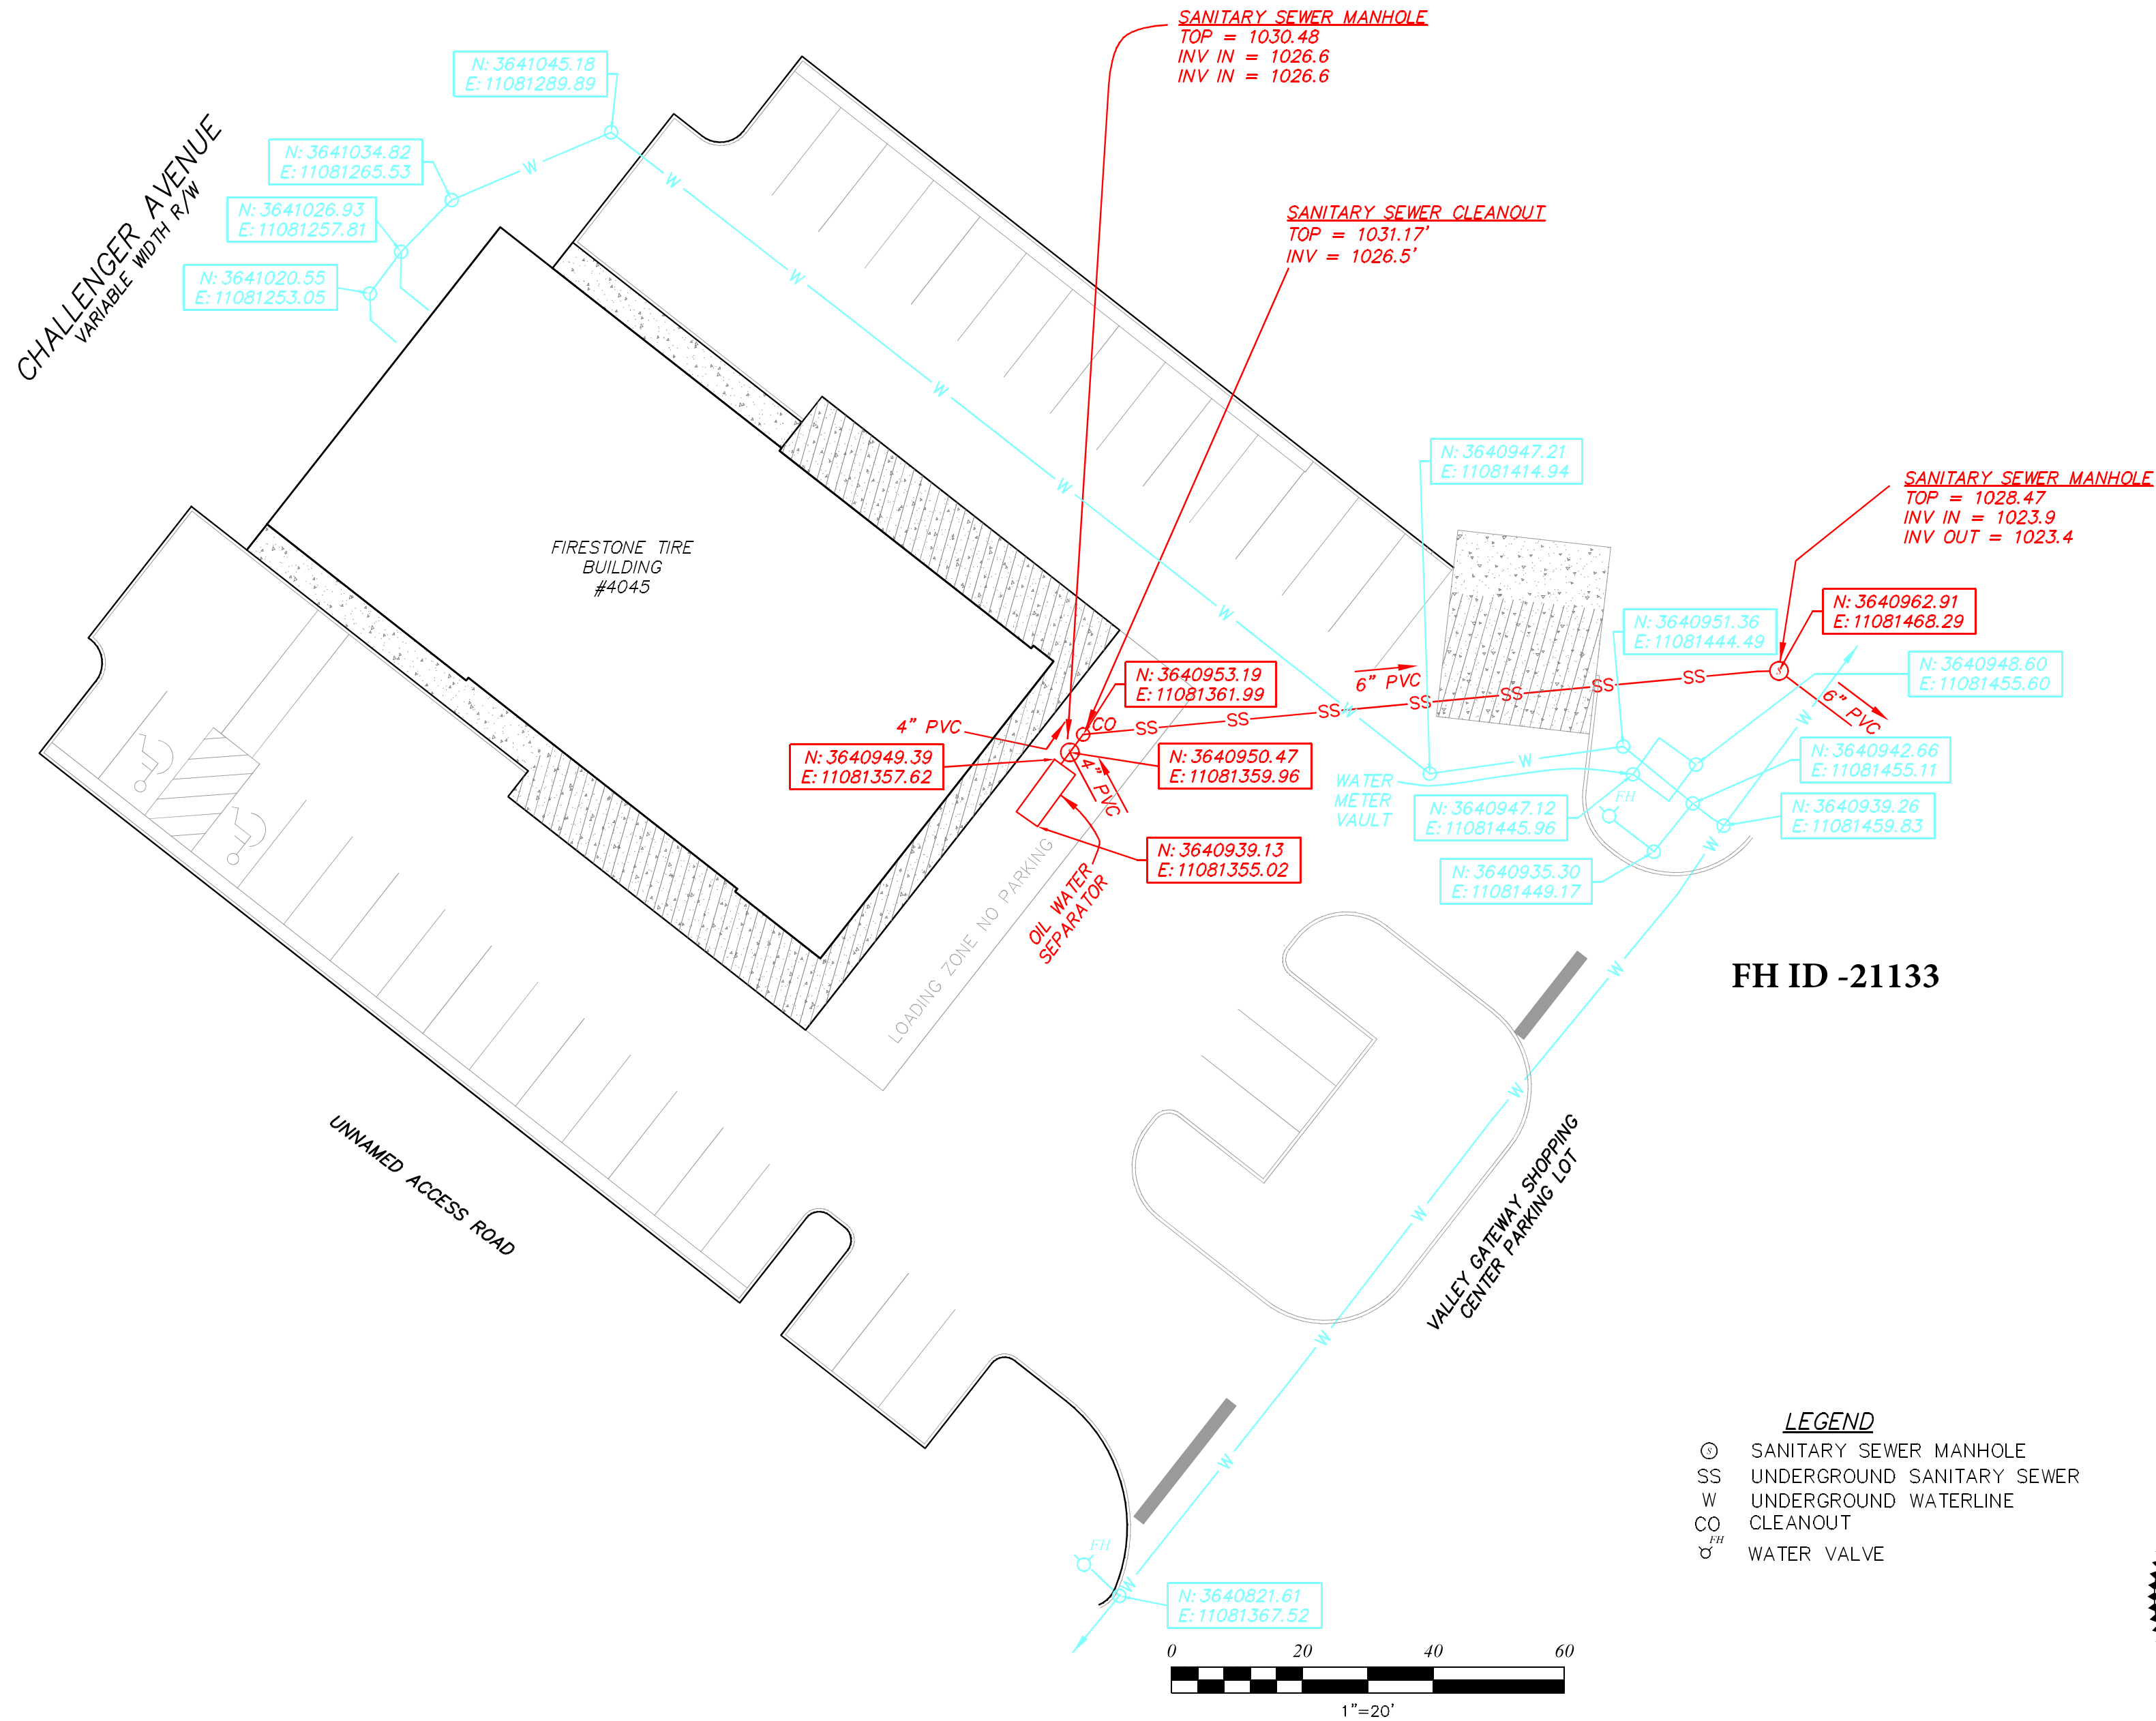

ASBUILT SURVEY SHOWING
WATERLINE AND SANITARY SEWER AT
ROANOKE FIRESTON
VINTON MAGISTERIAL DISTRICT, ROANOKE COUNTY, VIRGINIA

PROJECT#:200090

DATE: 10-28-2020

DRAWN BY:MSG

SHEET 1 OF 1

