


5BLK

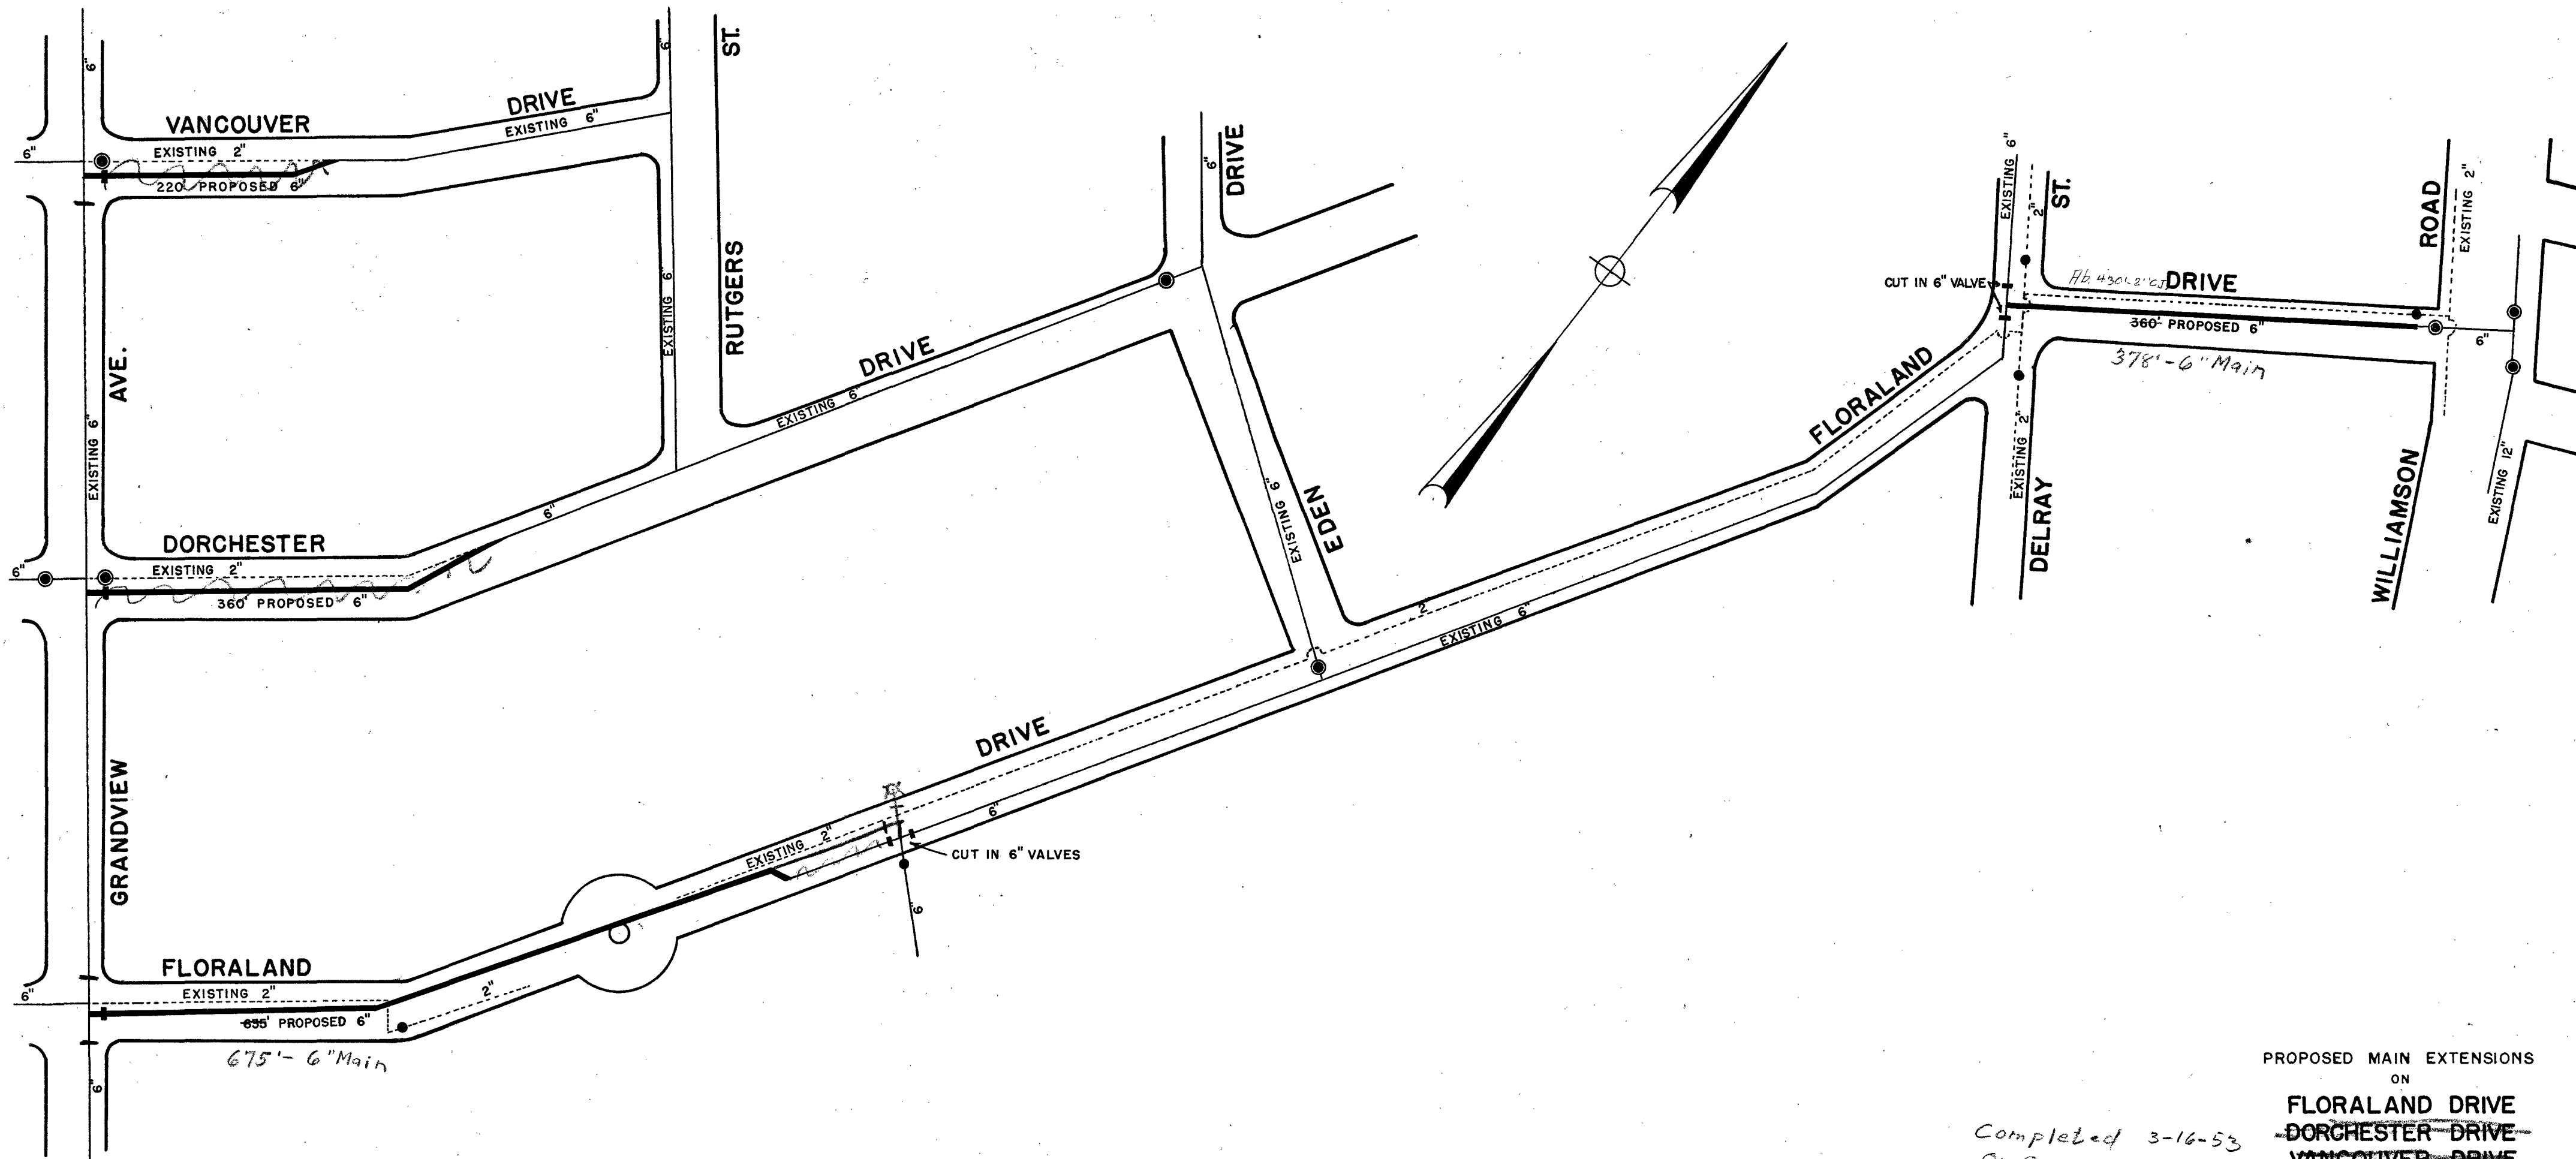

PROPOSED MAIN EXTENSIONS
ON

~~FLORALAND DRIVE~~
~~DORCHESTER DRIVE~~
~~VANCOUVER DRIVE~~

Completed 3-16-53
On Quad. Map
On Dist. Map

MARCH 4, 1953 SCALE: 1"=100'