
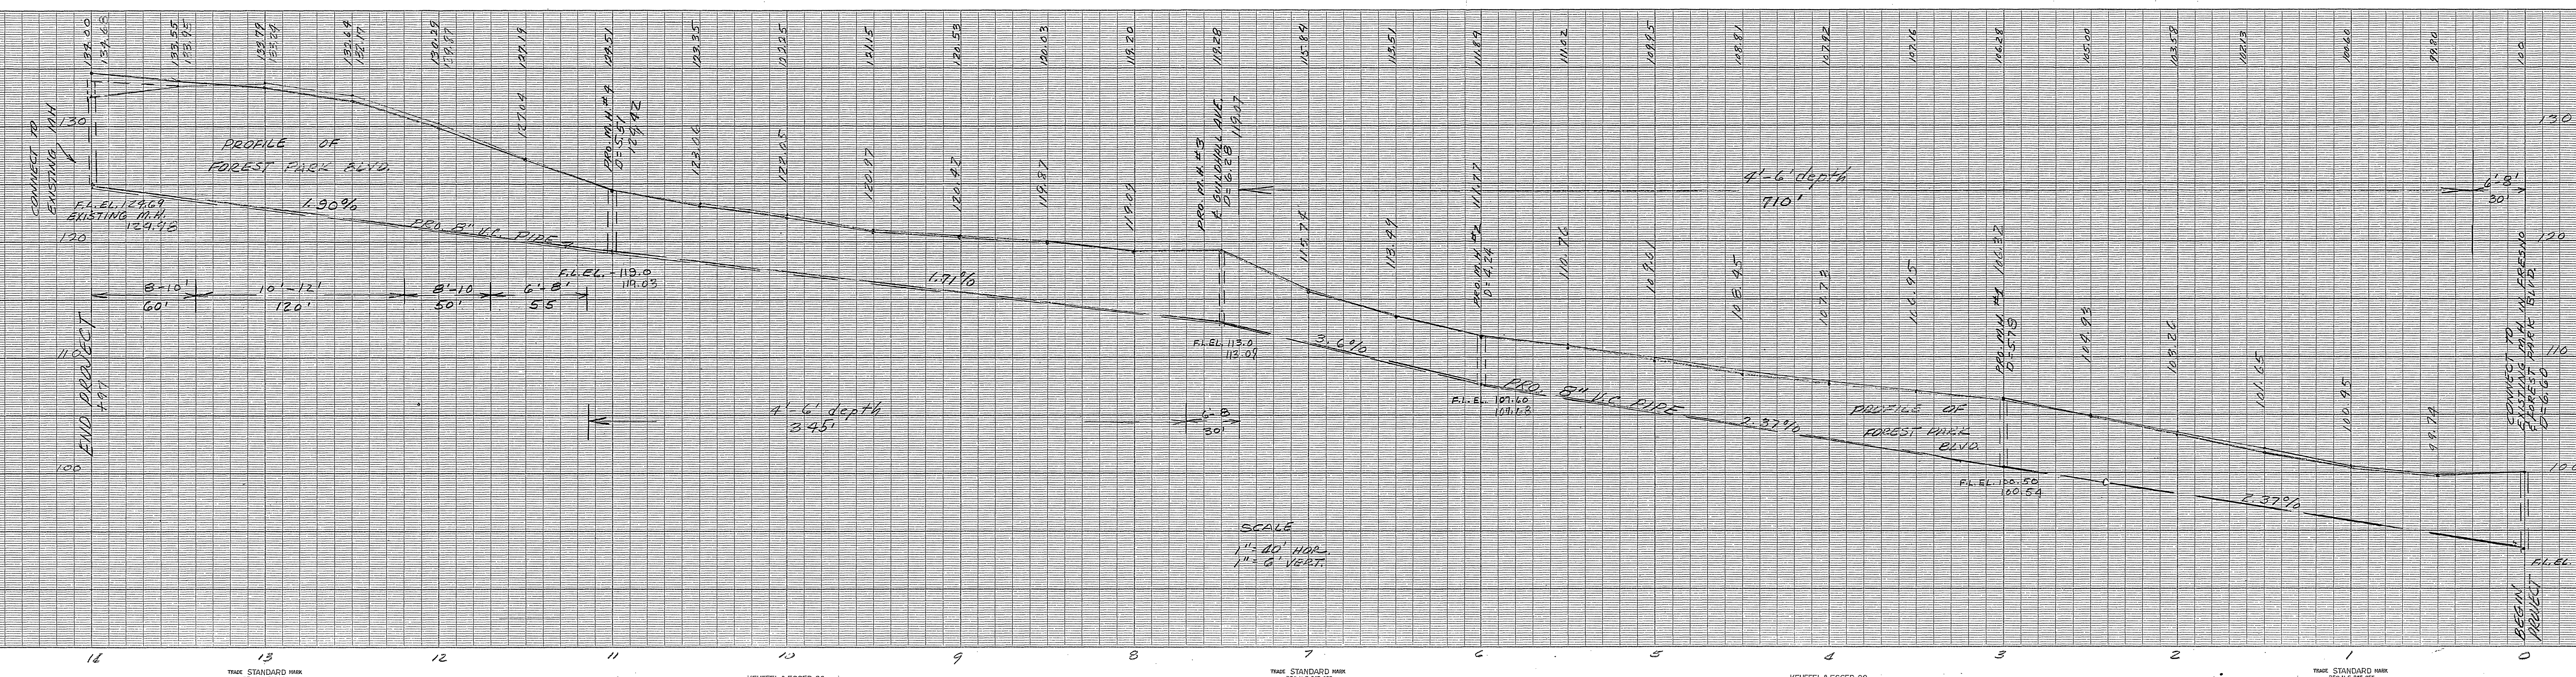


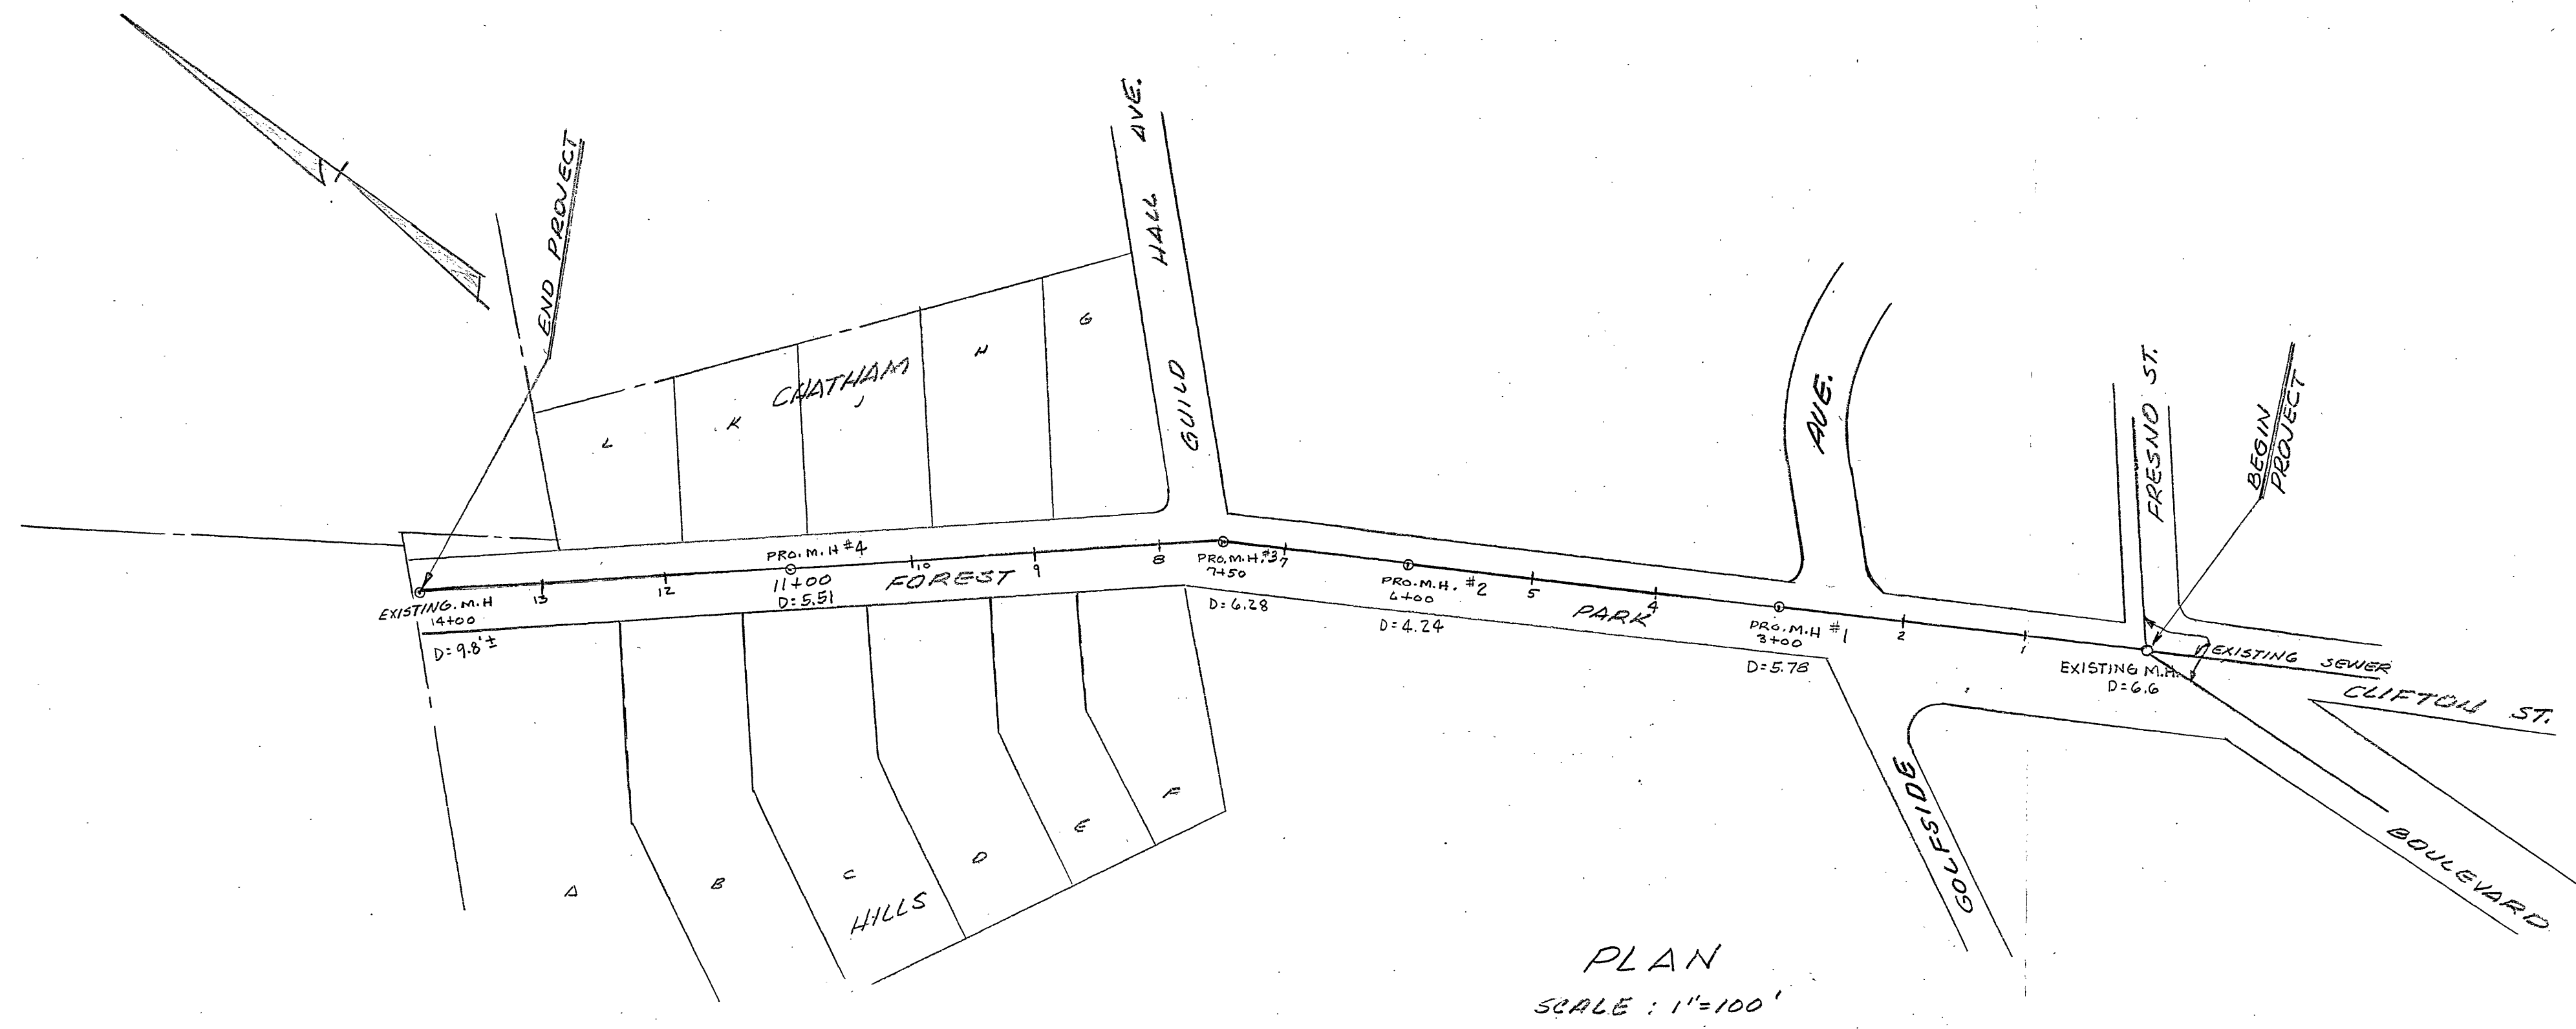

AS BUILT E.B. 329-PG. 11-
E.B. 317-PG. 68-69
OFFICE OF CITY ENGINEER
ROANOKE, VIRGINIA

PROFILE
OF
PROPOSED SANITARY SEWER
EXTENSION ON FOREST PARK
BLVD. WEST OF FRESNO ST.

SCALE: AS SHOWN
DATE: 6-9-55

APPROVED:
H. C. B. [Signature]
CITY ENGINEER

PROFILE No. 1511