
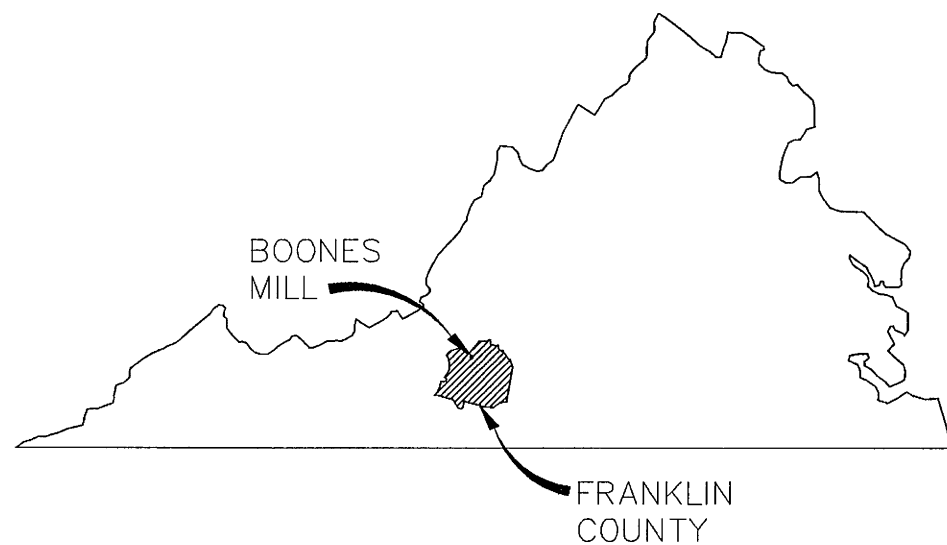


TOWN OF BOONES MILL
WATER SYSTEM REPLACEMENT, VOLUME 1-ASBUILT
TOWN OF BOONES MILL, BOONE DISTRICT, FRANKLIN COUNTY, VIRGINIA

- PROPOSED LEGEND**
- WATER METER
 - WATER LINE
 - BLOW OFF ASSEMBLY
 - AIR RELEASE
 - FIRE HYDRANT
 - CONCRETE ANCHOR
 - GATE VALVE
 - STEEL CASING
 - SLOPE ANCHOR
 - E.O.L. END OF LINE
- EXISTING LEGEND**
- ELECTRIC POLE
 - GUY WIRE
 - UTILITY PEDESTAL
 - LIGHT POLE
 - EDGE OF PAVEMENT
 - EDGE OF GRAVEL
 - BENCHMARK
 - SIGN
 - CONCRETE PAD
 - EDGE OF WOODS
 - EXISTING FENCE LINE
 - OVERHEAD ELECTRIC
 - UG ELECTRIC LINE
 - UG GAS LINE
 - UG TELEPHONE LINE
 - UG FIBER OPTIC LINE
 - UG WATER LINE
 - DITCH LINE

VIRGINIA UNIFORM CODING SYSTEM FOR EROSION
AND SEDIMENT CONTROL PRACTICES
* CHART TAKEN FROM THE VIRGINIA EROSION AND
SEDIMENT CONTROL HANDBOOK (JULY 1992)

- SF SILT FENCE
- TS TEMPORARY SEEDING
- PS PERMANENT SEEDING
- MU MULCHING
- CE TEMPORARY CONSTRUCTION
ENTRANCE
- CIP CULVERT INLET PROTECTION
- IP INLET PROTECTION
- B/M BLANKET MATTING
- SR SURFACE ROUGHING
- OP OUTLET PROTECTION

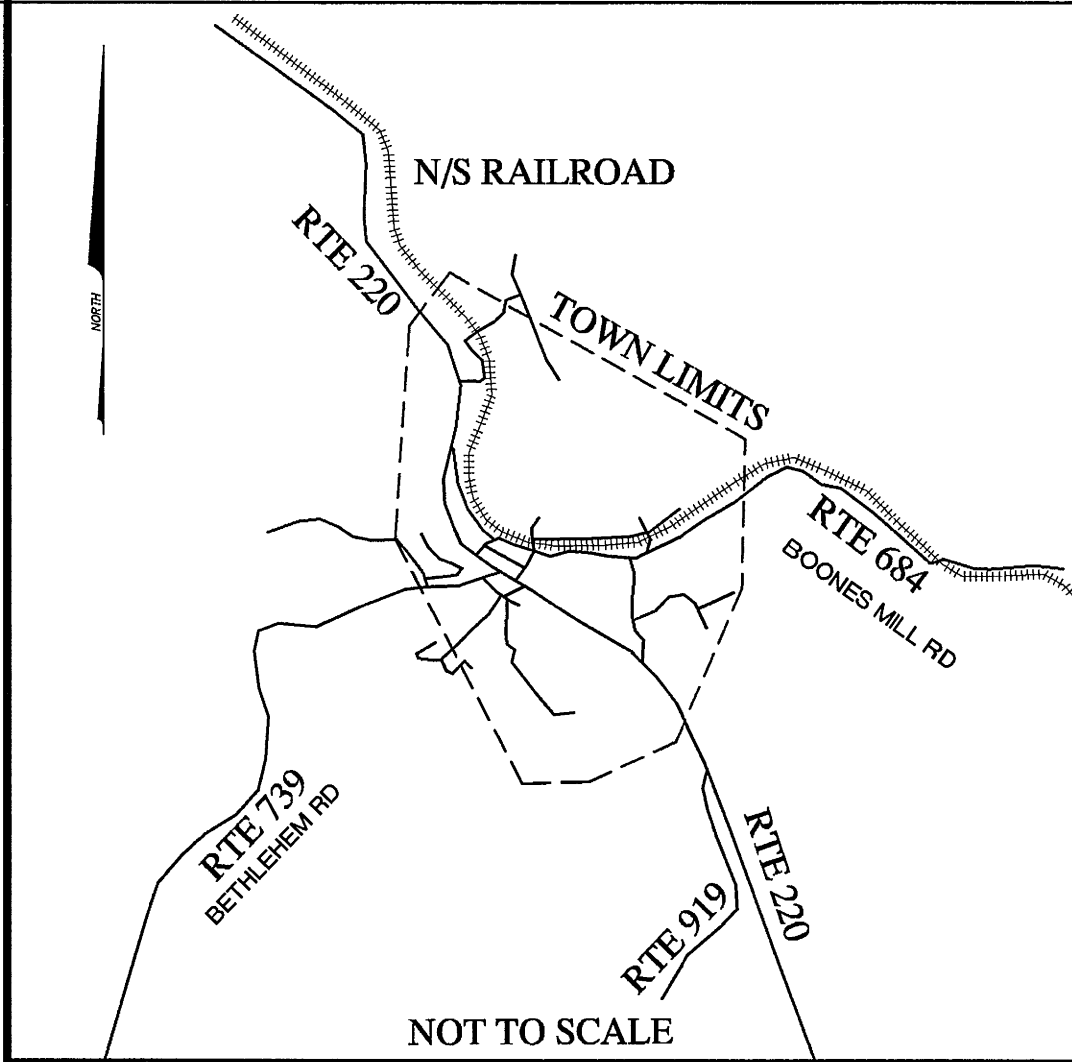

SHEET INDEX

C0.0	COVER SHEET
C0.1	NOTES
C0.2	PROJECT MAP
C0.3	E&S NARRATIVE AND DETAILS
WL-100.00	HEATHERWOOD LANE STA. 10+00-17+61± EOL
WL-200.00	MOUNTAINAIRE LANE STA. 10+00-17+46± EOL
WL-300.00	OAKWOOD DRIVE STA. 10+00-22+52± EOL
WL-400.00	DOGWOOD HILL ROAD STA. 10+00-21+00
WL-400.01	DOGWOOD HILL ROAD STA. 21+00-34+60± EOL
WL-500.00	WINDING WAY STA. 10+00-23+00±
WL-500.01	WINDING WAY STA. 23+00-32+00±
WL-500.02	WINDING WAY STA. 32+00-45+00±
WL-500.03	WINDING WAY STA. 45+00-58+00±
WL-500.04	WINDING WAY STA. 58+00-66+96± EOL
WL-600.00	EASY STREET STA. 10+00-15+30± EOL
WL-700.00	BOONES MILL ROAD STA. 10+00-21+68
WL-800.00	WHISPERING CREEK ROAD STA. 10+00-18+00
WL-800.01	WHISPERING CREEK ROAD STA. 18+00-25+26± EOL
WL-900.00	TURNER LANE STA. 10+00-21+10± EOL
WL-1000.00	LEANING OAK STA. 10+00-24+47± EOL
WL-1	WATER LINE DETAILS
WL-2	WATER LINE DETAILS
M1.0	METER MAP 1
M2.0	METER MAP 2
M3.0	METER MAP 3
M4.0	METER MAP 4
M5.0	METER MAP 5
M6.0	METER MAP 6
M7.0	METER MAP 7

HURT & PROFFITT
INCORPORATED
2524 LANGHORNE ROAD
LYNCHBURG, VA 24501
800.242.4906 TOLL FREE
434.847.7796 MAIN
434.847.0047 FAX

COVER SHEET-ASBUILT
FOR
TOWN OF BOONES MILL WATER SYSTEM REPLACEMENT, VOLUME 1
TOWN OF BOONES MILL, BOONE DISTRICT, FRANKLIN COUNTY, VA

PROJECT NO. 20080815
G.L. NO. 297-03-A3.9
FILE NO. G-12675
DATE: 7/31/09
DRAWN BY: WCH
CHECKED BY: BLC

HURT & PROFFITT

SHEET NO.
C0.0

#	DATE	DESCRIPTION OF REVISION	SHEETS
1	8/28/09	VDH COMMENTS	ALL
2	9/3/09	OWNER COMMENTS	ALL
3	2/17/10	REVISED ALIGNMENT	WL-500.00, 600.00, 700.00
4	3/14/12	ASBUILTS	ALL

Mar 14, 2012 - 10:24am V:\Vop\Projects\20080815\data\Asbuilt\W1-ASBUILT-Cover-W1.dwg

THE ENGINEER AND/OR SURVEYOR TAKES NO RESPONSIBILITY FOR THE
LOCATION OR ACCURACY OF THE UTILITIES AS SHOWN HEREON OR ANY
UTILITIES WITHIN THE PROJECT THAT MAY NOT BE SHOWN HEREON. THE
CONTRACTOR SHALL BE RESPONSIBLE FOR CONTACTING THE UTILITY
COMPANIES TO SEE IF ANY UTILITIES EXIST WITHIN THE AREA OF THE
PROJECT BEFORE ANY CONSTRUCTION BEGINS. ANY COST INCURRED BY
DAMAGING ANY UTILITY WITHIN THE PROJECT SHALL BE AT THE EXPENSE
OF THE CONTRACTOR.

48 WORKING HOURS PRIOR TO STARTING THE WORK, THE CONTRACTOR
SHALL CALL MISS UTILITY AT PHONE NUMBER 811 AND ADVISE THE
NATURE AND LOCATION OF THE WORK.

