



Mar 14, 2012 - 10:26am V:\LandProj\Projects\20080815\dwg\ASBUILT-WL-ASBUILT-P-Water.dwg

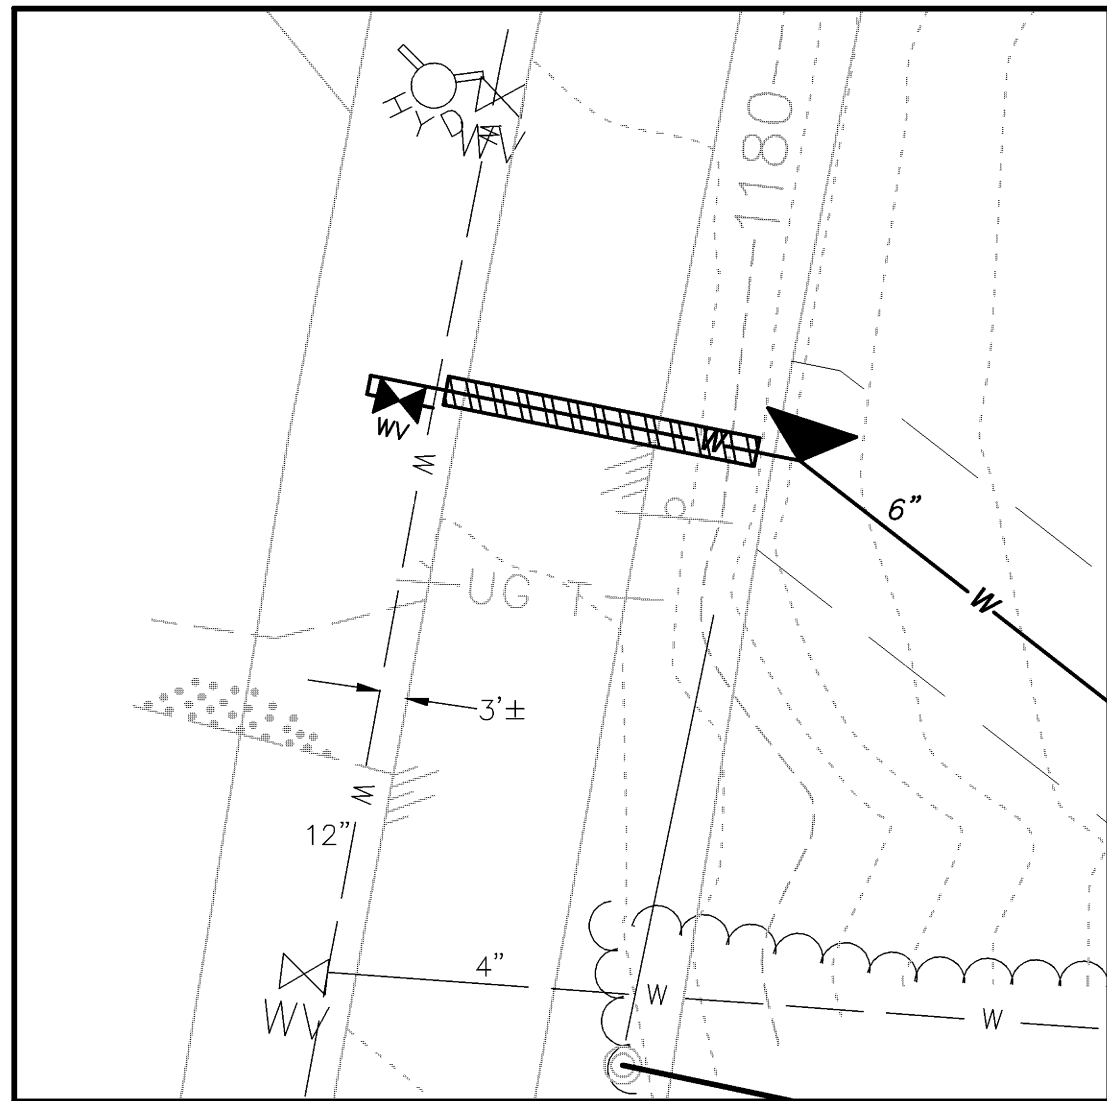

INSET 1

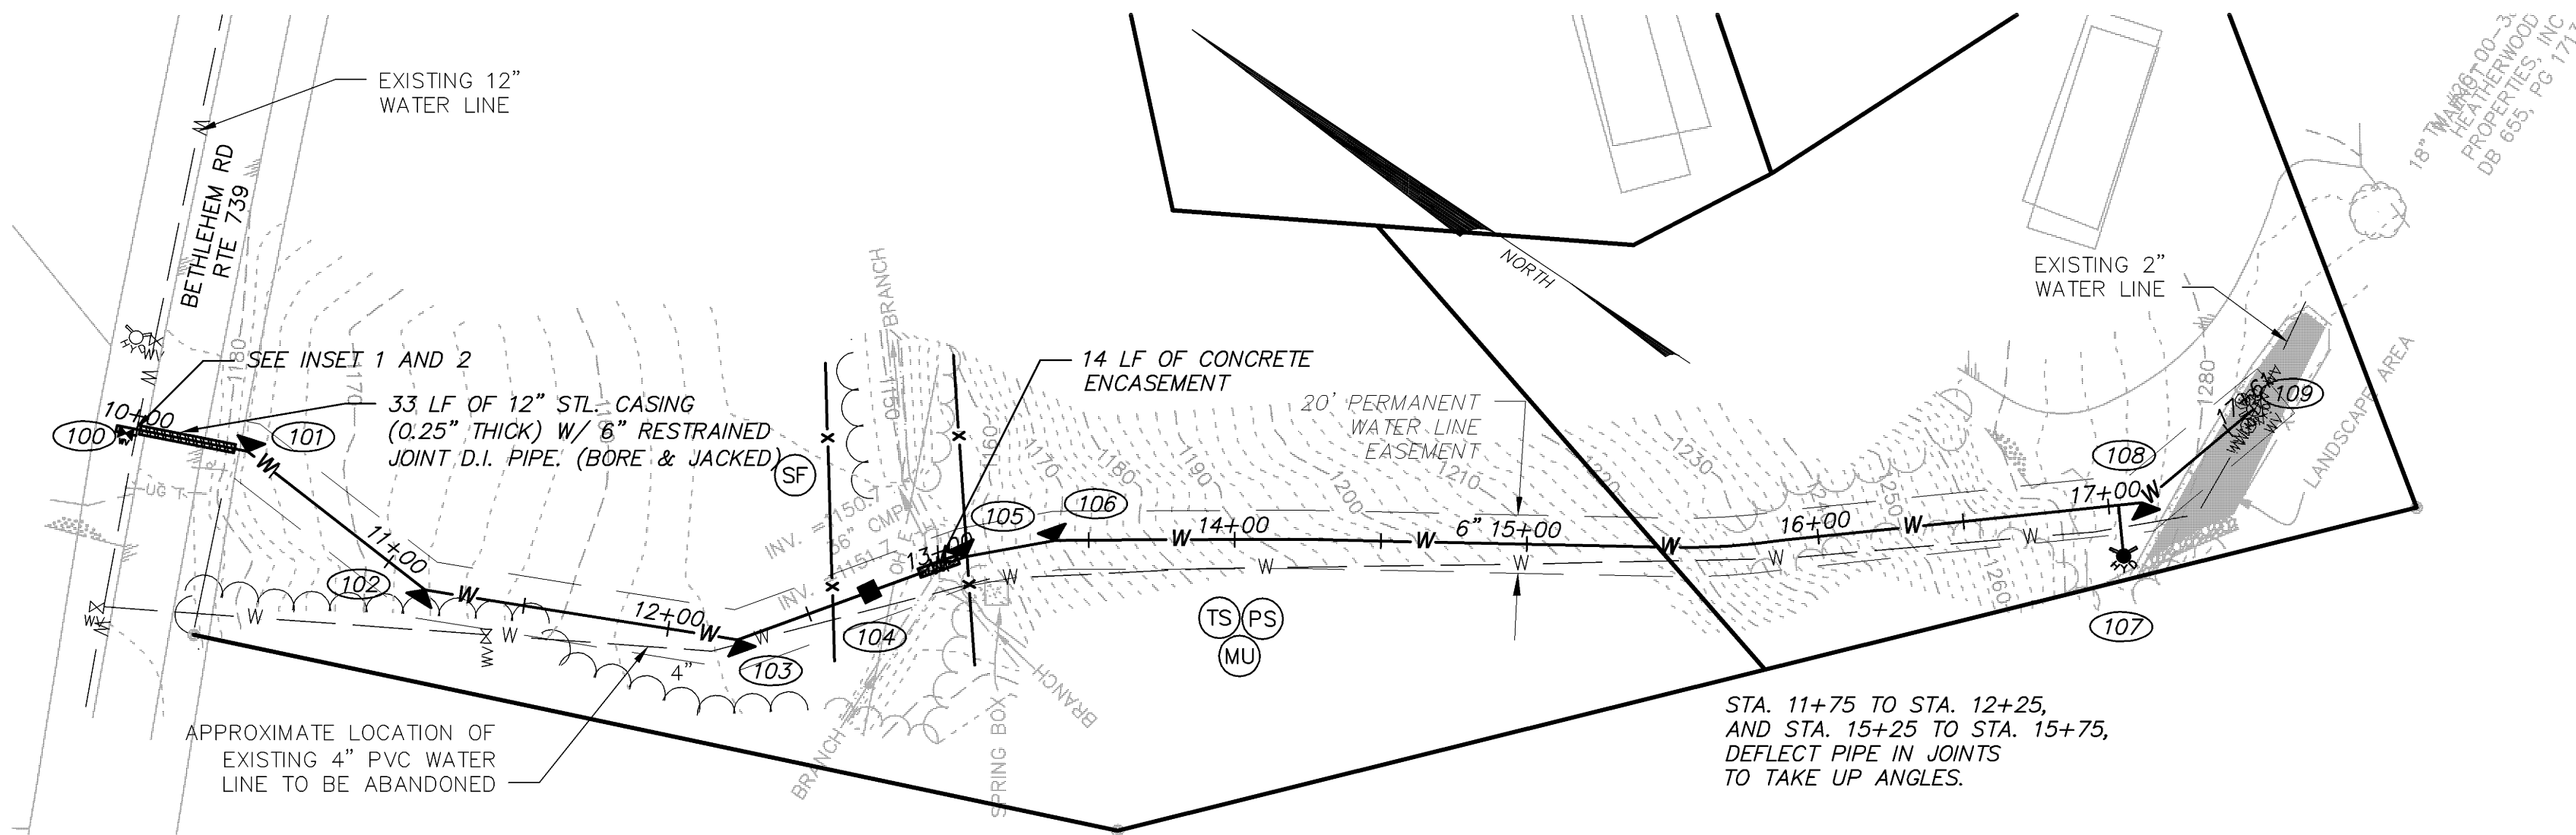


6" DIP WITH FIELD LOK GASKETS AND MEGALUGS
ON VALVES/FITTINGS FROM:
STA. 10+00 - 10+48
STA. 13+00 - 17+61


6" PVC WITH BELL RESTRAINTS FROM:
STA. 10+48 - 11+07

PROFILE INFORMATION TAKEN FROM RECORD DRAWINGS

LEGEND:
--- EXISTING GRADE
--- 6" C900 PVC

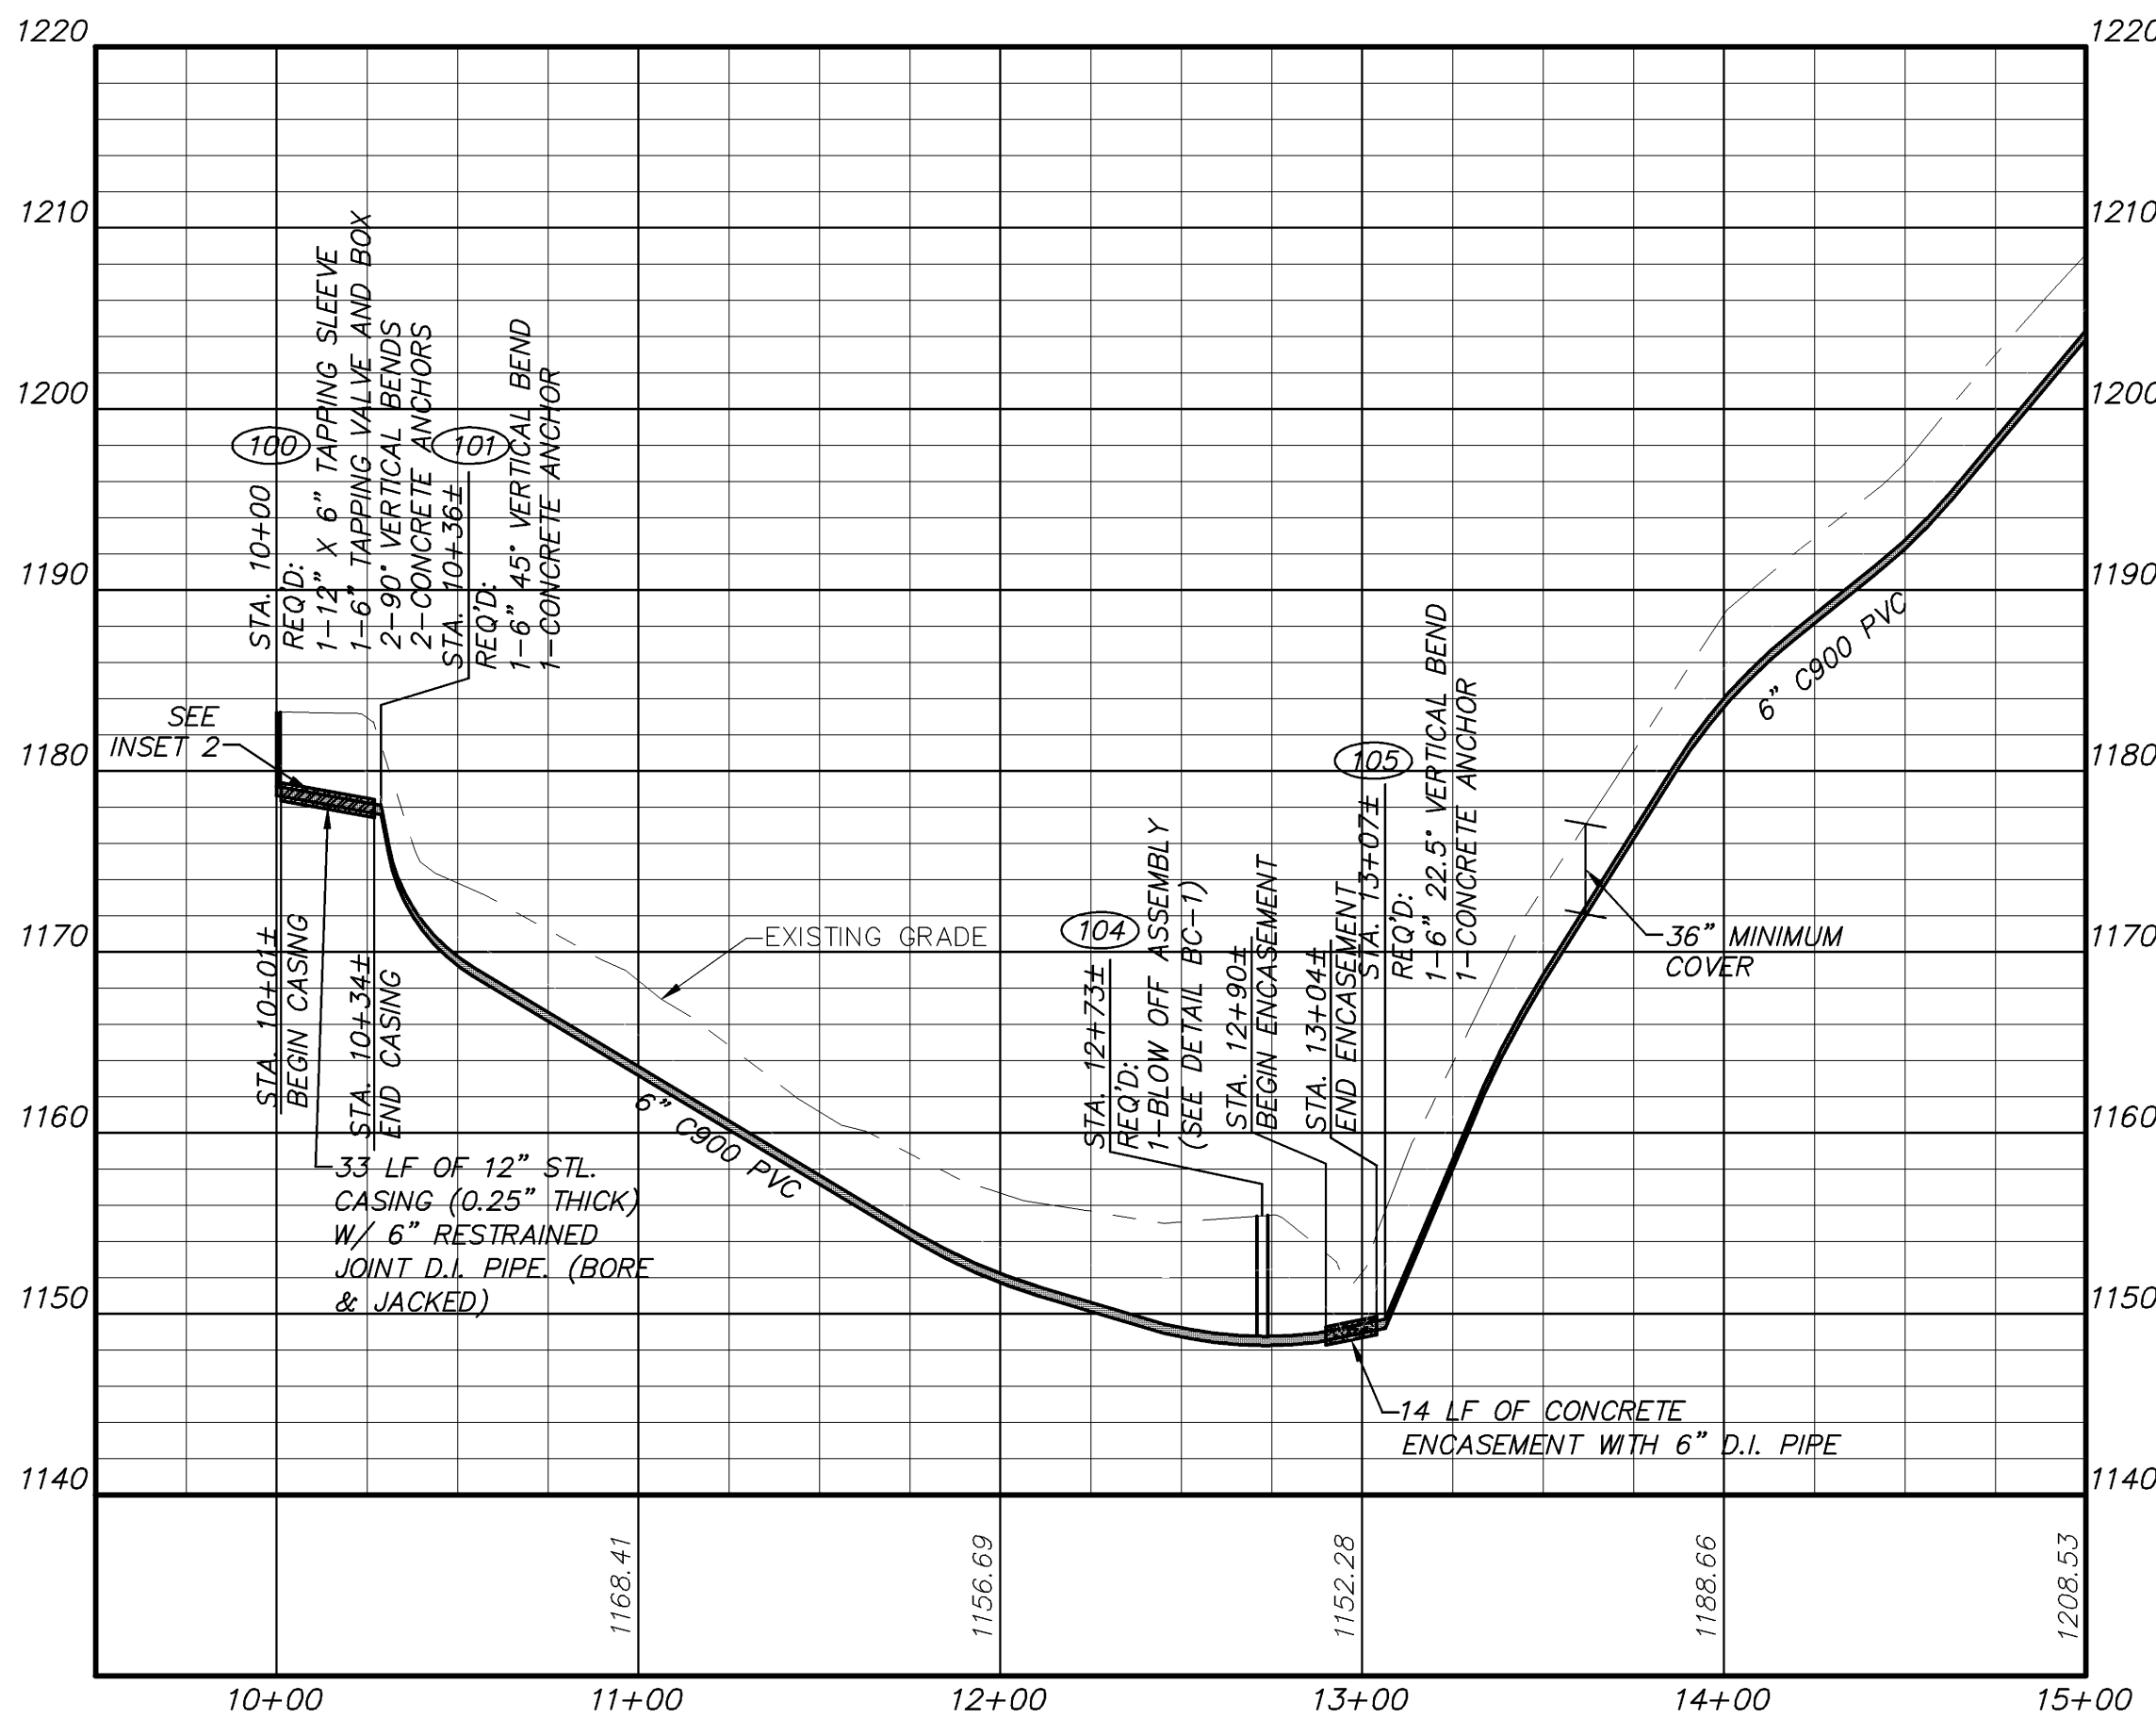

HORIZ. SCALE 1" = 50'
VERT. SCALE 1" = 10'

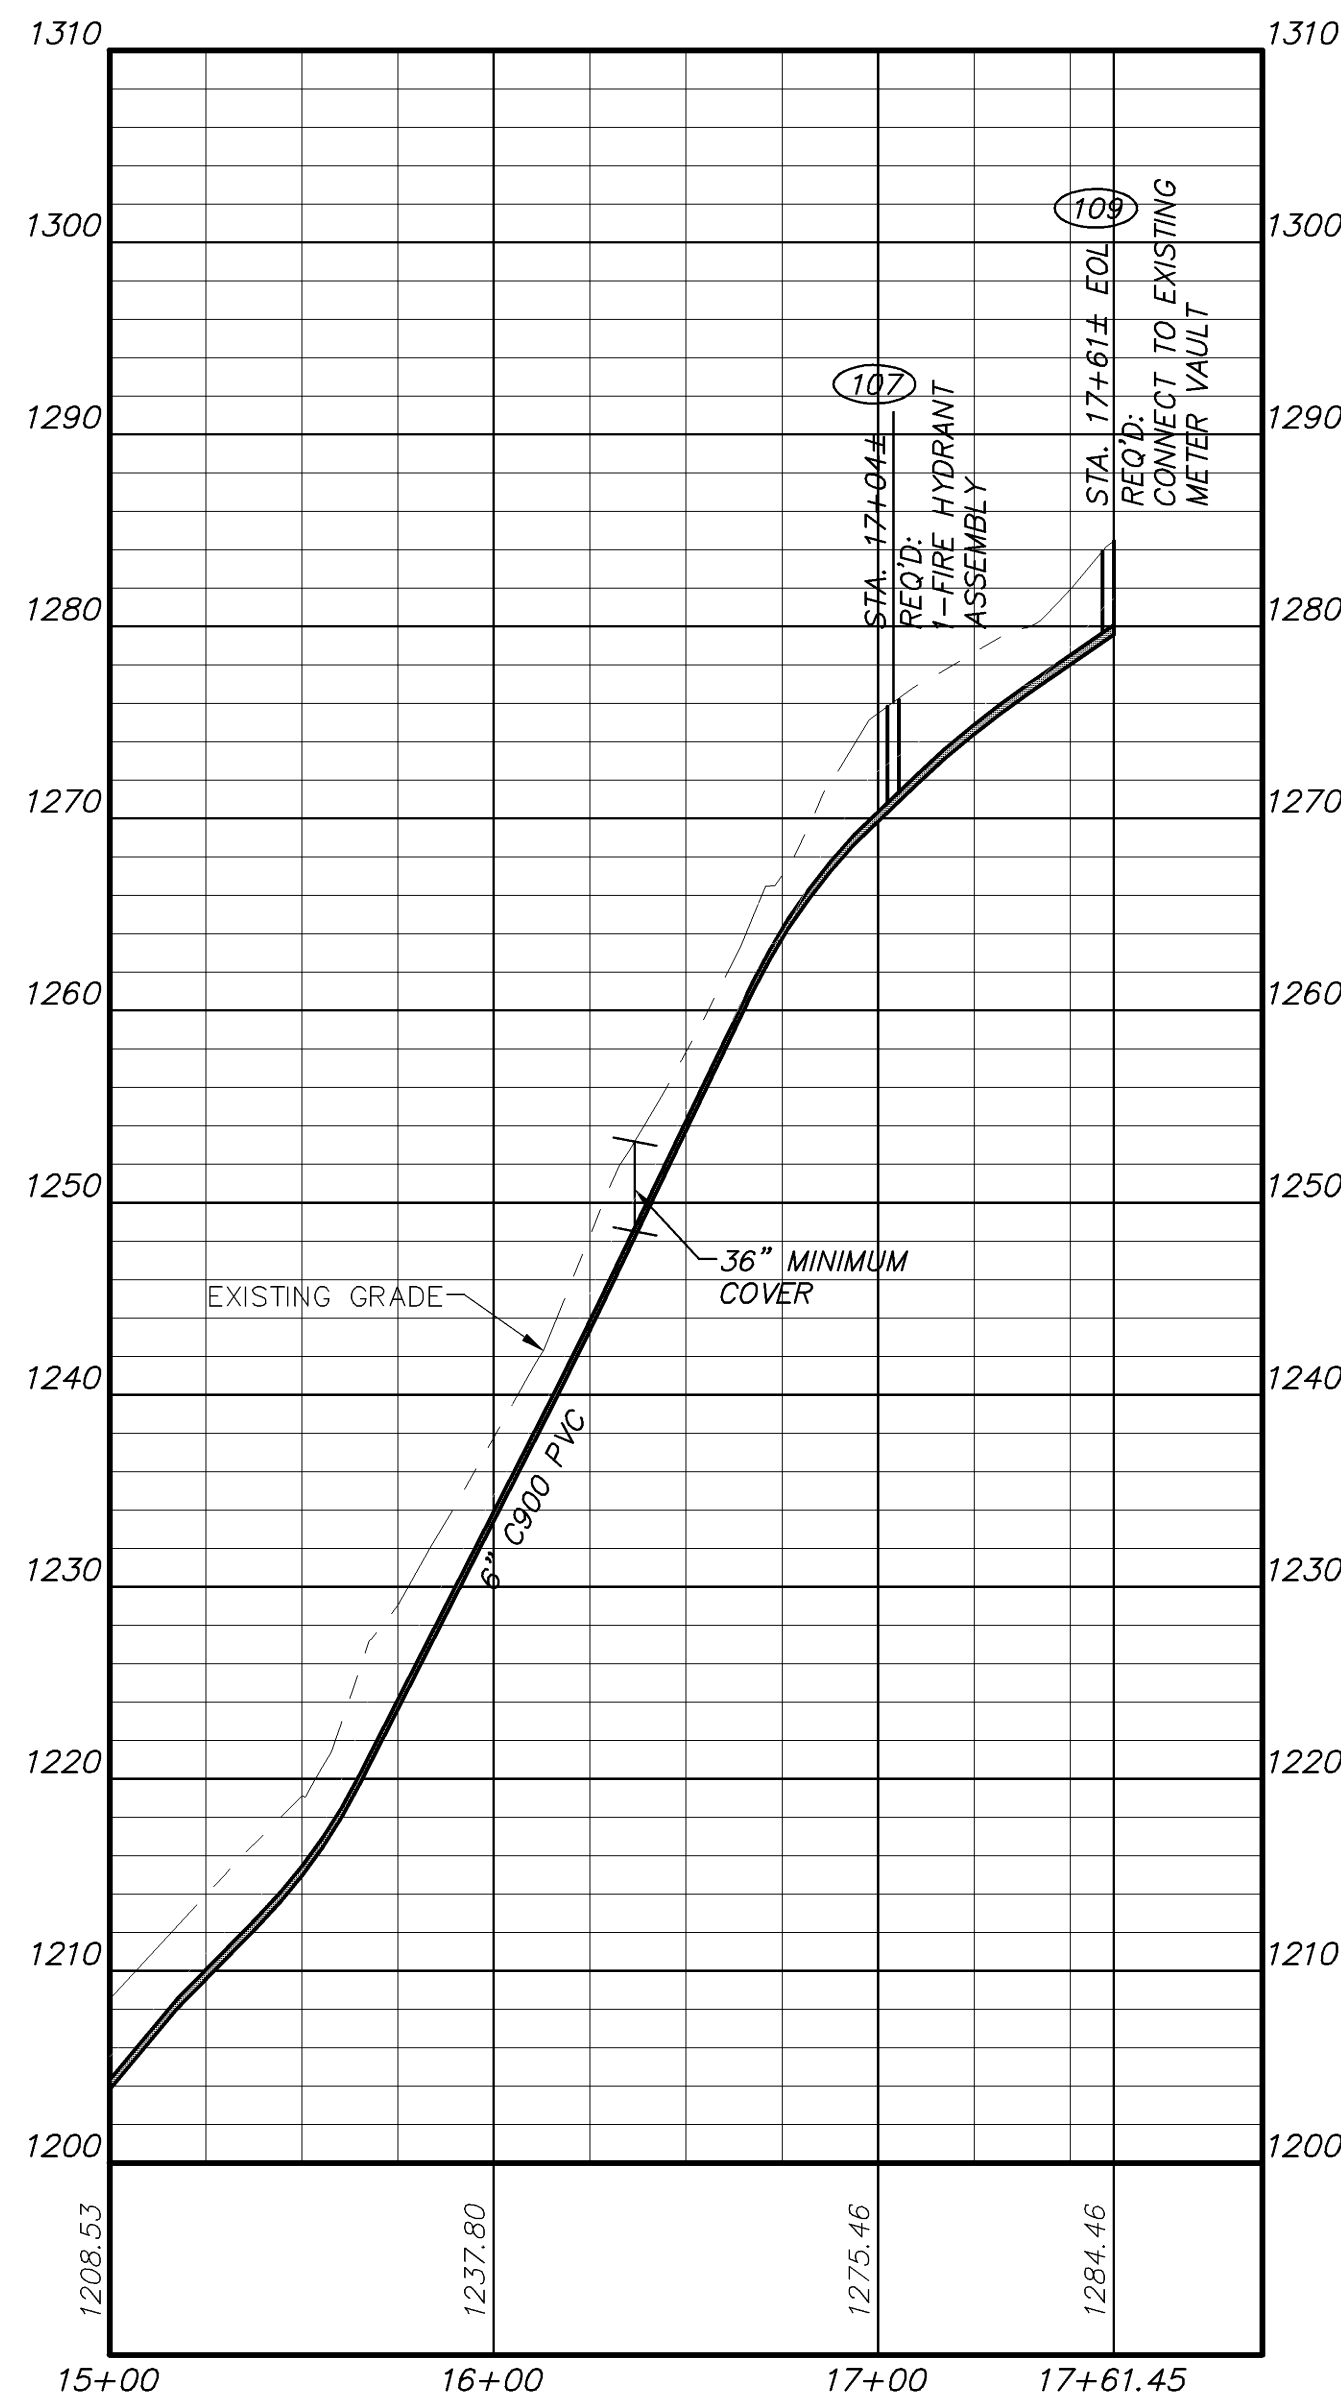

PROPOSED LEGEND

WATER METER
WATER LINE
BLOW OFF ASSEMBLY
AIR RELEASE
FIRE HYDRANT
CONCRETE ANCHOR
GATE VALVE
STEEL CASING
SLOPE ANCHOR
E.O.L. END OF LINE

EXISTING LEGEND

ELECTRIC POLE
GUY WIRE
UTILITY PEDESTAL
LIGHT POLE
EDGE OF PAVEMENT
EDGE OF GRAVEL
BENCHMARK
SIGN
CONCRETE PAD
EDGE OF WOODS
EXISTING FENCE LINE
OVERHEAD ELECTRIC
UG ELECTRIC LINE
UG GAS LINE
UG TELEPHONE LINE
UG FIBER OPTIC LINE
UG WATER LINE
DITCH LINE

- 100 STA. 10+00
REQ'D:
1-12" X 6" TAPPING SLEEVE
1-6" TAPPING VALVE AND BOX
2-90° VERTICAL BENDS
2-CONCRETE ANCHORS
- 101 STA. 10+36±
REQ'D:
2-6" 90° VERTICAL BEND
2-CONCRETE ANCHOR
- 102 STA. 11+15±
REQ'D:
1-6" 22.5° BEND
1-CONCRETE ANCHOR
- 103 STA. 12+24±
REQ'D:
1-22.5° BEND
1-CONCRETE ANCHOR
- 104 STA. 12+73±
REQ'D:
1-BLOW OFF ASSEMBLY
(SEE DETAIL BC-1)
- 105 STA. 13+07±
REQ'D:
1-6" 22.5° VERTICAL BEND
1-CONCRETE ANCHOR
- 106 STA. 13+39±
REQ'D:
1-6" 11.25° BEND
1-CONCRETE ANCHOR
- 107 STA. 17+04±
REQ'D:
1-FIRE HYDRANT ASSEMBLY
- 108 STA. 17+11±
REQ'D:
1-6" 45° BEND
1-CONCRETE ANCHOR
- 109 STA. 17+61± EOL
REQ'D:
CONNECT TO EXISTING
METER VAULT

*ENGINEERING & SURVEYING >> PLANNING

HURT & PROFFITT
INCORPORATED

2524 LANGHORNE ROAD
LYNCHBURG VA 24501
800.242.6906 TOLL FREE
434.847.7796 MAIN
434.847.0047 FAX

STA. 10+00 - 17+61± EOL HEATHERWOOD LANE-ASBUILT
FOR

TOWN OF BOONES MILL WATER SYSTEM REPLACEMENT, VOLUME 1
TOWN OF BOONES MILL, BOONE DISTRICT, FRANKLIN COUNTY, VA

PROJECT NO. 20080815
G.L. NO. 297-03-A3.9
FILE NO. G-12675
DATE: 7/31/09
DRAWN BY: WCH
CHECKED BY: BLC

HURT & PROFFITT

SHEET NO.
WL-100.00

1	8/28/09	VDH COMMENTS
2	9/3/09	OWNER COMMENTS
4	3/14/12	ASBUILTS