
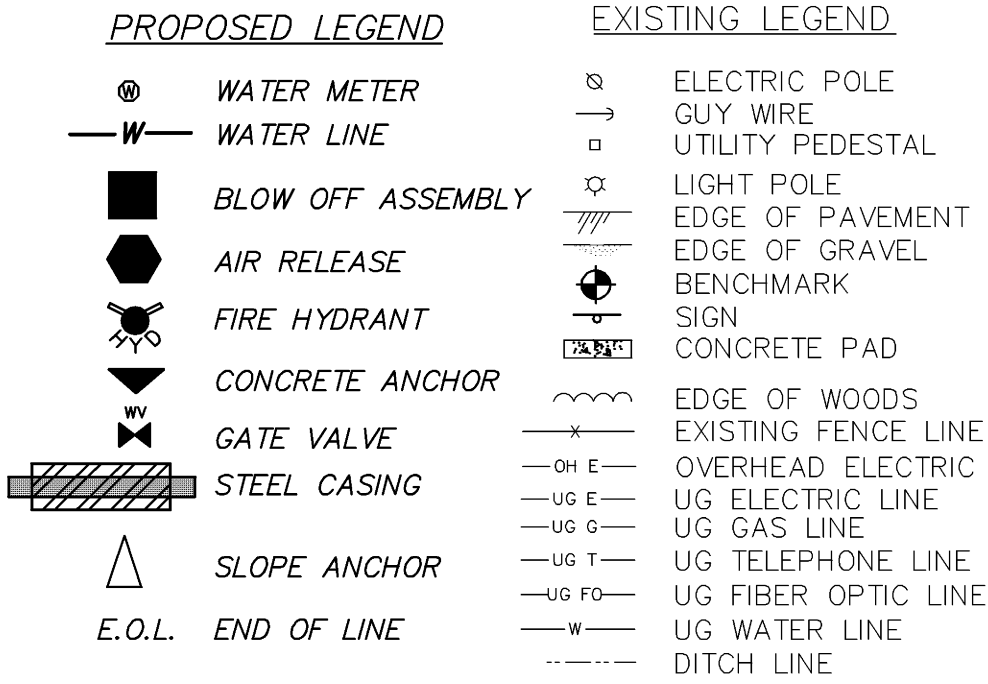
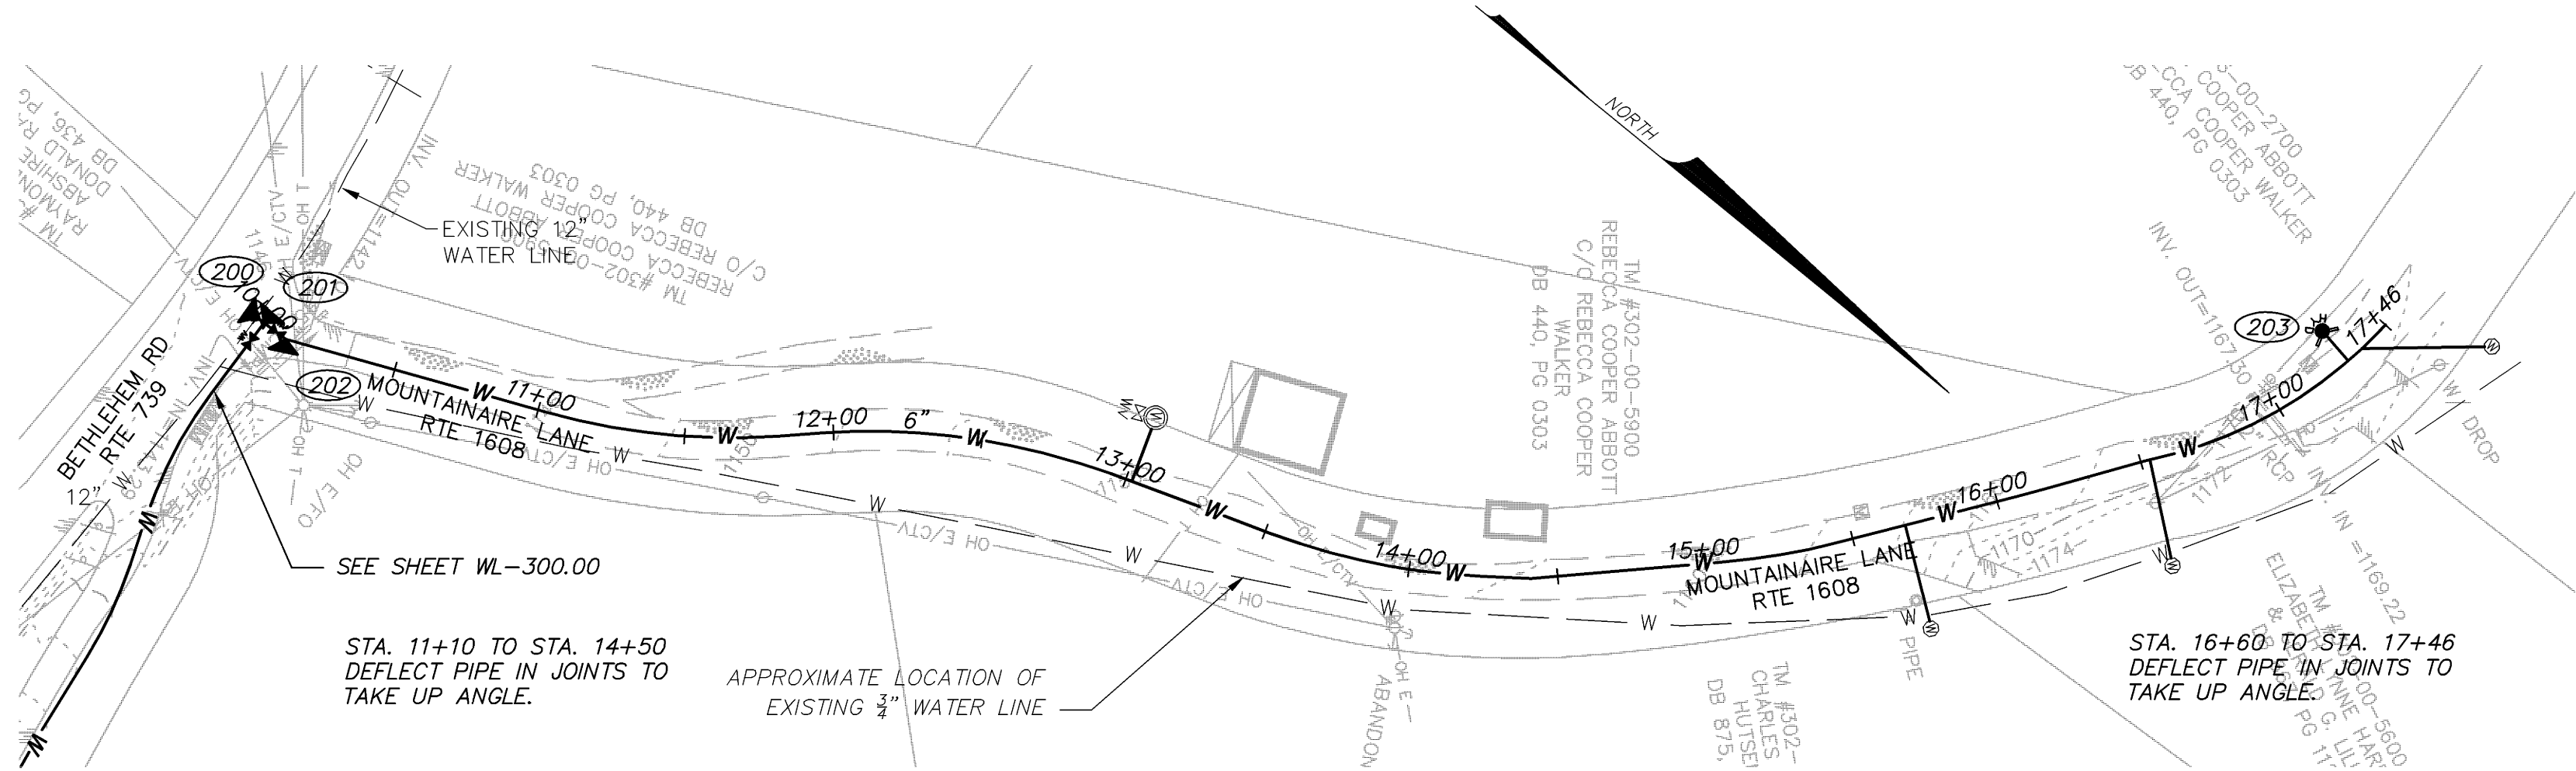
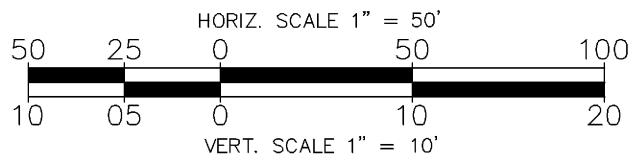
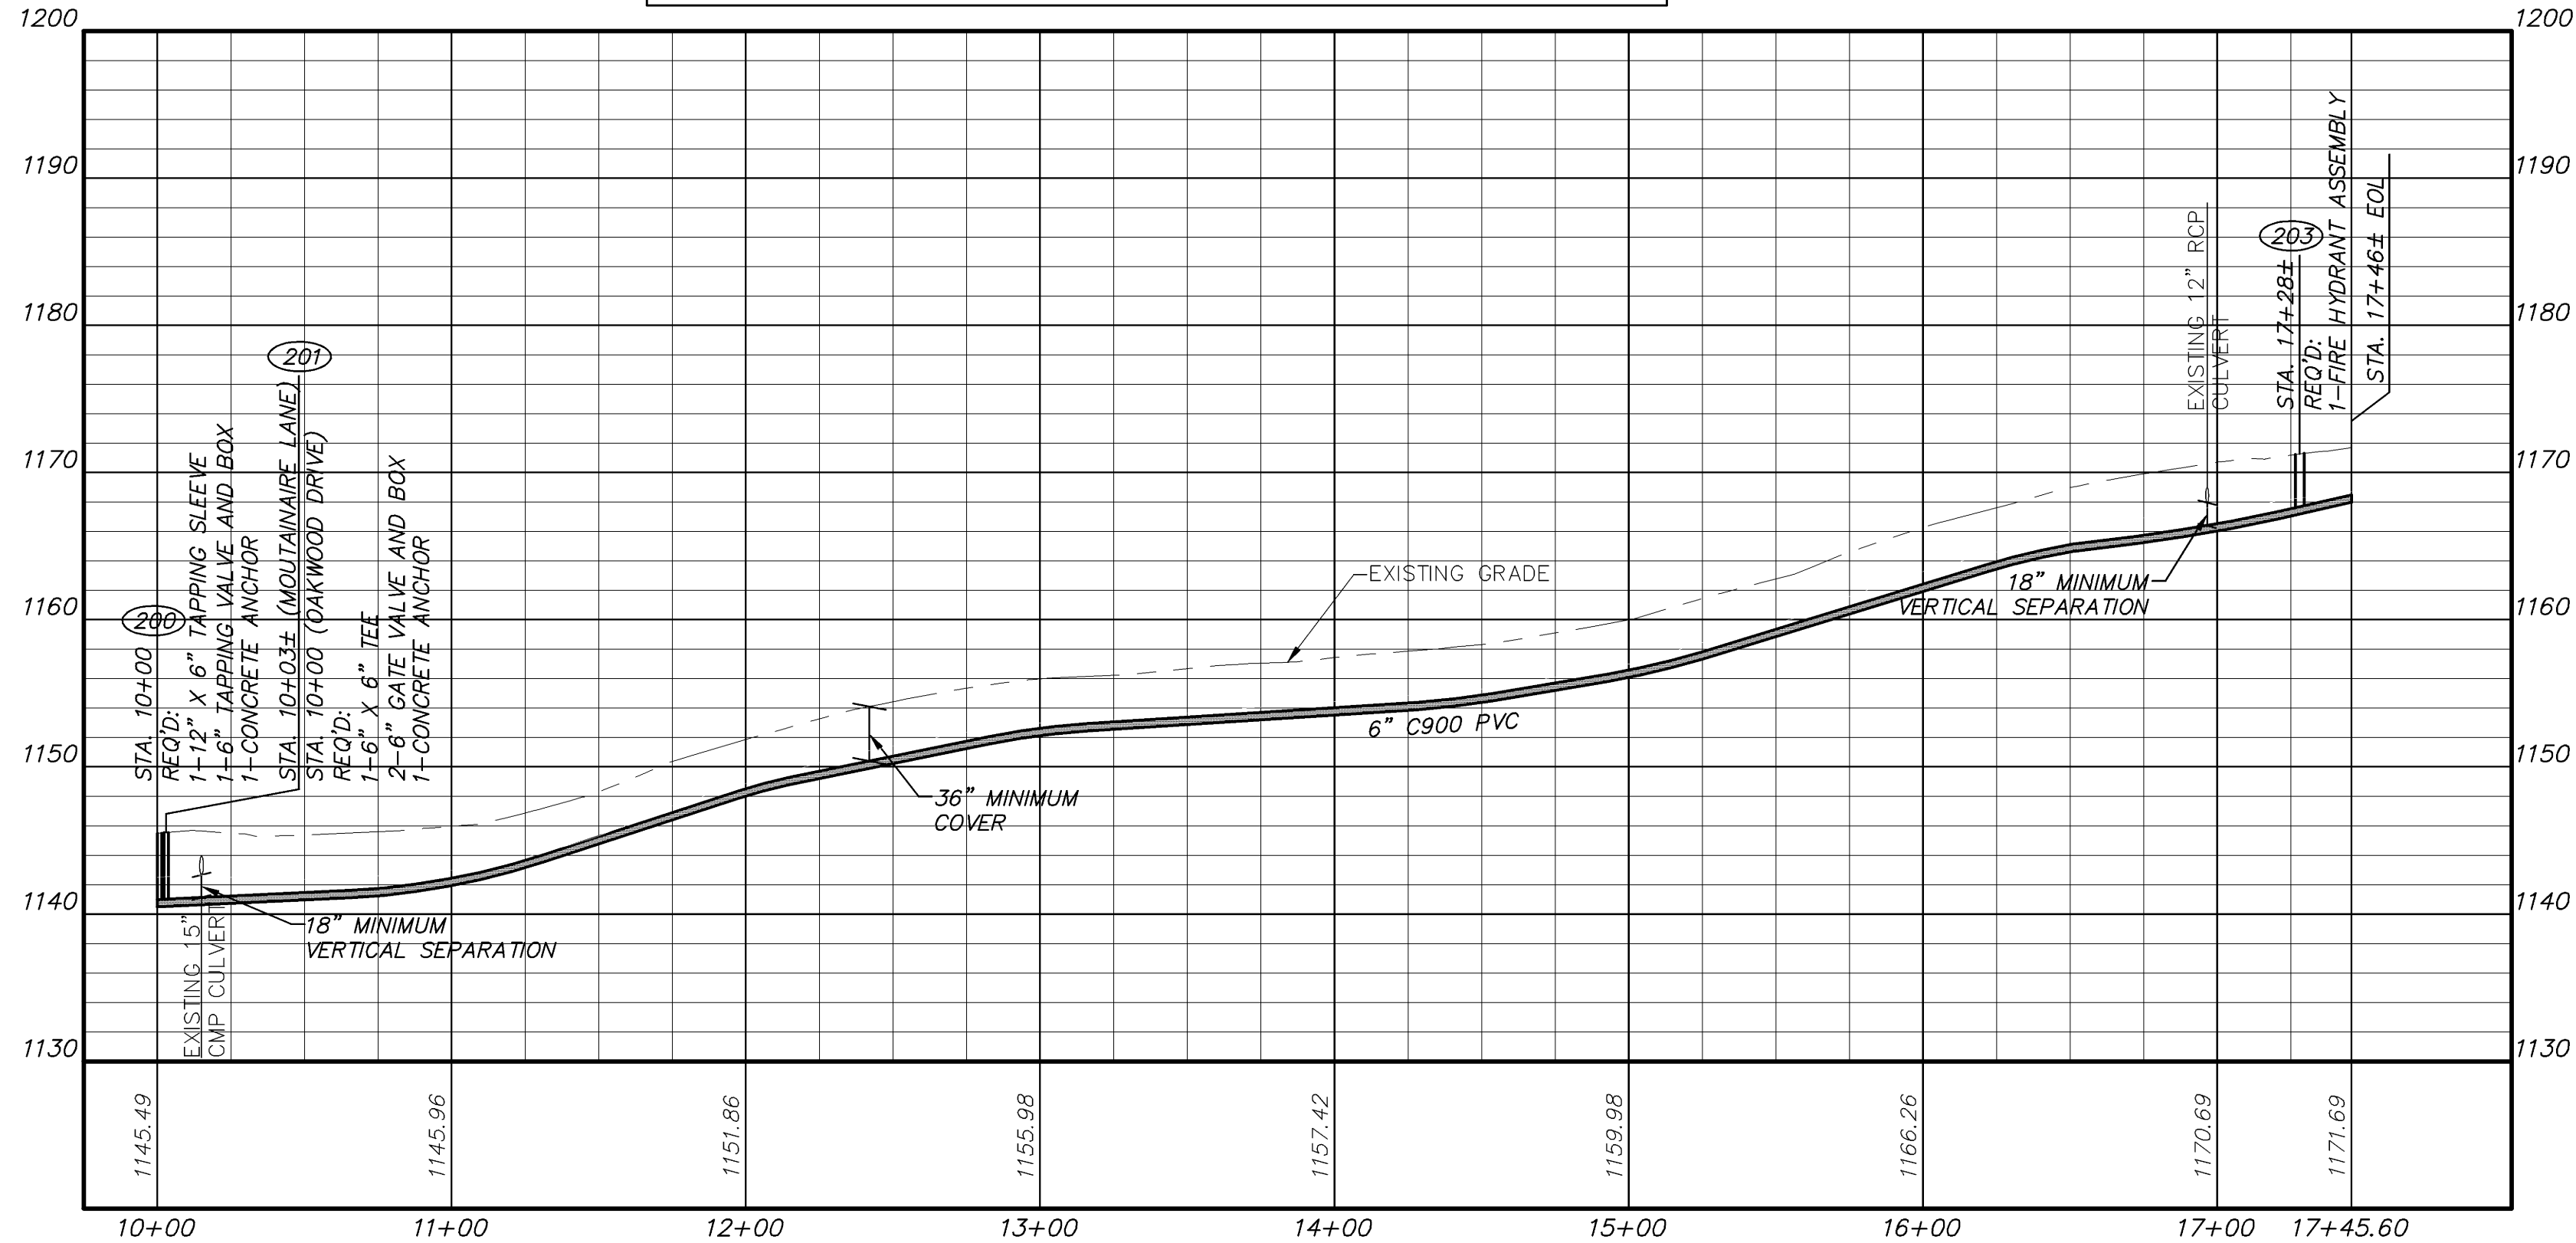


Mar 14, 2012 - 10:27am V:\LandProj\20080815.dwg\ASBUILT-P_P-Water.dwg

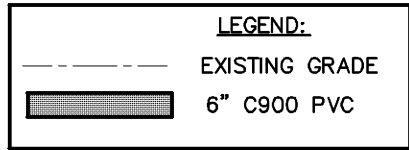

*ENGINEERING >> SURVEYING >> PLANNING

HURT & PROFFITT
INCORPORATED
2524 LANGHORNE ROAD
LYNCHBURG VA 24501
800.242.6906 TOLL FREE
434.847.7796 MAIN
434.847.0047 FAX

STA. 10+00 - 17+46± EOL MOUNTAINE LANE-ASBUILT
FOR
TOWN OF BOONES MILL WATER SYSTEM REPLACEMENT, VOLUME 1
TOWN OF BOONES MILL, BOONE DISTRICT, FRANKLIN COUNTY, VA

PROJECT NO. 20080815
G.L. NO. 297-03-A3.9
FILE NO. G-12675
DATE: 7/31/09
DRAWN BY: WCH
CHECKED BY: BLC

HURT & PROFFITT

SHEET NO.
WL-200.00

1	8/28/09	VDH COMMENTS
2	9/3/09	OWNER COMMENTS
4	3/14/12	ASBUILTS