

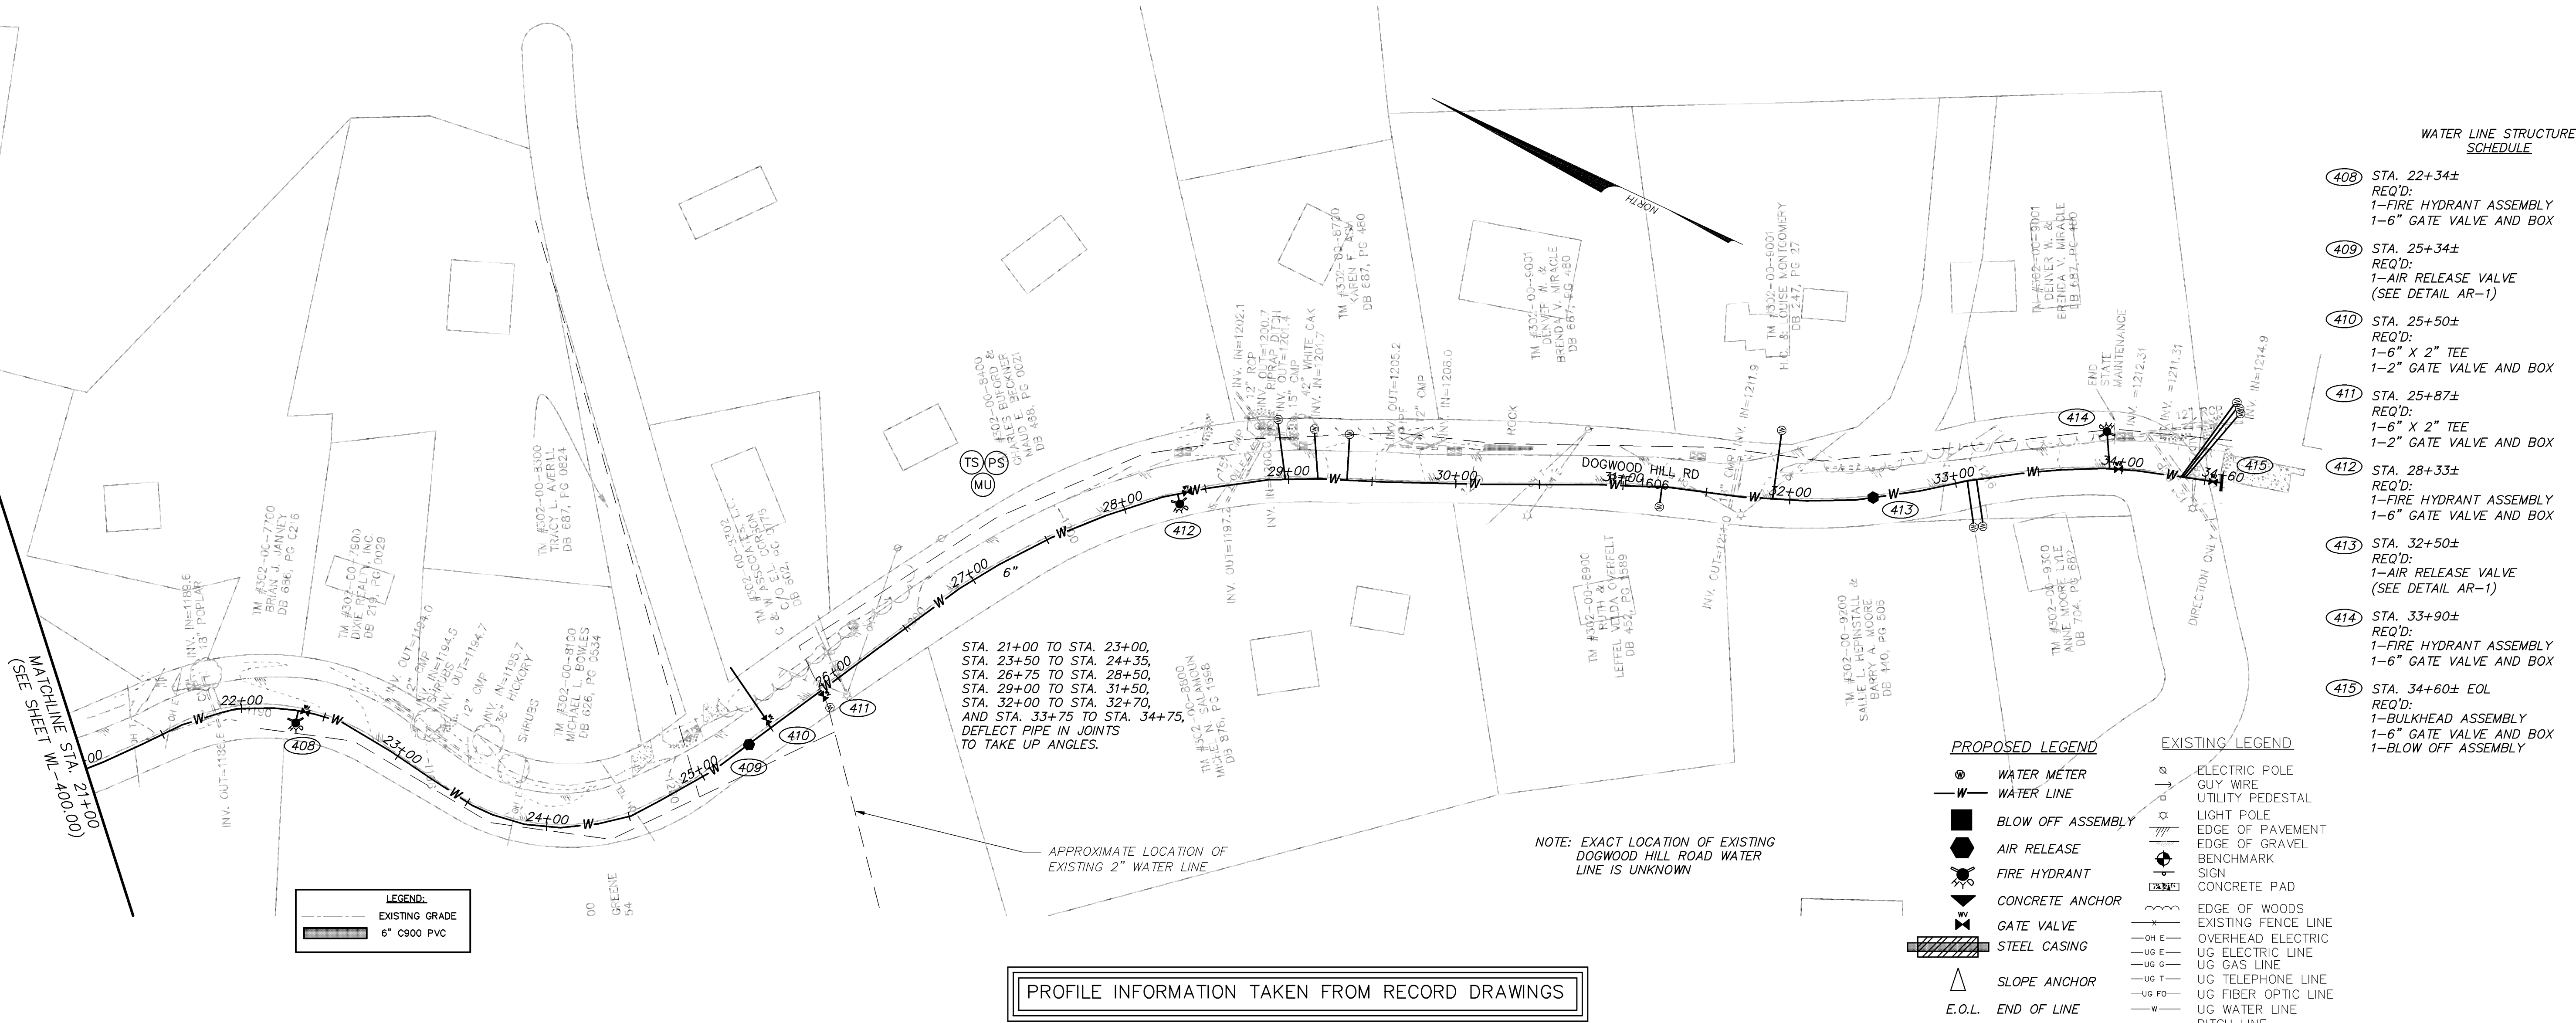


Mar 14, 2012, 10:29am V:\LandProjects\20080815.dwg\Asbults-WL-ASBULT-P-P-Water.dwg

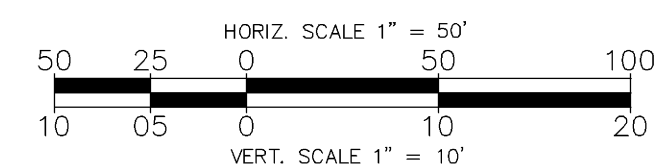

PROFILE INFORMATION TAKEN FROM RECORD DRAWINGS

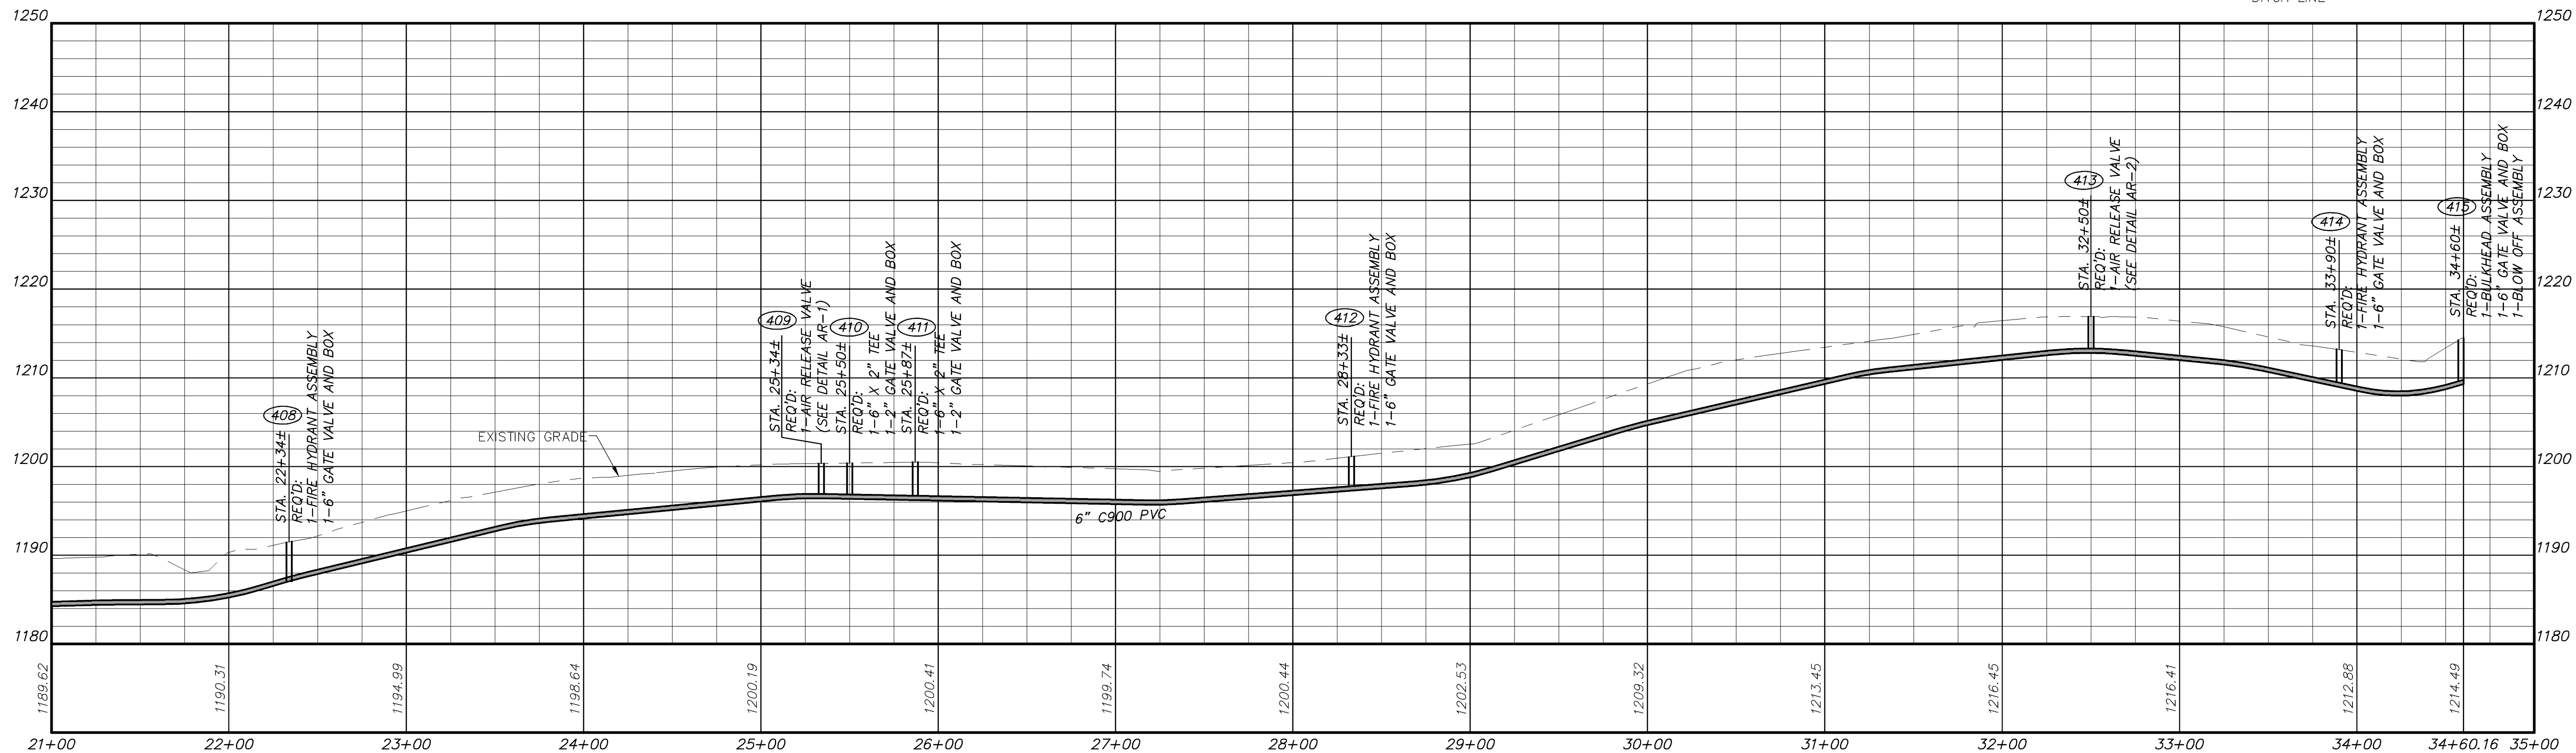

1	8/28/09	VDH COMMENTS
2	9/3/09	OWNER COMMENTS
4	3/14/12	ASBULTS

*ENGINEERING > SURVEYING > PLANNING

HURT & PROFFITT
INCORPORATED
2524 LANGHORNE ROAD
LYNCHBURG VA 24501
800.242.4906 TOLL FREE
434.847.7796 MAIN
434.847.0047 FAX

STA. 21+00 - 34+60± EOL DOGWOOD HILL ROAD-ASBULT
FOR
TOWN OF BOONES MILL WATER SYSTEM REPLACEMENT, VOLUME 1
TOWN OF BOONES MILL, BOONE DISTRICT, FRANKLIN COUNTY, VA

PROJECT NO. 20080815
G.L. NO. 297-03-A3.9
FILE NO. G-12675
DATE: 7/31/09
DRAWN BY: WCH
CHECKED BY: BLC

HURT & PROFFITT

SHEET NO.
WL-400.01