
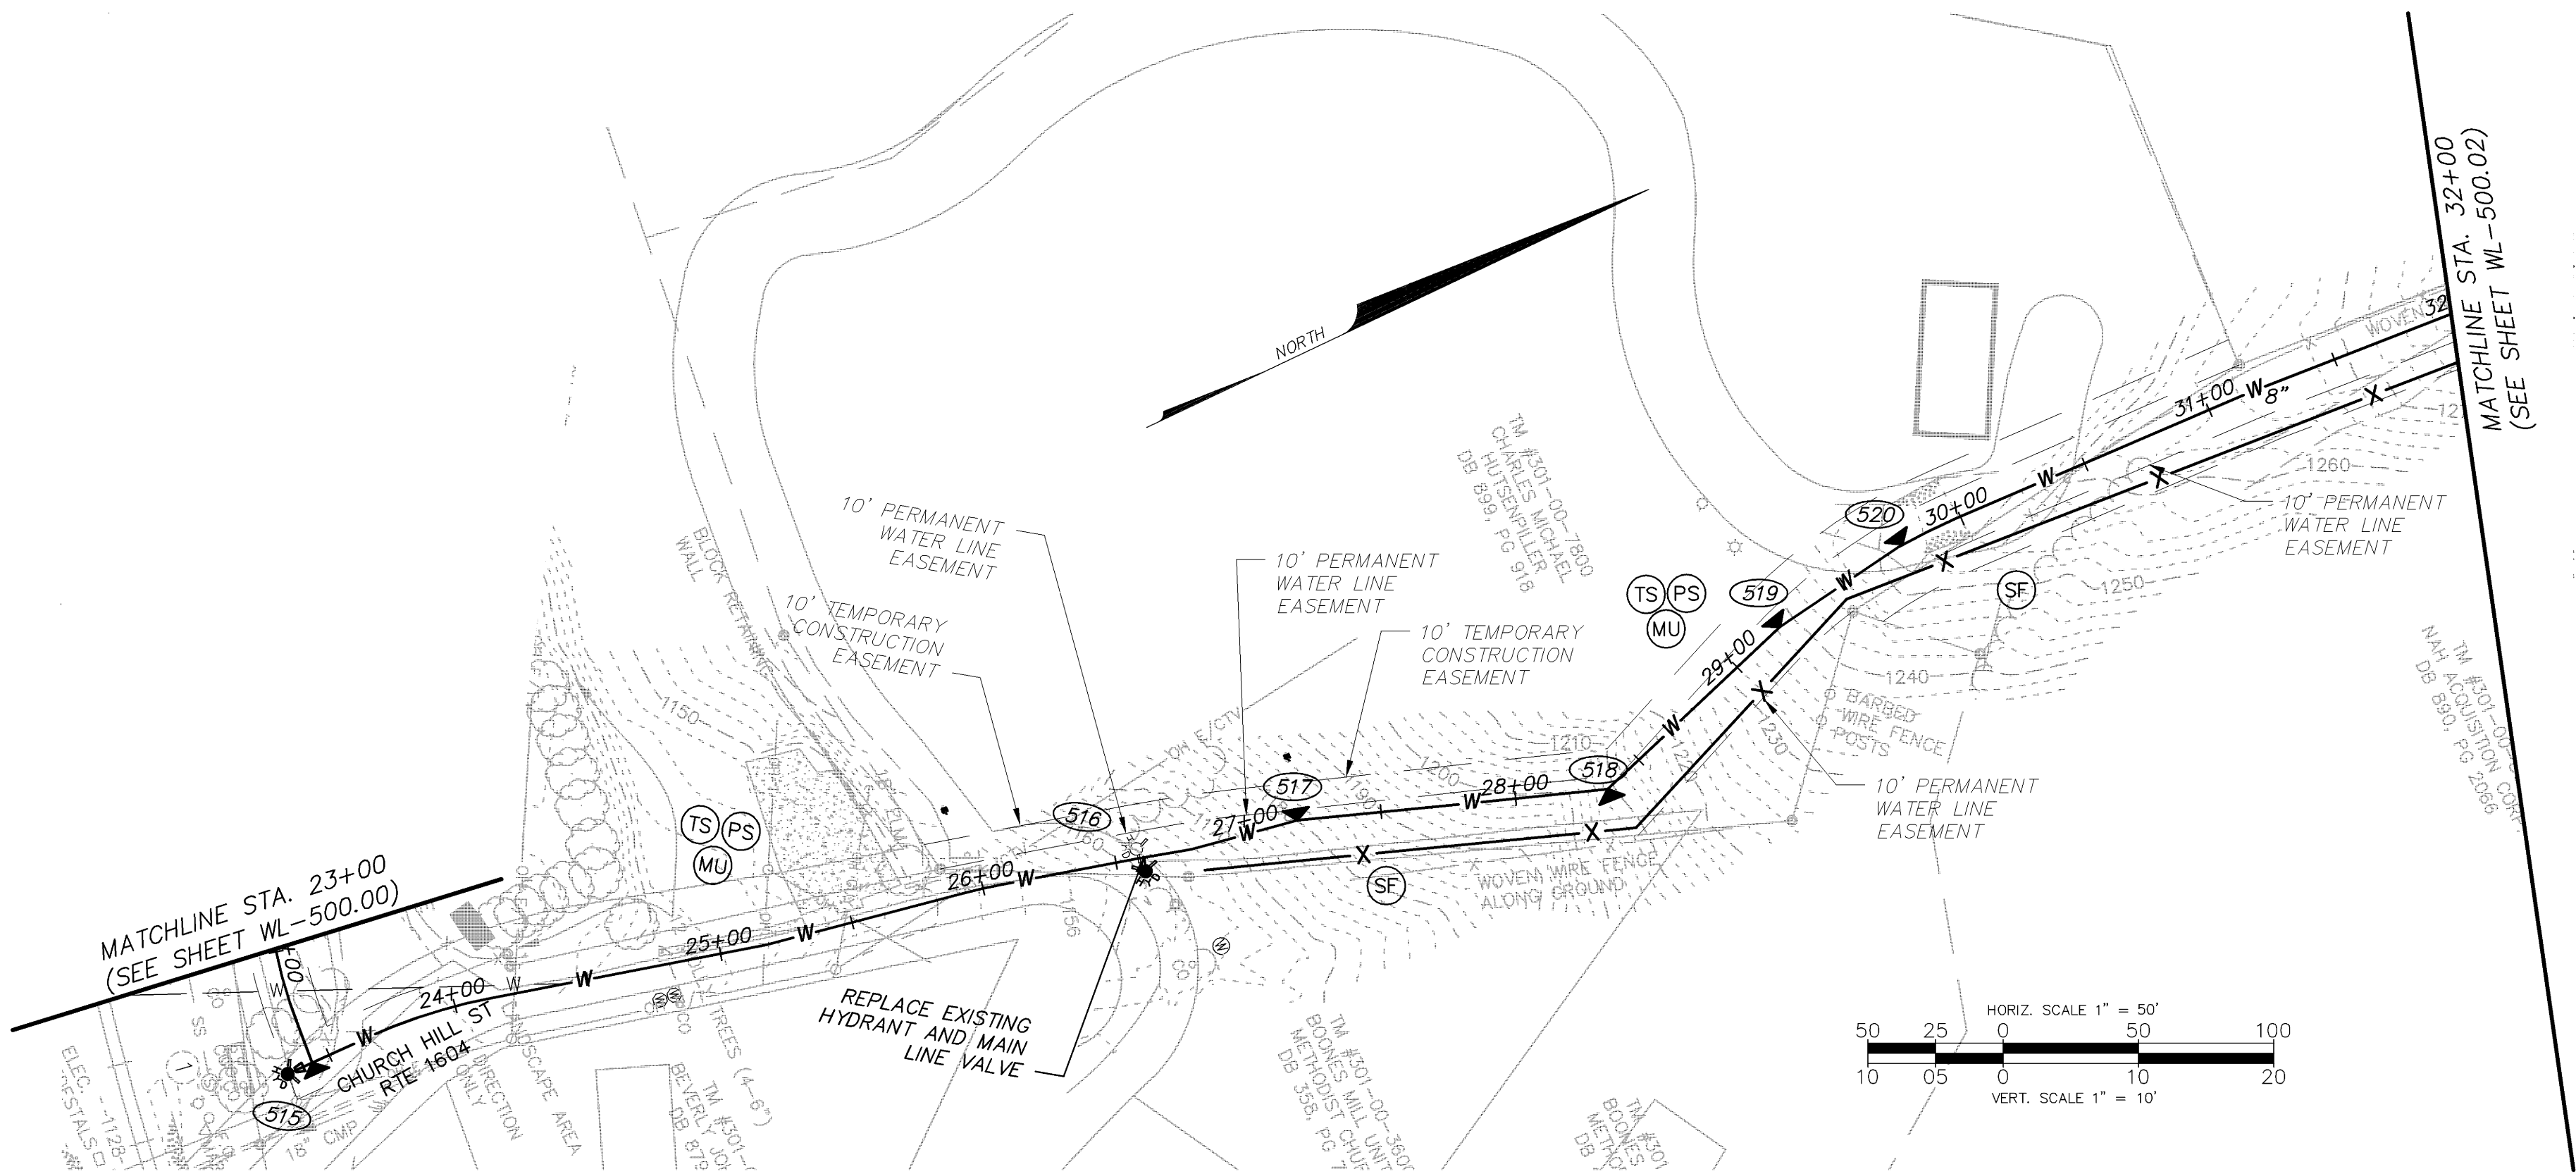


Mar 14, 2012 - 10:31am V:\LandProjects\20080815\dwg\asbuilts-WL-ASBUIL.T-P-Water.dwg

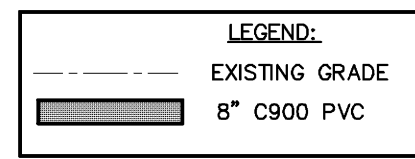

WATER LINE STRUCTURE
SCHEDULE



- (515) STA. 23+42±
REQ'D:
1-8" X 8" TEE
1-8" X 6" REDUCER
1-FIRE HYDRANT ASSEMBLY
1-CONCRETE ANCHOR
- (516) STA. 26+61±
REQ'D:
REMOVE AND DISPOSE OF EXISTING
HYDRANT ASSEMBLY
1-FIRE HYDRANT ASSEMBLY
- (517) STA. 27+19±
REQ'D:
1-8" 22.5° BEND
1- CONCRETE ANCHOR
- (518) STA. 28+34±
REQ'D:
1-8" 45° BEND
1-CONCRETE ANCHOR
- (519) STA. 29+22±
REQ'D:
1-8" 22.5° BEND
1-CONCRETE ANCHOR
- (520) STA. 29+76±
REQ'D:
1-8" 11.25° BEND
1-CONCRETE ANCHOR

EXISTING LEGEND

- ELECTRIC POLE
GUY WIRE
UTILITY PEDESTAL
LIGHT POLE
EDGE OF PAVEMENT
EDGE OF GRAVEL
BENCHMARK
SIGN
CONCRETE PAD
EDGE OF WOODS
EXISTING FENCE LINE
OVERHEAD ELECTRIC
UG ELECTRIC LINE
UG GAS LINE
UG TELEPHONE LINE
UG FIBER OPTIC LINE
UG WATER LINE
DITCH LINE

PROPOSED LEGEND

- WATER METER
WATER LINE
BLOW OFF ASSEMBLY
AIR RELEASE
FIRE HYDRANT
CONCRETE ANCHOR
GATE VALVE
STEEL CASING
SLOPE ANCHOR
E.O.L. END OF LINE

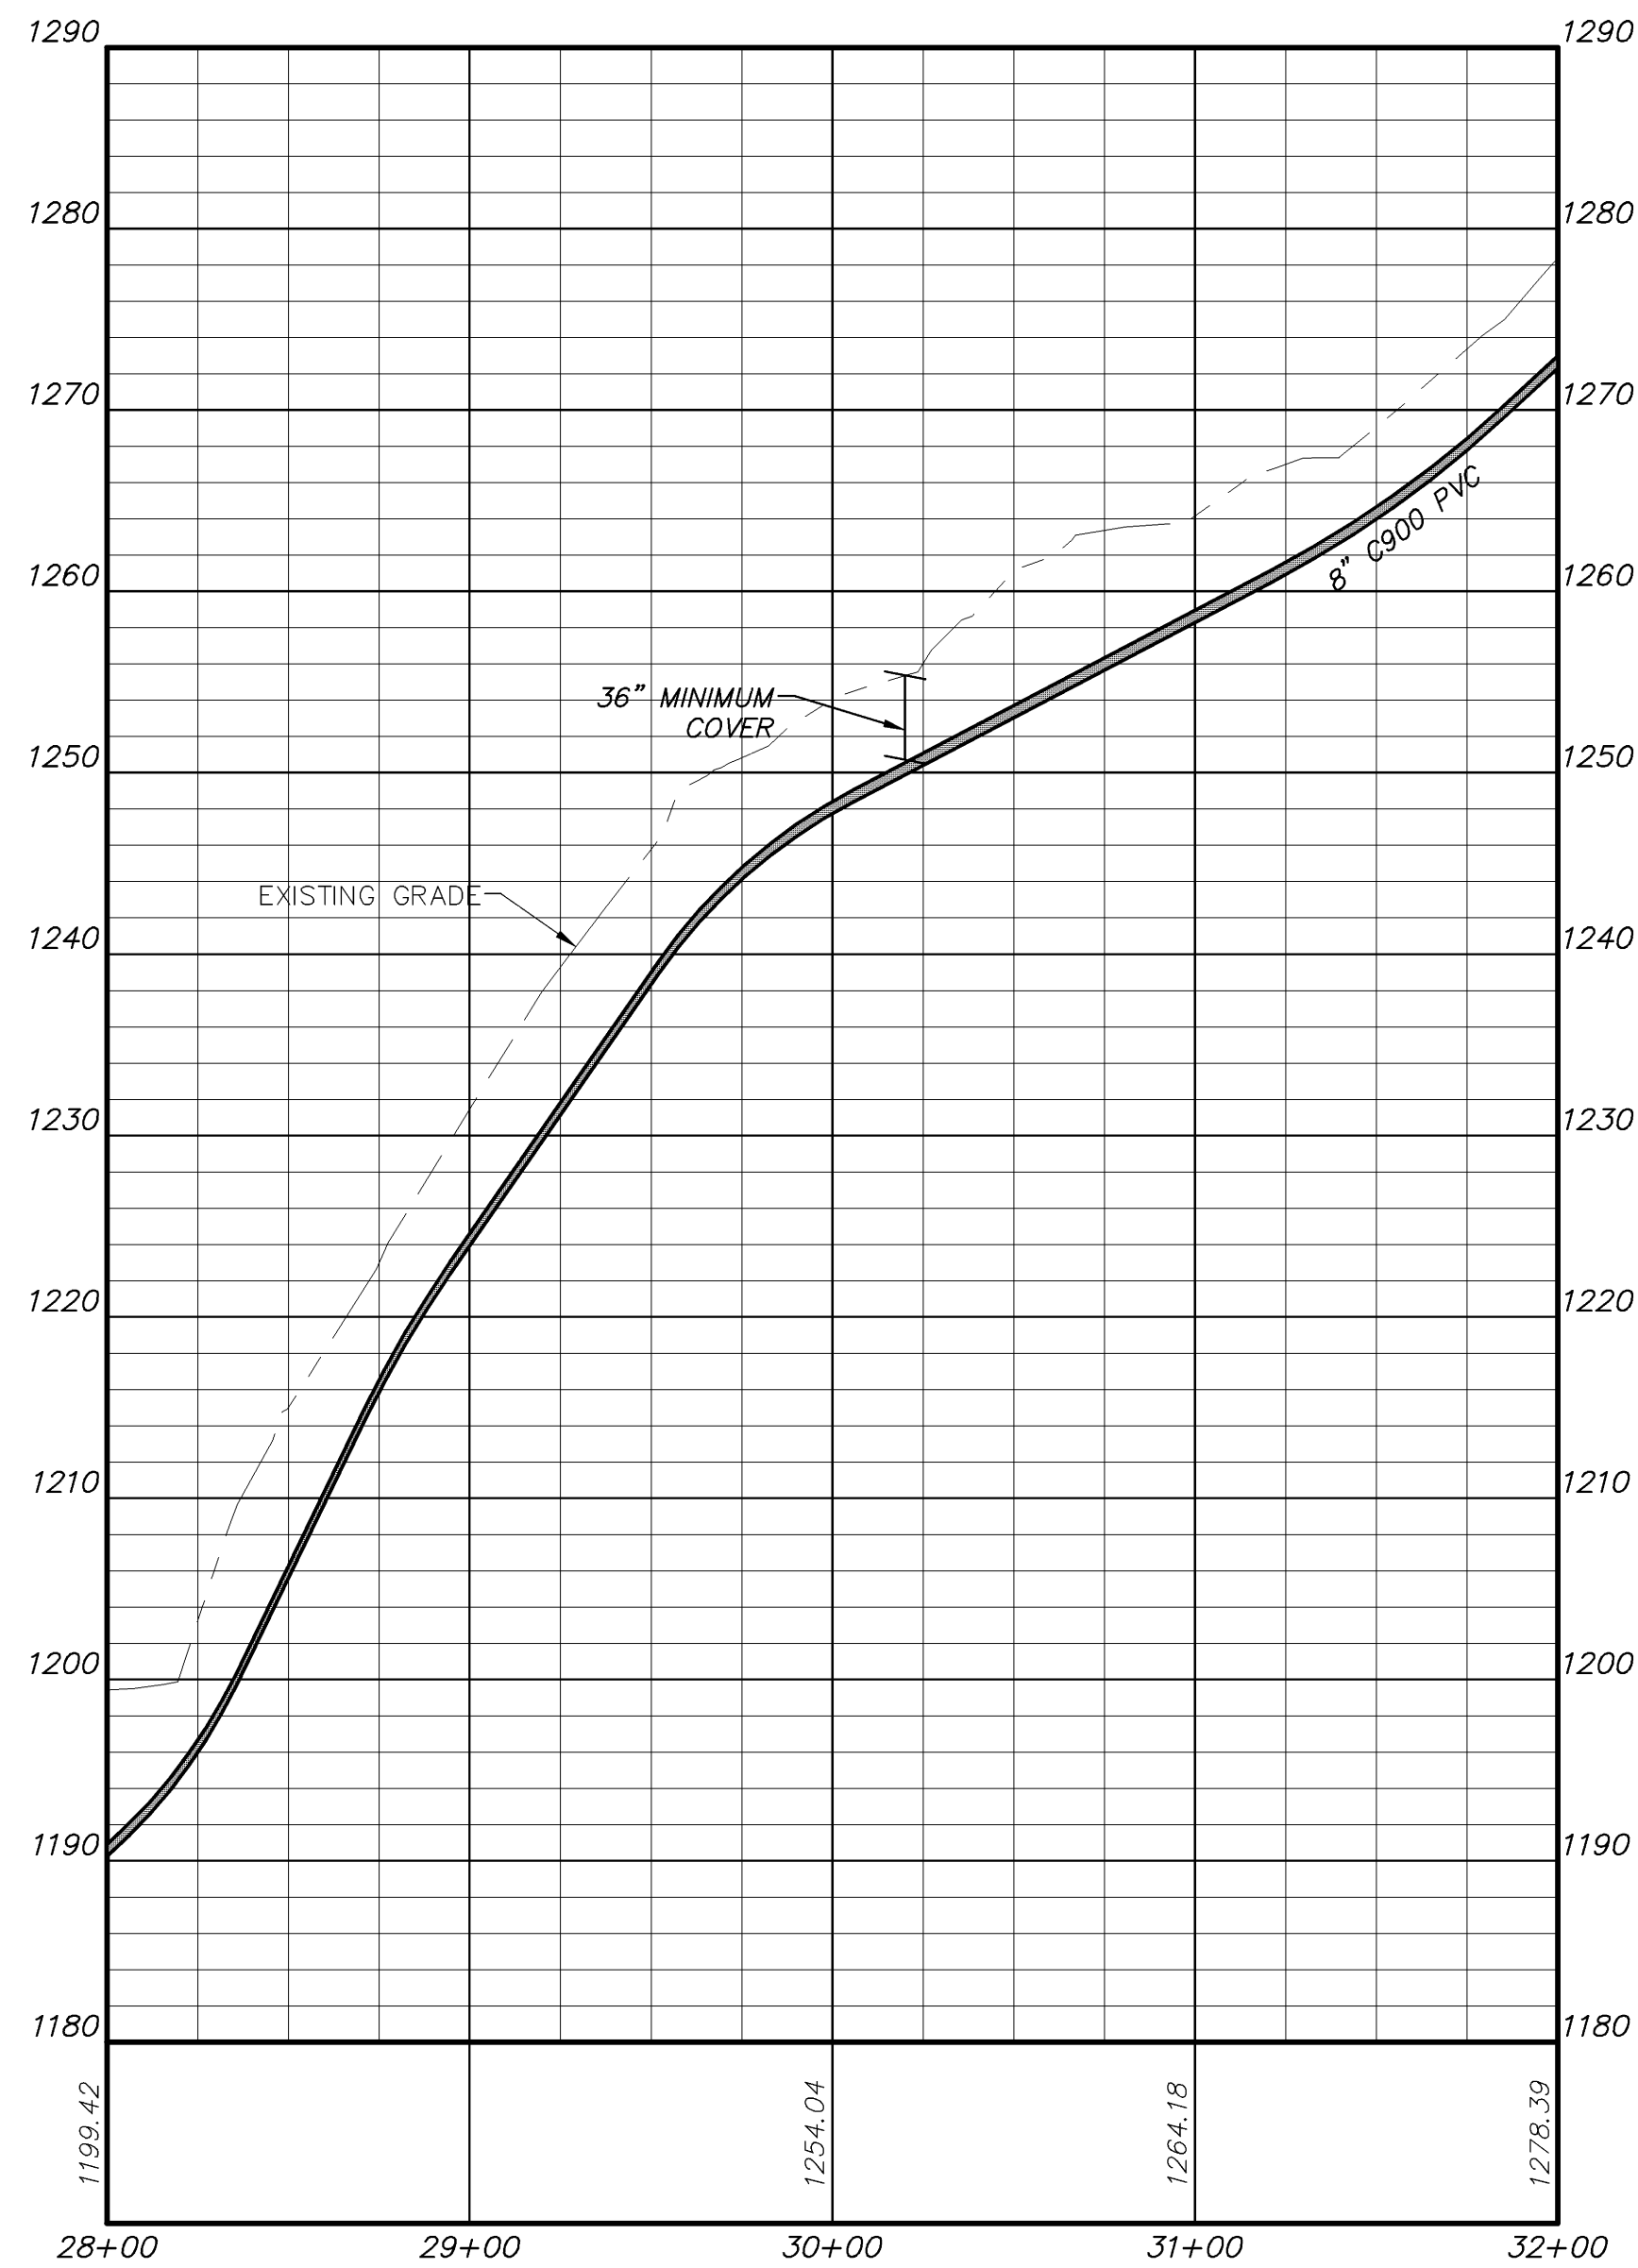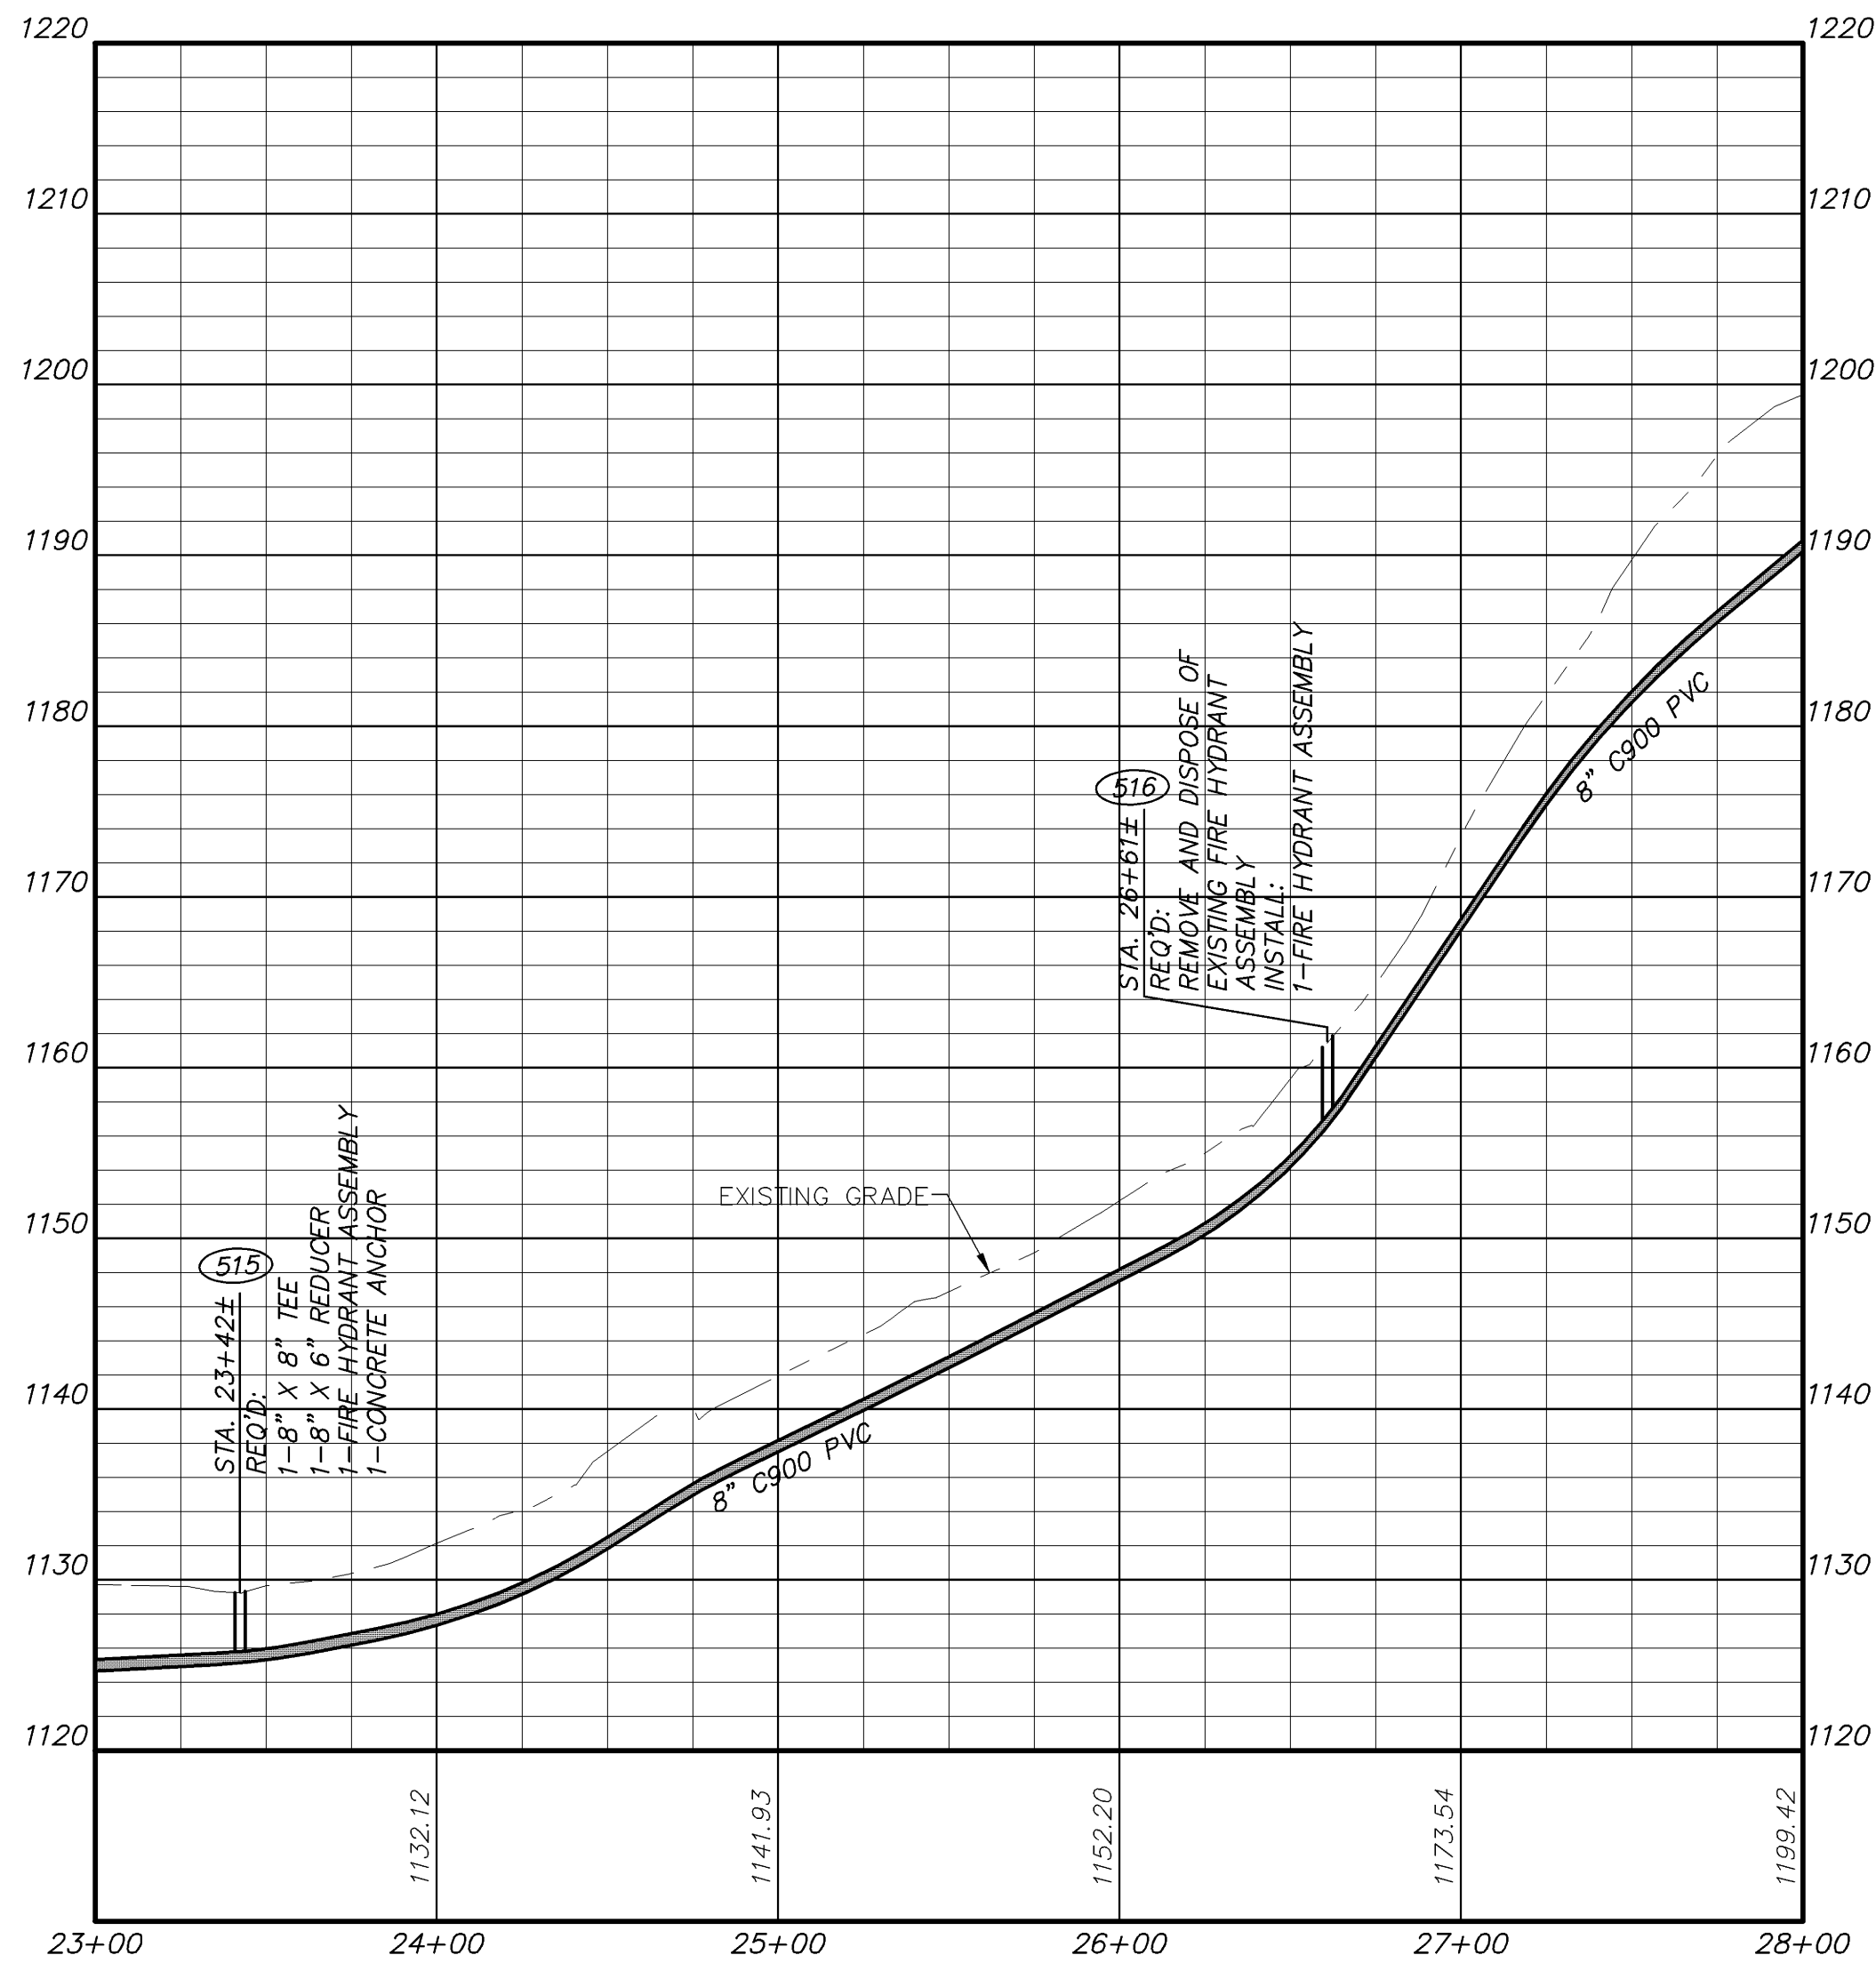

1	8/28/09	VDH COMMENTS
2	9/3/09	OWNER COMMENTS
4	3/14/12	ASBUILTS

PROJECT NO.	20080815
G.L. NO.	297-03-A3.9
FILE NO.	G-12675
DATE:	7/31/09
DRAWN BY:	WCH
CHECKED BY:	BLC