
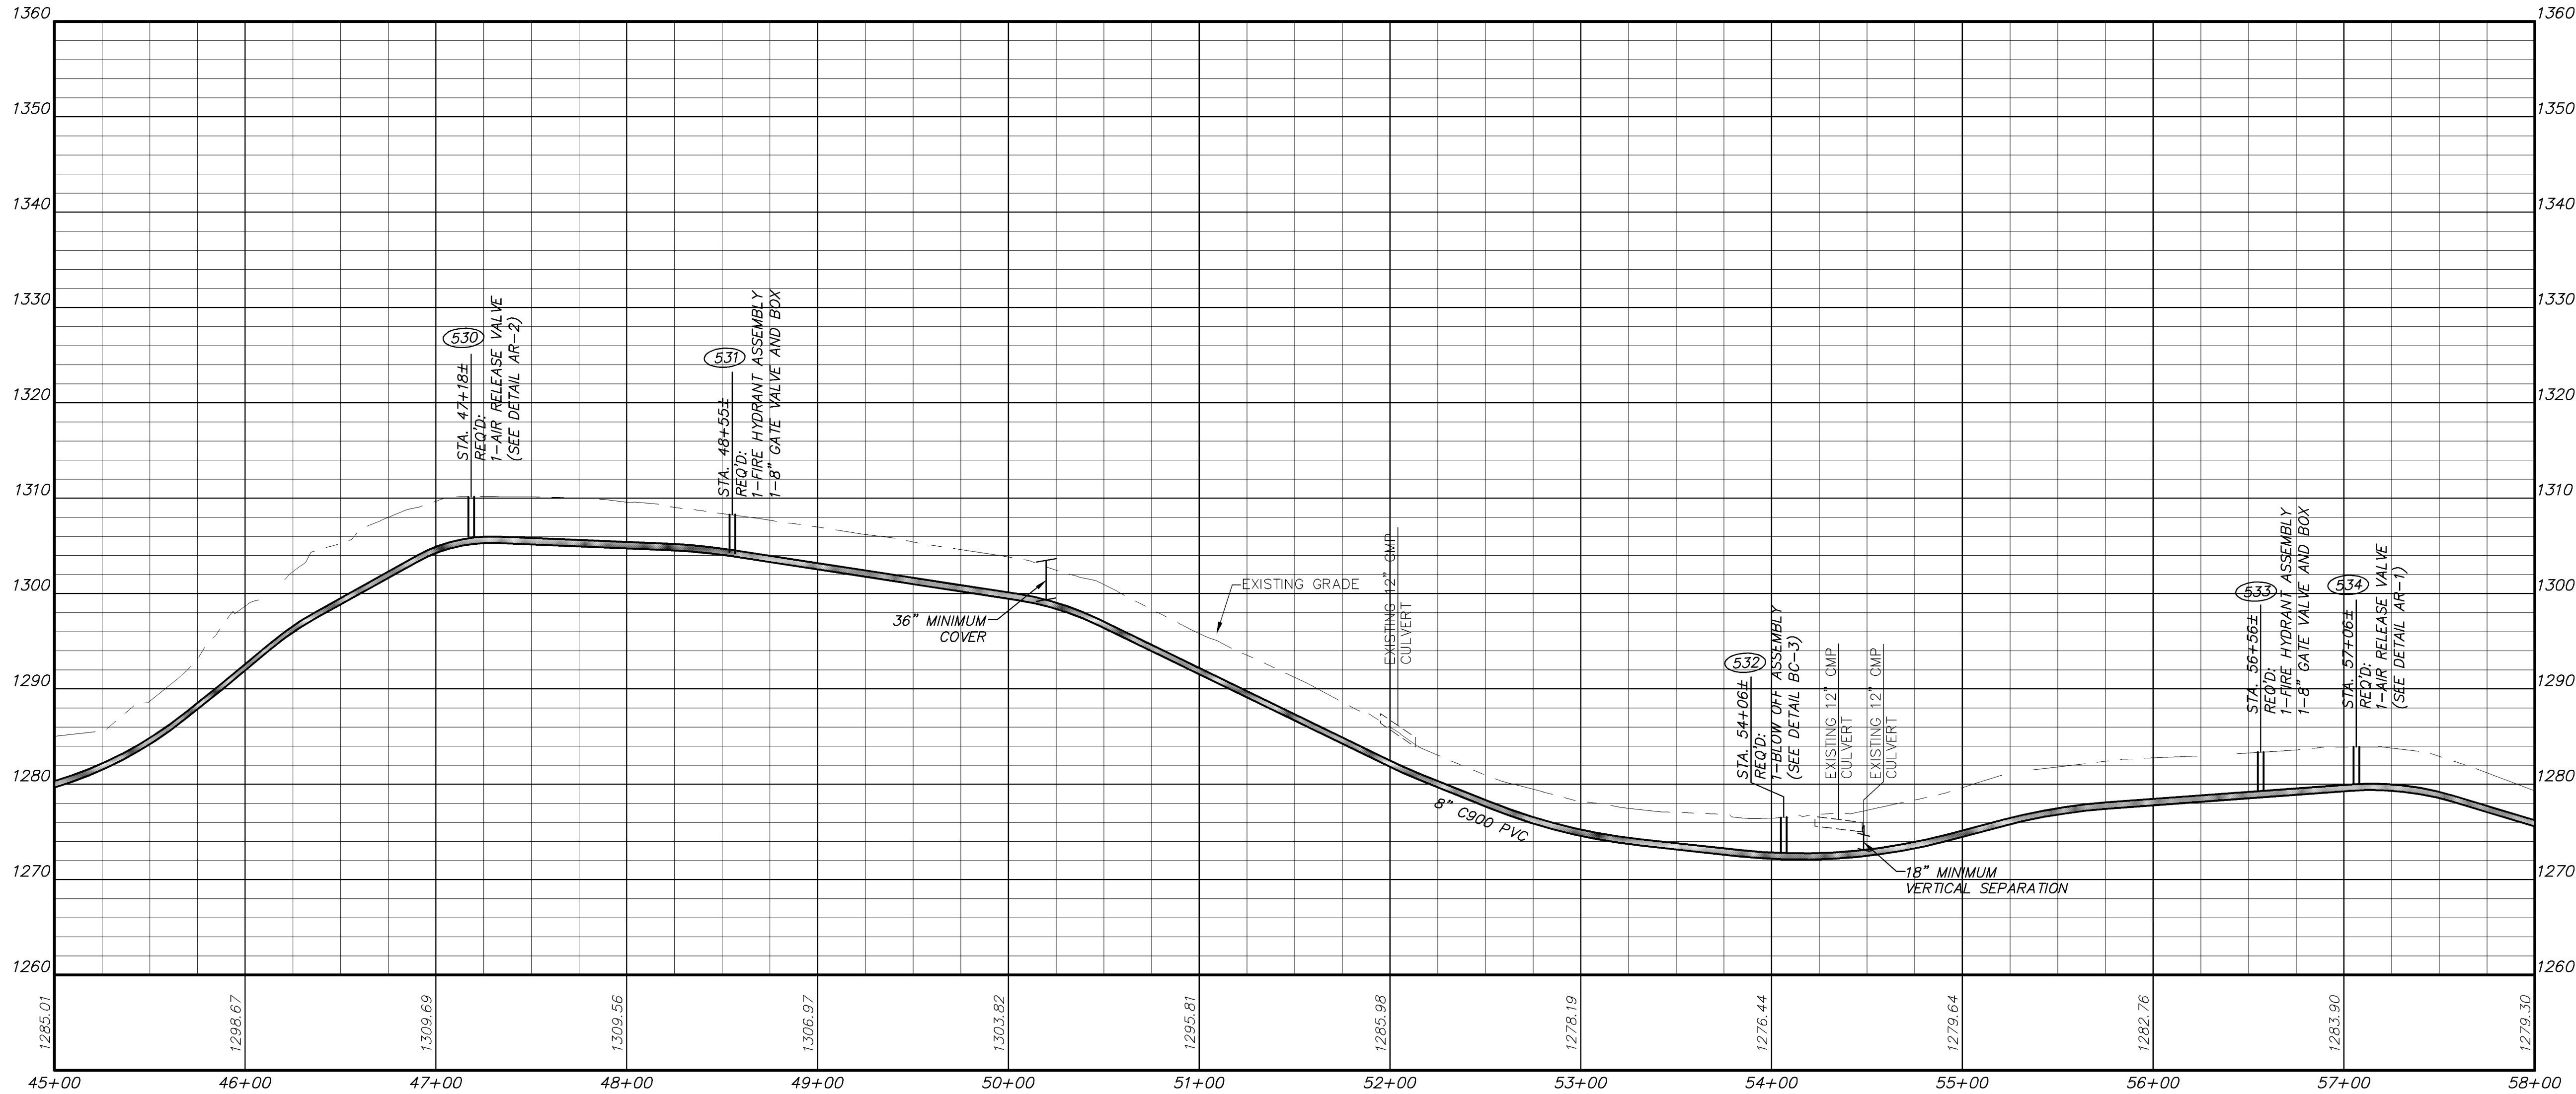


Mar 14, 2012 - 10:33am V:\LandProjects\20080815\dwg\Asbults-WL-ASBULT-P-P-Water.dwg

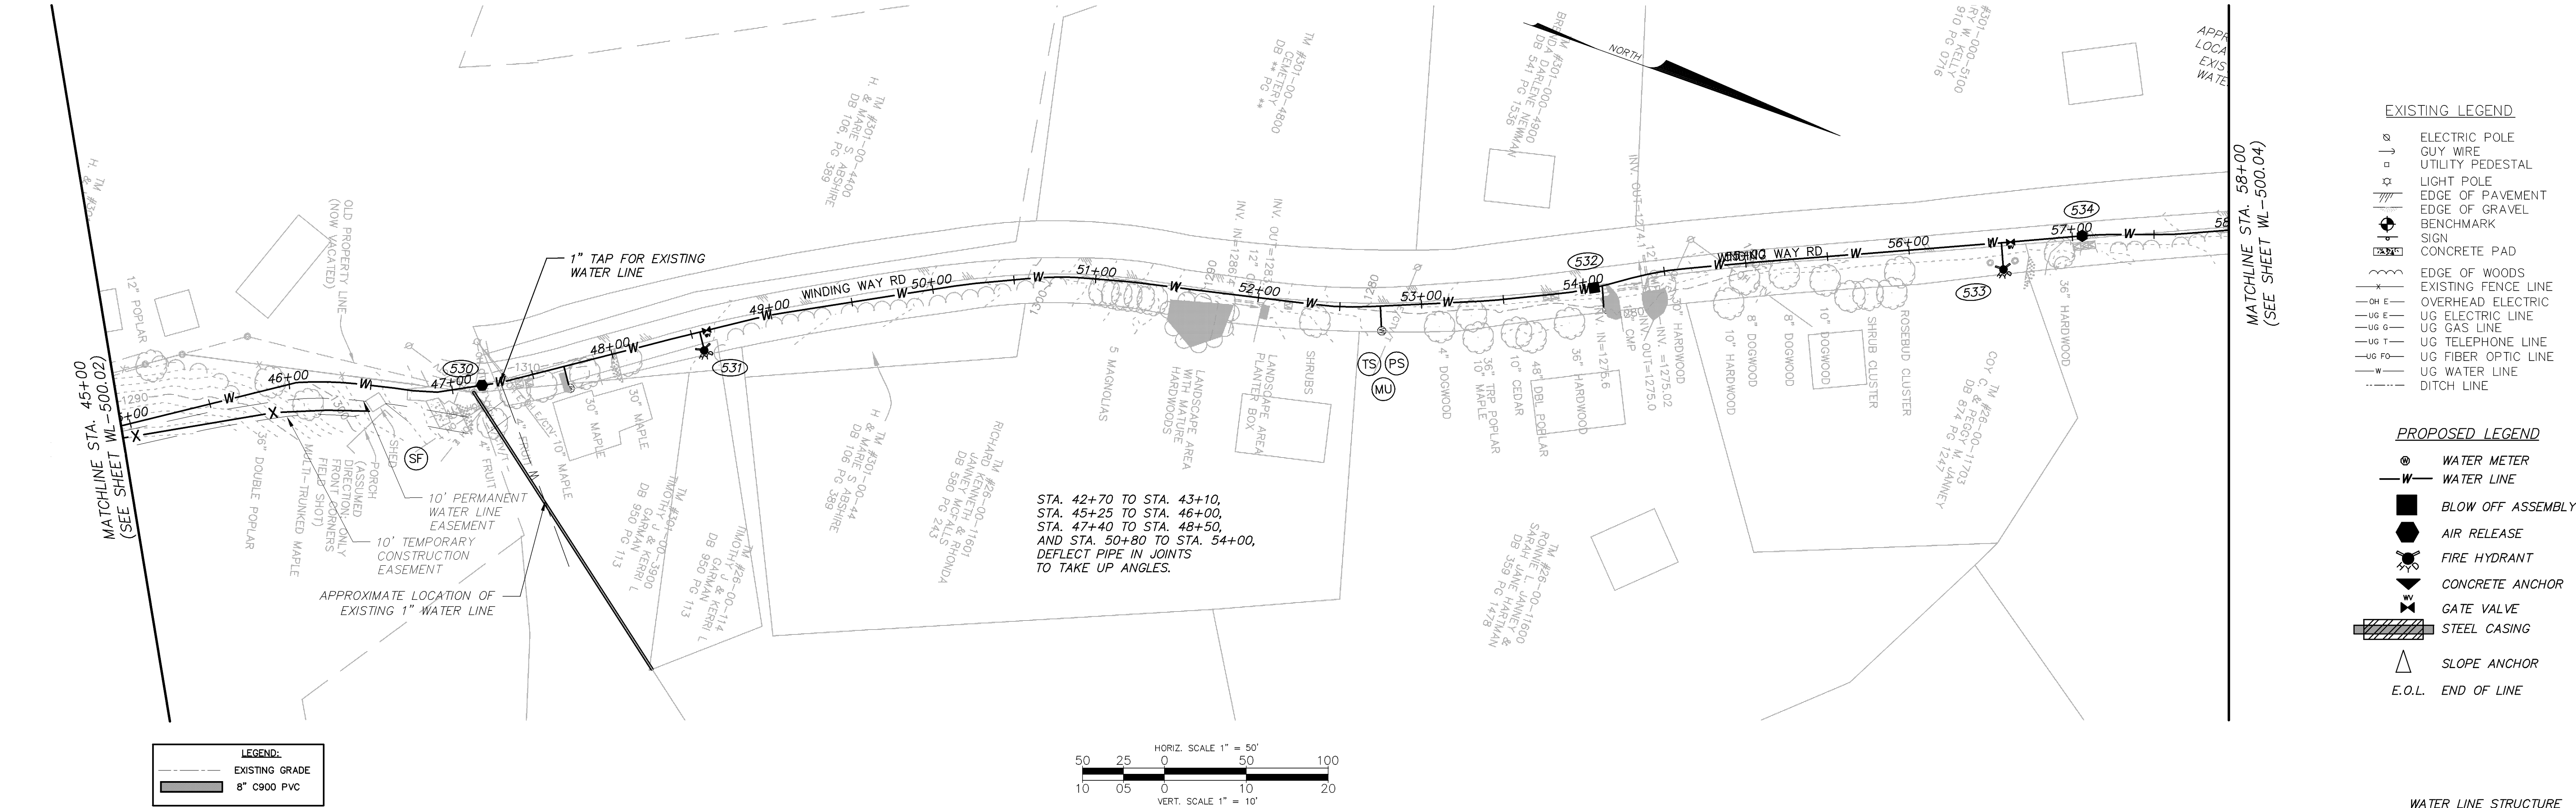

1	8/28/09	VDH COMMENTS
2	9/3/09	OWNER COMMENTS
4	3/14/12	ASBULTS

STA. 45+00 - 58+00± WINDING WAY-ASBULT
FOR
TOWN OF BOONES MILL WATER SYSTEM REPLACEMENT, VOLUME 1
TOWN OF BOONES MILL, BOONE DISTRICT, FRANKLIN COUNTY, VA

PROJECT NO.	20080815
G.L. NO.	297-03-A3.9
FILE NO.	G-12675
DATE:	7/31/09
DRAWN BY:	WCH
CHECKED BY:	BLC