

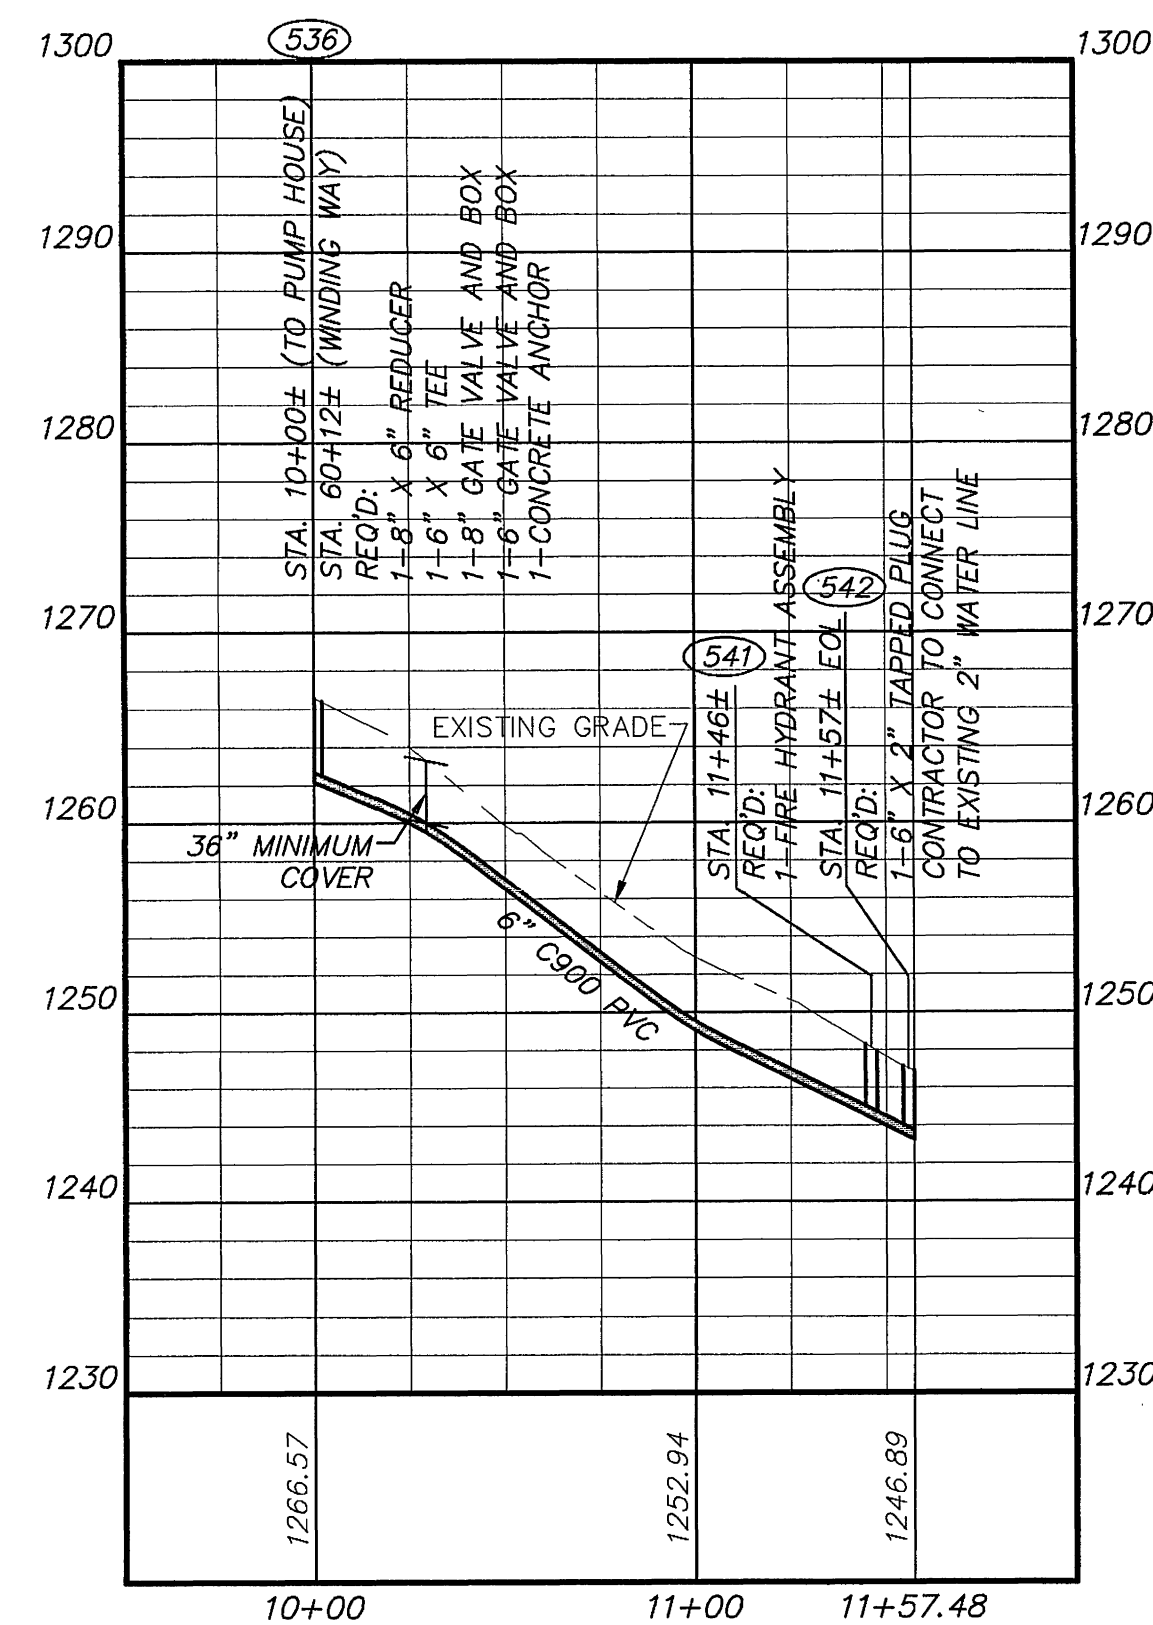
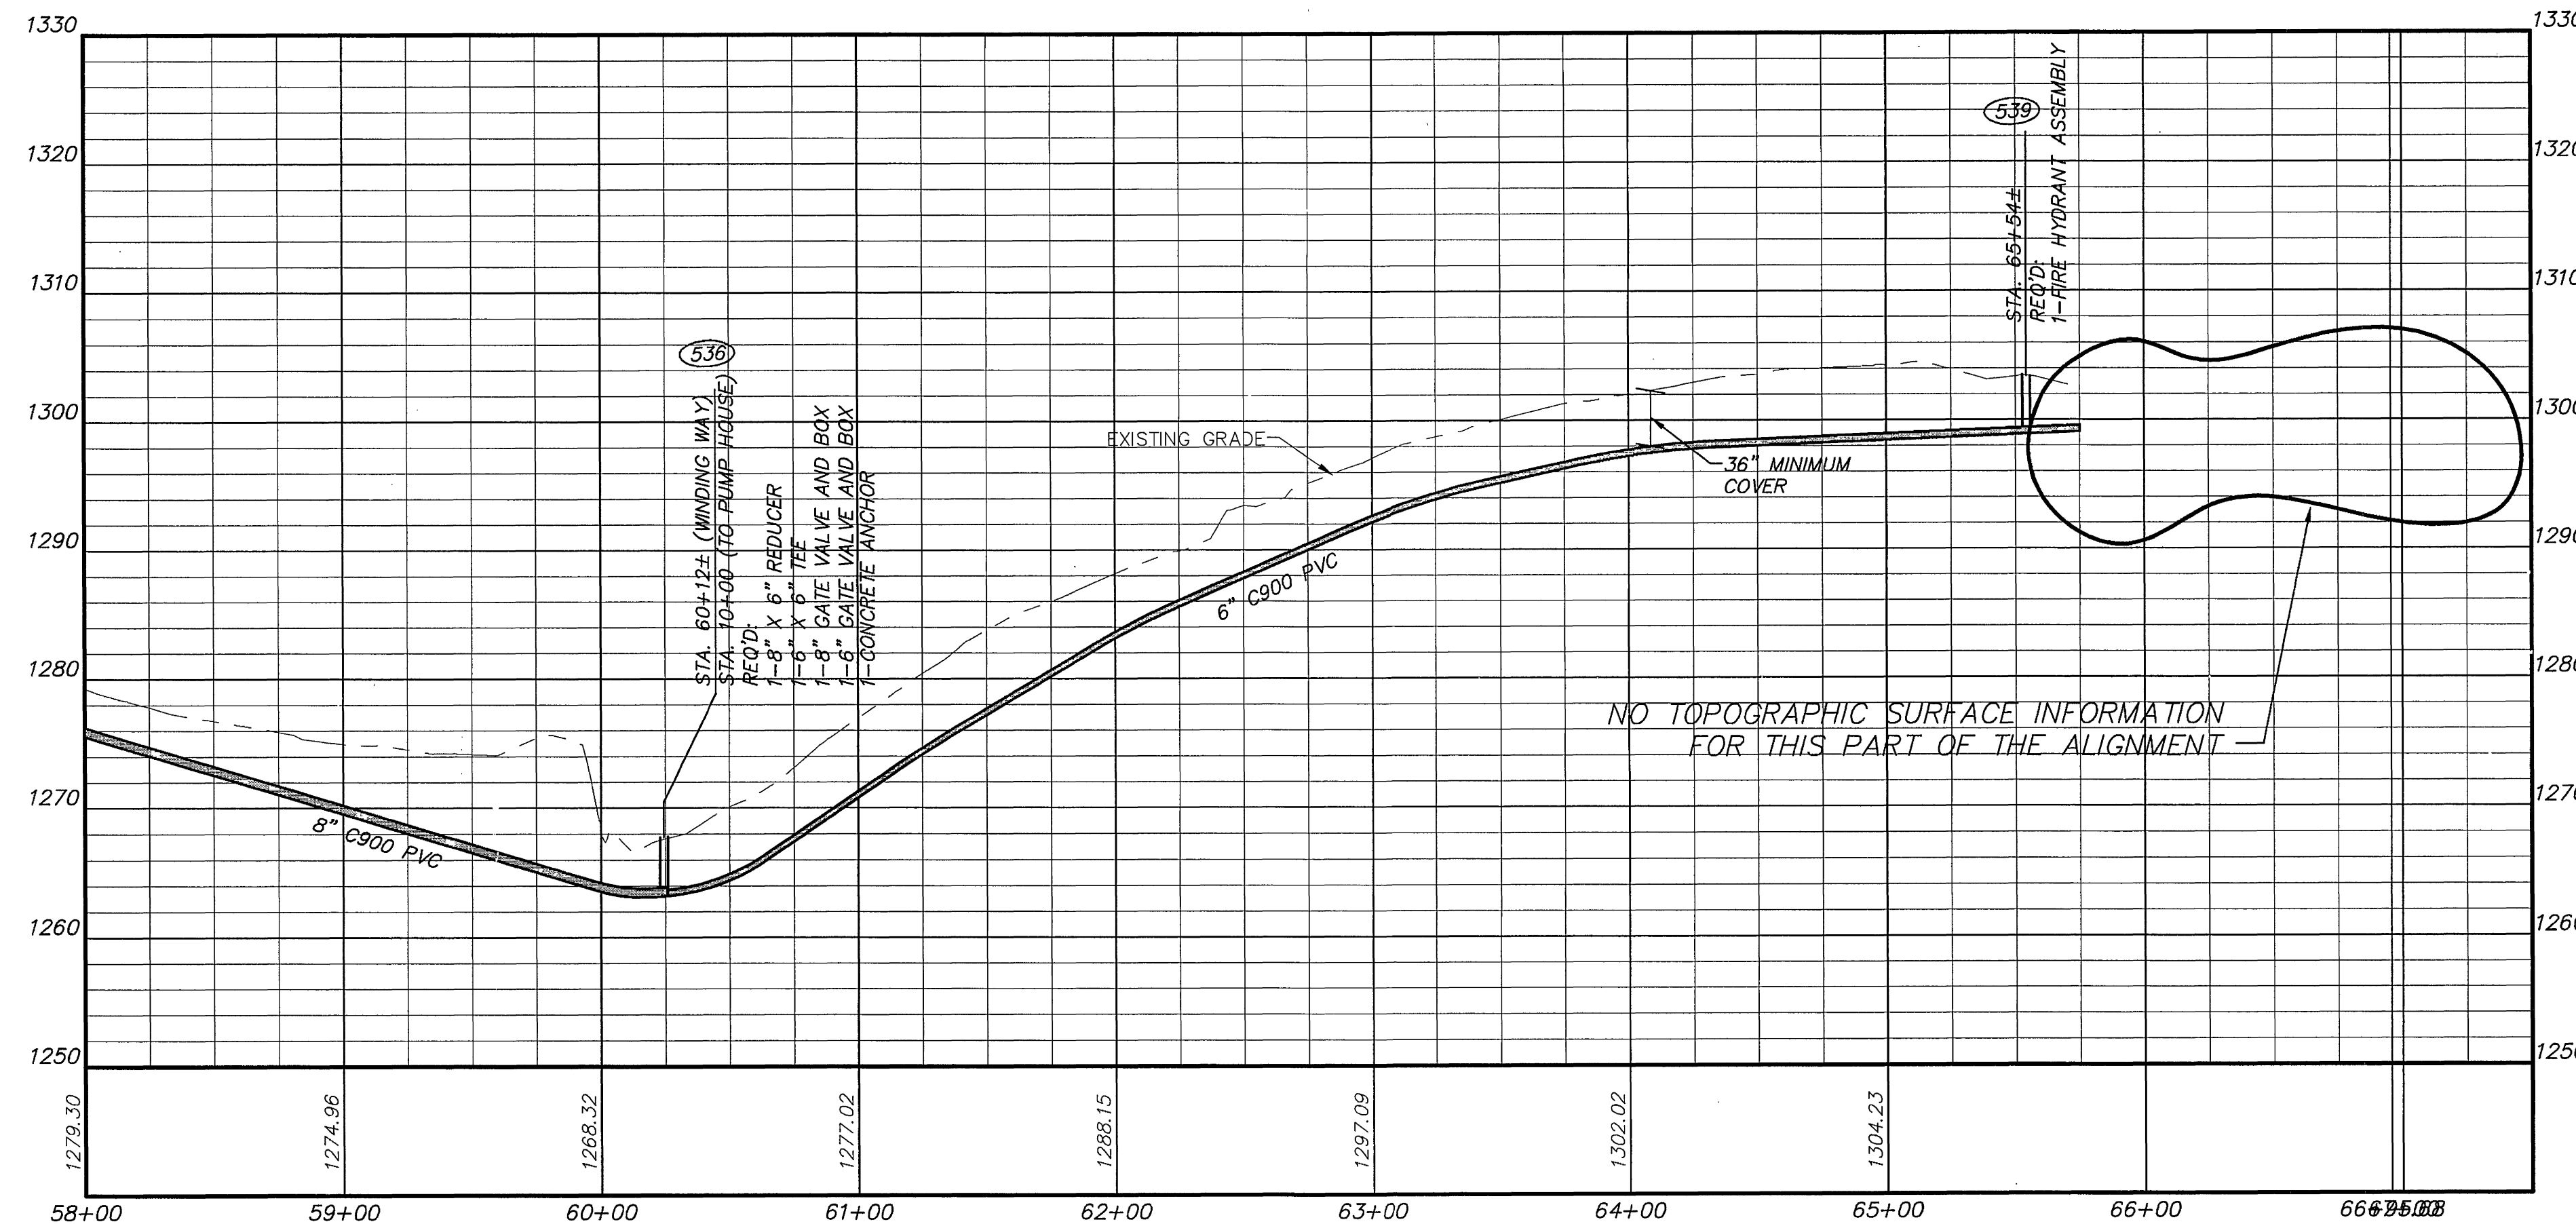


Mar 14, 2012 - 10:34am V:\LandProjects\20080815\Drawn\ASBUILT-IP-Water.dwg

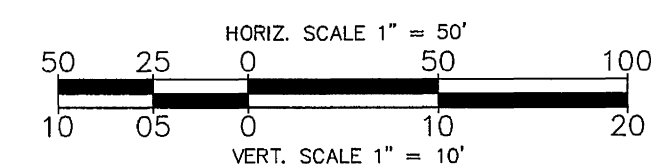

LINE TO PUMP HOUSE

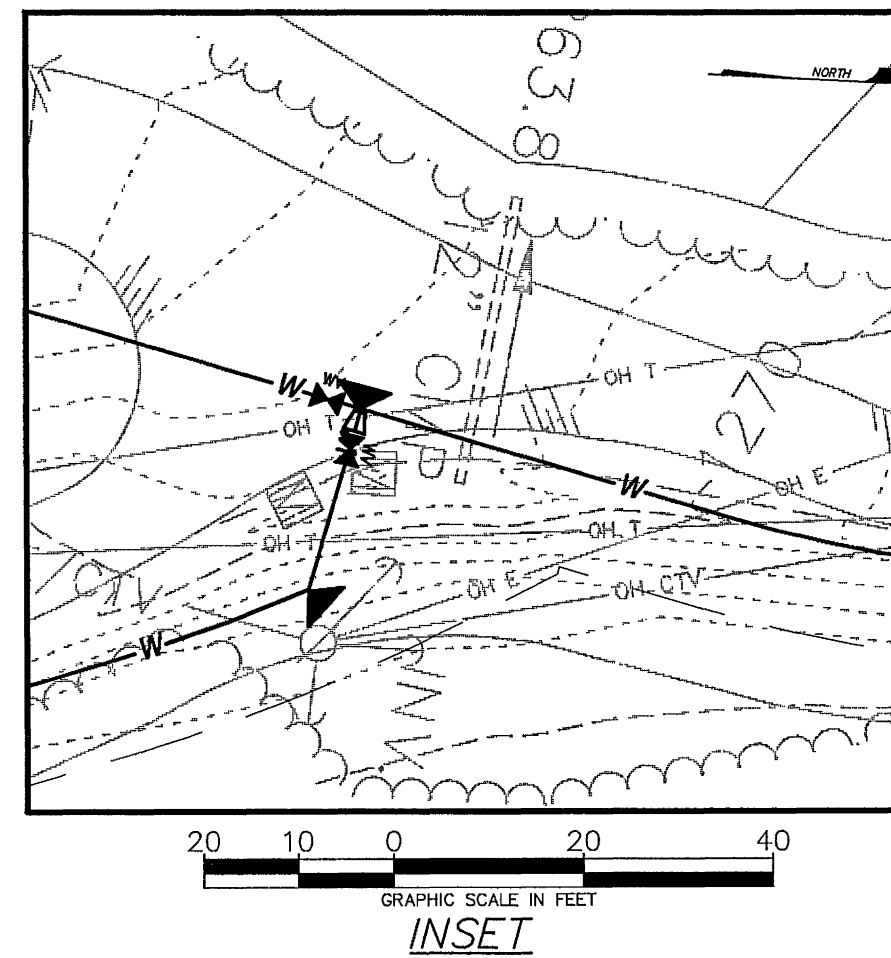

| PROPOSED LEGEND    | EXISTING LEGEND     |
|--------------------|---------------------|
| WATER METER        | ELECTRIC POLE       |
| WATER LINE         | GUY WIRE            |
| BLOW OFF ASSEMBLY  | UTILITY PEDESTAL    |
| AIR RELEASE        | LIGHT POLE          |
| FIRE HYDRANT       | EDGE OF PAVEMENT    |
| CONCRETE ANCHOR    | EDGE OF GRAVEL      |
| GATE VALVE         | BENCHMARK           |
| STEEL CASING       | SIGN                |
| SLOPE ANCHOR       | CONCRETE PAD        |
| E.O.L. END OF LINE | EDGE OF WOODS       |
|                    | EXISTING FENCE LINE |
|                    | OVERHEAD ELECTRIC   |
|                    | UG ELECTRIC LINE    |
|                    | UG GAS LINE         |
|                    | UG TELEPHONE LINE   |
|                    | UG FIBER OPTIC LINE |
|                    | UG WATER LINE       |
|                    | DITCH LINE          |

| WATER LINE STRUCTURE SCHEDULE                                                                                                                                                           |
|-----------------------------------------------------------------------------------------------------------------------------------------------------------------------------------------|
| STA. 59+92±<br>REQ'D:<br>1-8" 45° BEND<br>1-8" 22.5° BEND<br>2-CONCRETE ANCHOR                                                                                                          |
| STA. 60+12± (WINDING WAY)<br>STA. 10+00 (LINE TO PUMP HOUSE)<br>REQ'D:<br>1-8" X 6" REDUCER<br>1-6" X 6" TEE<br>1-8" GATE VALVE AND BOX<br>1-6" GATE VALVE AND BOX<br>1-CONCRETE ANCHOR |
| STA. 61+87±<br>REQ'D:<br>1-6" 22.5° BEND<br>1-CONCRETE ANCHOR                                                                                                                           |
| STA. 62+45±<br>REQ'D:<br>1-6" 90° BEND<br>1-CONCRETE ANCHOR                                                                                                                             |
| STA. 65+54±<br>REQ'D:<br>1-FIRE HYDRANT ASSEMBLY                                                                                                                                        |
| STA. 66+96± EOL (WINDING WAY)<br>REQ'D:<br>1-6" GATE VALVE AND BOX<br>1-BLOW OFF ASSEMBLY                                                                                               |
| STA. 11+46± (LINE TO PUMP HOUSE)<br>REQ'D:<br>1-FIRE HYDRANT ASSEMBLY                                                                                                                   |
| STA. 11+57± EOL (LINE TO PUMP HOUSE)<br>REQ'D:<br>1-6" X 2" TAPPED PLUG<br>CONTRACTOR TO CONNECT TO<br>EXISTING 2" WATER LINE                                                           |

\* ENGINEERING \*\* SURVEYING \*\* PLANNING

**STA. 58+00 - 66+96± EOL WINDING WAY-ASBUILT**  
**FOR**  
**TOWN OF BOONES MILL WATER SYSTEM REPLACEMENT, VOLUME 1**  
**TOWN OF BOONES MILL, BOONE DISTRICT, FRANKLIN COUNTY, VA**

PROJECT NO. 20080815  
G.L. NO. 297-03-A3.9  
FILE NO. G-12675  
DATE: 7/31/09  
DRAWN BY: WCH  
CHECKED BY: BLC

**HURT & PROFFITT**  
INCORPORATED

SHEET NO.  
**WL-500.04**



2534 LANGHORNE ROAD  
LYNCHBURG VA 24501  
800.242.4906 TOLL FREE  
434.847.7796 MAIN  
434.847.0047 FAX