



Mar 14, 2012 - 10:35am V:\UserProjects\20080815\dwg\Asbults-WL-Asbult-T-P-Water.dwg

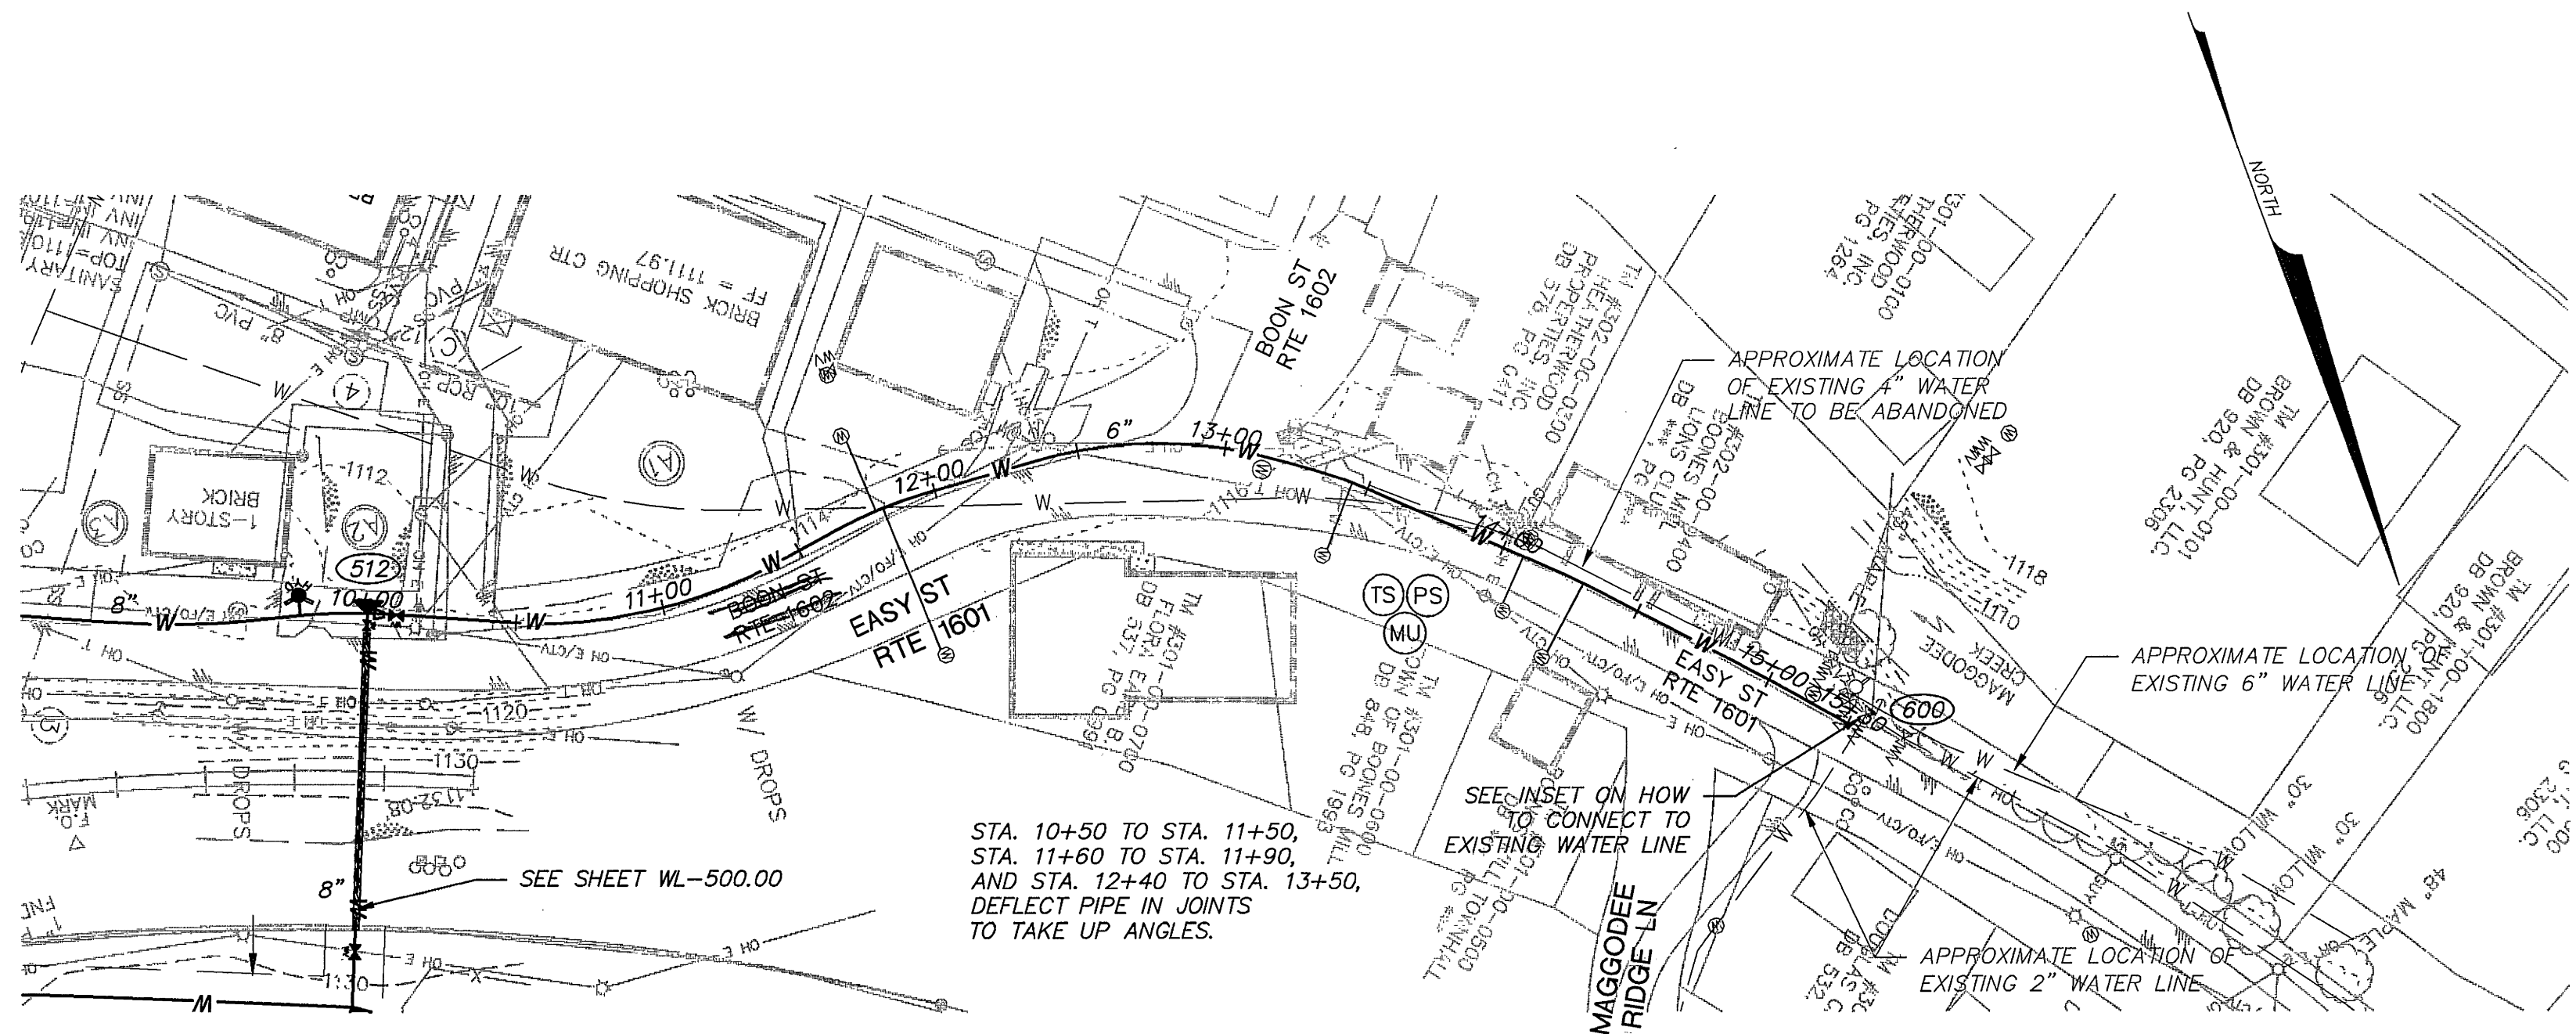


WATER LINE STRUCTURE SCHEDULE	
(512)	STA. 10+00 (EASY STREET) STA. 20+38± (WINDING WAY) REQ'D: 1-8" X 8" TEE 1-8" X 6" REDUCER 1-8" GATE VALVE AND BOX 1-6" GATE VALVE AND BOX 1-CONCRETE ANCHOR
(600)	STA. 15+30± EOL REQ'D: 1-6" 90° BEND 2-CONCRETE ANCHOR 1-6" X 6" TAPPING SLEEVE 1-6" TAPPING VALVE AND BOX CONNECT TO EXISTING LINE (SEE INSET ON THIS SHEET)

NOTE: CONTRACTOR TO VERIFY ALL SERVICE CONNECTIONS ON EASY STREET ARE CONNECTED TO EXISTING 6" LINE. CONTRACTOR TO MOVE ANY SERVICES CONNECTED TO EXISTING 2" LINE TO 6" LINE FROM STA. 15+30 TO END OF EASY STREET.

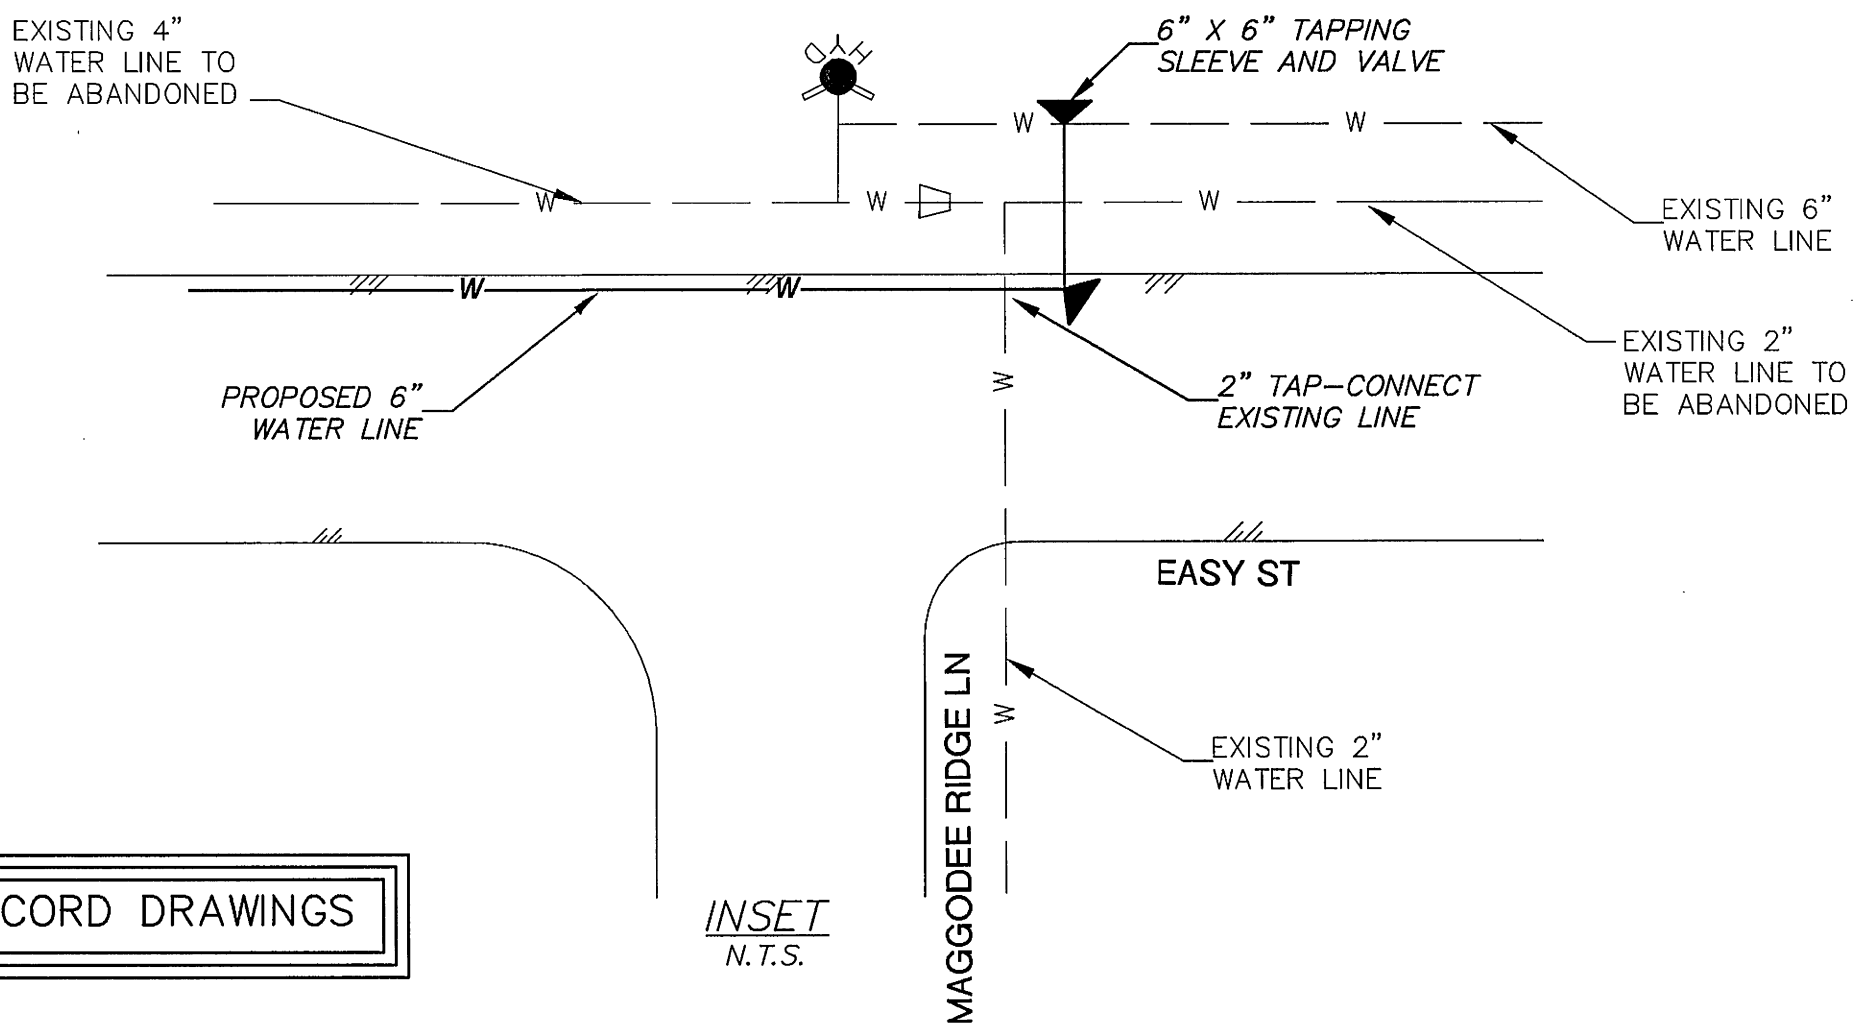


PROFILE INFORMATION TAKEN FROM RECORD DRAWINGS

LEGEND:	
---	EXISTING GRADE
---	6" C900 PVC

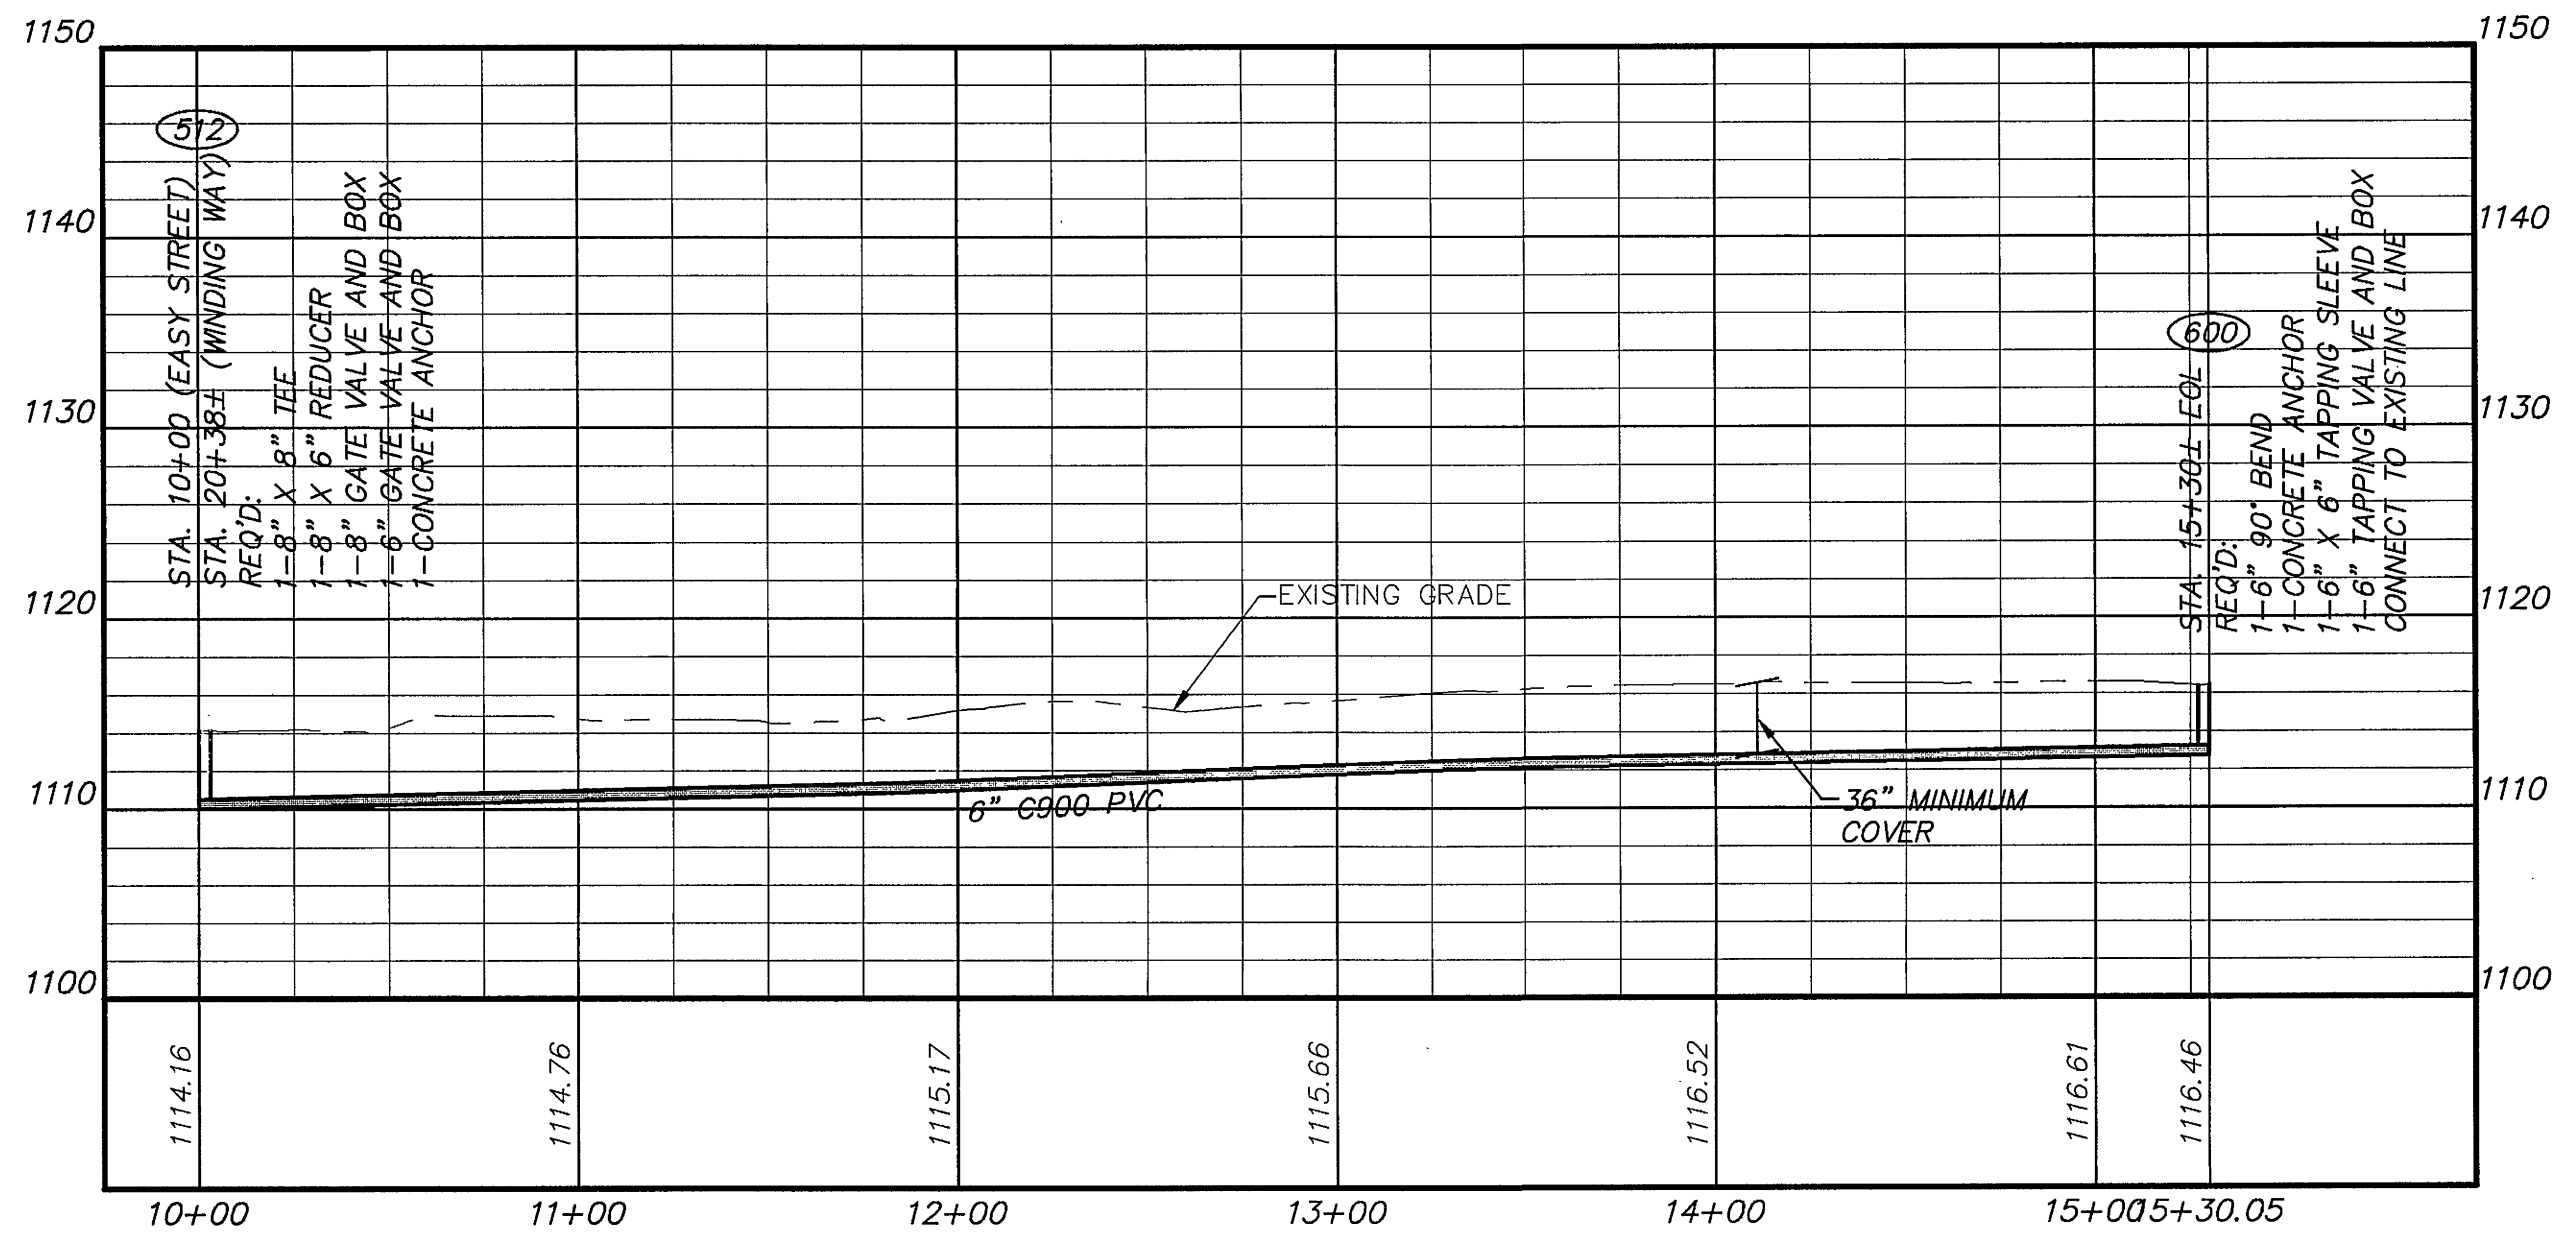

PROPOSED LEGEND	
⊙	WATER METER
—W—	WATER LINE
■	BLOW OFF ASSEMBLY
⊙	AIR RELEASE
⊙	FIRE HYDRANT
⊙	CONCRETE ANCHOR
⊙	GATE VALVE
⊙	STEEL CASING
△	SLOPE ANCHOR
E.O.L.	END OF LINE
EXISTING LEGEND	
⊙	ELECTRIC POLE
⊙	GUY WIRE
⊙	UTILITY PEDESTAL
⊙	LIGHT POLE
⊙	EDGE OF PAVEMENT
⊙	EDGE OF GRAVEL
⊙	BENCHMARK
⊙	SIGN
⊙	CONCRETE PAD
⊙	EDGE OF WOODS
⊙	EXISTING FENCE LINE
⊙	OVERHEAD ELECTRIC
⊙	UG ELECTRIC LINE
⊙	UG GAS LINE
⊙	UG TELEPHONE LINE
⊙	UG FIBER OPTIC LINE
⊙	UG WATER LINE
⊙	DITCH LINE

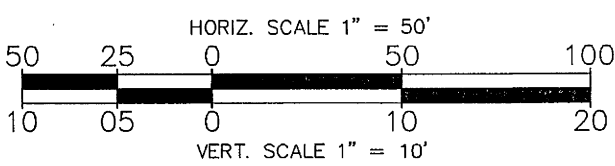

1	8/28/09	VDH COMMENTS
2	9/3/09	OWNER COMMENTS
3	2/17/10	REVISED ALIGNMENT
4	3/14/12	ASBUILTS