

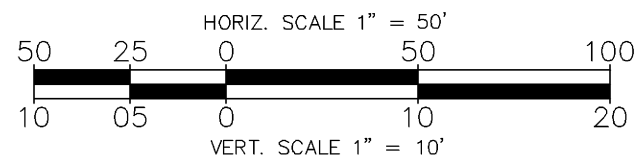
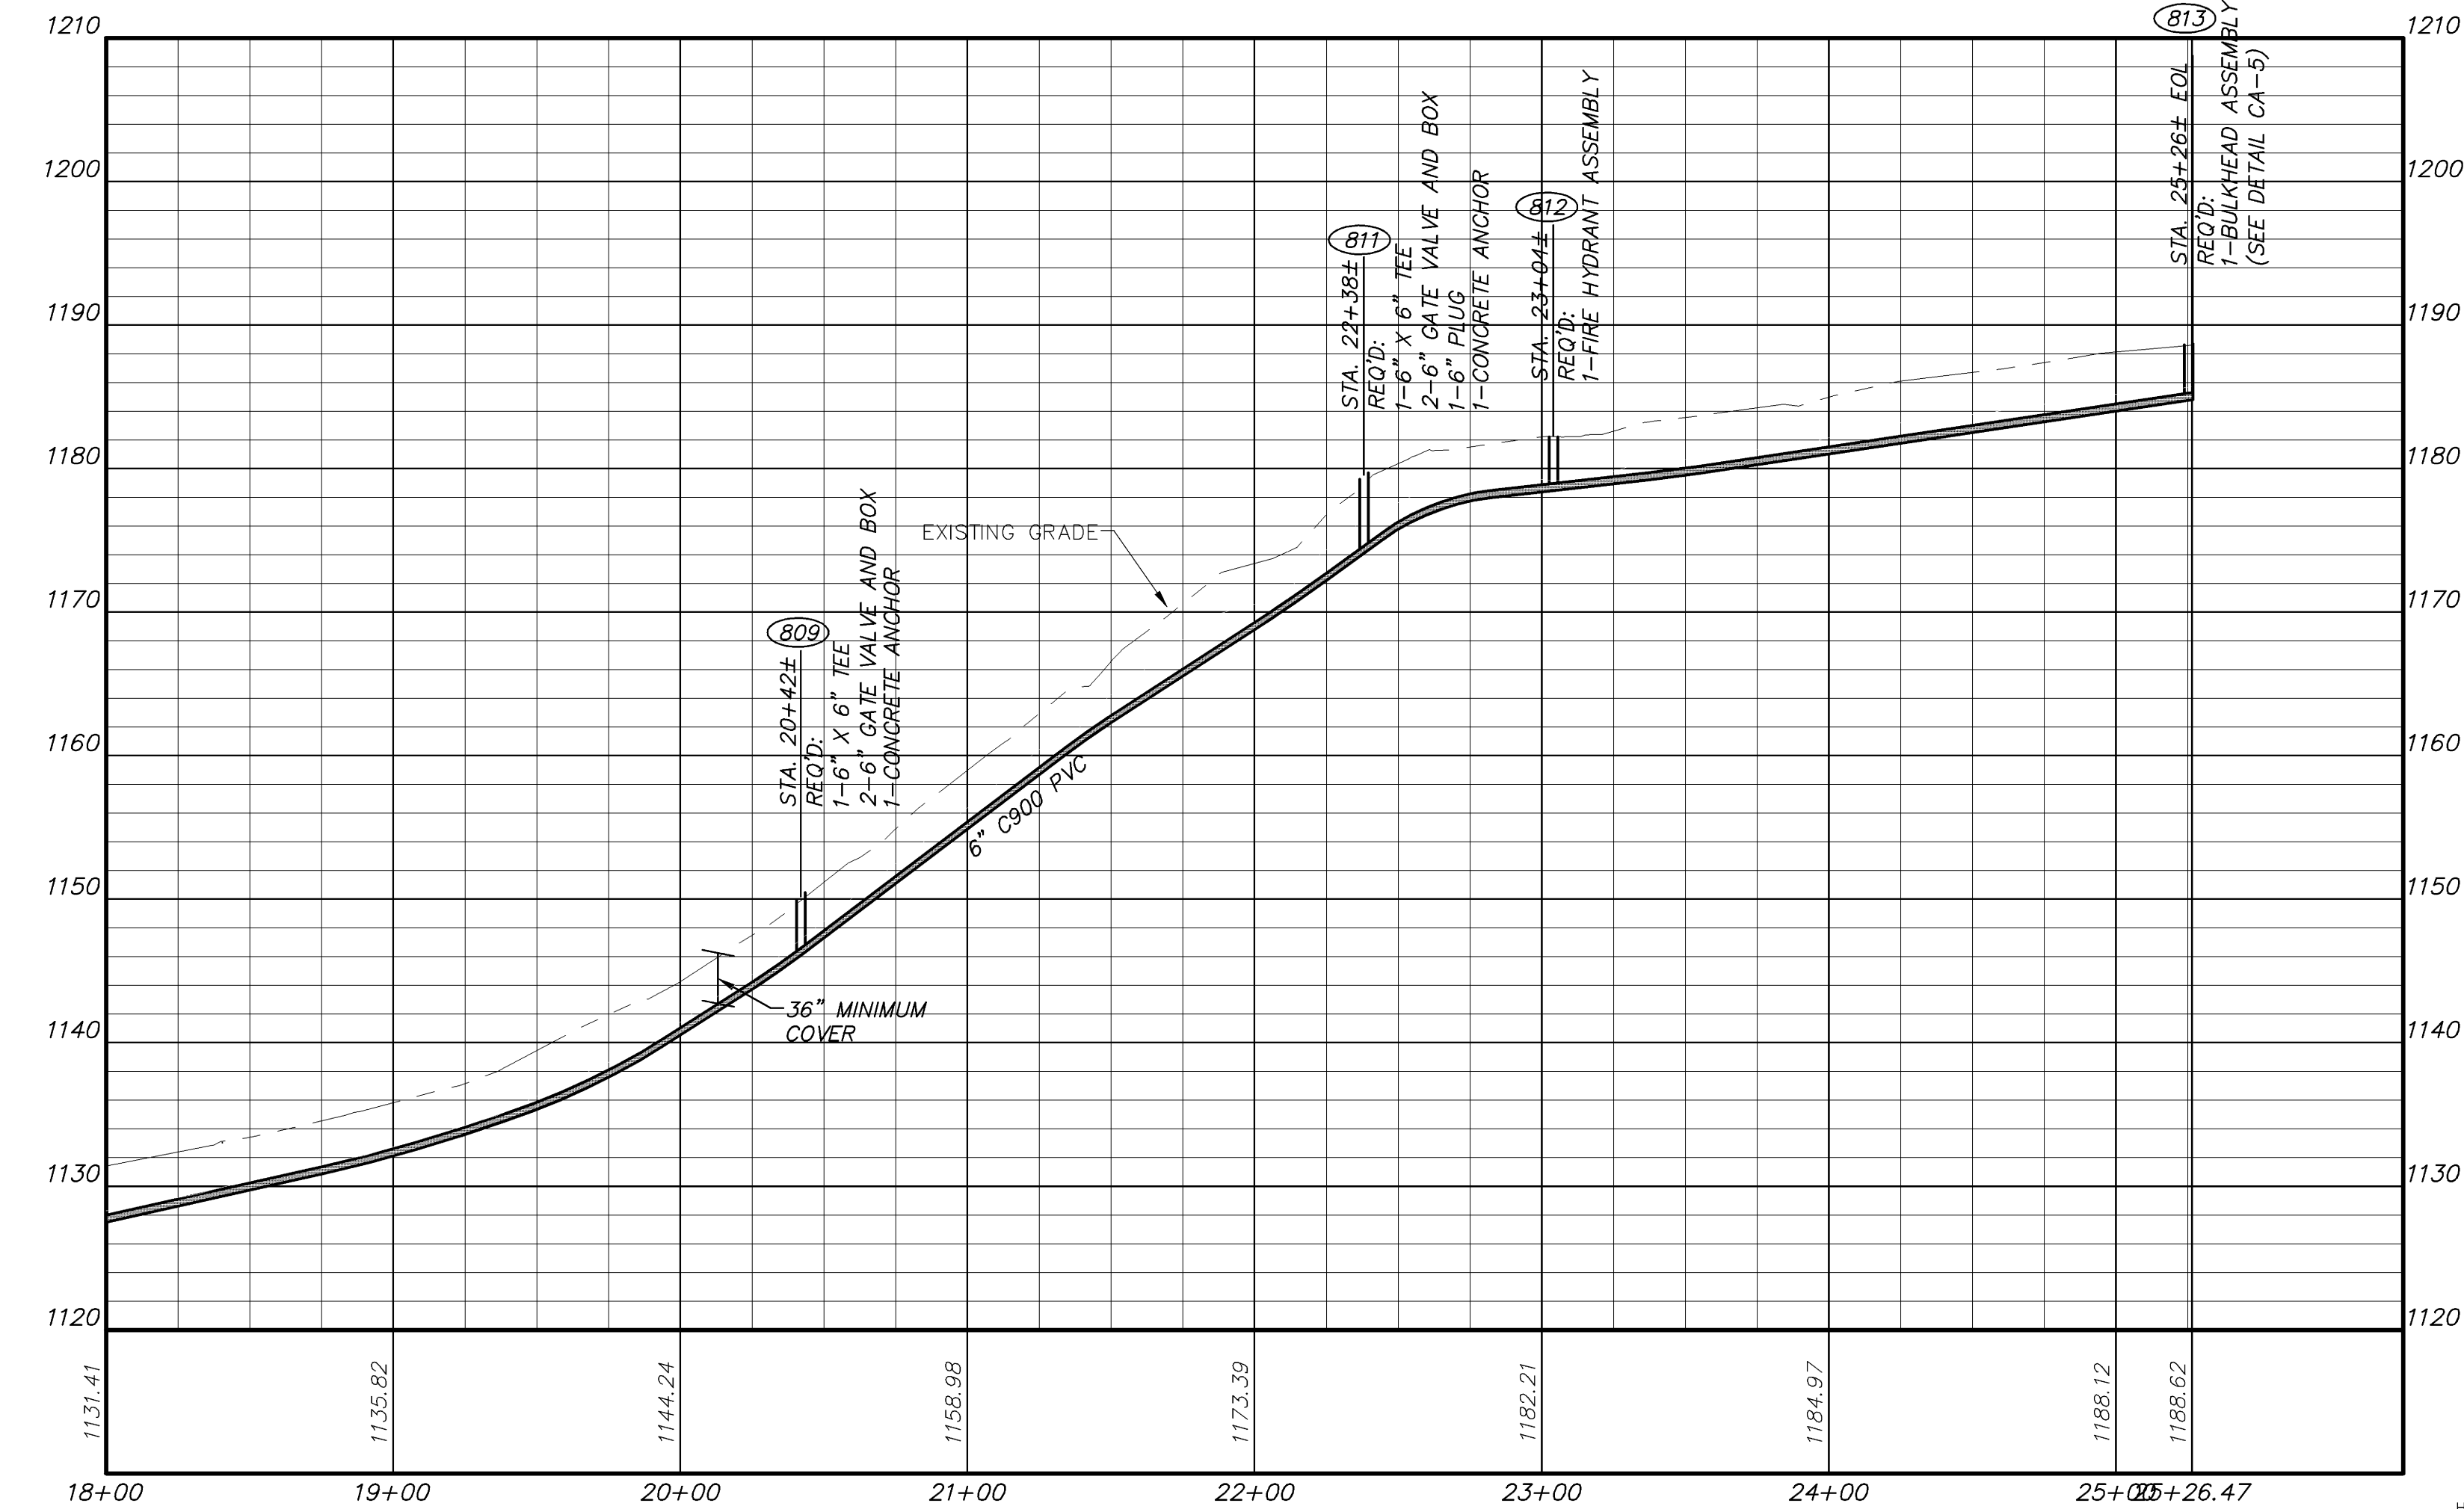


Mar 14, 2012 - 10:37am V:\LandProjects\20080815.dwg\Asbults-WL_ASBULT-P-P-Water.dwg

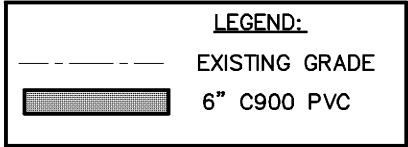

WATER LINE STRUCTURE
SCHEDULE

- (809) STA. 20+42± (WHISPERING CREEK ROAD)
STA. 10+00 (TURNER LANE)
REQ'D:
1-6" X 6" TEE
2-6" GATE VALVE AND BOX
1-CONCRETE ANCHOR
- (810) STA. 21+85±
REQ'D:
1-6" 45° BEND
1-CONCRETE ANCHOR
- (811) STA. 22+38±
REQ'D:
1-6" X 6" TEE
2-6" GATE VALVE AND BOX
1-6" PLUG
1-CONCRETE ANCHOR
- (812) STA. 23+04±
REQ'D:
1-FIRE HYDRANT ASSEMBLY
- (813) STA. 25+26± EOL
REQ'D:
1-BULKHEAD ASSEMBLY
(SEE DETAIL CA-5)
2-1" WATER METERS
(CONTRACTOR TO INSTALL WATER METERS
AND CONNECT EXISTING LINES TO NEW
METERS)

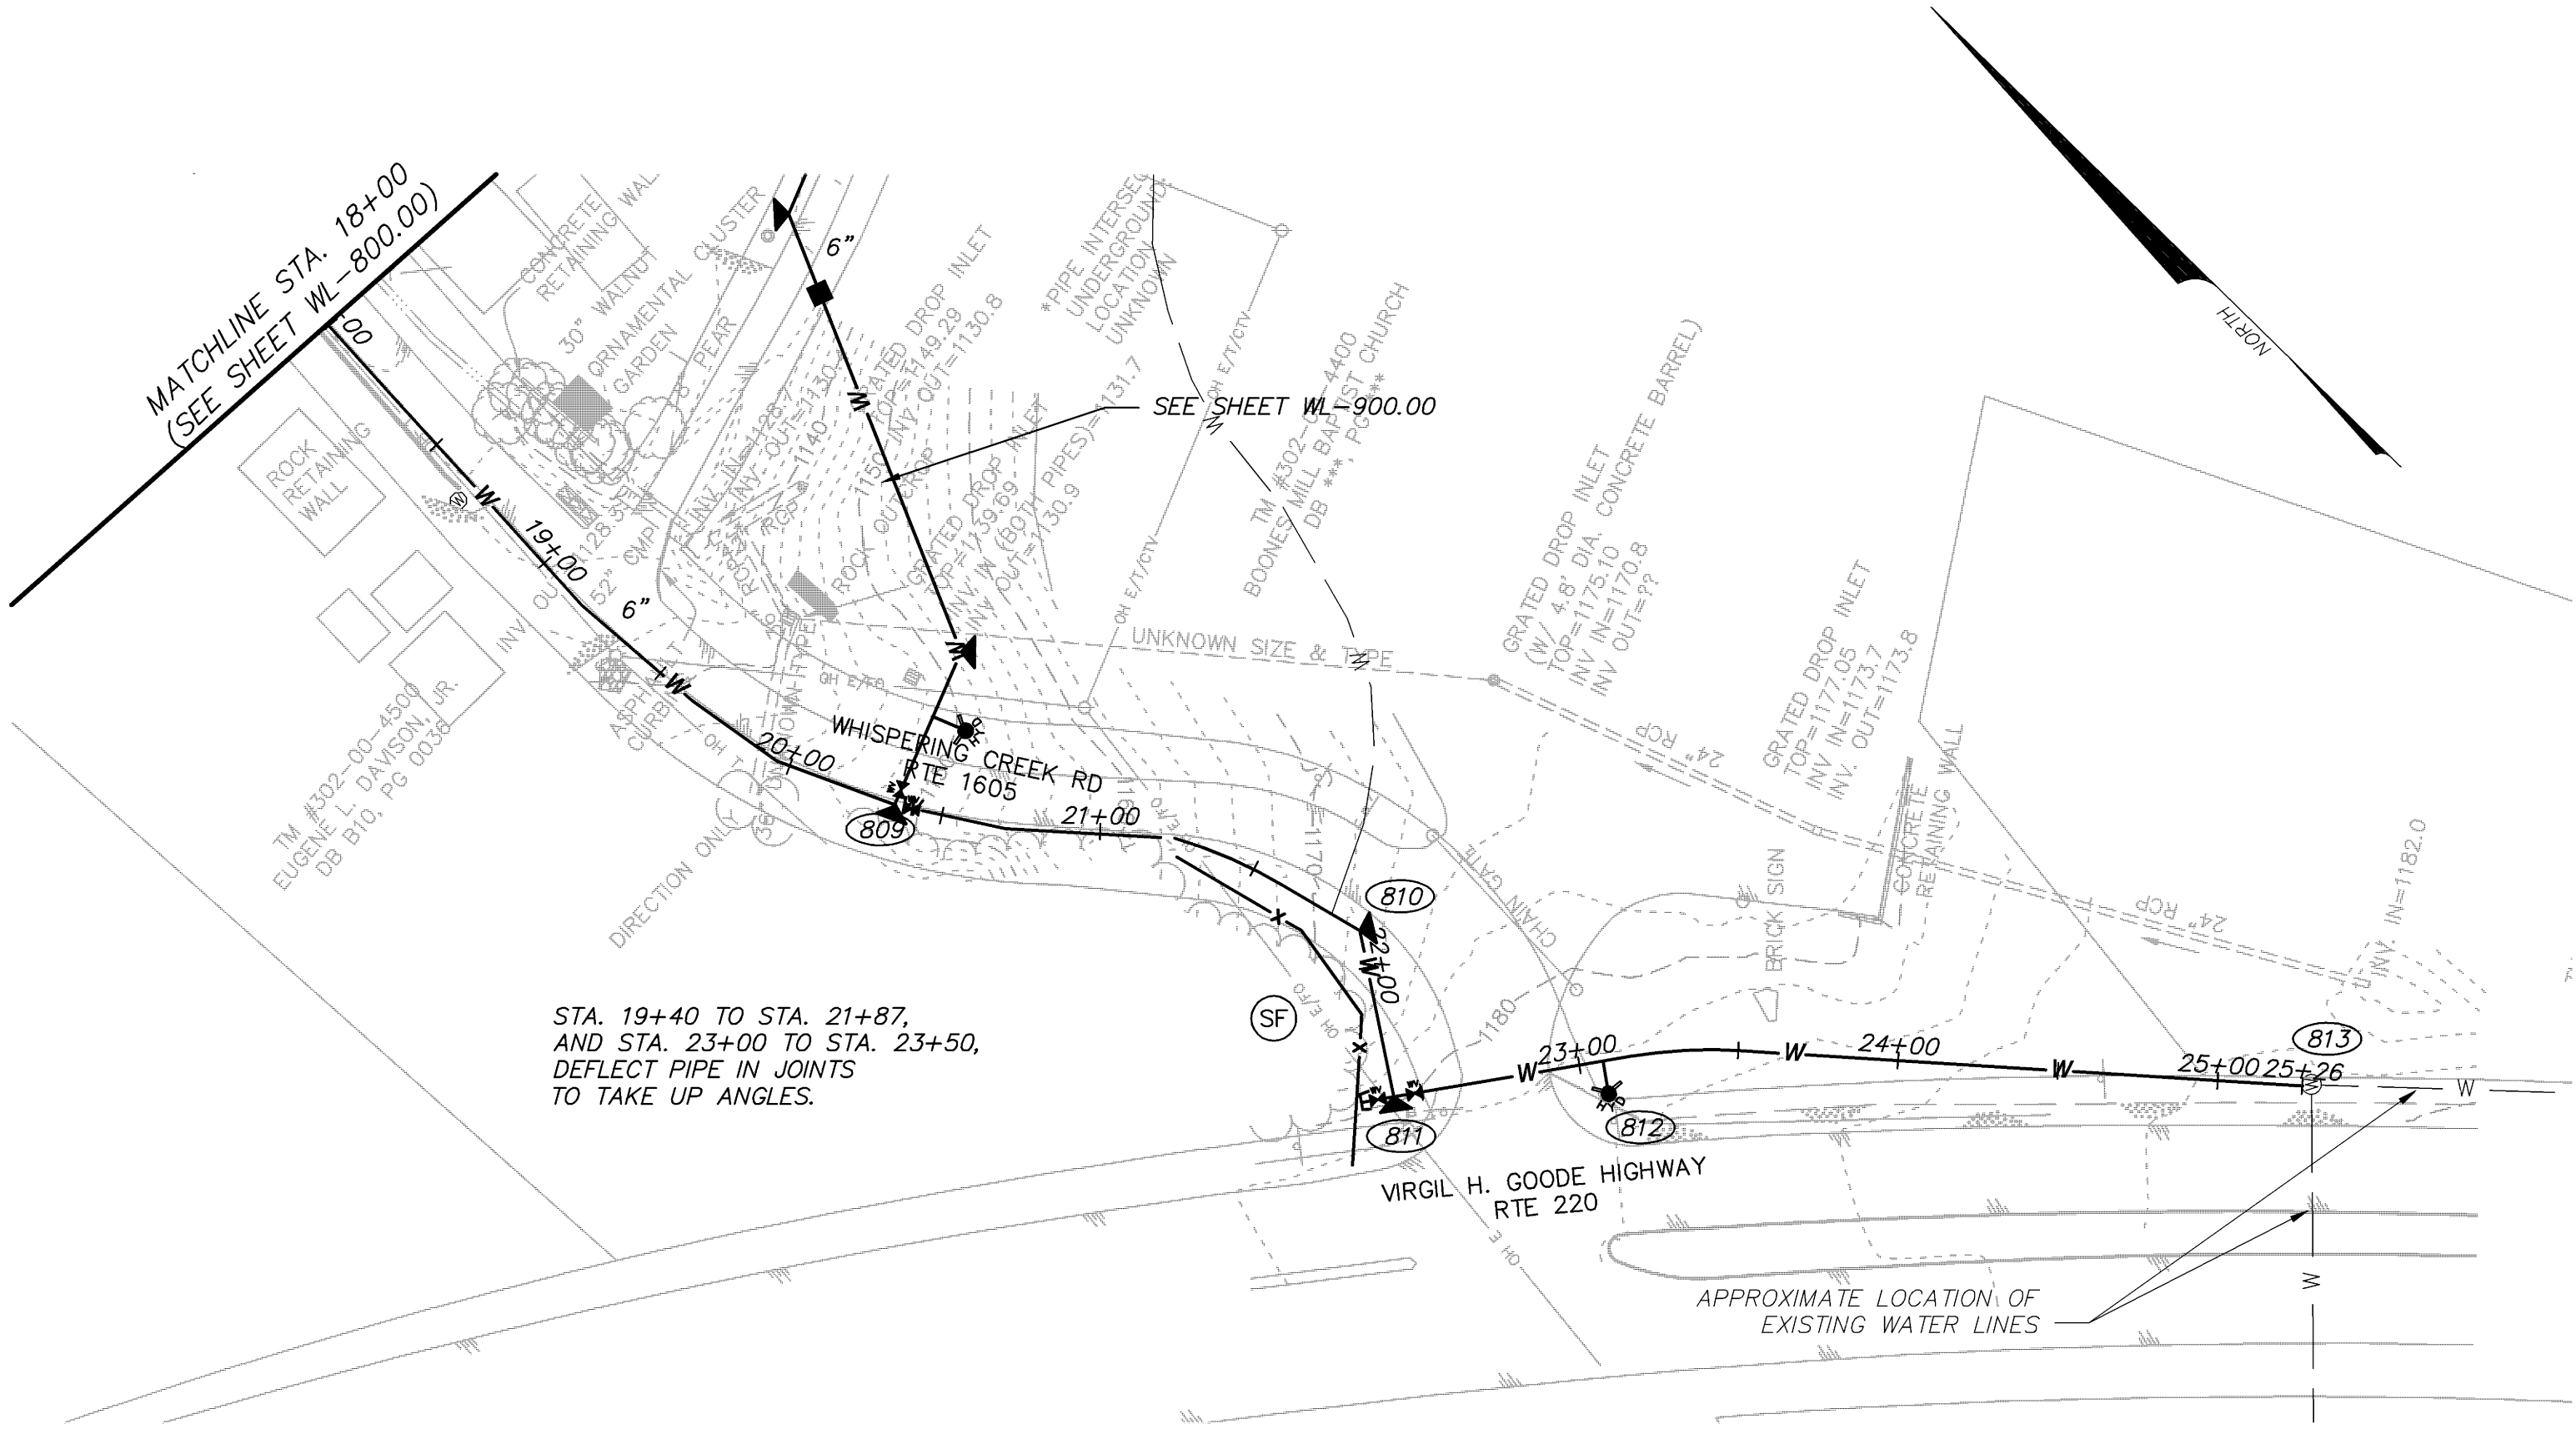

PROPOSED LEGEND

- ⊗ WATER METER
- W— WATER LINE
- BLOW OFF ASSEMBLY
- ⬢ AIR RELEASE
- ⊕ FIRE HYDRANT
- ⊕ CONCRETE ANCHOR
- ⊕ GATE VALVE
- ⊕ STEEL CASING
- △ SLOPE ANCHOR
- E.O.L. END OF LINE

EXISTING LEGEND

- ⊕ ELECTRIC POLE
- ⊕ GUY WIRE
- ⊕ UTILITY PEDESTAL
- ⊕ LIGHT POLE
- ⊕ EDGE OF PAVEMENT
- ⊕ EDGE OF GRAVEL
- ⊕ BENCHMARK
- ⊕ SIGN
- ⊕ CONCRETE PAD
- ⊕ EDGE OF WOODS
- ⊕ EXISTING FENCE LINE
- ⊕ OVERHEAD ELECTRIC
- ⊕ UG ELECTRIC LINE
- ⊕ UG GAS LINE
- ⊕ UG TELEPHONE LINE
- ⊕ UG FIBER OPTIC LINE
- ⊕ UG WATER LINE
- ⊕ DITCH LINE

*ENGINEERING >> SURVEYING >> PLANNING

HURT & PROFFITT
INCORPORATED

2524 LANGHORNE ROAD
LYNCHBURG VA 24501
800.242.6906 TOLL FREE
434.847.7796 MAIN
434.847.0047 FAX

STA. 18+00 - 25+26± EOL WHISPERING CREEK ROAD-ASBUILT
FOR
TOWN OF BOONES MILL WATER SYSTEM REPLACEMENT, VOLUME 1
TOWN OF BOONES MILL, BOONE DISTRICT, FRANKLIN COUNTY, VA

PROJECT NO.	20080815
G.L. NO.	297-03-A3.9
FILE NO.	G-12675
DATE:	7/31/09
DRAWN BY:	WCH
CHECKED BY:	BLC

HURT & PROFFITT

SHEET NO.
WL-800.01

1	8/28/09	VDH COMMENTS
2	9/3/09	OWNER COMMENTS
4	3/14/12	ASBUILTS