

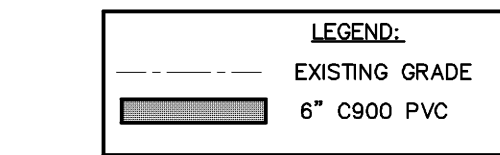
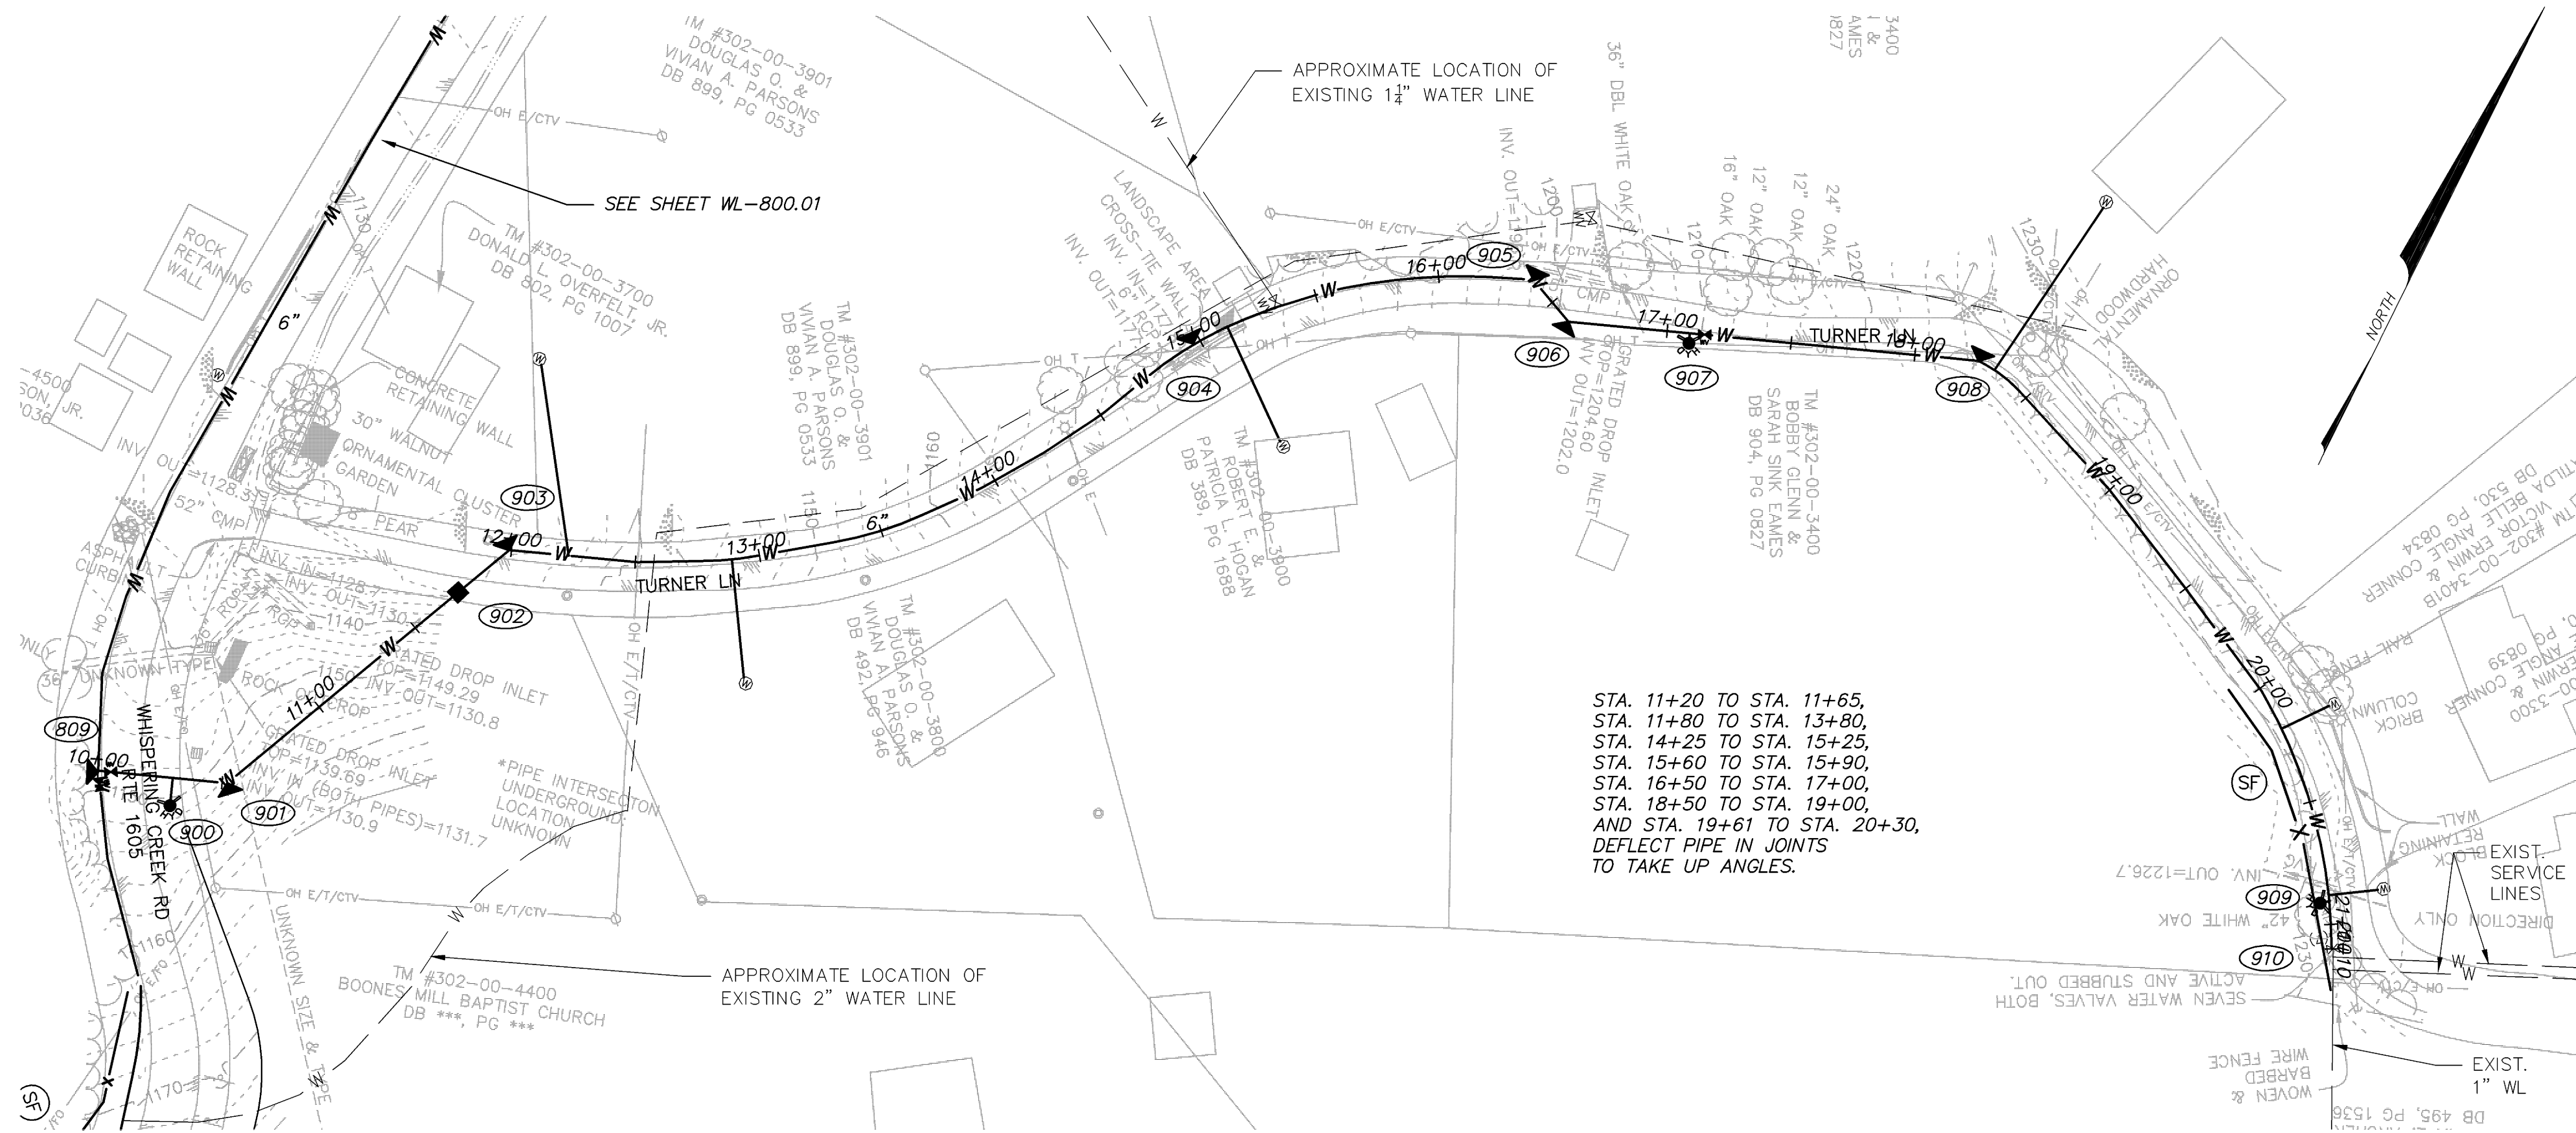
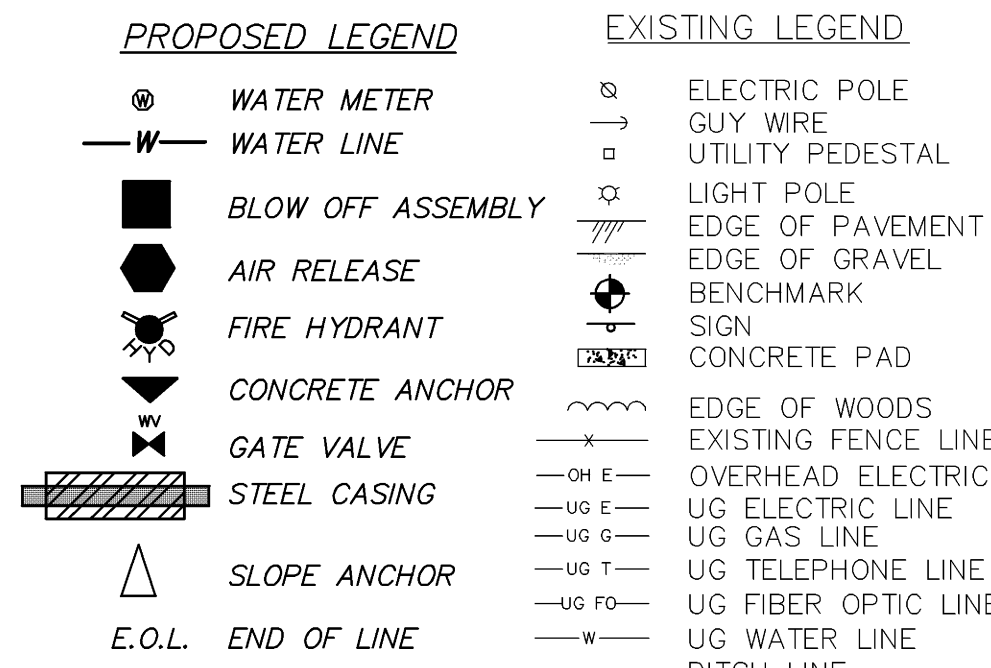


Mar 14, 2012 - 10:38am V:\LandProjects\20080815.dwg\Asbults-WL-ASBULT-P-P-Water.dwg

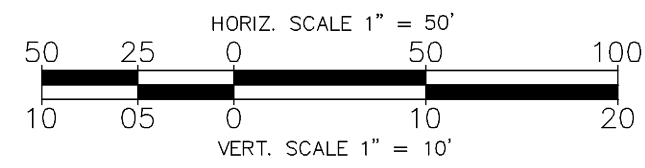

PROFILE INFORMATION TAKEN FROM RECORD DRAWINGS

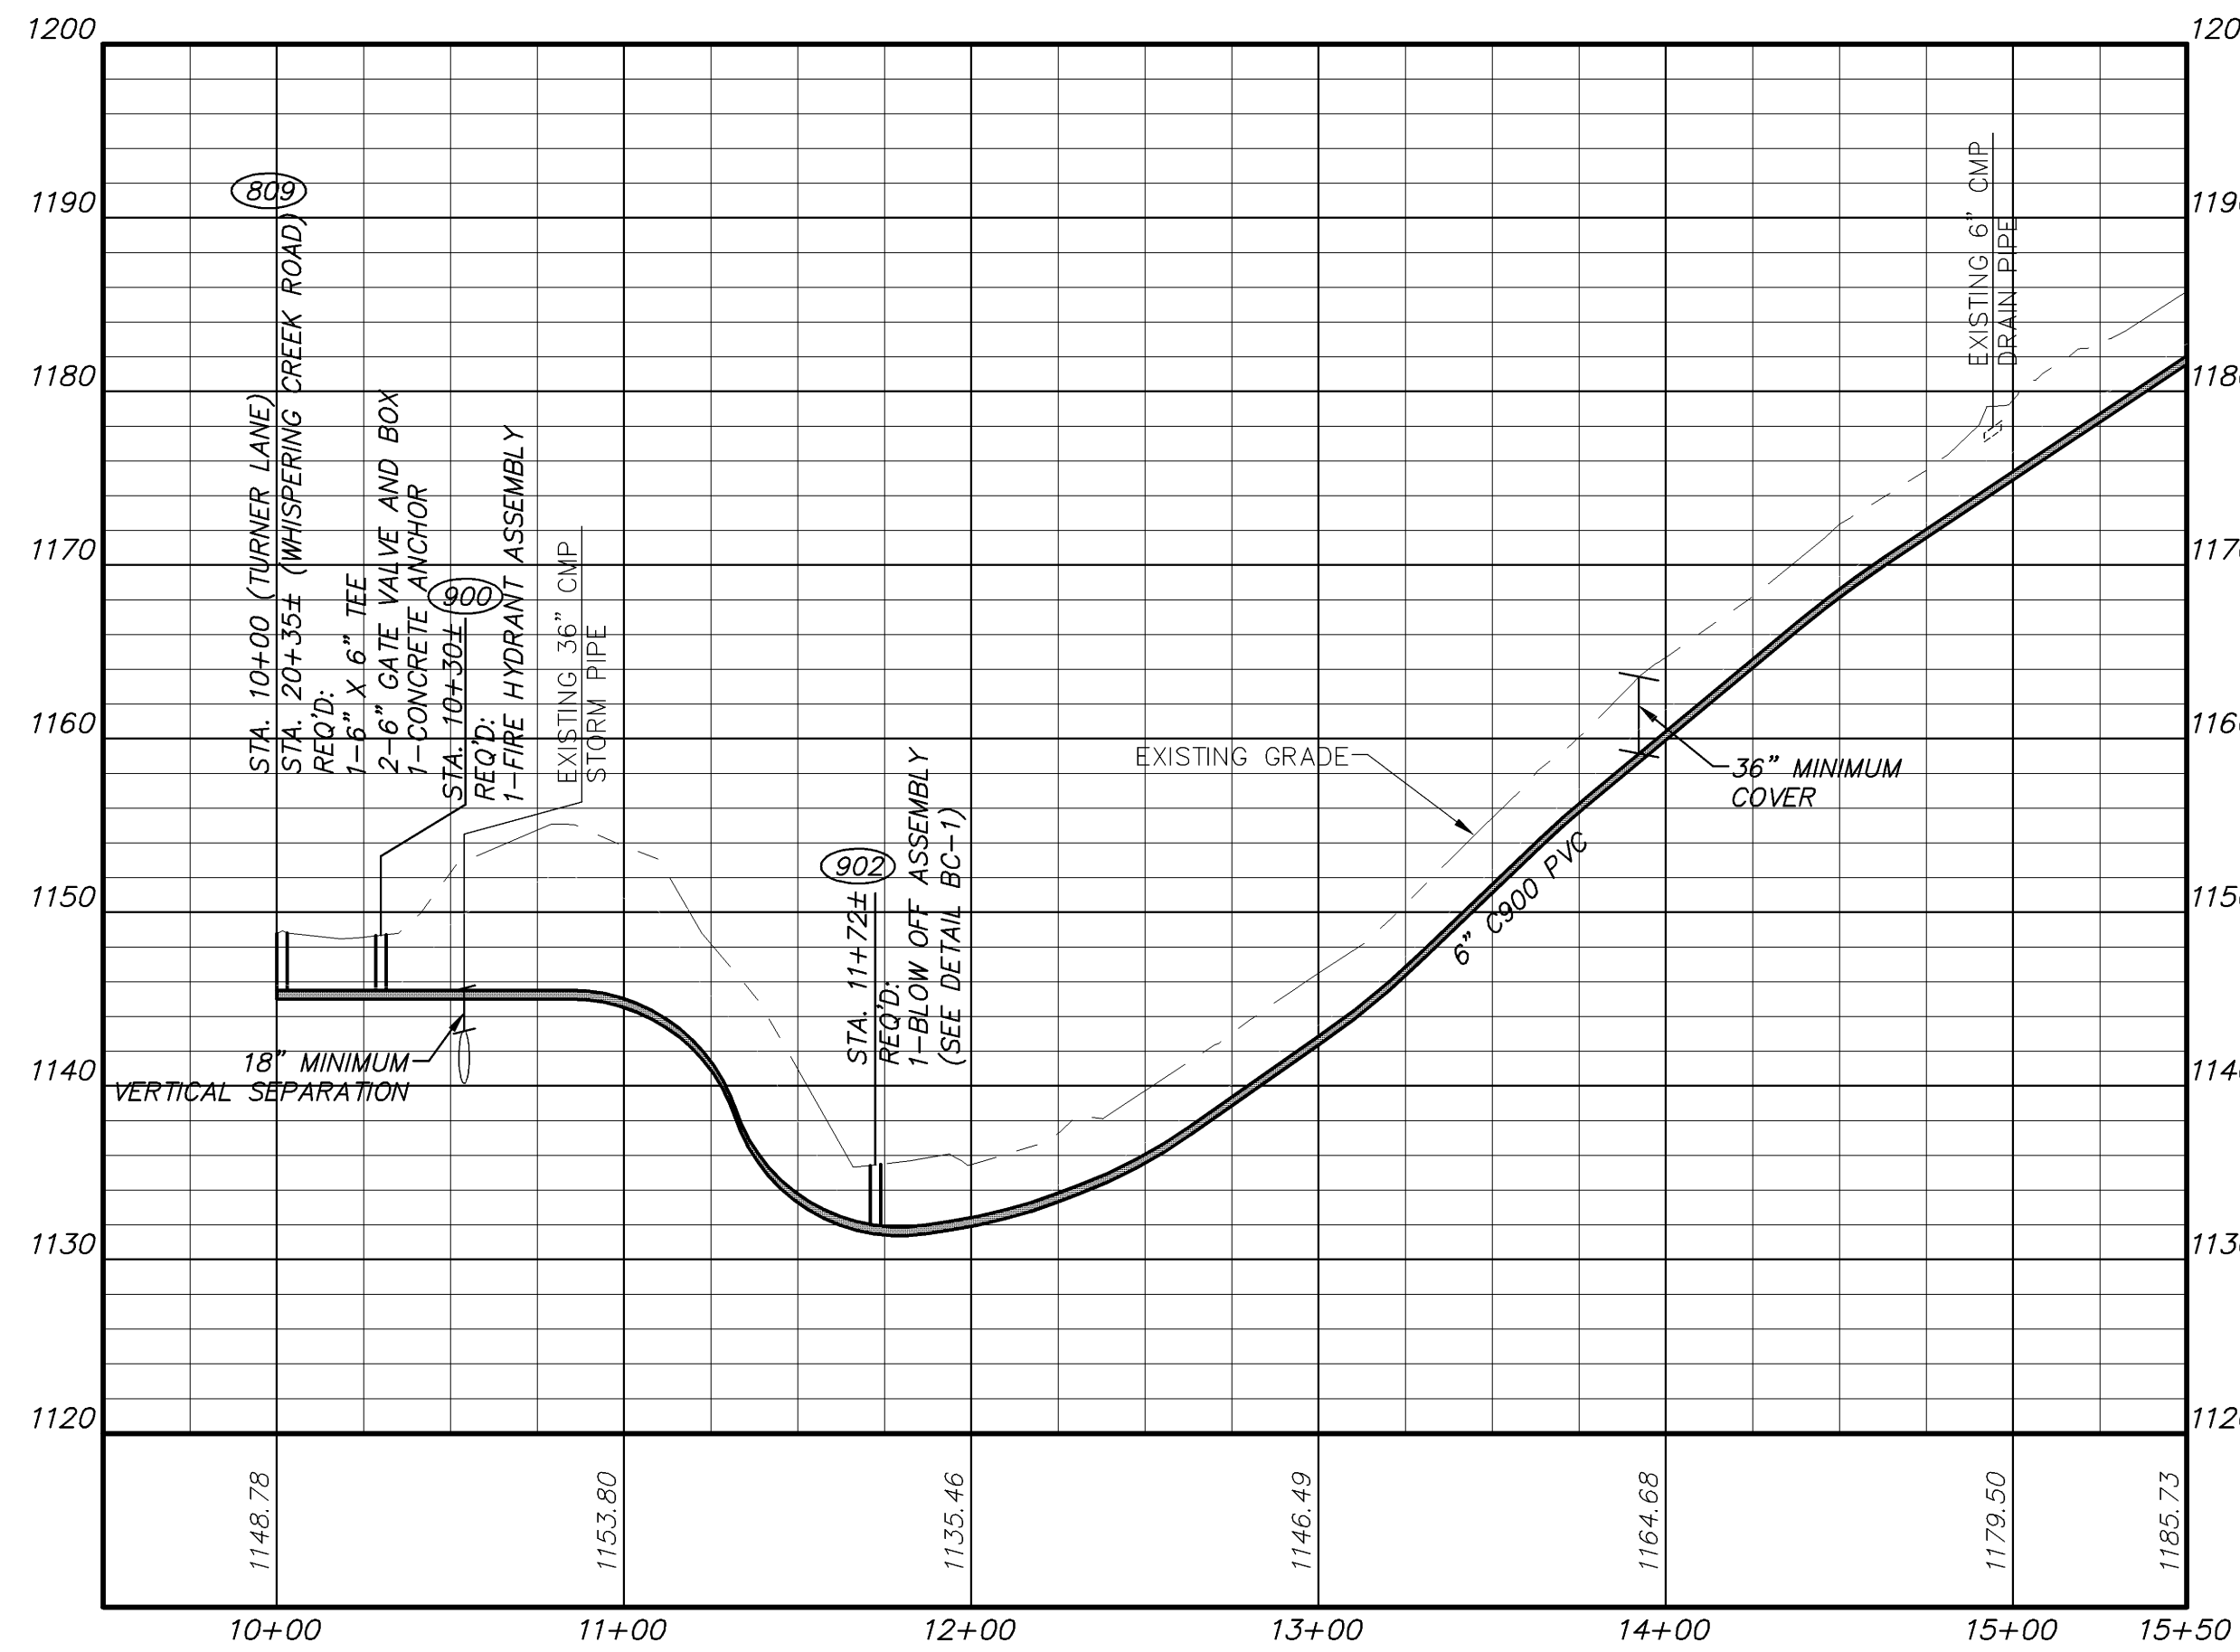

WATER LINE STRUCTURE SCHEDULE

809	STA. 10+00 (TURNER LANE) STA. 20+35± (WHISPERING CREEK ROAD) REQ'D: 1-6" X 6" TEE 2-6" GATE VALVE AND BOX 1-CONCRETE ANCHOR
900	STA. 10+30± REQ'D: 1-FIRE HYDRANT ASSEMBLY
901	STA. 10+52± REQ'D: 1-6" 45' BEND 1-CONCRETE ANCHOR
902	STA. 11+72± REQ'D: 1-BLOW OFF ASSEMBLY (SEE DETAIL BC-1)
903	STA. 11+99± REQ'D: 1-6" 45' BEND 1-CONCRETE ANCHOR
904	STA. 14+97± REQ'D: 1-6" 11.25' BEND 1-CONCRETE ANCHOR
905	STA. 16+38± REQ'D: 1-6" 45' BEND 1-CONCRETE ANCHOR
906	STA. 16+60± REQ'D: 1-6" 45' BEND 1-CONCRETE ANCHOR
907	STA. 17+09± REQ'D: 1-FIRE HYDRANT ASSEMBLY 1-6" GATE VALVE AND BOX
908	STA. 18+25± REQ'D: 1-6" 22.5' BEND 1-CONCRETE ANCHOR
909	STA. 20+91± REQ'D: 1-FIRE HYDRANT ASSEMBLY
910	STA. 21+10± EOL REQ'D: 1-1" WATER METER (CONTRACTOR TO INSTALL METER AD CONNECT EXISTING 1" WATER LINE TO METER)

*ENGINEERING >> SURVEYING >> PLANNING

HURT & PROFFITT
INCORPORATED
2524 LANGHORNE ROAD
LYNCHBURG VA 24501
800.242.6906 TOLL FREE
434.847.7796 MAIN
434.847.0047 FAX

STA. 10+00 - 21+10± EOL TURNER LANE-ASBULT
FOR
TOWN OF BOONES MILL WATER SYSTEM REPLACEMENT, VOLUME 1
TOWN OF BOONES MILL, BOONE DISTRICT, FRANKLIN COUNTY, VA

PROJECT NO. 20080815
G.L. NO. 297-03-A3.9
FILE NO. G-12675
DATE: 7/31/09
DRAWN BY: WCH
CHECKED BY: BLC

HURT & PROFFITT

SHEET NO.
WL-900.00

1	8/28/09	VDH COMMENTS
2	9/3/09	OWNER COMMENTS
4	3/14/12	ASBULTS