

Mar 14, 2012 - 10:38am V:\LandProjects\20080815.dwg\ASBUILT-P-Water.dwg

LEGEND:	
	EXISTING GRADE
	6" C900 PVC

PROPOSED LEGEND

	WATER METER
	WATER LINE
	BLOW OFF ASSEMBLY
	AIR RELEASE
	FIRE HYDRANT
	CONCRETE ANCHOR
	GATE VALVE
	STEEL CASING
	SLOPE ANCHOR
	E.O.L. END OF LINE

EXISTING LEGEND

	ELECTRIC POLE
	GUY WIRE
	UTILITY PEDESTAL
	LIGHT POLE
	EDGE OF PAVEMENT
	EDGE OF GRAVEL
	BENCHMARK
	SIGN
	CONCRETE PAD
	EDGE OF WOODS
	EXISTING FENCE LINE
	OVERHEAD ELECTRIC
	UG ELECTRIC LINE
	UG GAS LINE
	UG TELEPHONE LINE
	UG FIBER OPTIC LINE
	UG WATER LINE
	DITCH LINE

DEPTH TO TOP OF CASING


STA. 10+10	3.50 FT
STA. 10+20	4.83 FT
STA. 10+30	6.17 FT
STA. 10+40	6.83 FT
STA. 10+47	7.42 FT
STA. 10+61	7.25 FT
STA. 10+73	5.75 FT
STA. 10+83	4.00 FT
STA. 11+02	3.50 FT

6" HDPE PIPE FROM STA. 10+00 TO 11+04±

6" PVC PIPE FROM STA. 11+04 TO 14+46±

WATER LINE STRUCTURE
SCHEDULE

1000	STA. 10+00 REQ'D: 1-12" X 6" TAPPING SLEEVE 1-6" TAPPING VALVE
1001	STA. 10+09± REQ'D: 1-6" 90° BEND 1-CONCRETE ANCHOR
1002	STA. 12+60± REQ'D: 1-6" 90° BEND 1-CONCRETE ANCHOR
1003	STA. 12+83± REQ'D: 1-6" 90° BEND 1-CONCRETE ANCHOR
1004	STA. 19+54± REQ'D: 1-FIRE HYDRANT ASSEMBLY
1005	STA. 24+46± EOL REQ'D: 1-2" BLOW OFF ASSEMBLY 1-6" GATE VALVE AND BOX

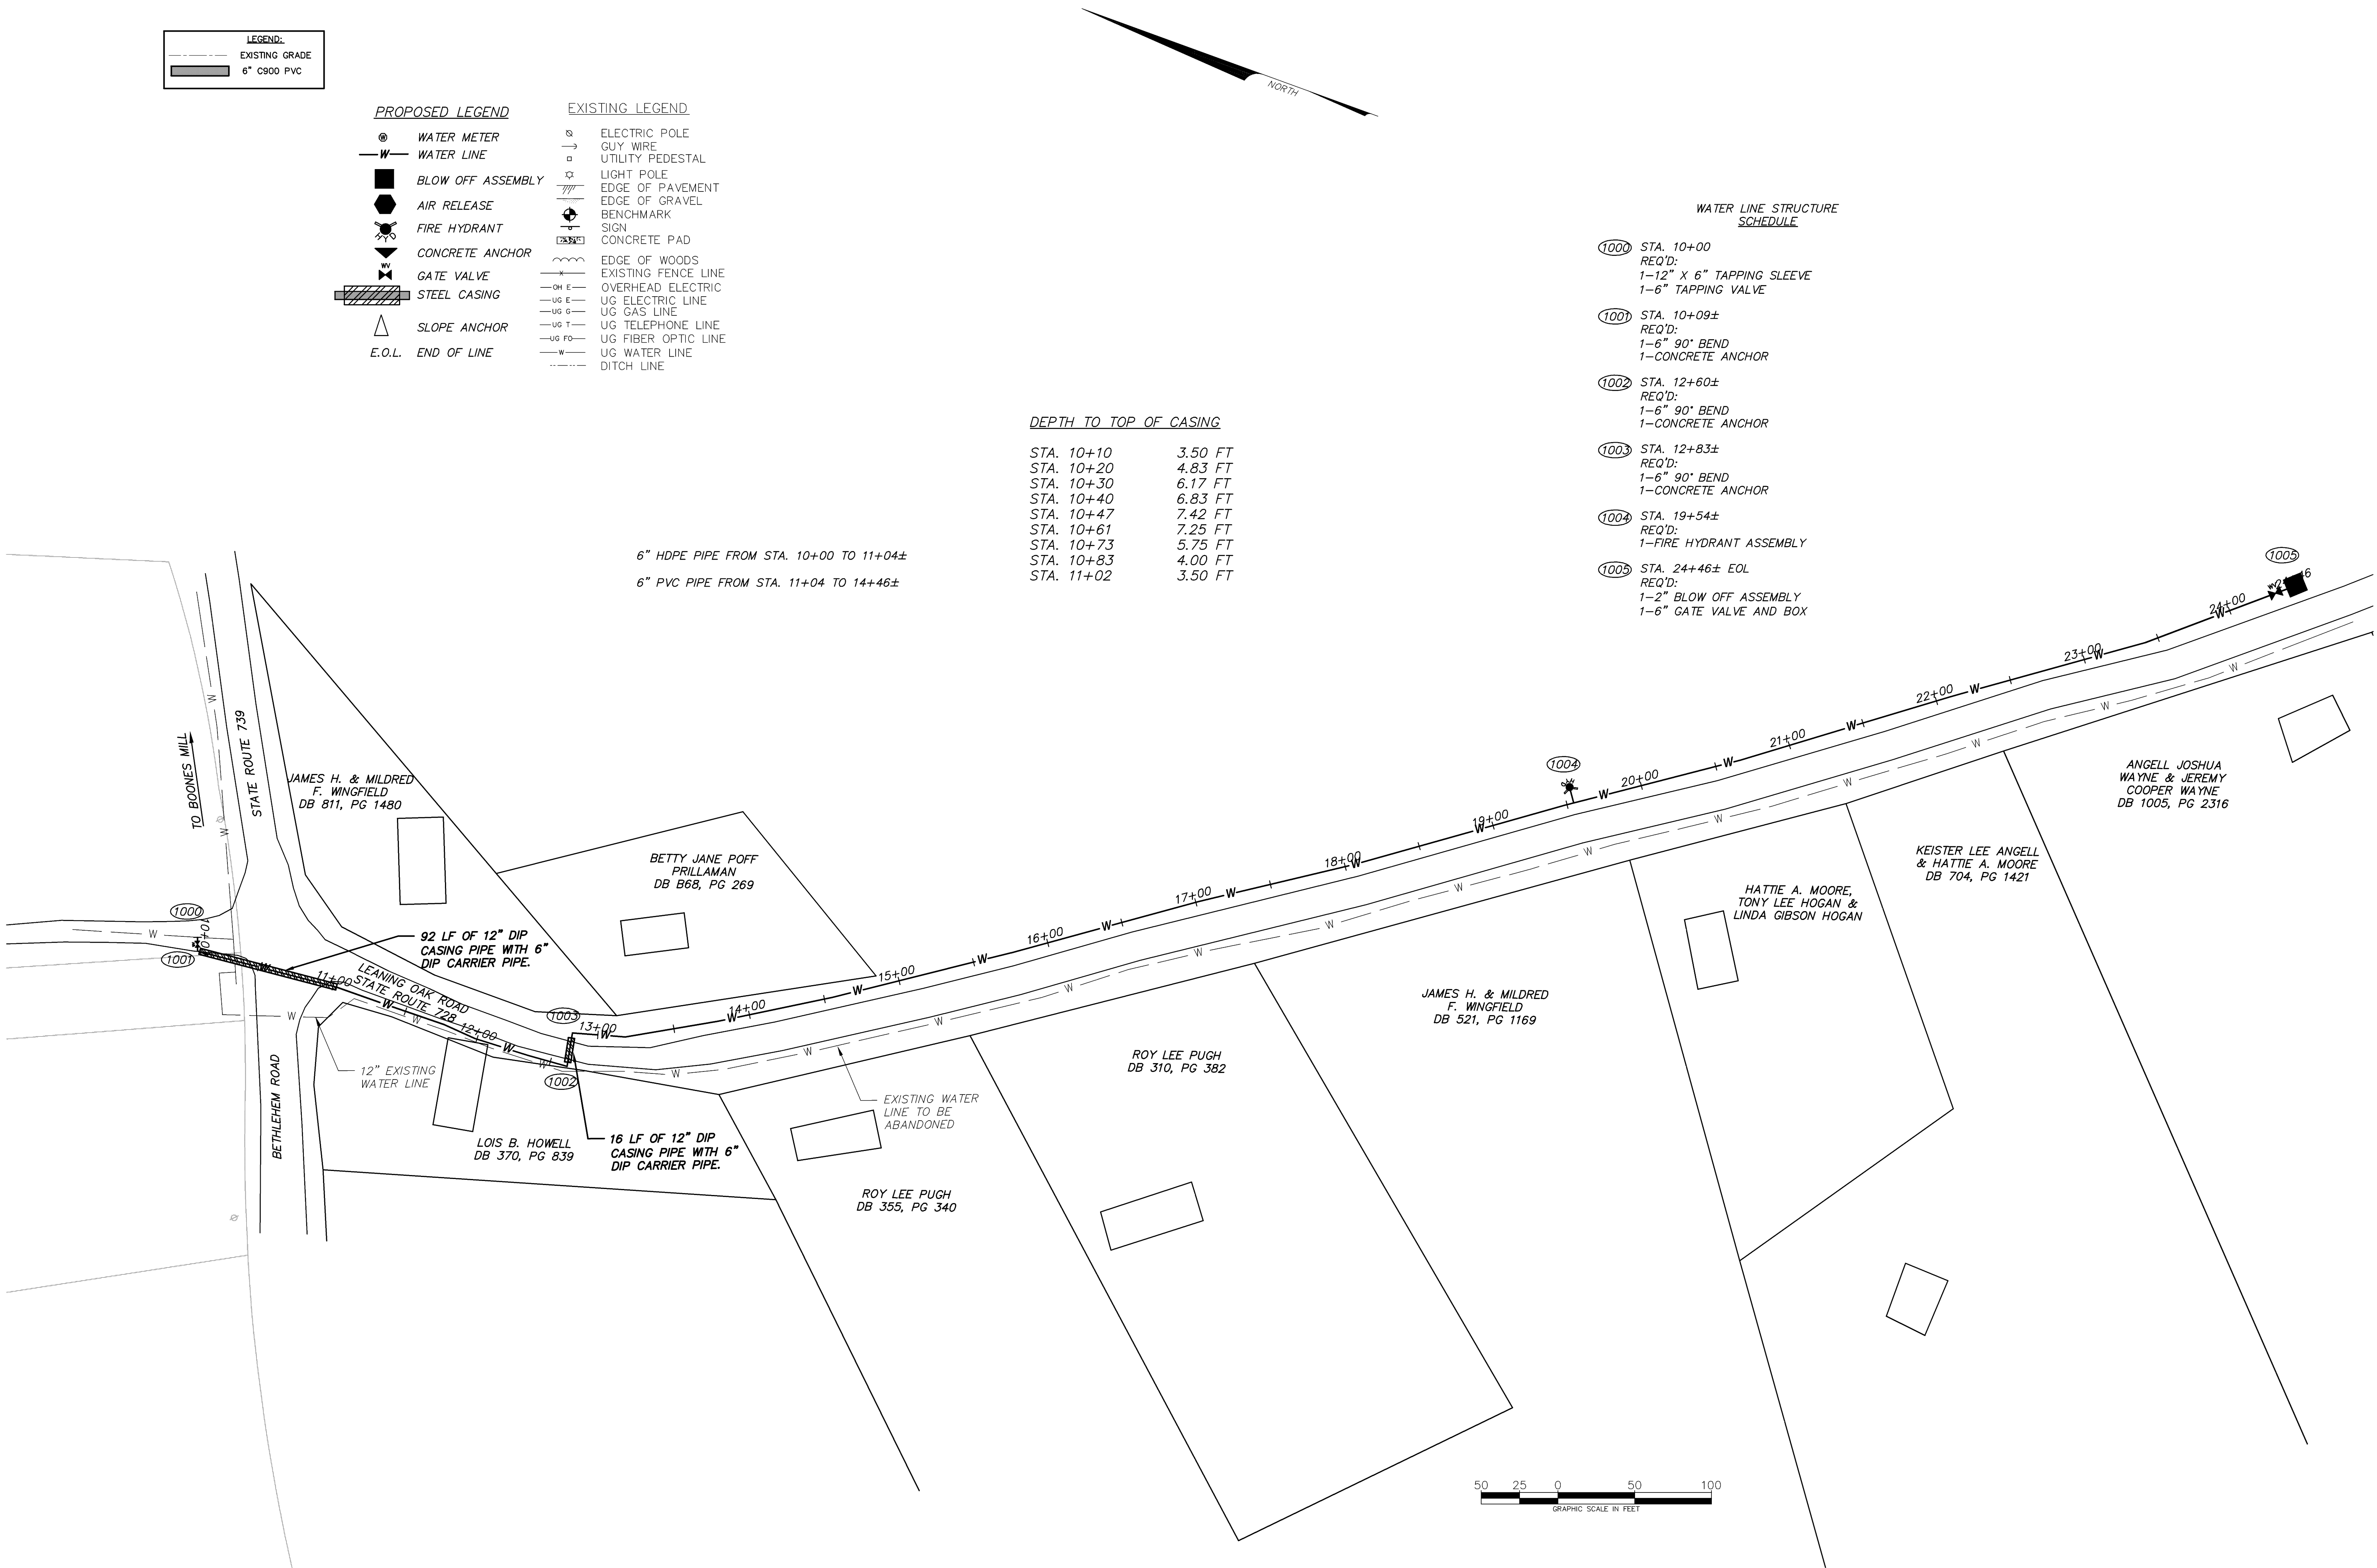

*ENGINEERING >> SURVEYING >> PLANNING

HURT & PROFFITT

INCORPORATED

2524 LANGHORNE ROAD

LYNCHBURG VA 24501

800.242.6906 TOLL FREE

434.847.7796 MAIN

434.847.0047 FAX

STA. 10+00 - 24+46± EOL LEANING OAK-ASBUILT

FOR

TOWN OF BOONES MILL WATER SYSTEM REPLACEMENT, VOLUME 1

TOWN OF BOONES MILL, BOONE DISTRICT, FRANKLIN COUNTY, VA

PROJECT NO.	20080815
G.L. NO.	297-03-A3.9
FILE NO.	G-12675
DATE:	7/31/09
DRAWN BY:	WCH
CHECKED BY:	BLC

HURT & PROFFITT

SHEET NO.
WL-1000.00