


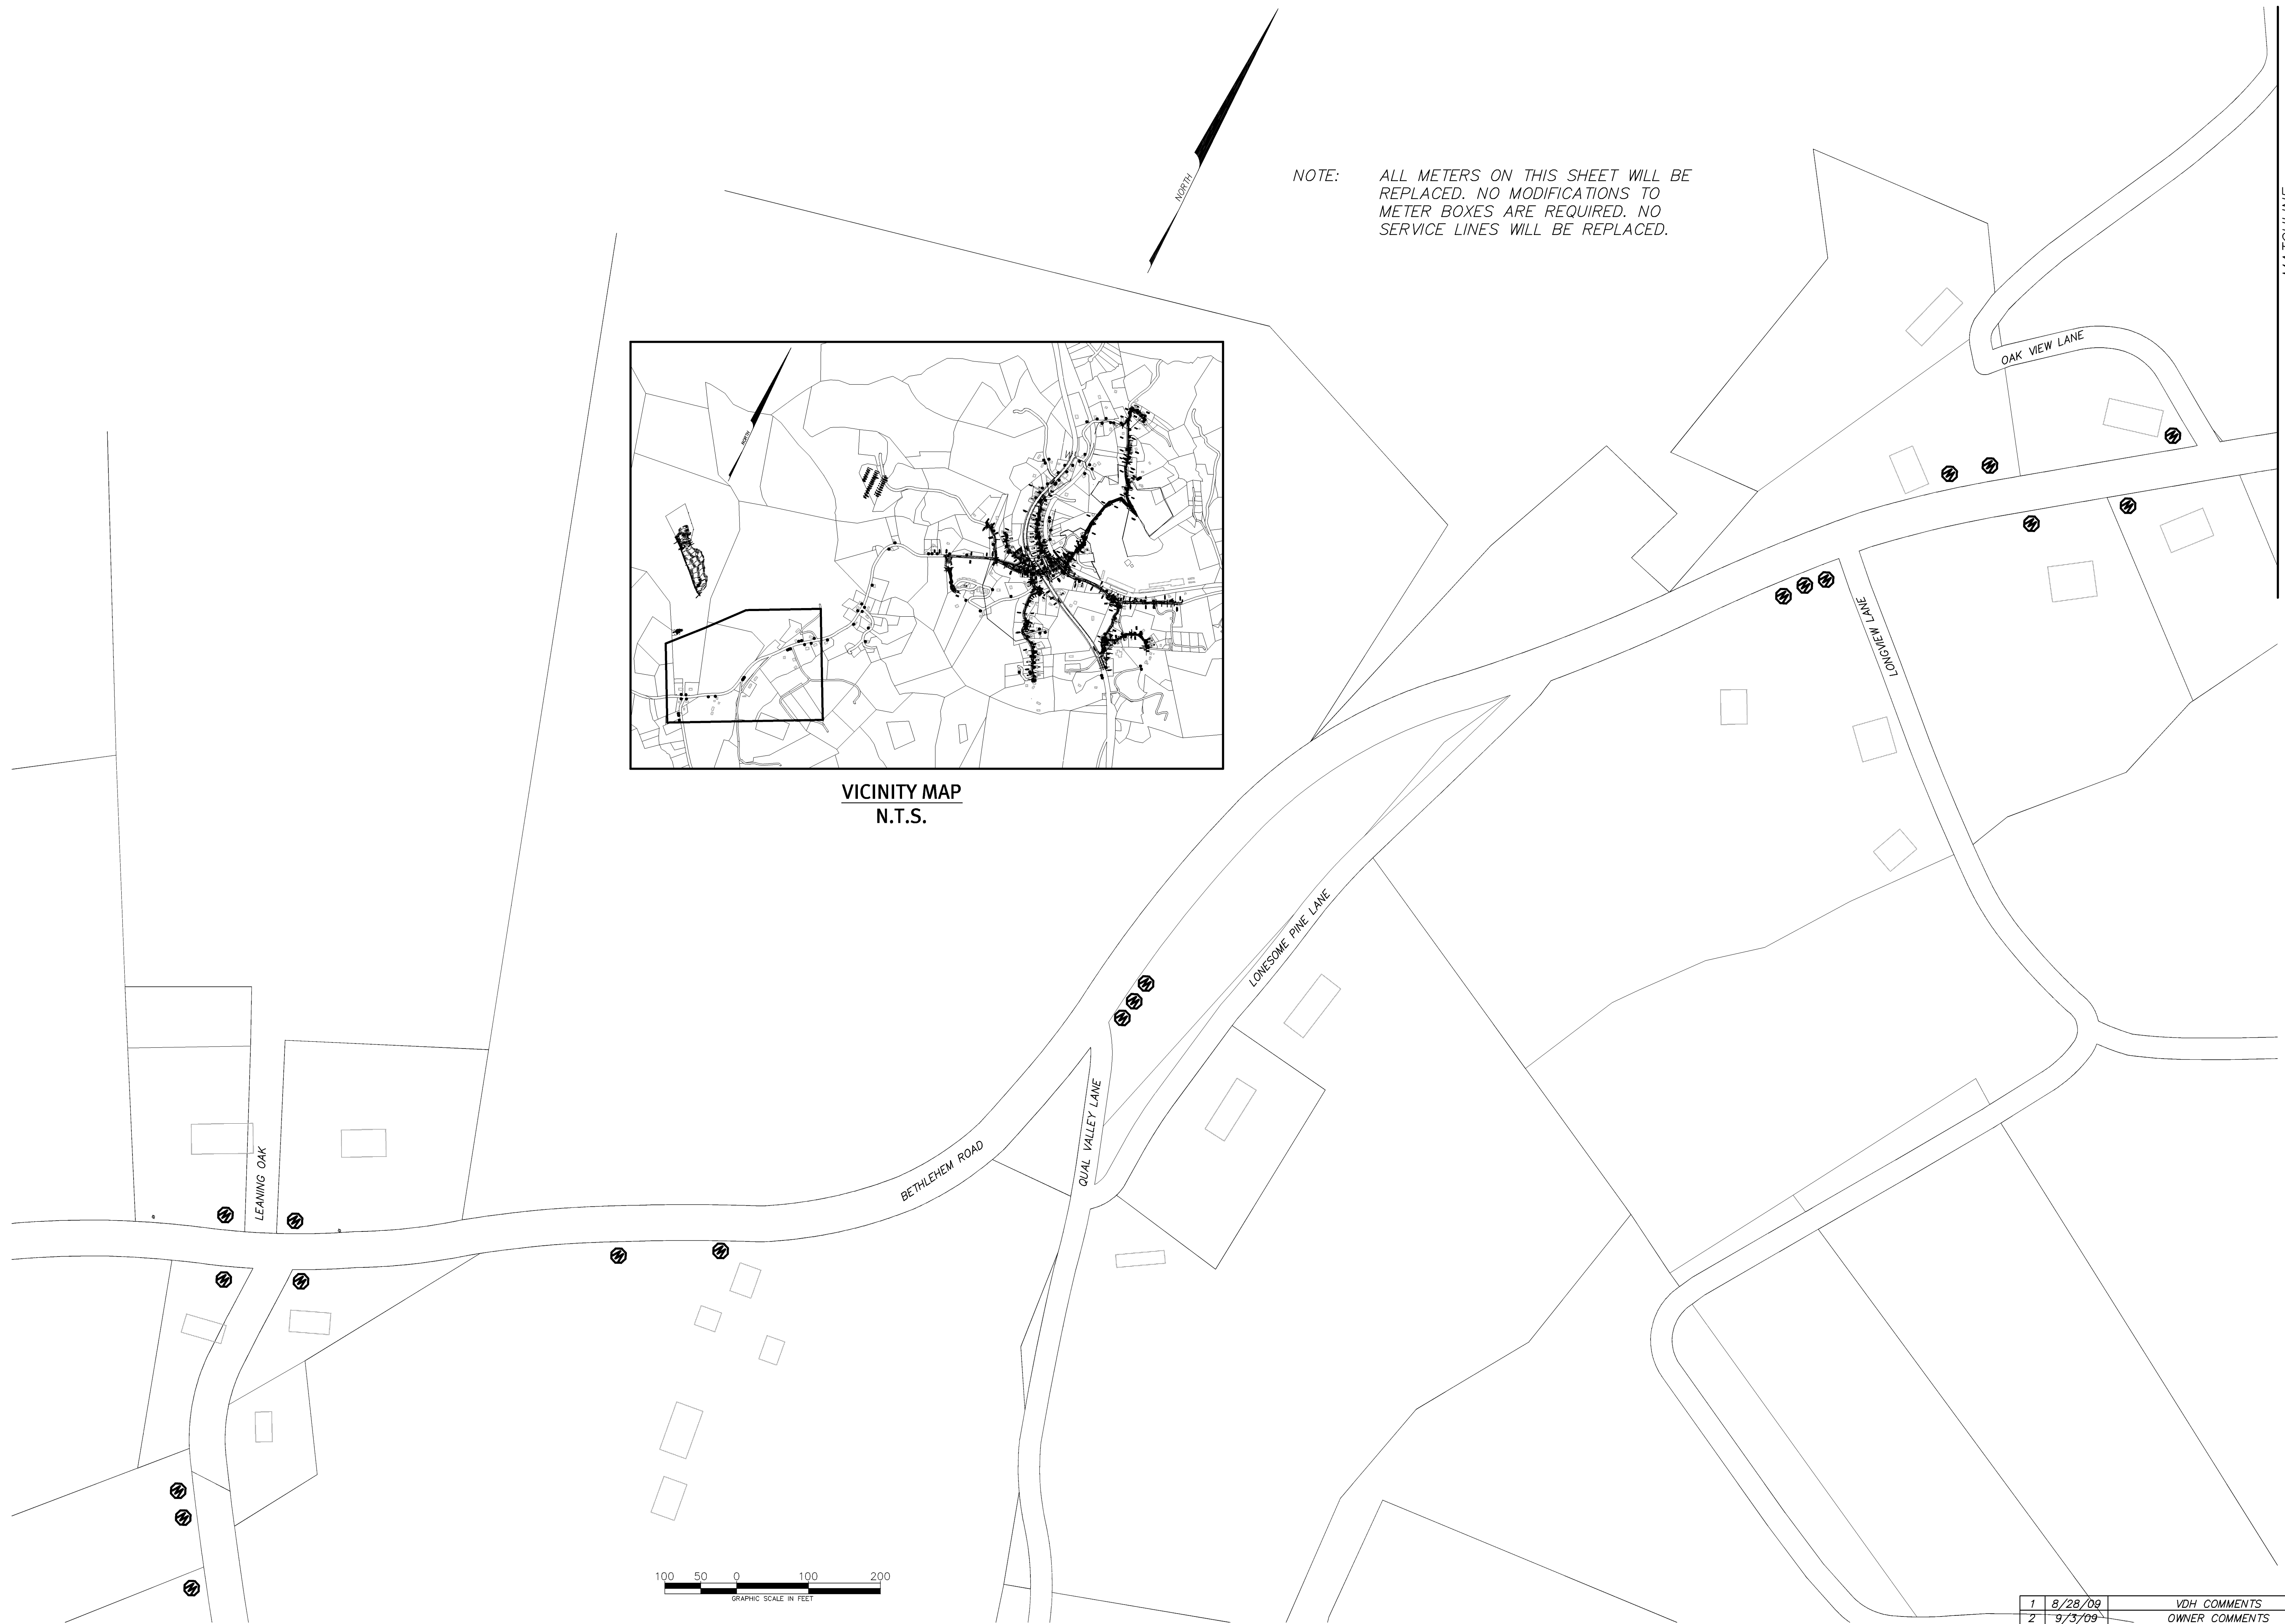

NOTE: ALL METERS ON THIS SHEET WILL BE REPLACED. NO MODIFICATIONS TO METER BOXES ARE REQUIRED. NO SERVICE LINES WILL BE REPLACED.

VICINITY MAP
N.T.S.

MATCHLINE
(SEE SHEET M2.0)

HURT & PROFFITT
INCORPORATED
2524 LANGHORE ROAD
LYNCHBURG VA 24501
800.242.4906 TOLL FREE
434.847.7796 MAIN
434.847.0047 FAX



“ENGINEERING » SURVEYING » PLANNING”

METER MAP 1-ASBUILT
FOR
TOWN OF BOONES MILL WATER SYSTEM REPLACEMENT, VOLUME 1
TOWN OF BOONES MILL, BOONE DISTRICT, FRANKLIN COUNTY, VA

PROJECT NO.	20080815
G.L. NO.	297-03-A3.9
FILE NO.	G-12675
DATE:	8/28/09
DRAWN BY:	WCH
CHECKED BY:	BLC

HURT & PROFFITT

SHEET NO.
M1.0

1	8/28/09	VDH COMMENTS
2	9/3/09	OWNER COMMENTS
4	3/14/12	ASBUILTS