



HURT & PROFFITT
INCORPORATED
* ENGINEERING » SURVEYING » PLANNING

2524 LANGHORNE ROAD
LYNCHBURG VA 24501
800.242.4906 TOLL FREE
434.847.7796 MAIN
434.847.0047 FAX

METER MAP 4-ASBUILT FOR

TOWN OF BOONES MILL WATER SYSTEM REPLACEMENT, VOLUME 1
TOWN OF BOONES MILL, BOONE DISTRICT, FRANKLIN COUNTY, VA

PROJECT NO. 20080815
G.L. NO. 297-03-A3.9
FILE NO. G-12675
DATE: 8/28/09
DRAWN BY: WCH
CHECKED BY: BLC


HURT & PROFFITT

SHEET NO.
M4.0

1	8/28/09	VDH COMMENTS
2	9/3/09	OWNER COMMENTS
4	3/14/12	ASBUILTS

MATCHLINE
(SEE SHEET M3.0)

VICINITY MAP
N.T.S.

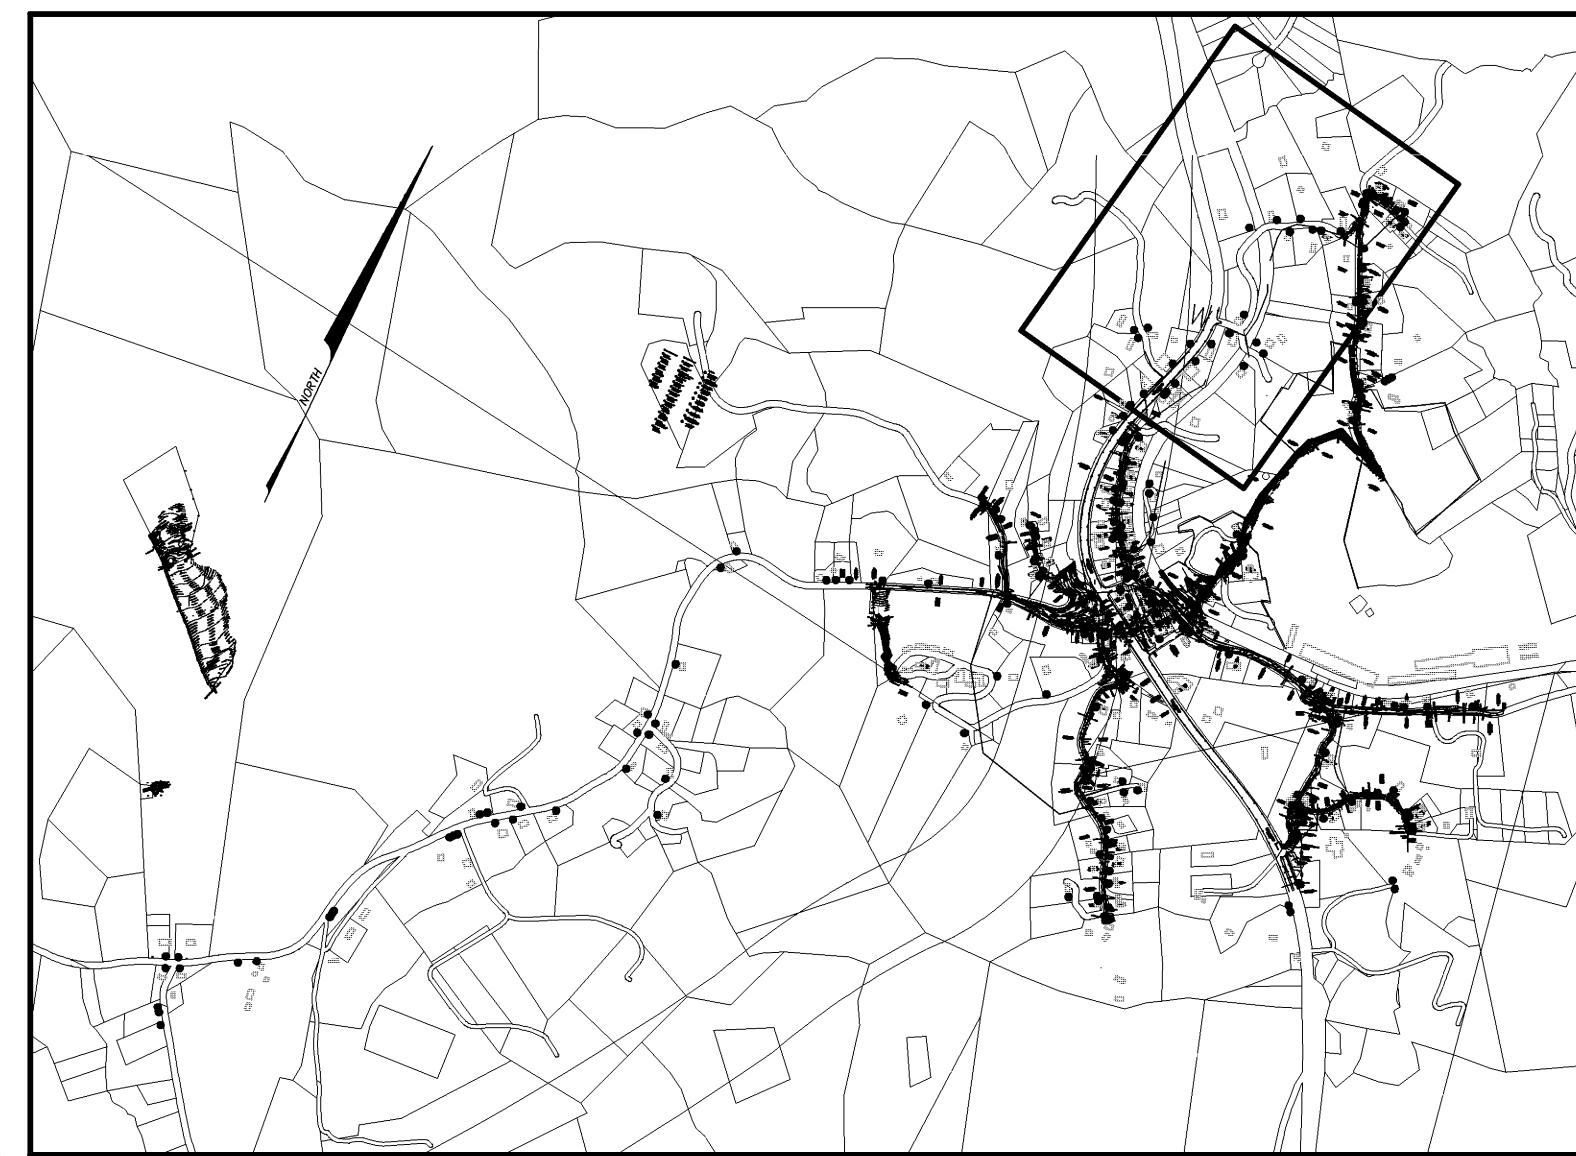

MATCHLINE
(SEE SHEET M6.0)

MATCHLINE
(SEE SHEET M7.0)

NOTE:

ALL METERS SHOWN WILL BE
REPLACED WITH NEW METER BASE
WITH PRV AS SHOWN ON SHEET WL-1.

100 50 0 100 200
GRAPHIC SCALE IN FEET

Mar. 14, 2012 - 10:39am V:\LandProjects\20080815\wsa\Asbuilt\Water_Meter.dwg