
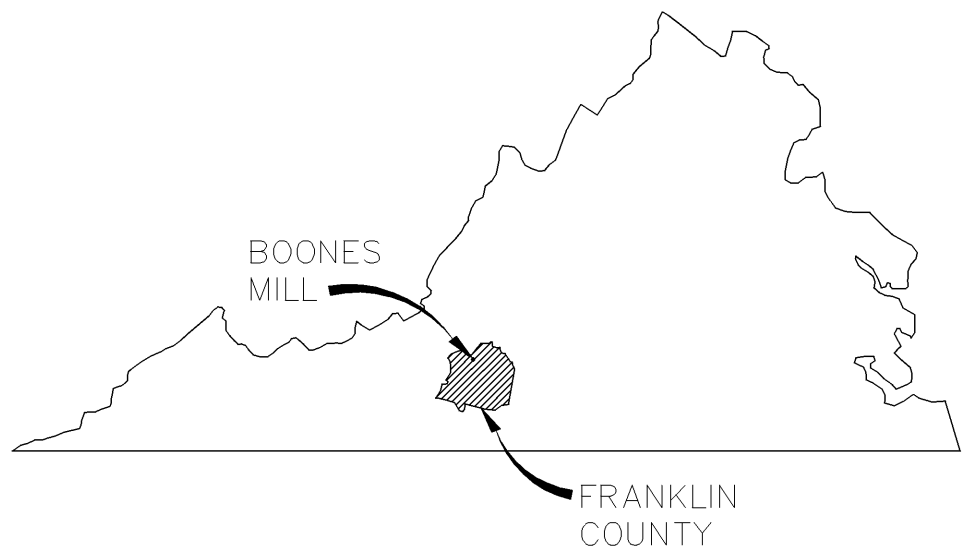


TOWN OF BOONES MILL  
WATER SYSTEM REPLACEMENT, VOLUME 1-ASBUILT  
TOWN OF BOONES MILL, BOONE DISTRICT, FRANKLIN COUNTY, VIRGINIA

- PROPOSED LEGEND**
- WATER METER
  - WATER LINE
  - BLOW OFF ASSEMBLY
  - AIR RELEASE
  - FIRE HYDRANT
  - CONCRETE ANCHOR
  - GATE VALVE
  - STEEL CASING
  - SLOPE ANCHOR
  - E.O.L. END OF LINE
- EXISTING LEGEND**
- ELECTRIC POLE
  - GUY WIRE
  - UTILITY PEDESTAL
  - LIGHT POLE
  - EDGE OF PAVEMENT
  - EDGE OF GRAVEL
  - BENCHMARK
  - SIGN
  - CONCRETE PAD
  - EDGE OF WOODS
  - EXISTING FENCE LINE
  - OVERHEAD ELECTRIC
  - UG ELECTRIC LINE
  - UG GAS LINE
  - UG TELEPHONE LINE
  - UG FIBER OPTIC LINE
  - UG WATER LINE
  - DITCH LINE

VIRGINIA UNIFORM CODING SYSTEM FOR EROSION  
AND SEDIMENT CONTROL PRACTICES  
\* CHART TAKEN FROM THE VIRGINIA EROSION AND  
SEDIMENT CONTROL HANDBOOK (JULY 1992)

- SILT FENCE
- TEMPORARY SEEDING
- PERMANENT SEEDING
- MULCHING
- TEMPORARY CONSTRUCTION  
ENTRANCE
- CULVERT INLET PROTECTION
- INLET PROTECTION
- BLANKET MATTING
- SURFACE ROUGHING
- OUTLET PROTECTION

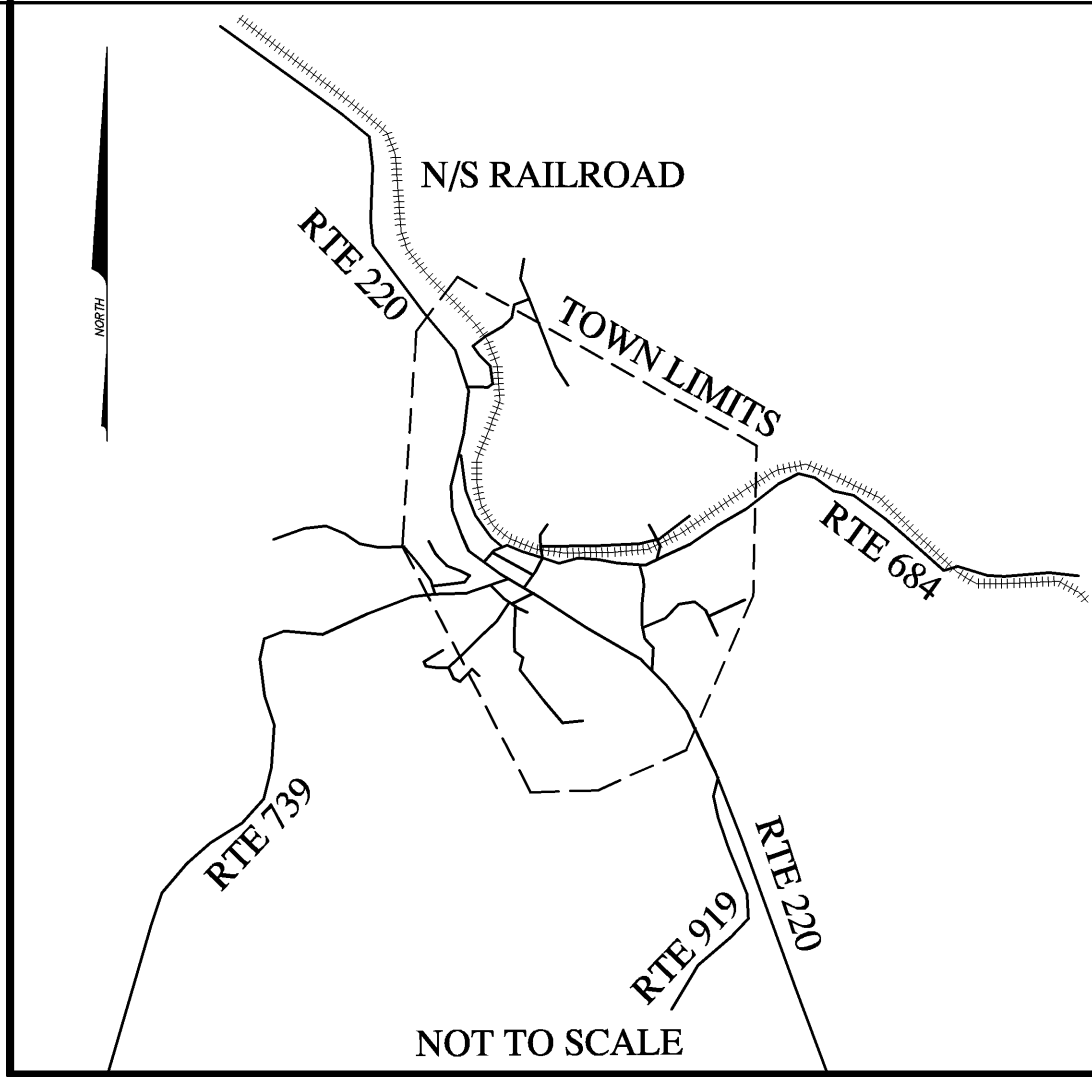

**SHEET INDEX**

C0.0 COVER SHEET  
C0.1 NOTES  
C0.2 PROJECT MAP  
C0.3 E&S NARRATIVE AND DETAILS

WL-100.00 HEATHERWOOD LANE STA. 10+00-17+61± EOL  
WL-200.00 MOUNTAINAIRE LANE STA. 10+00-17+46± EOL  
WL-300.00 OAKWOOD DRIVE STA. 10+00-22+52± EOL  
WL-400.00 DOGWOOD HILL ROAD STA. 10+00-21+00  
WL-400.01 DOGWOOD HILL ROAD STA. 21+00-34+60± EOL  
WL-500.00 WINDING WAY STA. 10+00-23+00±  
WL-500.01 WINDING WAY STA. 23+00-32+00±  
WL-500.02 WINDING WAY STA. 32+00-45+00±  
WL-500.03 WINDING WAY STA. 45+00-58+00±  
WL-500.04 WINDING WAY STA. 58+00-68+98± EOL  
WL-600.00 EASY STREET STA. 10+00-15+30± EOL  
WL-700.00 BOONES MILL ROAD STA. 10+00-21+68  
WL-800.00 WHISPERING CREEK ROAD STA. 10+00-18+00  
WL-800.01 WHISPERING CREEK ROAD STA. 18+00-25+26± EOL  
WL-900.00 TURNER LANE STA. 10+00-21+10± EOL  
WL-1000.00 LEANING OAK STA. 10+00-24+47± EOL  
WL-1 WATER LINE DETAILS  
WL-2 WATER LINE DETAILS

M1.0 METER MAP 1  
M2.0 METER MAP 2  
M3.0 METER MAP 3  
M4.0 METER MAP 4  
M5.0 METER MAP 5  
M6.0 METER MAP 6  
M7.0 METER MAP 7

THE ENGINEER AND/OR SURVEYOR TAKES NO RESPONSIBILITY FOR THE  
LOCATION OR ACCURACY OF THE UTILITIES AS SHOWN HEREON OR ANY  
UTILITIES WITHIN THE PROJECT THAT MAY NOT BE SHOWN HEREON. THE  
CONTRACTOR SHALL BE RESPONSIBLE FOR CONTACTING THE UTILITY  
COMPANIES TO SEE IF ANY UTILITIES EXIST WITHIN THE AREA OF THE  
PROJECT BEFORE ANY CONSTRUCTION BEGINS. ANY COST INCURRED BY  
DAMAGING ANY UTILITY WITHIN THE PROJECT SHALL BE AT THE EXPENSE  
OF THE CONTRACTOR.

48 WORKING HOURS PRIOR TO STARTING THE WORK, THE CONTRACTOR  
SHALL CALL MISS UTILITY AT PHONE NUMBER 811 AND ADVISE THE  
NATURE AND LOCATION OF THE WORK.



\* ENGINEERING >>> SURVEYING >>> PLANNING

**HURT & PROFFITT**  
INCORPORATED  
2524 LANGHORNE ROAD  
LYNCHBURG VA 24501  
800.242.4906 TOLL FREE  
434.847.7796 MAIN  
434.847.0047 FAX

**COVER SHEET-ASBUILT**  
FOR  
**TOWN OF BOONES MILL WATER SYSTEM REPLACEMENT, VOLUME 1**  
**TOWN OF BOONES MILL, BOONE DISTRICT, FRANKLIN COUNTY, VA**

PROJECT NO. 20080815  
G.L. NO. 297-03-A3.9  
FILE NO. G-12675  
DATE: 7/31/09  
DRAWN BY: WCH  
CHECKED BY: BLC

**HURT & PROFFITT**


SHEET NO.  
**C0.0**

PLAN REVISIONS			
#	DATE	DESCRIPTION OF REVISION	SHEETS
1	8/28/09	VDH COMMENTS	ALL
2	9/3/09	OWNER COMMENTS	ALL
3	2/17/10	REVISED ALIGNMENT	WL-500.00, 600.00, 700.00
4	3/14/12	ASBUILTS	ALL





Mar 14, 2012 10:24am V:\LandProjects\20080815\dwg\Asbuilts-WL\ASBUILT-cover-WL.dwg

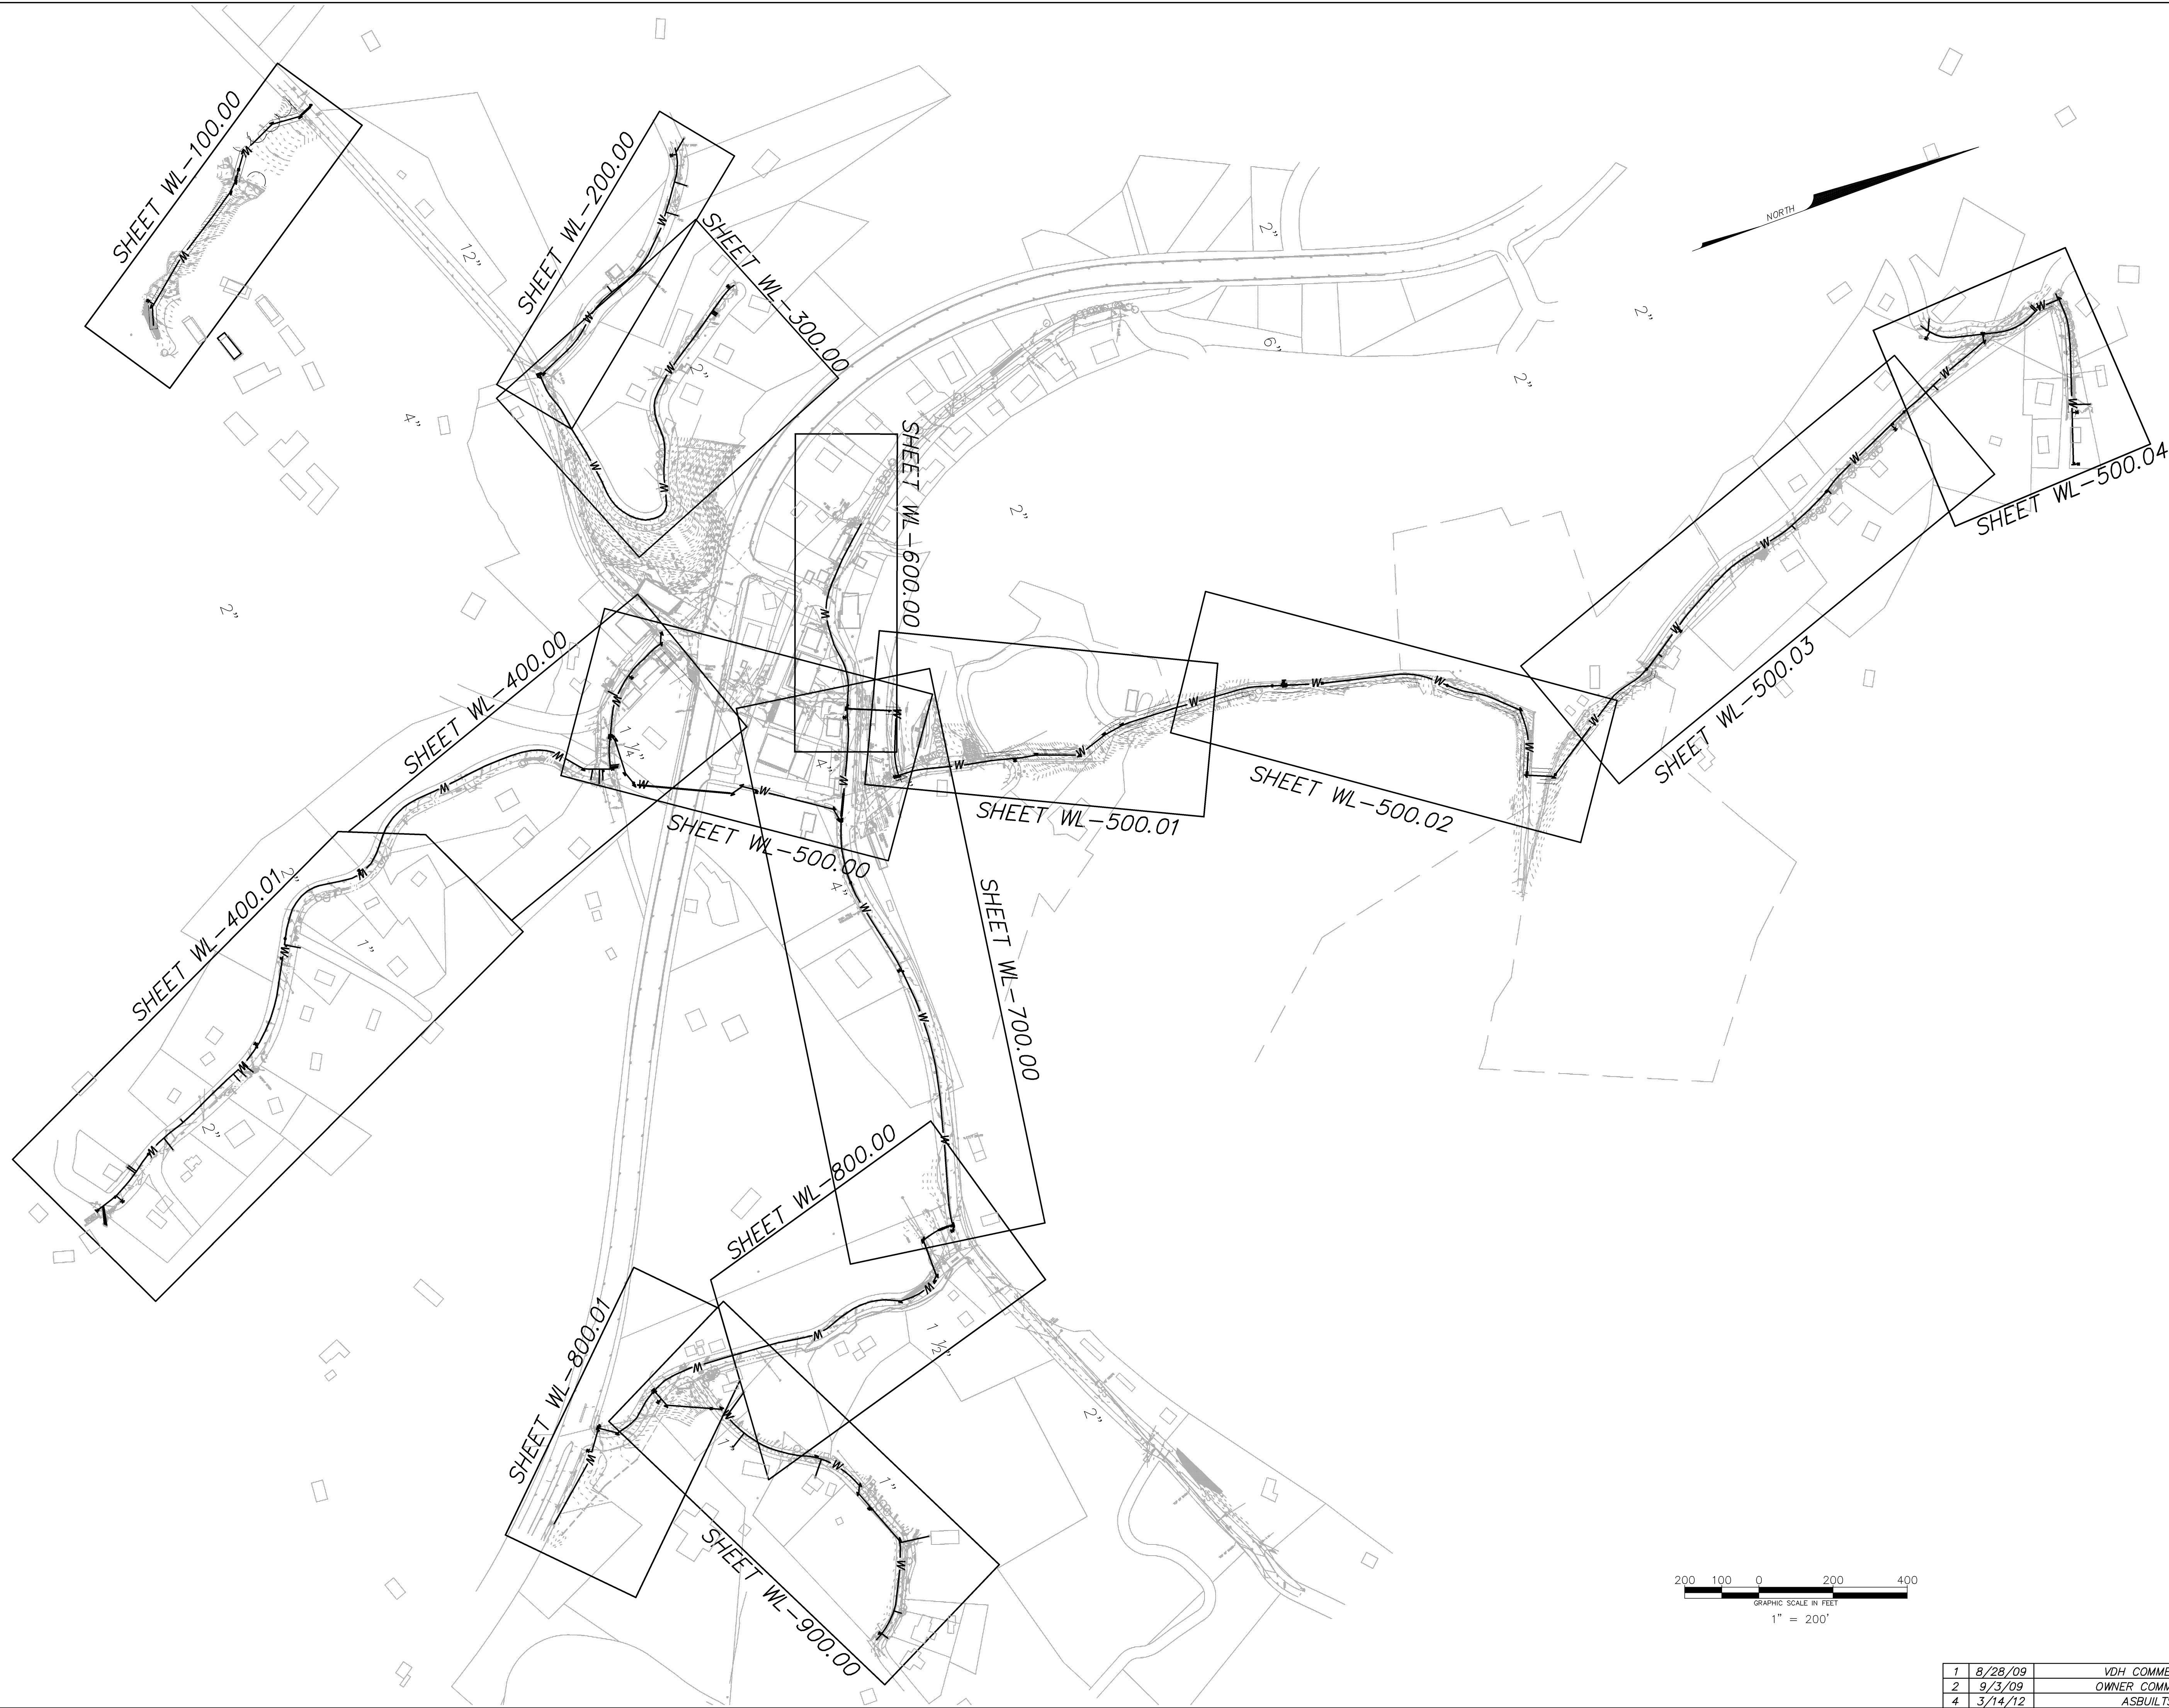

1	8/28/09	VDH COMMENTS
2	9/3/09	OWNER COMMENTS
4	3/14/12	ASBUILTS

**PROJECT MAP-ASBUILT**  
**FOR**  
**TOWN OF BOONES MILL WATER SYSTEM REPLACEMENT, VOLUME 1**  
**TOWN OF BOONES MILL, BOONE DISTRICT, FRANKLIN COUNTY, VA**


PROJECT NO.	20080815
G.L. NO.	297-03-A3.9
FILE NO.	G-12675
DATE:	7/31/09
DRAWN BY:	ASK
CHECKED BY:	BLC

**HURT & PROFFITT**

SHEET NO.  
**C0.2**

**HURT & PROFFITT**  
INCORPORATED  
2524 LANGHORNE ROAD  
LYNCHBURG VA 24501  
800.242.4906 TOLL FREE  
434.847.7796 MAIN  
434.847.0047 FAX

\* ENGINEERING >> SURVEYING >> PLANNING



Mar 14, 2012 10:24am V:\LandProjects\20080815\dwg\Asbuilts-W\ASBUILT-Cover-WL.dwg

EROSION AND SEDIMENT CONTROL NARRATIVE

**PROJECT DESCRIPTION:**  
THIS PROJECT CONSISTS OF CONSTRUCTION OF WATER LINE, WATER TREATMENT PLANT, WELL DEVELOPMENT AND TWO TANKS LOCATED IN THE TOWN OF BOONES MILL. THE PROJECT INCLUDES GRADING AND ASSOCIATED EROSION AND SEDIMENT CONTROL MEASURES NECESSARY TO CONSTRUCT WATERLINE, WATER TREATMENT PLANT, WELL DEVELOPMENT AND THE TWO OTHER TANKS. APPROXIMATELY 4.88 ACRES WILL BE DISTURBED AS PART OF THE CONSTRUCTION. A VSPM PERMIT WILL BE REQUIRED FOR THIS PORTION OF THE PROJECT.

**EXISTING SITE CONDITIONS:**  
CURRENTLY THE SPRING SITE HAS A TREATMENT BUILDING, A SMALL CONCRETE TANK AND A 250,000 GALLON WATER TANK ON IT. THE SPRING SITE HAS BEEN CLEARED OF ALL TREES. THE LOCATION OF THE FUTURE WATER TREATMENT BUILDING IS LOCATED JUST BELOW THE SPRING SITE AND IS CURRENTLY AN APPLE ORCHARD.

**ADJACENT PROPERTIES:**  
THE SURROUND PROPERTY IS ZONED AGRICULTURAL. ALL MEASURES SHALL BE TAKEN TO ENSURE THAT THE SITE IS STABILIZED AND NO ADDITIONAL SEDIMENT IS DEPOSITED INTO THE DRAINAGE CHANNEL.

**OFFSITE AREAS:**  
ALL GRADING SHALL OCCUR ON-SITE. ANY ADDITIONAL DIRT BORROWED OR WASTED FROM THE SITE WILL BE EITHER STOCKPILED OR REMOVED FROM A LOCATION CHOSEN BY THE CONTRACTOR AT A LATER DATE.

**CRITICAL AREAS:**  
THE CRITICAL AREAS FOR THIS PROJECT WILL BE THE AREA AROUND THE SPRING AND THE PLACE WHERE THE WATERLINE CROSSES ANY STREAMS OR CREEKS. THE CONTRACTOR SHALL ENSURE THAT SILT FENCE IS INSTALLED AT ANY AREA NEAR THE SPRING AND CREEK.

**SOILS:**  
ALL SOILS AROUND THE SPRING AND WATER TREATMENT PLANT SITE ARE CLASSIFIED AS WINTERGREEN LOAM, 8-15% SLOPES. SOILS IN THE REMAINDER OF THE PROJECT AREA VARY BETWEEN CLIFFORD-HICKORY KNOB COMPLEX AND HAYESVILLE LOAM.

**EROSION AND SEDIMENT CONTROL MEASURES:**  
UNLESS OTHERWISE INDICATED, ALL VEGETATIVE AND STRUCTURAL EROSION AND SEDIMENT CONTROL PRACTICES SHALL BE CONSTRUCTED AND MAINTAINED ACCORDING TO MINIMUM STANDARDS AND SPECIFICATION OF THE LATEST EDITION OF THE VIRGINIA EROSION AND SEDIMENT CONTROL HANDBOOK. THE MINIMUM STANDARDS OF THE HANDBOOK SHALL BE ADHERED TO UNLESS OTHERWISE WAIVED OR APPROVED BY VARIANCE.

**SECTION 3.02- TEMPORARY STONE CONSTRUCTION ENTRANCE MAINTENANCE**  
1. THE ENTRANCE SHALL BE MAINTAINED IN A CONDITION WHICH WILL PREVENT TRACKING OR FLOW OF MUD ONTO PUBLIC RIGHTS-OF-WAY. THIS MAY REQUIRE PERIODIC TOP DRESSING WITH ADDITIONAL STONE OR THE WASHING AND REWORKING OF EXISTING STONE AS CONDITIONS DEMAND AND REPAIR AND/OR CLEANOUT OF ANY STRUCTURES USED TO TRAP SEDIMENT. ALL MATERIALS SPILLED, DROPPED, WASHED, OR TRACKED FROM VEHICLES ONTO ROADWAYS OR INTO STORM DRAINS MUST BE REMOVED IMMEDIATELY. THE USE OF WATER TRUCKS TO REMOVE MATERIALS DROPPED, WASHED, OR TRACKED ONTO ROADWAYS WILL NOT BE PERMITTED UNDER ANY CIRCUMSTANCES.

**SECTION 3.05- SILT FENCE MAINTENANCE**  
1. SILT FENCES SHALL BE INSPECTED IMMEDIATELY AFTER EACH RAINFALL AND AT LEAST DAILY DURING PROLONGED RAINFALL. ANY REQUIRED REPAIRS SHALL BE MADE IMMEDIATELY.  
2. CLOSE ATTENTION SHALL BE PAID TO THE REPAIR OF DAMAGED SILT FENCE RESULTING FROM END RUNS AND UNDERCUTTING.  
3. SHOULD THE FABRIC ON A SILT FENCE DECOMPOSE OR BECOME INEFFECTIVE PRIOR TO THE END OF THE EXPECTED USABLE LIFE AND THE BARRIER STILL BE NECESSARY, THE FABRIC SHALL BE REPLACED PROMPTLY.  
4. SEDIMENT DEPOSITS SHOULD BE REMOVED AFTER EACH STORM EVENT. THEY MUST BE REMOVED WHEN DEPOSITS REACH APPROXIMATELY ONE-HALF THE HEIGHT OF THE BARRIER.  
5. ANY SEDIMENT DEPOSITS REMAINING IN PLACE AFTER THE SILT FENCE IS NO LONGER REQUIRED SHALL BE DRESSED TO CONFORM WITH THE EXISTING GRADE, PREPARED AND SEEDED.

**SECTION 3.08- CULVERT INLET PROTECTION MAINTENANCE**  
1. THE STRUCTURE SHALL BE INSPECTED AFTER EACH RAIN AND REPAIRS MADE AS NEEDED.  
2. AGGREGATE SHALL BE REPLACED OR CLEANED WHEN INSPECTION REVEALS THAT CLOGGED VOIDS ARE CAUSING PONDING PROBLEMS WHICH INTERFERE WITH ON-SITE CONSTRUCTION.  
3. SEDIMENT SHALL BE REMOVED AND THE IMPOUNDMENT RESTORED TO ITS ORIGINAL DIMENSIONS WHEN SEDIMENT HAS ACCUMULATED TO ONE-HALF THE DESIGN DEPTH. REMOVED SEDIMENT SHALL BE DEPOSITED IN A SUITABLE AREA IN SUCH A MANNER THAT IT WILL NOT ERODE AND CAUSE SEDIMENTATION PROBLEMS.  
4. TEMPORARY STRUCTURES SHALL BE REMOVED WHEN THEY HAVE SERVED THEIR USEFUL PURPOSE, BUT NOT BEFORE THE UPSLOPE AREA HAS BEEN PERMANENTLY STABILIZED.

**SECTION 3.09- TEMPORARY DIVERSION DIKE MAINTENANCE**  
1. THE MEASURE SHALL BE INSPECTED AFTER EVERY STORM AND REPAIRS MADE TO THE DIKE, FLOW CHANNEL, OUTLET OR SEDIMENT TRAPPING FACILITY, AS NECESSARY. ONCE EVERY TWO WEEKS, WHETHER A STORM EVENT HAS OCCURRED OR NOT, THE MEASURE SHALL BE INSPECTED AND REPAIRS MADE IF NEEDED. DAMAGES CAUSED BY CONSTRUCTION TRAFFIC OR OTHER ACTIVITY MUST BE REPAIRED BEFORE THE END OF EACH WORKING DAY.

**SECTION 3.18- OUTLET PROTECTION MAINTENANCE**  
1. OUTLET PROTECTION SHOULD BE CHECKED FOR SEDIMENT ACCUMULATION AFTER EACH RUNOFF-PRODUCING STORM EVENT. IT SHOULD BE INSPECTED PERIODICALLY TO DETERMINE IF HIGH FLOWS HAVE CAUSED SCOUR BEHIND THE RIPRAP OR FILTER FABRIC OR CLOGGED ANY OF THE STONE. CARE MUST BE TAKEN TO PROPERLY CONTROL SEDIMENT-LOADED CONSTRUCTION RUNOFF WHICH MAY DRAIN TO THE POINT OF THE NEW INSTALLATION. IF REPAIRS ARE NEEDED, THEY SHOULD BE ACCOMPLISHED IMMEDIATELY.

**SECTION 3.31- TEMPORARY SEEDING**  
ESTABLISHMENT OF TEMPORARY VEGETATIVE COVER BY PLANTING SEED ON ROUGH-GRADED AREAS THAT WILL BE BROUGHT TO FINAL GRADE BETWEEN 6 MONTHS AND A YEAR.

**SECTION 3.32- PERMANENT SEEDING MAINTENANCE**  
1. EVEN WITH CAREFUL, WELL-PLANNED SEEDING OPERATIONS, FAILURES CAN OCCUR WHEN IT IS CLEAR THAT PLANTS HAVE NOT GERMINATED ON AN AREA OR HAVE DIED. THESE AREAS MUST BE RESEEDING IMMEDIATELY TO PREVENT EROSION DAMAGE. HOWEVER, IT IS EXTREMELY IMPORTANT TO DETERMINE FOR WHAT REASON GERMINATION DID NOT TAKE PLACE AND MAKE ANY CORRECTIVE ACTION NECESSARY PRIOR TO RESEEDING THE AREA. HEALTHY VEGETATION IS THE MOST EFFECTIVE EROSION CONTROL AVAILABLE.

**SECTION 3.35- MULCHING MAINTENANCE**  
1. ALL MULCHES AND SOIL COVERINGS SHOULD BE INSPECTED PERIODICALLY (PARTICULARLY AFTER RAINSTORMS) TO CHECK FOR EROSION. WHERE EROSION IS OBSERVED IN MULCHED AREAS, ADDITIONAL MULCH SHOULD BE APPLIED. NETS AND MATS SHOULD BE INSPECTED AFTER RAINSTORMS FOR DISLOCATION OR FAILURE. IF WASHOUTS OR BREAKAGE OCCUR, RE-INSTALL NETTING OR MATTING AS NECESSARY AFTER REPAIRING DAMAGE TO THE SLOPE OR DITCH. INSPECTIONS SHOULD TAKE PLACE UP UNTIL GRASSES ARE FIRMLY ESTABLISHED. WHERE MULCH IS USED IN CONJUNCTION WITH ORNAMENTAL PLANTINGS, INSPECT PERIODICALLY THROUGHOUT THE YEAR TO DETERMINE IF MULCH IS MAINTAINING COVERAGE OF THE SOIL SURFACE; REPAIR AS NEEDED.

VEGETATIVE PRACTICES:

**TEMPORARY SEEDING / PERMANENT STABILIZATION:**  
SEEDING MEASURES SHALL BE TAKEN ON DISTURBED SOIL AT CUT / FILL SLOPES, DITCH LINES, OR AREAS OUTSIDE OF ON-GOING CONSTRUCTION PRACTICES WITHIN SEVEN (7) DAYS OF COMPLETED GRADING. ALL AREAS DISTURBED BY CONSTRUCTION WILL BE STABILIZED WITH PERMANENT SEEDING IMMEDIATELY FOLLOWING FINAL GRADING.

SITE MAINTENANCE:

- SILT FENCE BARRIERS SHALL BE CHECKED WEEKLY AND ESPECIALLY AFTER EACH RAINFALL EVENT, TO INSURE THAT THEY ARE FUNCTIONING PROPERLY. IF ANY BARRIER IS DAMAGED DUE TO CONSTRUCTION ACTIVITIES, NATURAL CAUSES, OR ANY OTHER REASON, THE BARRIER SHALL BE REPAIRED OR REPLACED IMMEDIATELY. IF TRASH OR SEDIMENTATION REACHES ONE-HALF THE HEIGHT OF THE BARRIER, THE BARRIER SHALL BE CLEANED, AND RESTORED TO PROPER FUNCTIONING CONDITION.
- ALL OTHER STRUCTURAL MEASURES ARE TO BE CHECKED WEEKLY AND ESPECIALLY AFTER EACH RAINFALL EVENT TO INSURE THAT THEY ARE FUNCTIONING PROPERLY. ANY DAMAGED OR CLOGGED MEASURE SHALL BE CLEANED OUT OR REPAIRED IMMEDIATELY.
- ALL SEDIMENT REMOVED FROM THE CONTROL DEVICES SHALL BE RE-SPREAD ON THE SITE ABOVE THE CONTROL DEVICES.
- VEGETATION SHALL BE CHECKED WEEKLY TO INSURE PROPER AND ADEQUATE COVERAGE. BARE OR WASHED AREAS SHALL BE SCARIFIED AND RESEEDING UNTIL PERMANENT STABILIZATION HAS BEEN ACHIEVED.
- ONCE SITE HAS ESTABLISHED AND SEDIMENT HAS CEASED TO BE CONVEYED ON THE SITE, ALL SILT FENCE BARRIERS AND INLET PROTECTION SHALL BE REMOVED FROM THE SITE.
- OTHER CONTROLS.
  - NO SOLID MATERIALS, INCLUDING BUILDING MATERIALS, GARBAGE AND DEBRIS SHALL BE DISCHARGED TO SURFACE WATERS OF THE STATE, EXCEPT AS AUTHORIZED BY A CWA SECTION 404 PERMIT.
  - WHERE CONSTRUCTION VEHICLE ACCESS ROUTES INTERSECT PAVED PUBLIC ROADS, MINIMIZATION OF TRANSPORT OF SEDIMENT BY VEHICULAR TRACKING ON THE PAVEMENT WILL BE PREVENTED BY PROPER USE AND MAINTENANCE OF THE CONSTRUCTION ENTRANCES AND CLEANING THE ROAD AT THE END OF EACH DAY.
  - STORAGE OF ONSITE MATERIALS WILL BE DONE TO MINIMIZE EXPOSURE OF THE MATERIALS TO STORMWATER AND SPILL PREVENTION AND RESPONSE.
  - DISTURBED AREAS AND AREAS USED FOR STORAGE OF MATERIALS THAT ARE EXPOSED TO PRECIPITATION SHALL BE INSPECTED FOR EVIDENCE OF, OR THE POTENTIAL FOR, POLLUTANTS ENTERING THE DRAINAGE SYSTEM.


**INSPECTIONS AND REPORTING:**  
FACILITY PERSONNEL WHO ARE FAMILIAR WITH THE CONSTRUCTION ACTIVITY, THE BMPS AND THE STORMWATER POLLUTION PREVENTION PLAN WILL INSPECT DISTURBED AREAS OF THE CONSTRUCTION SITE THAT HAVE NOT BEEN FINALLY STABILIZED, AND AREAS USED FOR STORAGE MATERIALS THAT ARE EXPOSED TO PRECIPITATION. STRUCTURAL CONTROLS AND LOCATIONS WHERE VEHICLES ENTER OR EXIT THE SITE. THESE INSPECTIONS SHALL BE CONDUCTED EVERY 14 DAYS OR WITHIN 48 HOURS OF THE END OF A STORM EVENT THAT IS 0.5 INCHES OR GREATER.

EROSION AND SEDIMENT CONTROL DEVICES:

PERIMETER EROSION AND SEDIMENT CONTROL DEVICES SHALL BE INSTALLED PRIOR TO ANY LAND DISTURBING ACTIVITY. AS CONSTRUCTION PROCEEDS, ALL ADDITIONAL EROSION AND SEDIMENT CONTROL DEVICES SHALL BE INSTALLED AS SOON AS POSSIBLE. EROSION AND SEDIMENT CONTROL DEVICES AS SHOWN ON THE PLAN ARE A MINIMUM AND THE PROJECT CONDITION MAY DICTATE ADDITIONAL CONTROL. ALL EROSION AND SEDIMENT CONTROL DEVICES SHALL BE PER THE LATEST EDITION OF THE VIRGINIA EROSION AND SEDIMENT CONTROL HANDBOOK.


EROSION AND SEDIMENT CONTROL MAINTENANCE:

THE CONTRACTOR IS RESPONSIBLE FOR MAINTAINING ALL EROSION CONTROL DEVICES FOR THE DURATION OF THE PROJECT. ALL EROSION AND SEDIMENT CONTROL DEVICES SHALL BE CHECKED WEEKLY AND AFTER EACH SIGNIFICANT RAINFALL TO INSURE THAT ALL DEVICES ARE IN PLACE AND FUNCTIONING AS REQUIRED. ALL EROSION AND SEDIMENT CONTROL DEVICES SHALL BE MAINTAINED PER THE LATEST EDITION OF THE VIRGINIA EROSION AND SEDIMENT CONTROL HANDBOOK. IN GENERAL, IF THE SILT BUILT UP BEHIND A BARRIER BECOMES AS DEEP AS 9 INCHES, THE SILT IS TO BE REMOVED AND THE BARRIER REPAIRED OR REPLACED. AFTER COMPLETION OF THE PROJECT, AND PERMANENT SEEDING HAS BEEN ESTABLISHED, EROSION CONTROL DEVICES AND ANY SILT BUILT UP SHALL BE REMOVED. DISTURBED AREAS DUE TO THIS CLEANUP OPERATION SHALL BE REPAIRED, RESEEDING AND REMULCHED.

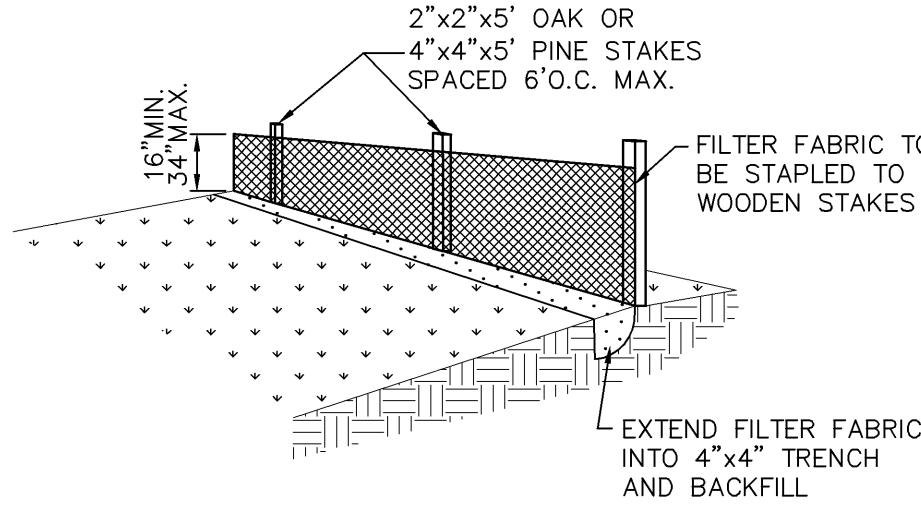


**SF SILT FENCE**  
(WITHOUT WIRE SUPPORT)  
N.T.S.

**CP SILT FENCE CULVERT INLET PROTECTION**

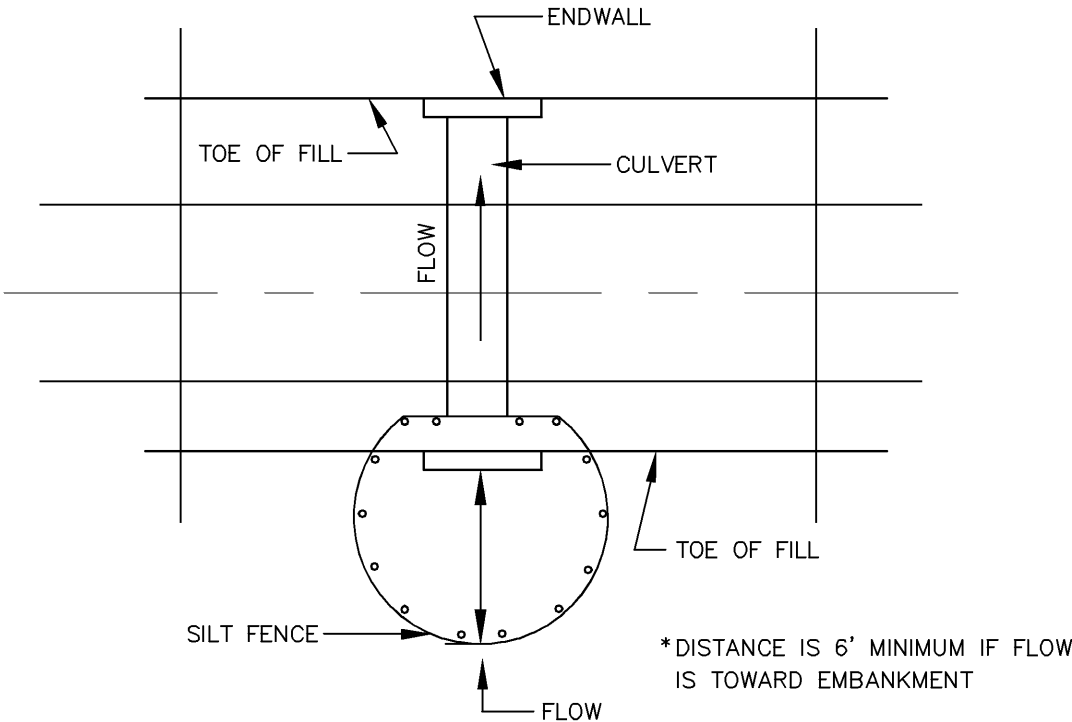

**\* OPTIONAL STONE COMBINATION**

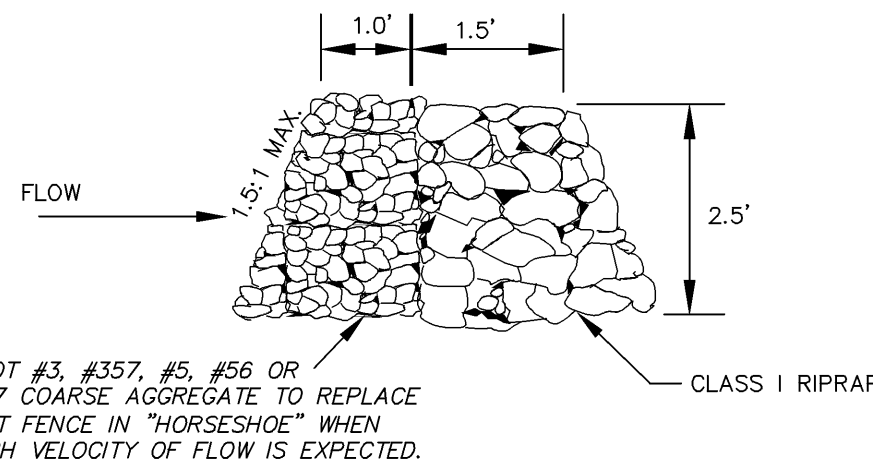


SOURCE: ADAPTED FROM VDOT Standard Sheets and Va. DSWC

PLATE. 3.08-1

**OP PIPE OUTLET PROTECTION**

N.T.S.

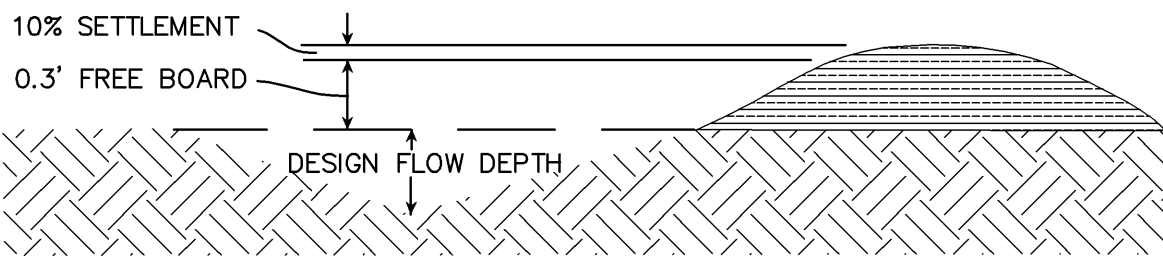

**TYPICAL VEE-SHAPED DIVERSION**  
N.T.S.

**CE CONSTRUCTION ENTRANCE**  
N.T.S.

1	8/28/09	VDH COMMENTS
2	9/3/09	OWNER COMMENTS
4	3/14/12	ASBUILTS

\*ENGINEERING >>> SURVEYING >>> PLANNING

**HURT & PROFFITT**  
INCORPORATED  
2524 LANGHORNE ROAD  
LYNCHBURG VA 24501  
800.242.4906 TOLL FREE  
434.847.7796 MAIN  
434.847.0047 FAX

**E&S NARRATIVE AND DETAILS-ASBUILT**  
**FOR**  
**TOWN OF BOONES MILL WATER SYSTEM REPLACEMENT, VOLUME 1**  
**TOWN OF BOONES MILL, BOONE DISTRICT, FRANKLIN COUNTY, VA**



PROJECT NO.	20080815
G.L. NO.	297-03-A3.9
FILE NO.	G-12675
DATE:	7/31/09
DRAWN BY:	WCH
CHECKED BY:	BLC

**HURT & PROFFITT**

SHEET NO.  
**C0.3**






Mar 14, 2012 - 10:26am V:\LandProj\Projects\20080815\dwg\ASBUILT-P-Water.dwg

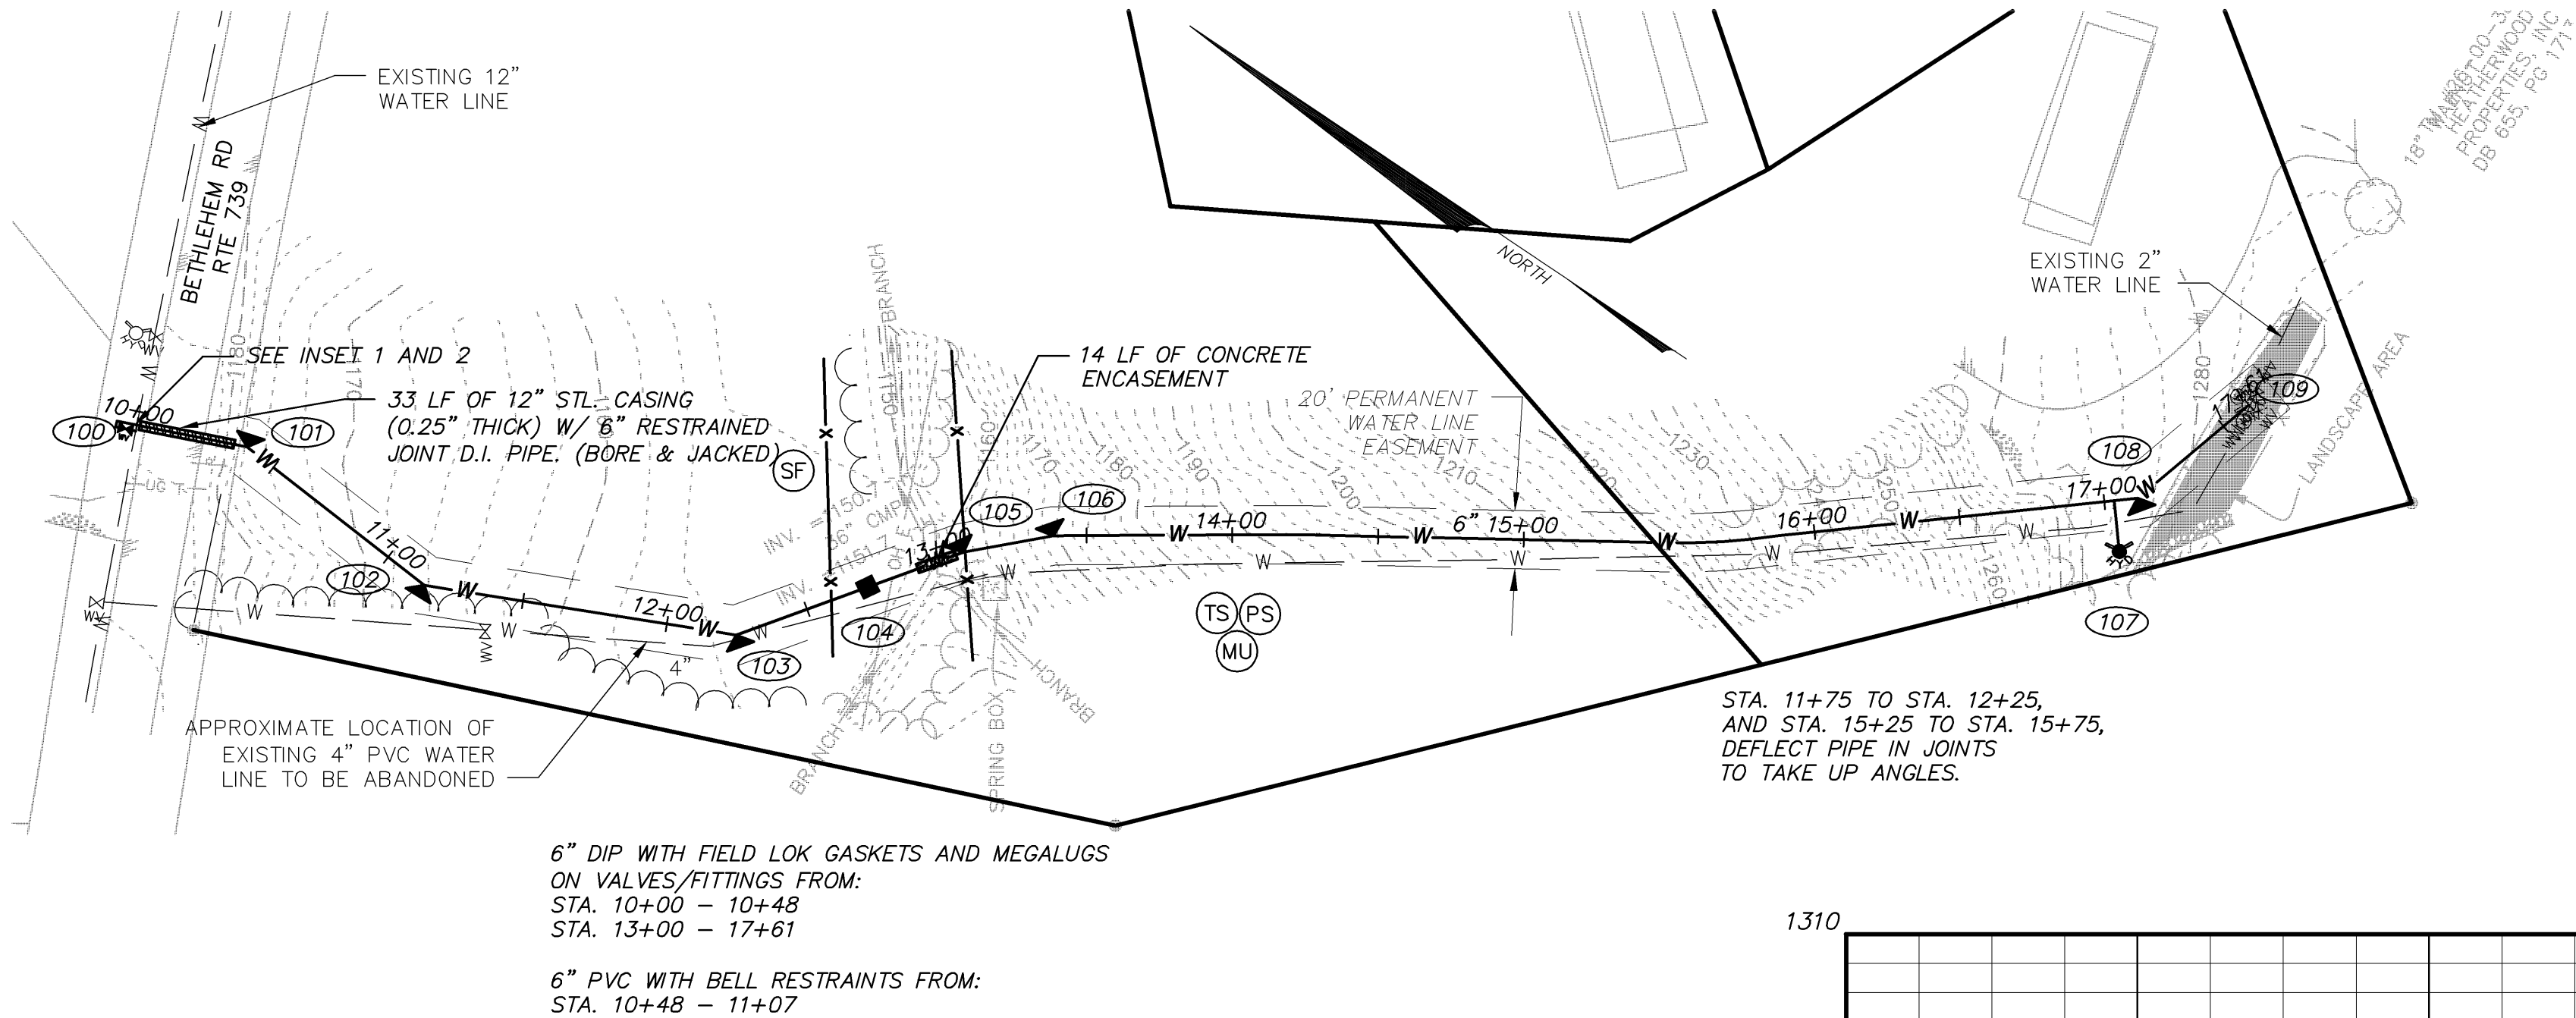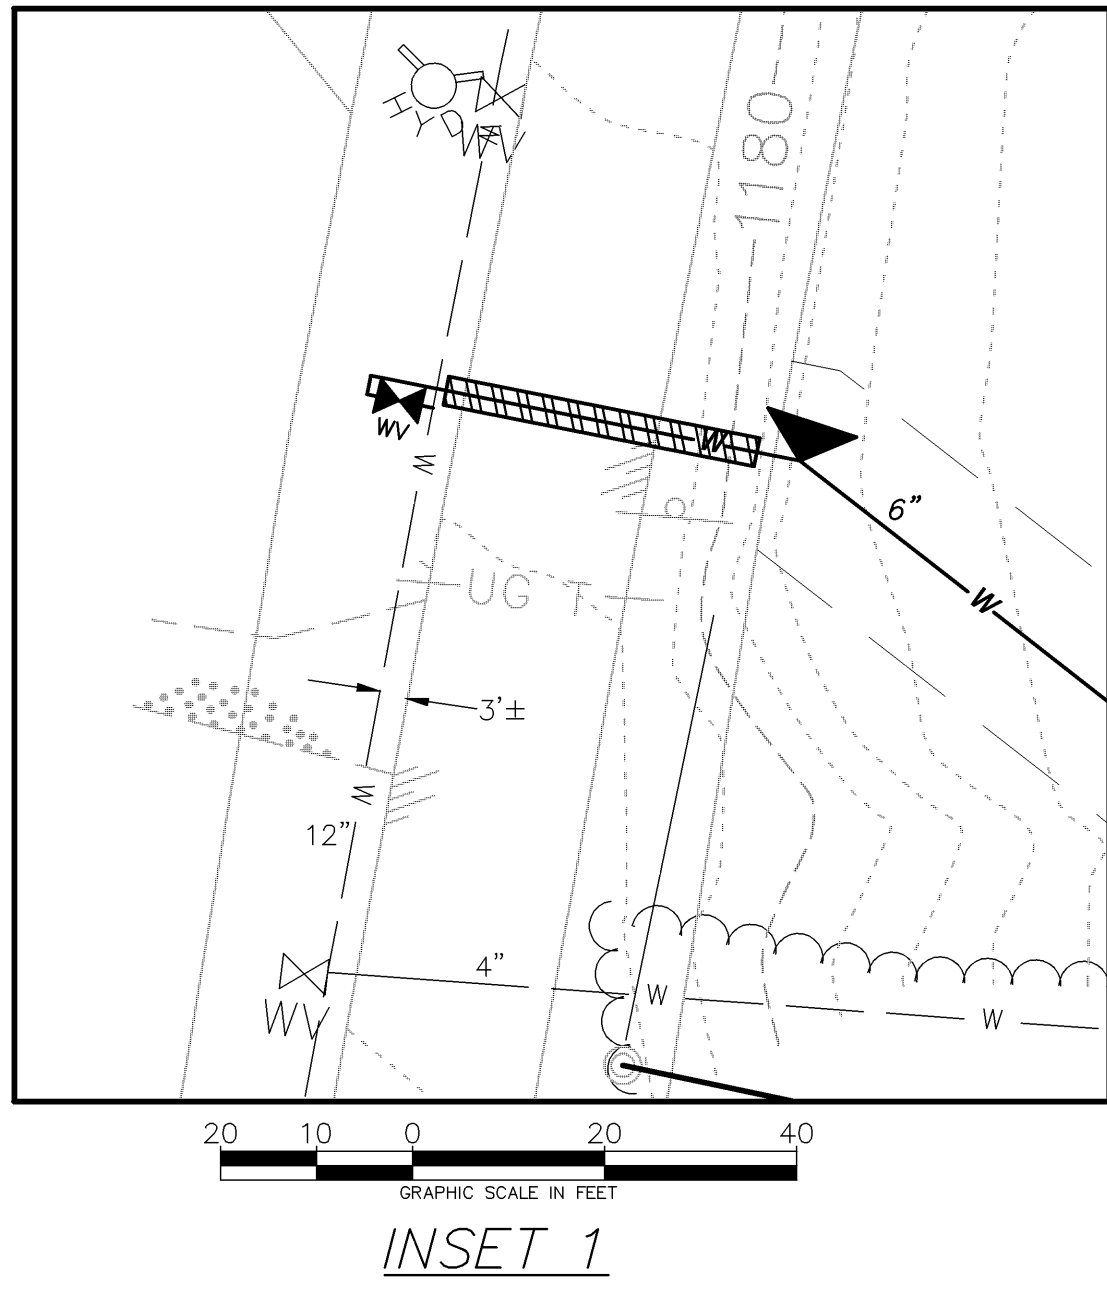

PROFILE INFORMATION TAKEN FROM RECORD DRAWINGS

LEGEND:  
--- EXISTING GRADE  
--- 6" C900 PVC

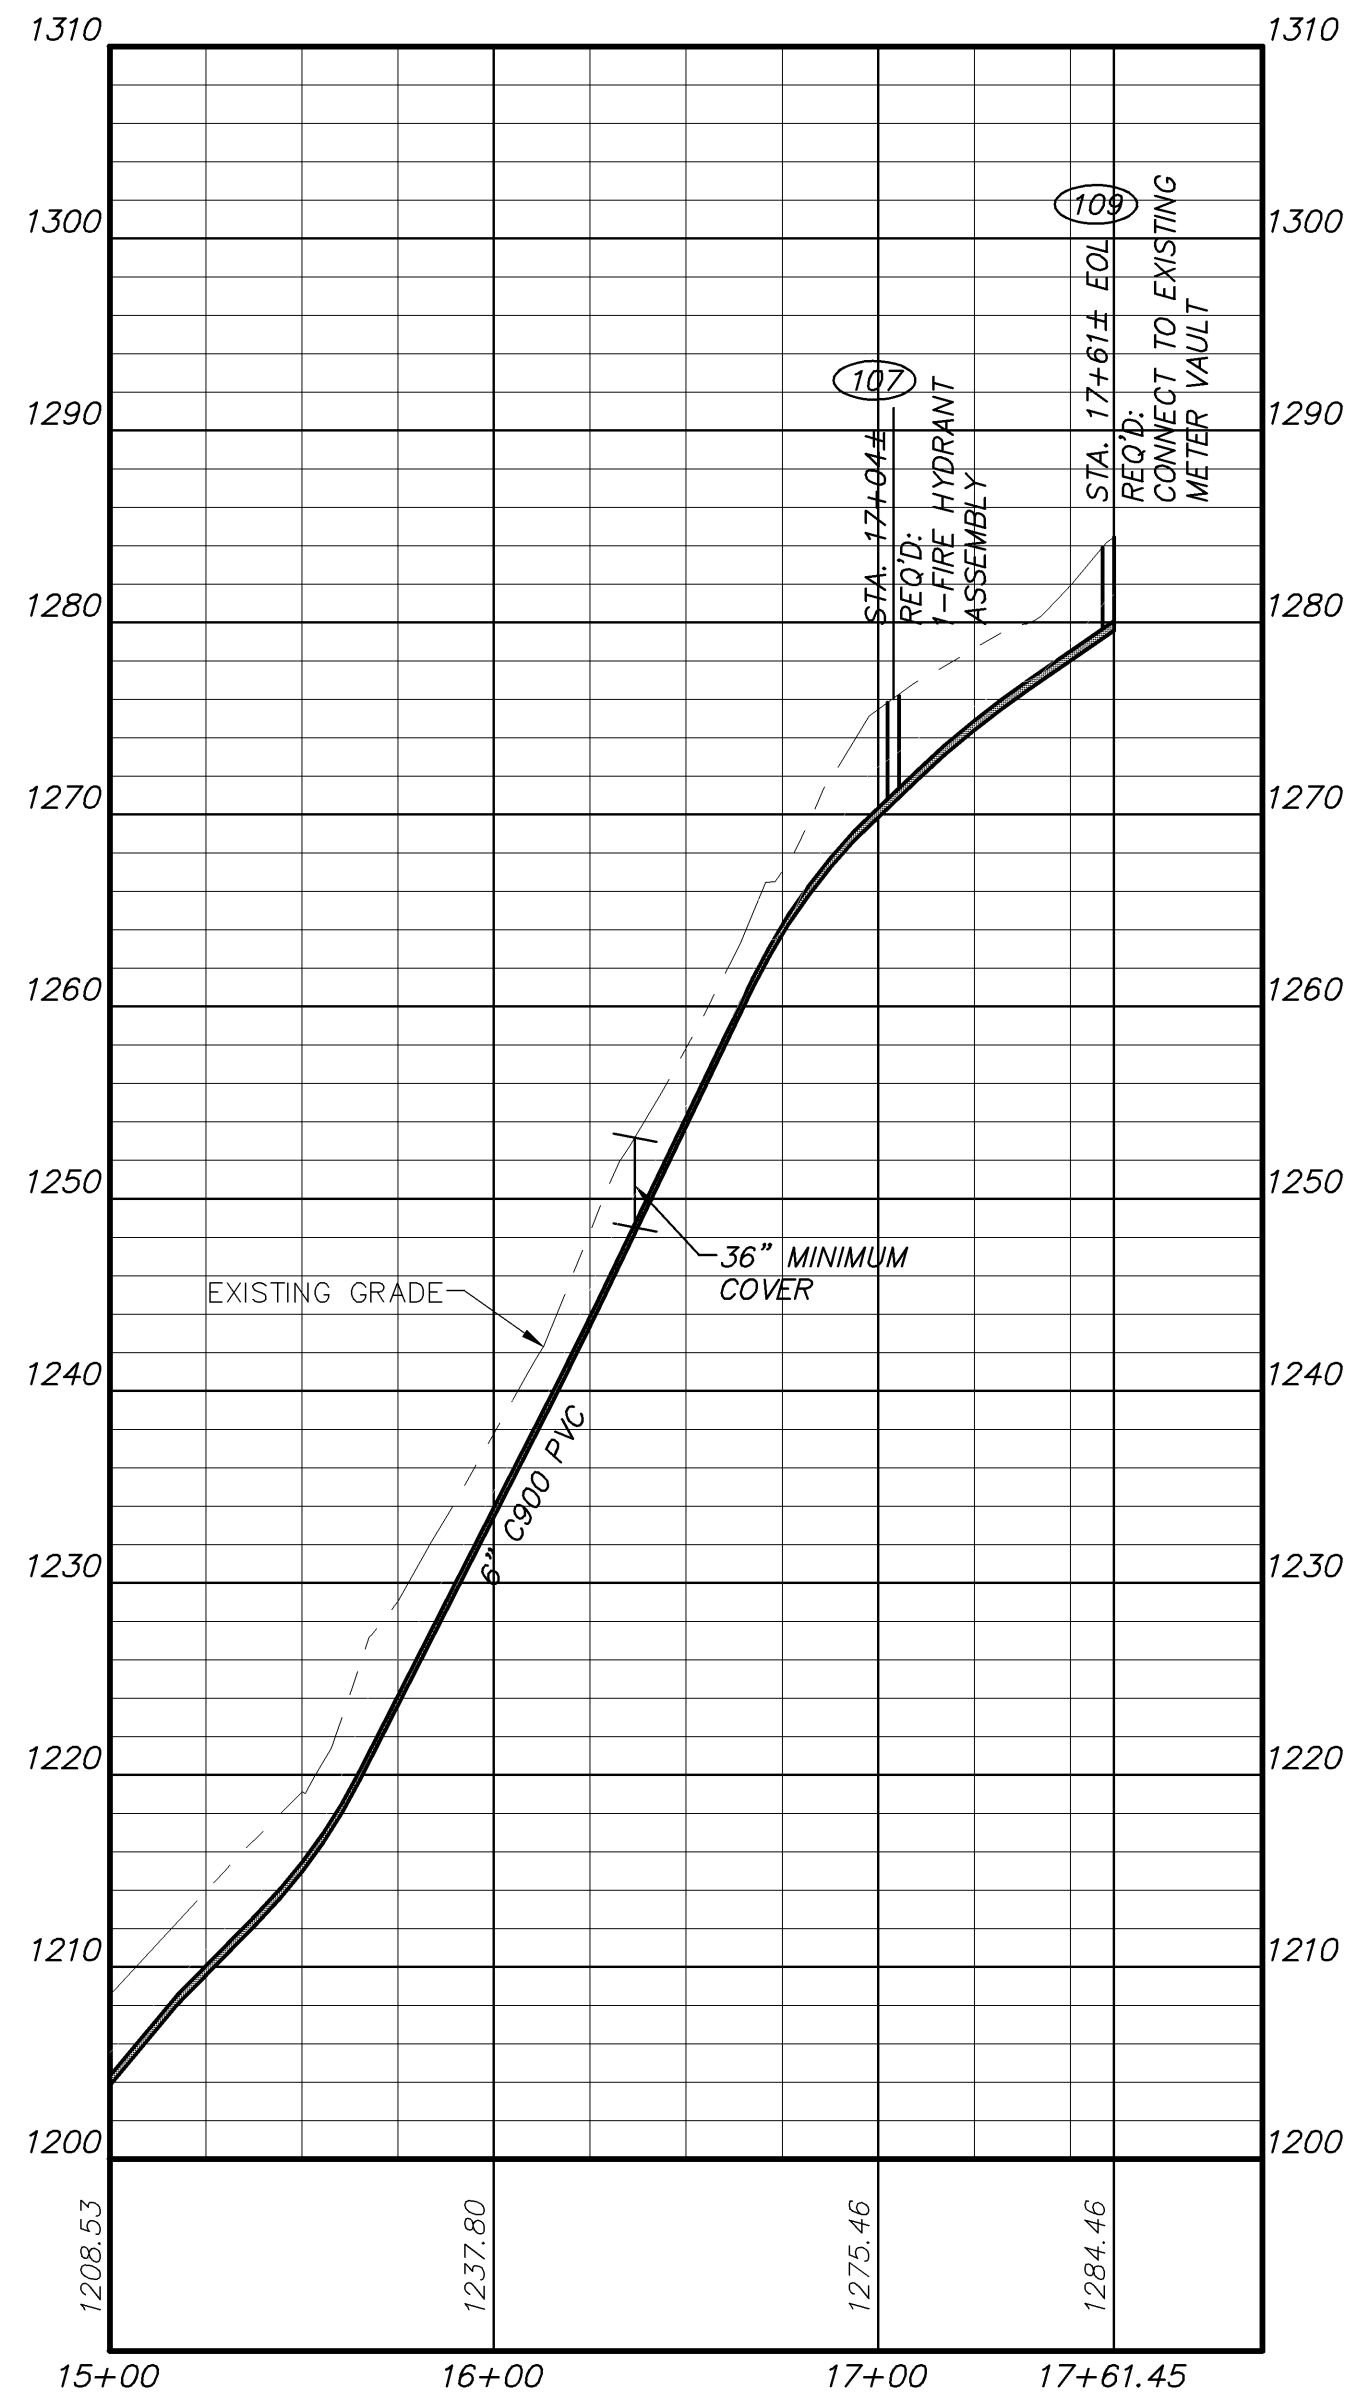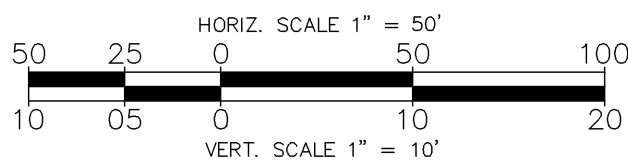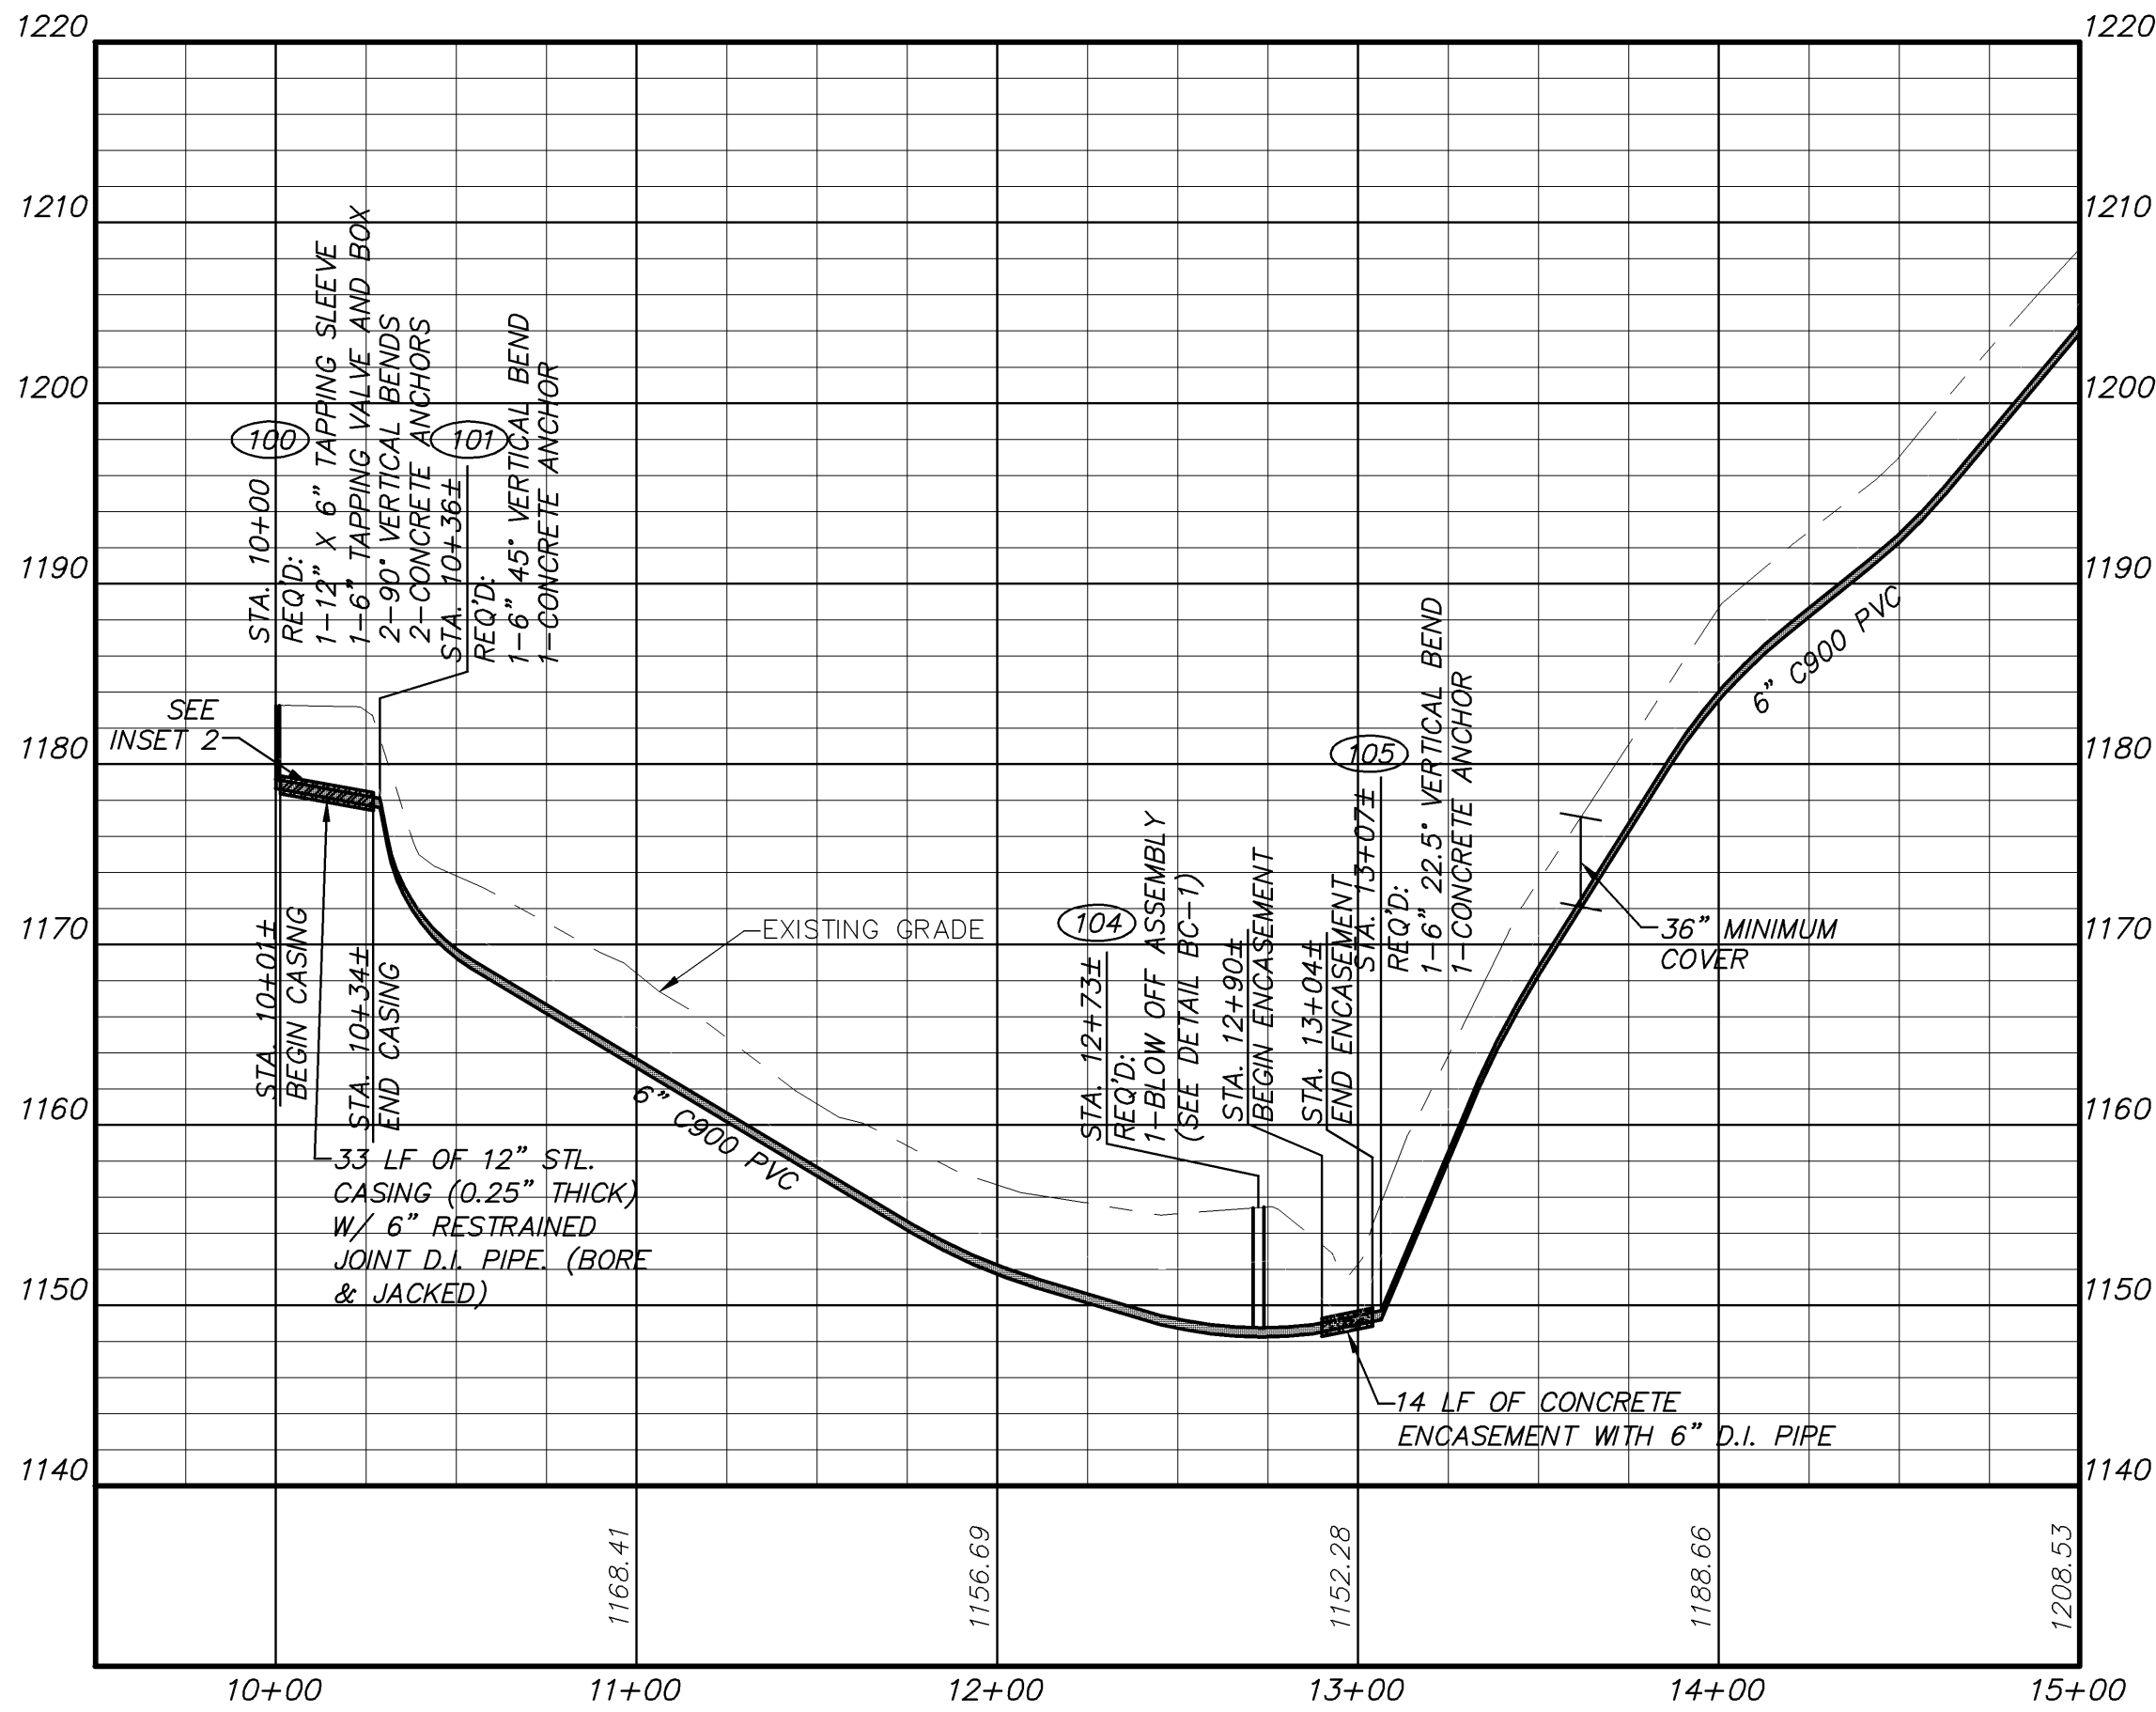

PROPOSED LEGEND

- WATER METER
- WATER LINE
- BLOW OFF ASSEMBLY
- AIR RELEASE
- FIRE HYDRANT
- CONCRETE ANCHOR
- GATE VALVE
- STEEL CASING
- SLOPE ANCHOR
- E.O.L. END OF LINE

EXISTING LEGEND

- ELECTRIC POLE
- GUY WIRE
- UTILITY PEDESTAL
- LIGHT POLE
- EDGE OF PAVEMENT
- EDGE OF GRAVEL
- BENCHMARK
- SIGN
- CONCRETE PAD
- EDGE OF WOODS
- EXISTING FENCE LINE
- OVERHEAD ELECTRIC
- UG ELECTRIC LINE
- UG GAS LINE
- UG TELEPHONE LINE
- UG FIBER OPTIC LINE
- UG WATER LINE
- DITCH LINE

- WATER LINE STRUCTURE SCHEDULE
- 100 STA. 10+00  
REQ'D:  
1-12" X 6" TAPPING SLEEVE  
1-6" TAPPING VALVE AND BOX  
2-90° VERTICAL BENDS  
2-CONCRETE ANCHORS
  - 101 STA. 10+36±  
REQ'D:  
2-6" 90° VERTICAL BEND  
2-CONCRETE ANCHOR
  - 102 STA. 11+15±  
REQ'D:  
1-6" 22.5° BEND  
1-CONCRETE ANCHOR
  - 103 STA. 12+24±  
REQ'D:  
1-22.5° BEND  
1-CONCRETE ANCHOR
  - 104 STA. 12+73±  
REQ'D:  
1-BLOW OFF ASSEMBLY  
(SEE DETAIL BC-1)
  - 105 STA. 13+07±  
REQ'D:  
1-6" 22.5° VERTICAL BEND  
1-CONCRETE ANCHOR
  - 106 STA. 13+39±  
REQ'D:  
1-6" 11.25° BEND  
1-CONCRETE ANCHOR
  - 107 STA. 17+04±  
REQ'D:  
1-FIRE HYDRANT ASSEMBLY
  - 108 STA. 17+11±  
REQ'D:  
1-6" 45° BEND  
1-CONCRETE ANCHOR
  - 109 STA. 17+61± EOL  
REQ'D:  
CONNECT TO EXISTING METER VAULT

\*ENGINEERING >> SURVEYING >> PLANNING

**HURT & PROFFITT**  
INCORPORATED

2524 LANGHORNE ROAD  
LYNCHBURG VA 24501  
800.242.6906 TOLL FREE  
434.847.7796 MAIN  
434.847.0047 FAX

**STA. 10+00 - 17+61± EOL HEATHERWOOD LANE-ASBUILT**  
**FOR**

**TOWN OF BOONES MILL WATER SYSTEM REPLACEMENT, VOLUME 1**  
**TOWN OF BOONES MILL, BOONE DISTRICT, FRANKLIN COUNTY, VA**





PROJECT NO. 20080815  
G.L. NO. 297-03-A3.9  
FILE NO. G-12675  
DATE: 7/31/09  
DRAWN BY: WCH  
CHECKED BY: BLC

**HURT & PROFFITT**

SHEET NO.  
**WL-100.00**

1	8/28/09	VDH COMMENTS
2	9/3/09	OWNER COMMENTS
4	3/14/12	ASBUILTS

Mar 14, 2012, 10:27am V:\LandProjects\20080815.dwg\ASBUILT-P-P-Water.dwg

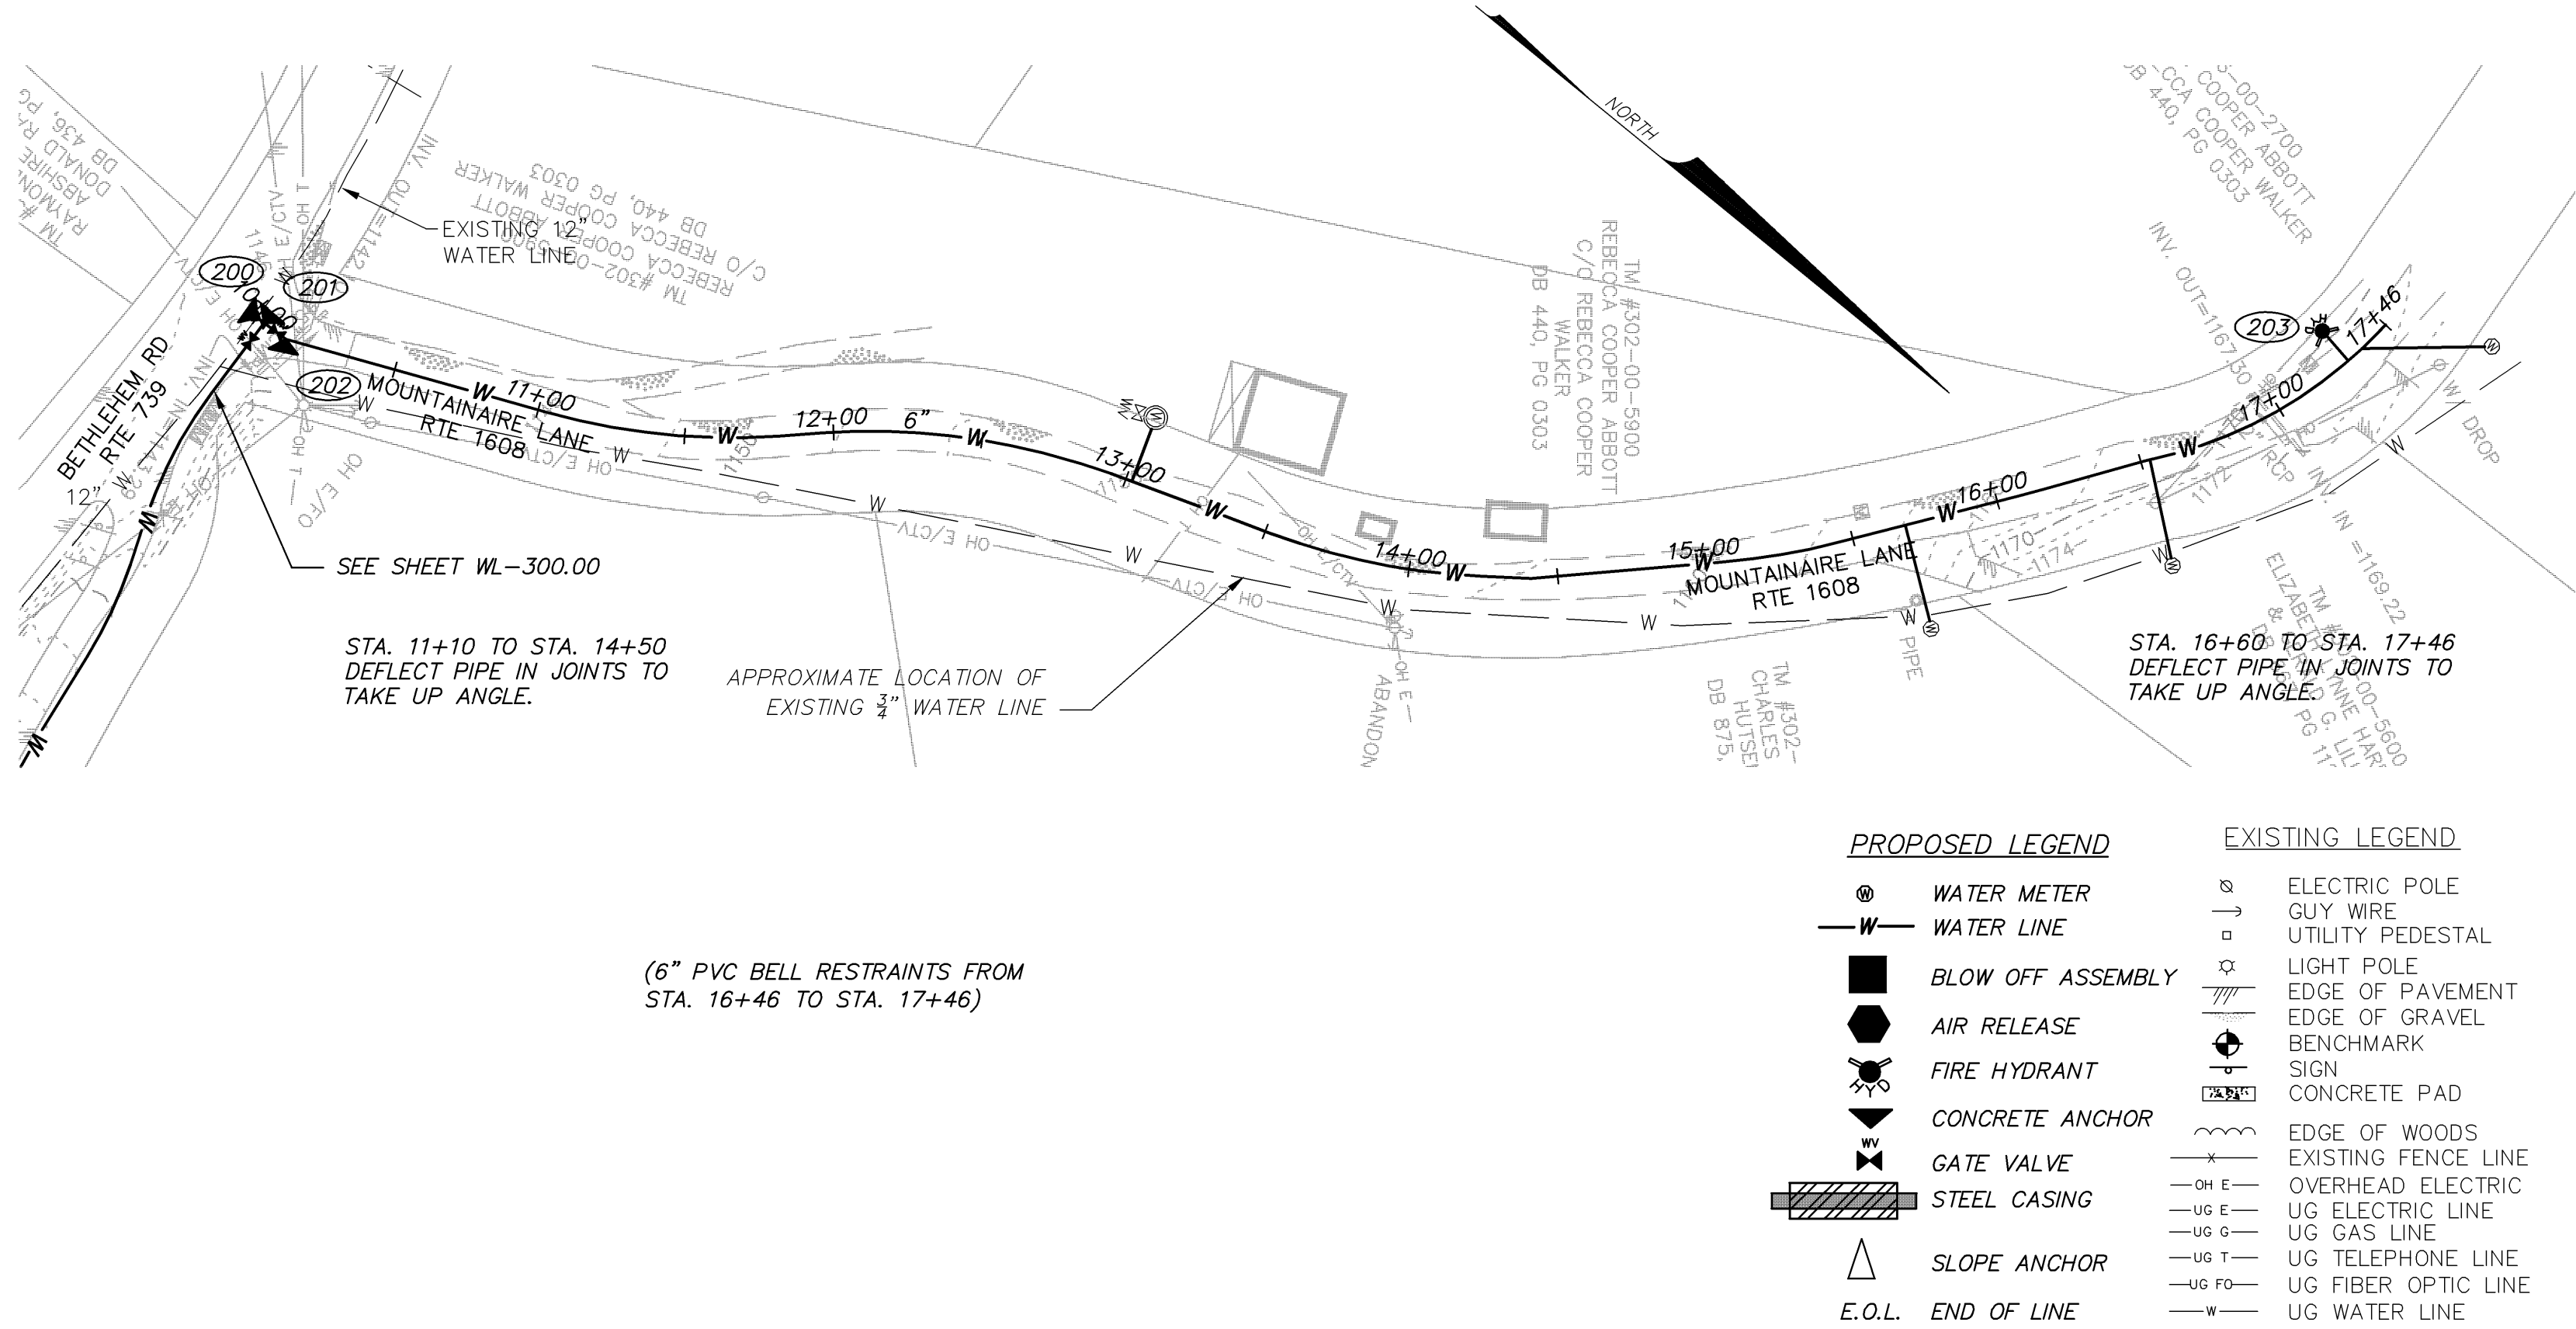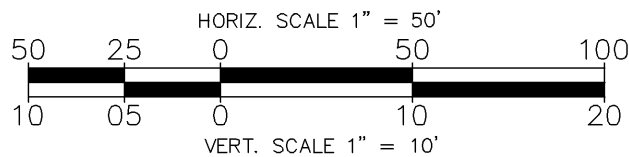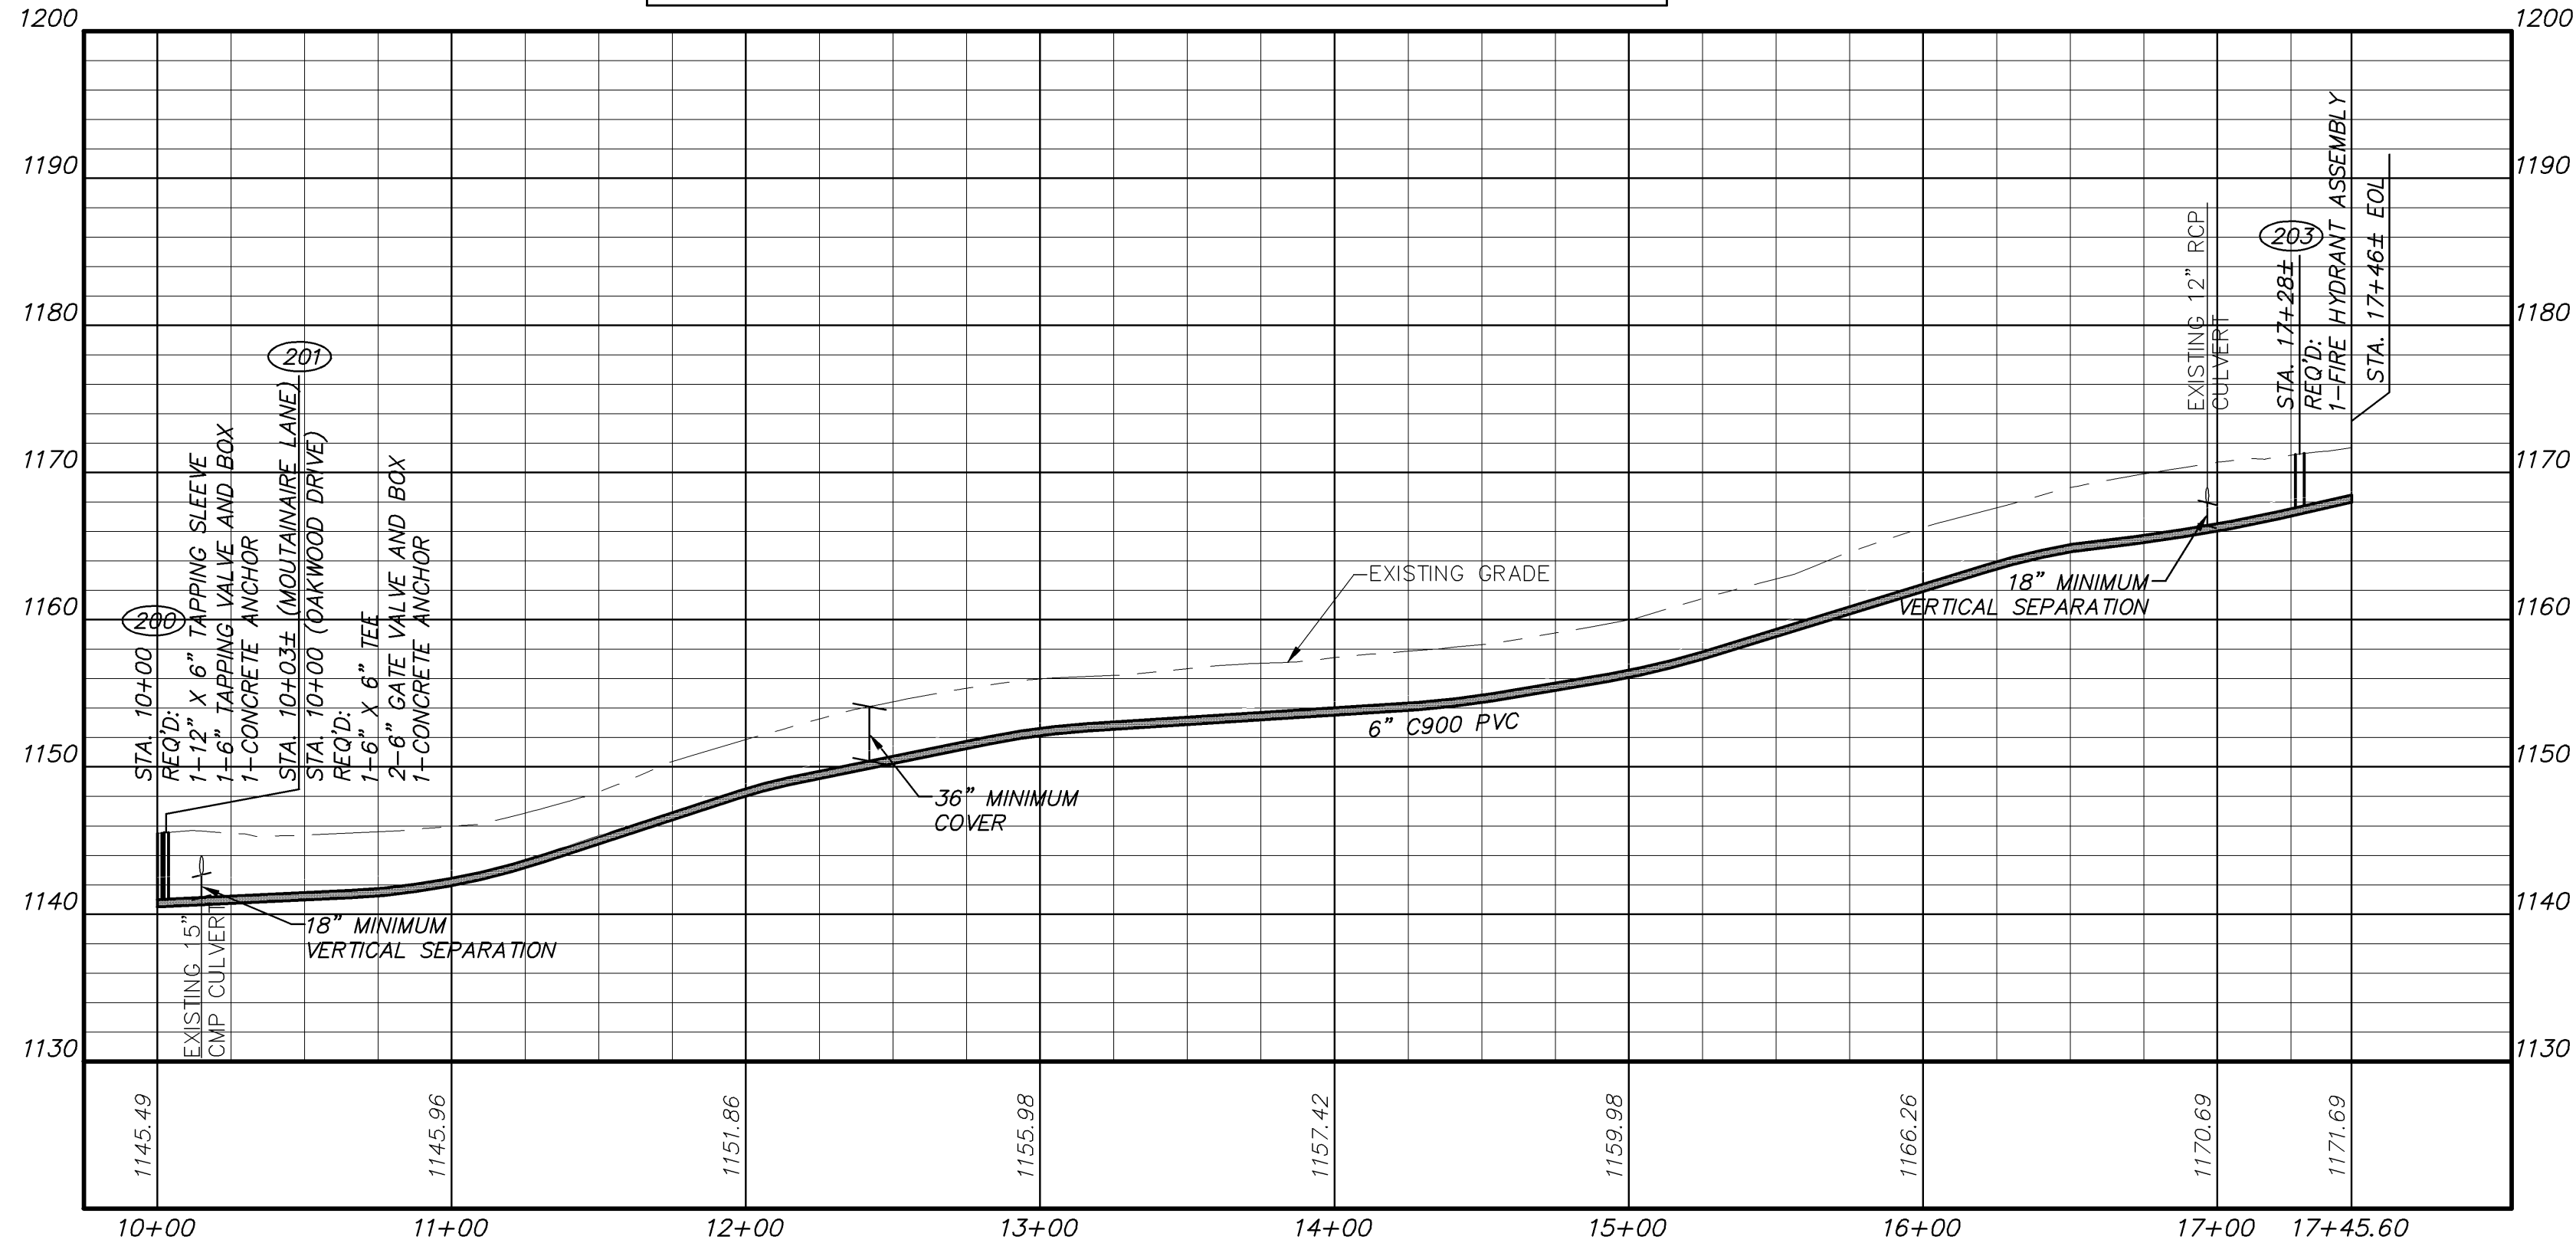
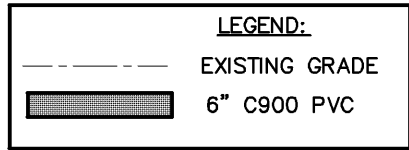


WATER LINE STRUCTURE SCHEDULE


200	STA. 10+00	REQ'D:	1-12" X 6" TAPPING SLEEVE 1-6" TAPPING VALVE AND BOX 1-CONCRETE ANCHOR
201	STA. 10+03± (MOUNTAINAIRE LANE) STA 10+00 (OAKWOOD DRIVE)	REQ'D:	1-6" X 6" TEE 2-6" GATE VALVE AND BOX 1-CONCRETE ANCHOR
202	STA. 10+12±	REQ'D:	1-6" 22.5' BEND 1-CONCRETE ANCHOR
203	STA. 17+28±	REQ'D:	1-FIRE HYDRANT ASSEMBLY



Mar 14, 2012 - 10:28am V:\LandProjects\20080815\dwg\Asbults-WL-ASBULT-P-Water.dwg

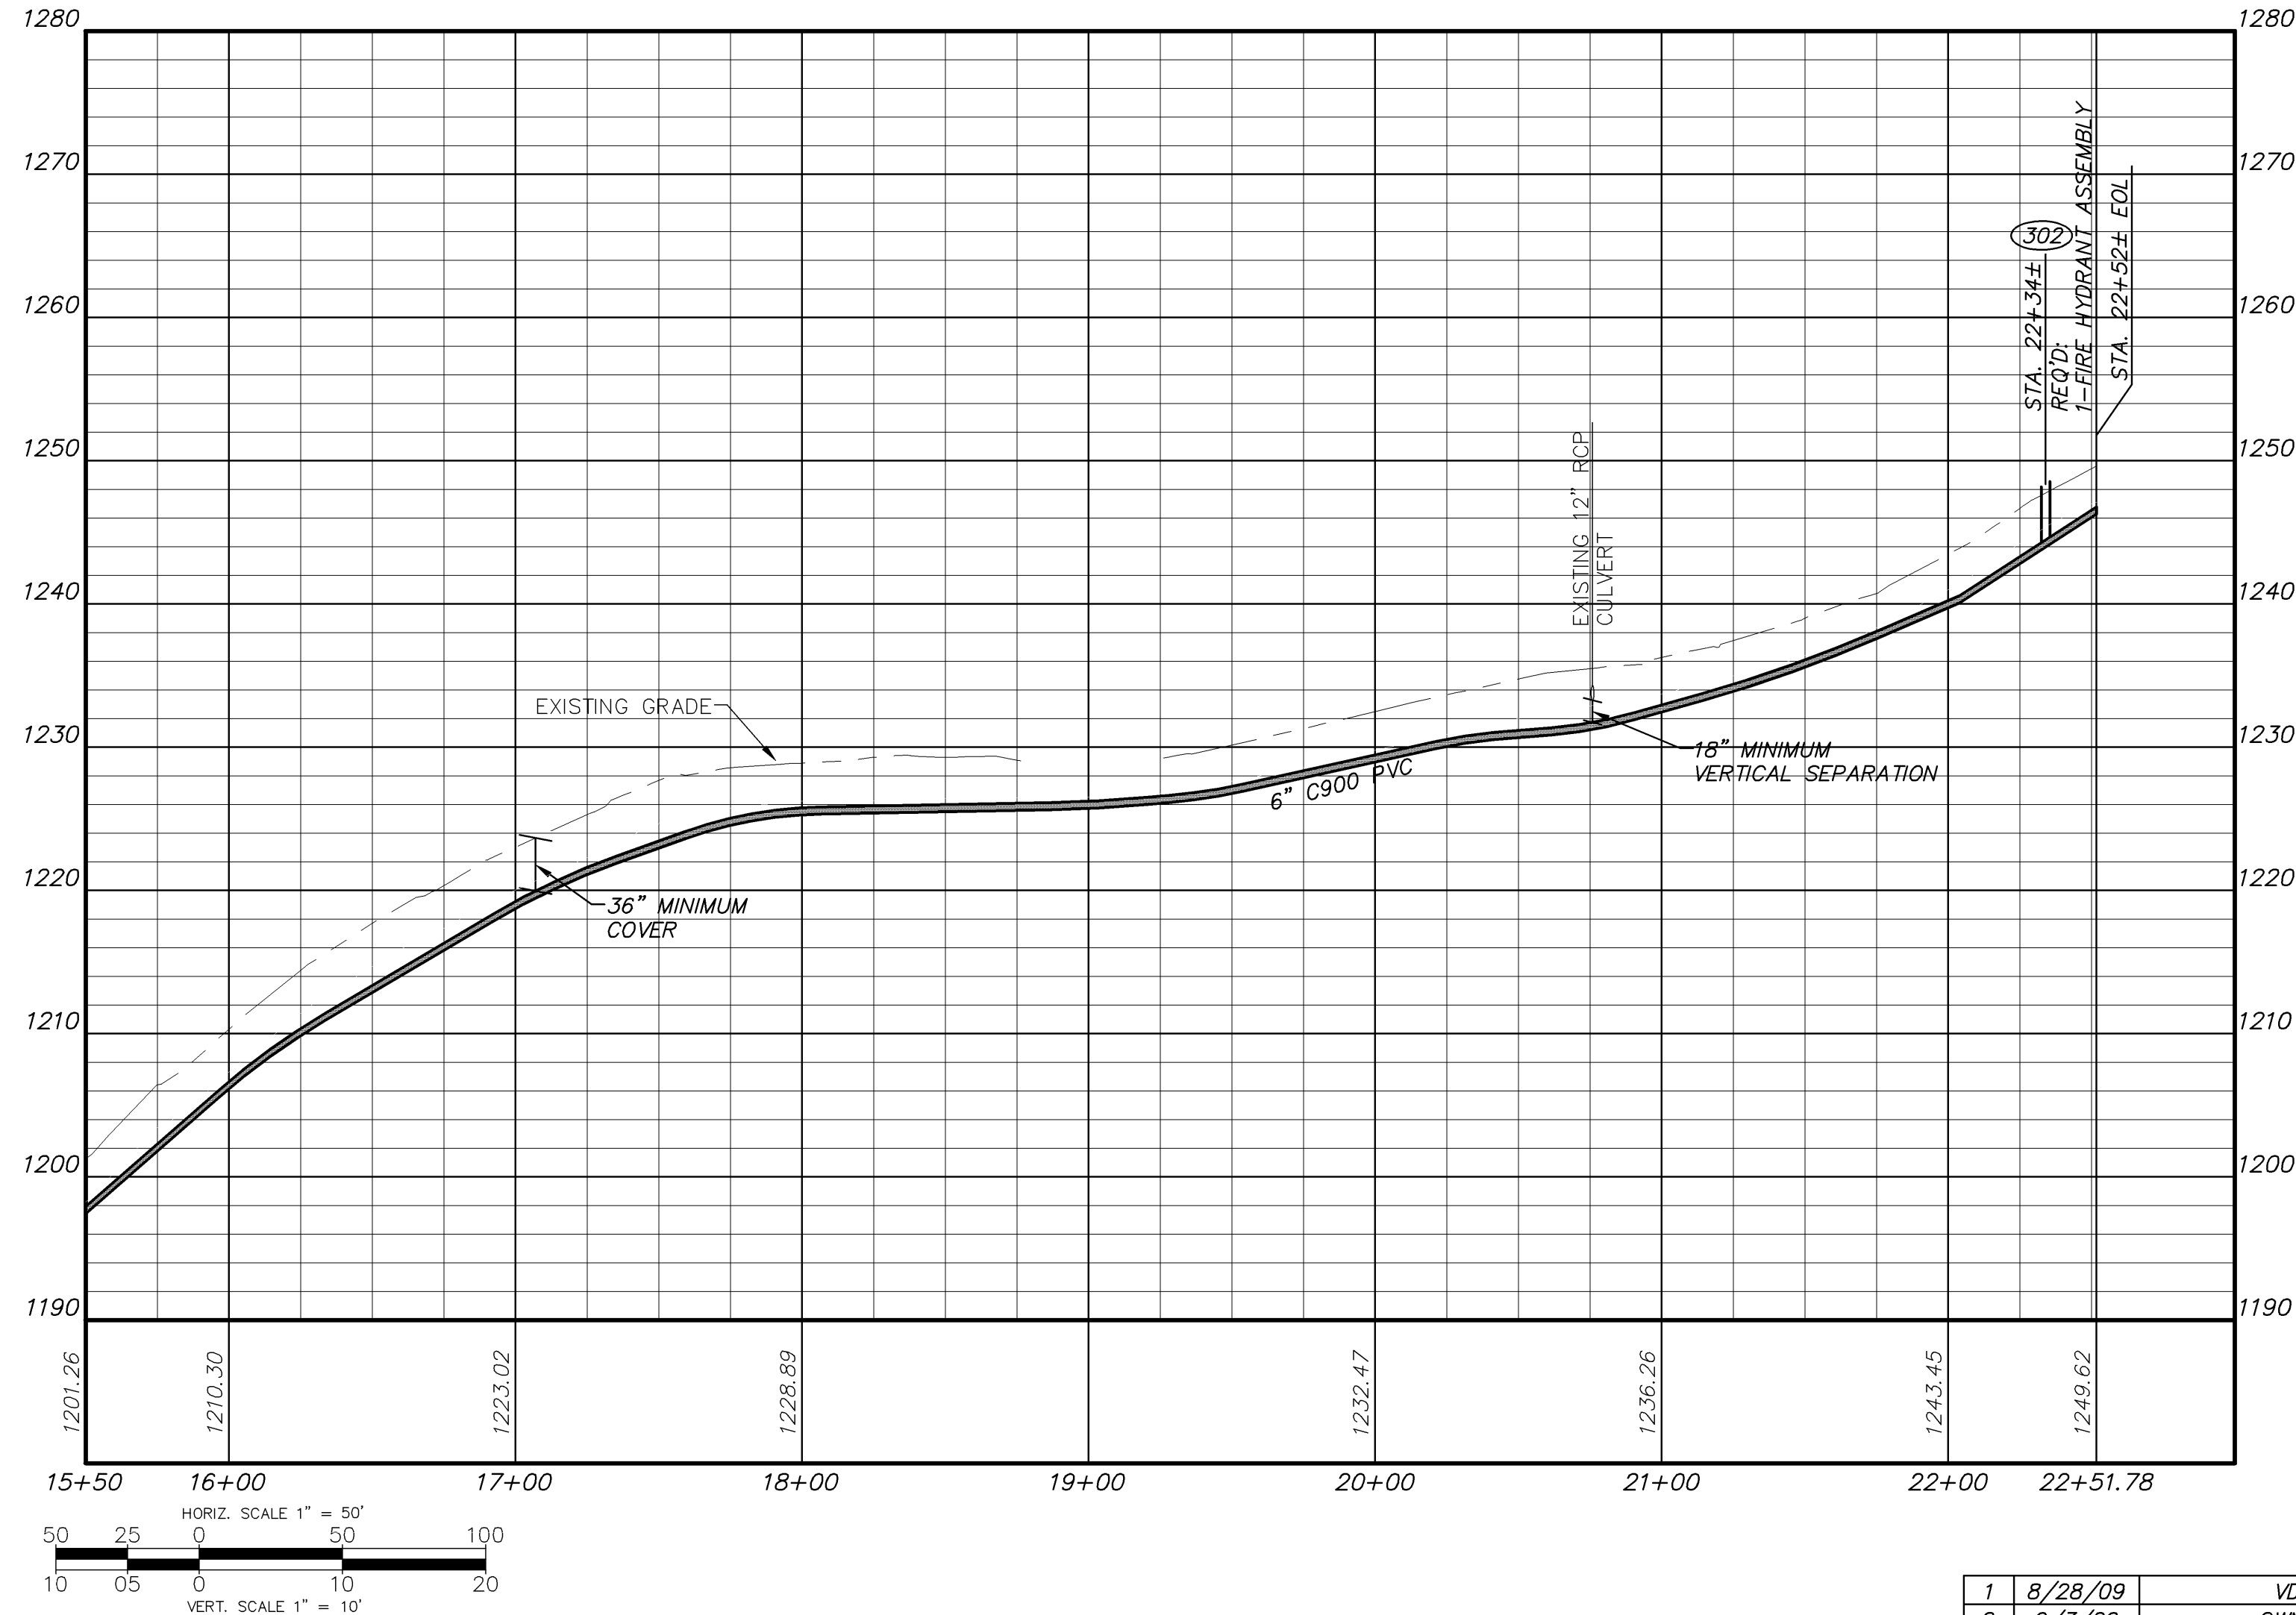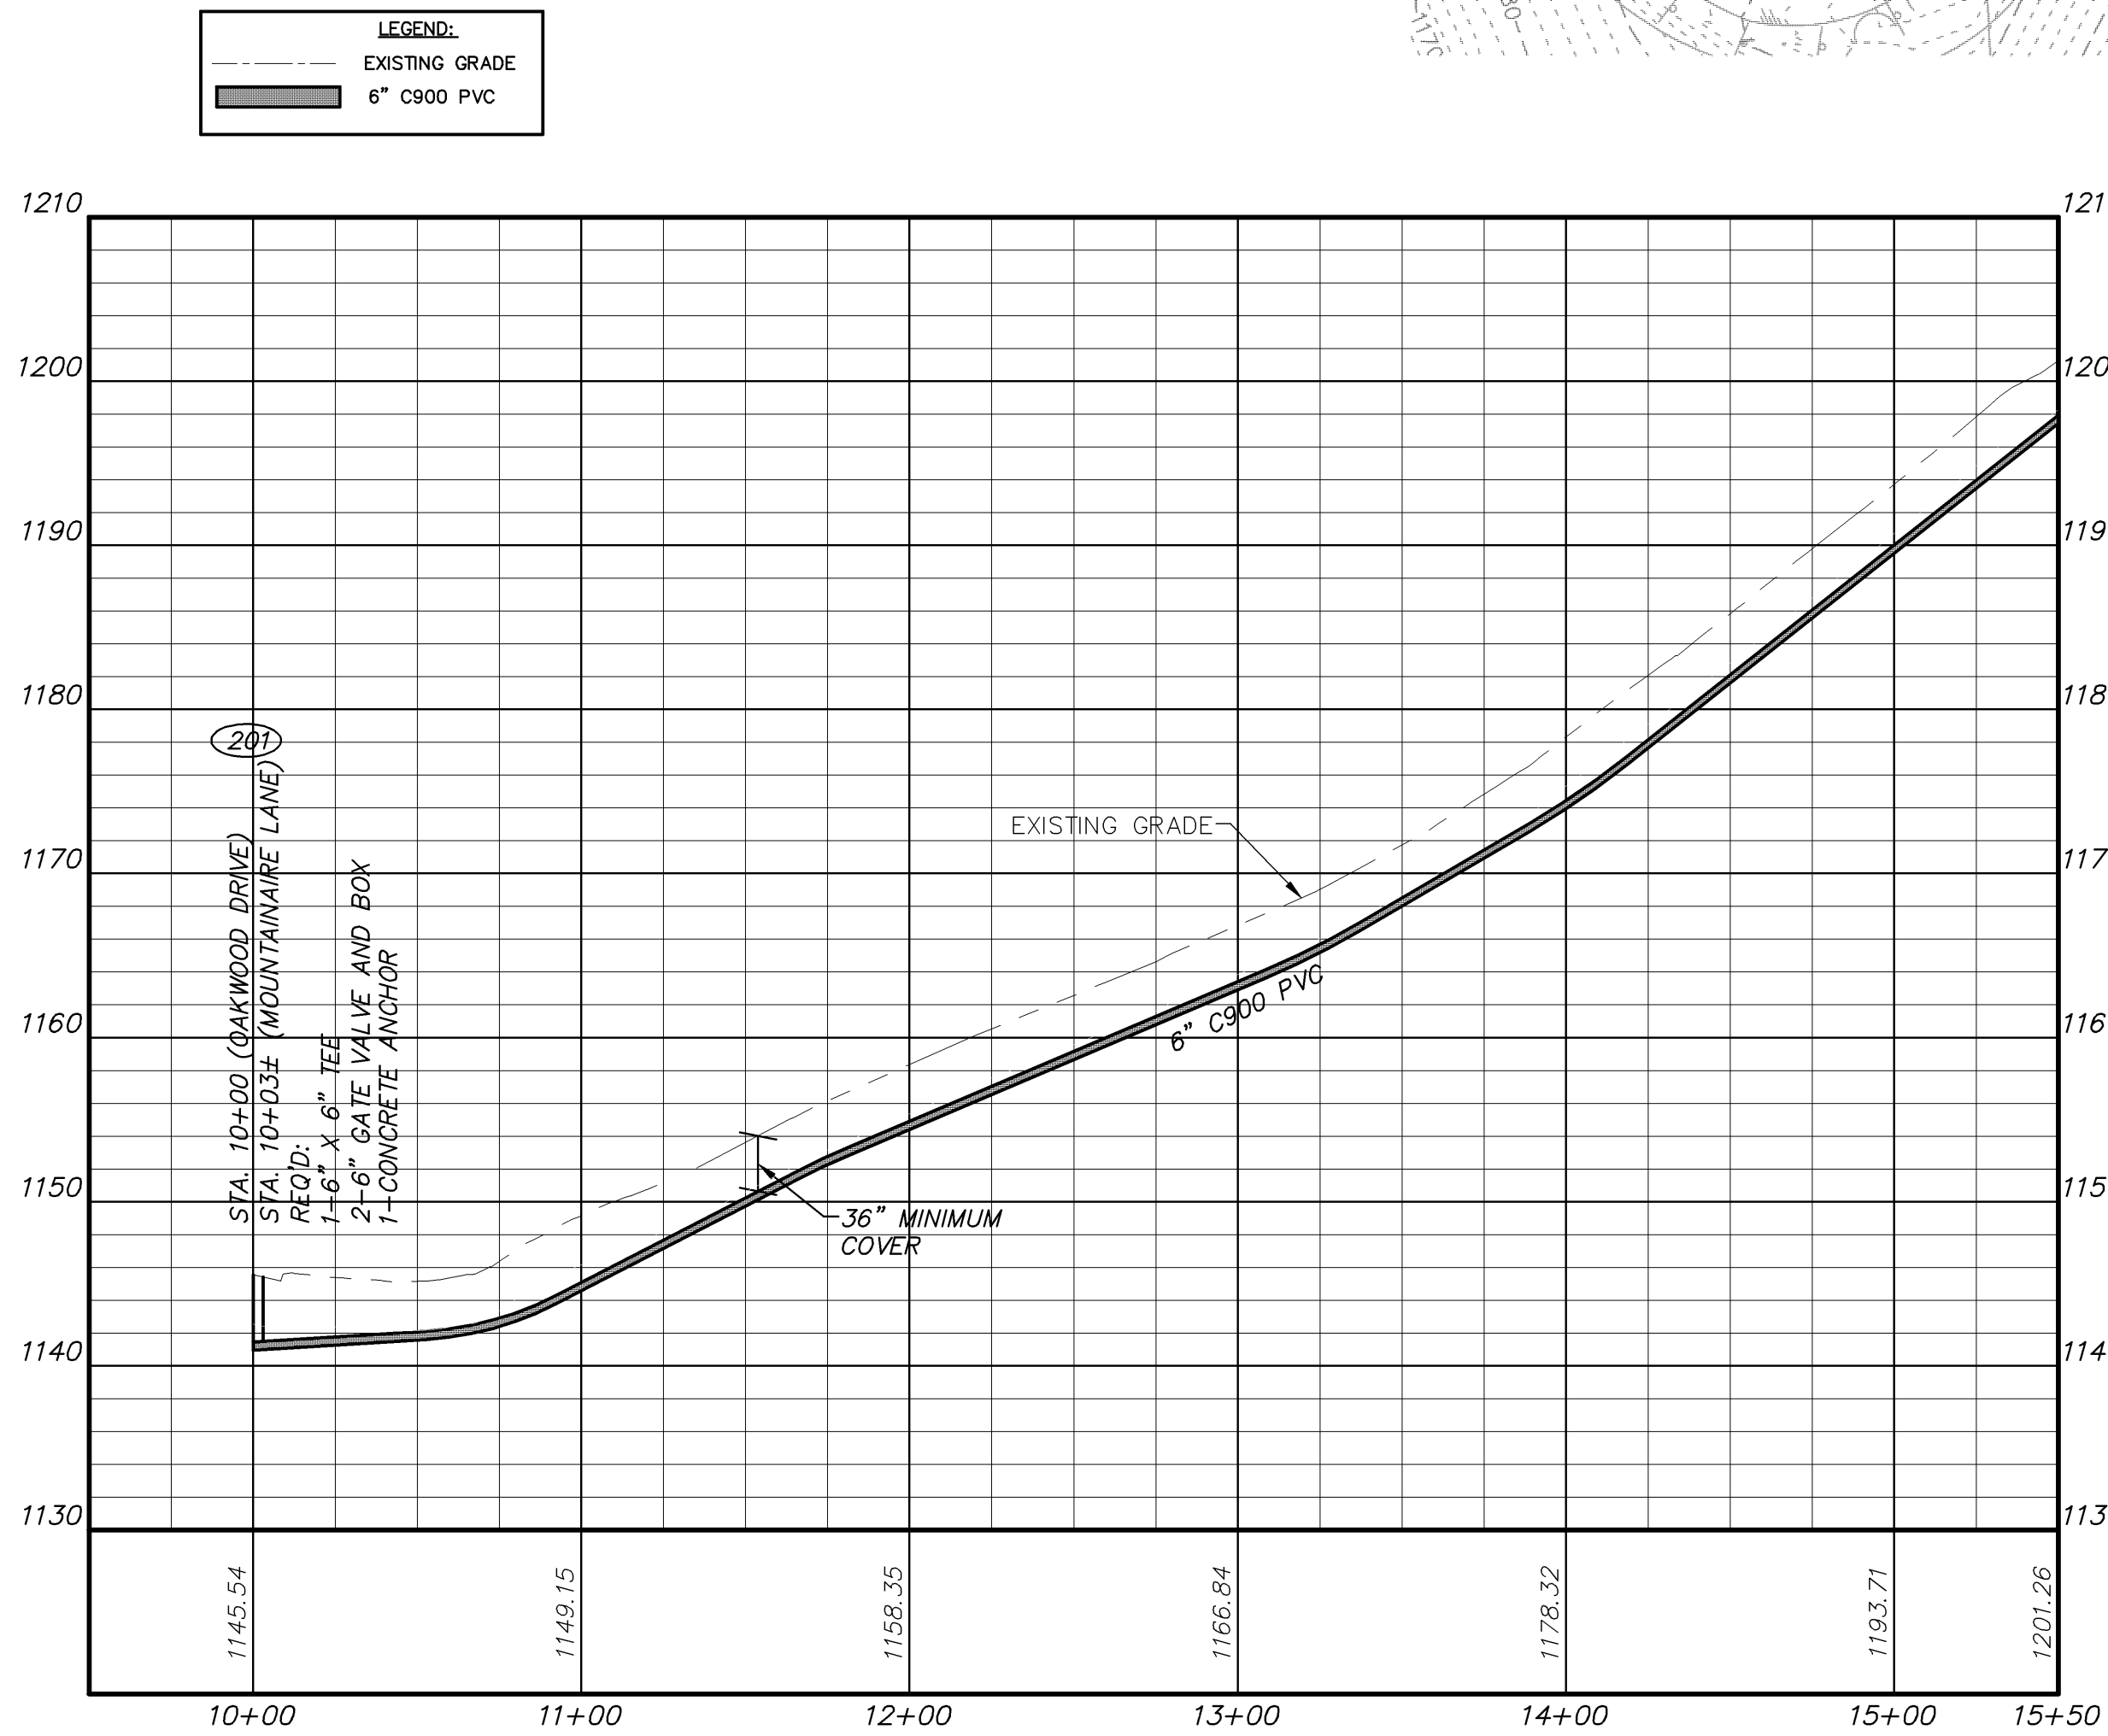

1	8/28/09	VDH COMMENTS
2	9/3/09	OWNER COMMENTS
4	3/14/12	ASBULTS

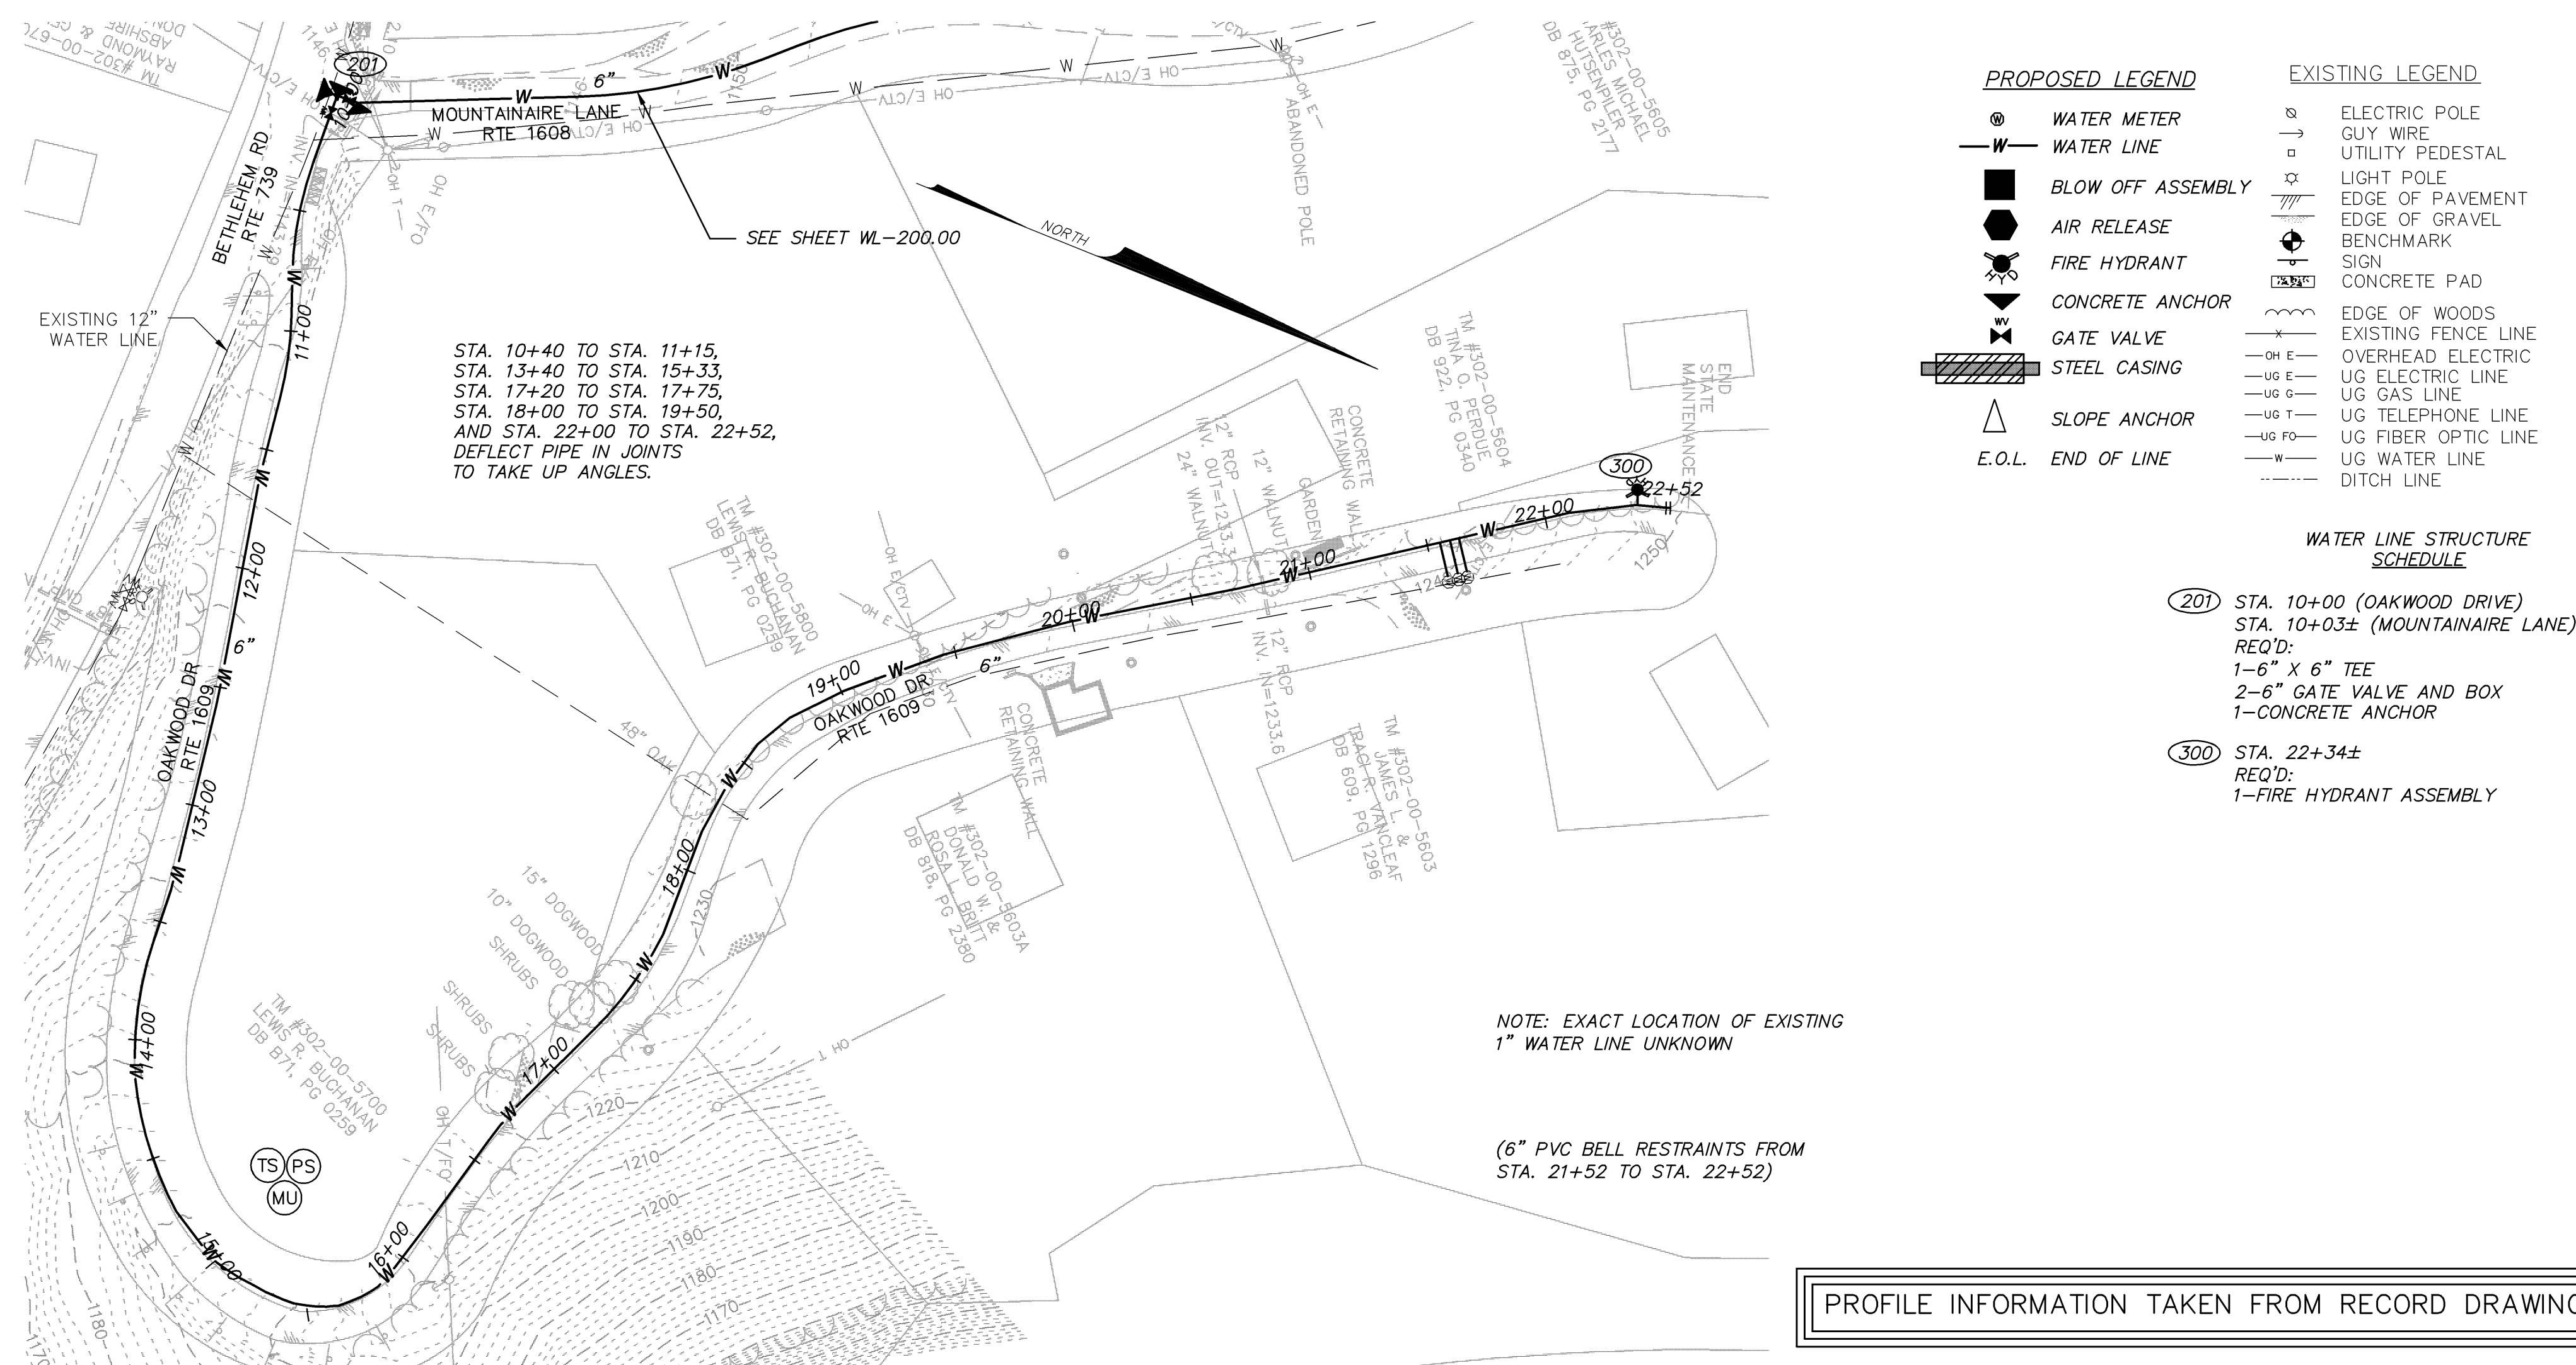

\*ENGINEERING >> SURVEYING >> PLANNING

**HURT & PROFFITT**  
INCORPORATED  
2524 LANGHORNE ROAD  
LYNCHBURG VA 24501  
800.242.6906 TOLL FREE  
434.847.7796 MAIN  
434.847.0047 FAX

**STA. 10+00 - 22+52± EOL OAKWOOD DRIVE-ASBULT**  
**FOR**  
**TOWN OF BOONES MILL WATER SYSTEM REPLACEMENT, VOLUME 1**  
**TOWN OF BOONES MILL, BOONE DISTRICT, FRANKLIN COUNTY, VA**

PROJECT NO. 20080815  
G.L. NO. 297-03-A3.9  
FILE NO. G-12675  
DATE: 7/31/09  
DRAWN BY: WCH  
CHECKED BY: BLC




**HURT & PROFFITT**

SHEET NO.  
**WL-300.00**





Mar 14, 2012, 10:29am V:\LandProjects\20080815.dwg\Asbults-WL-ASBULT-P-P-Water.dwg

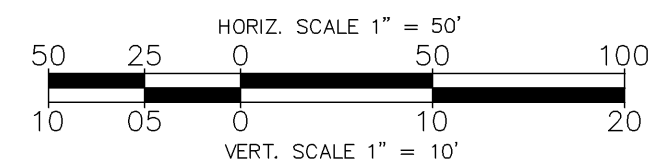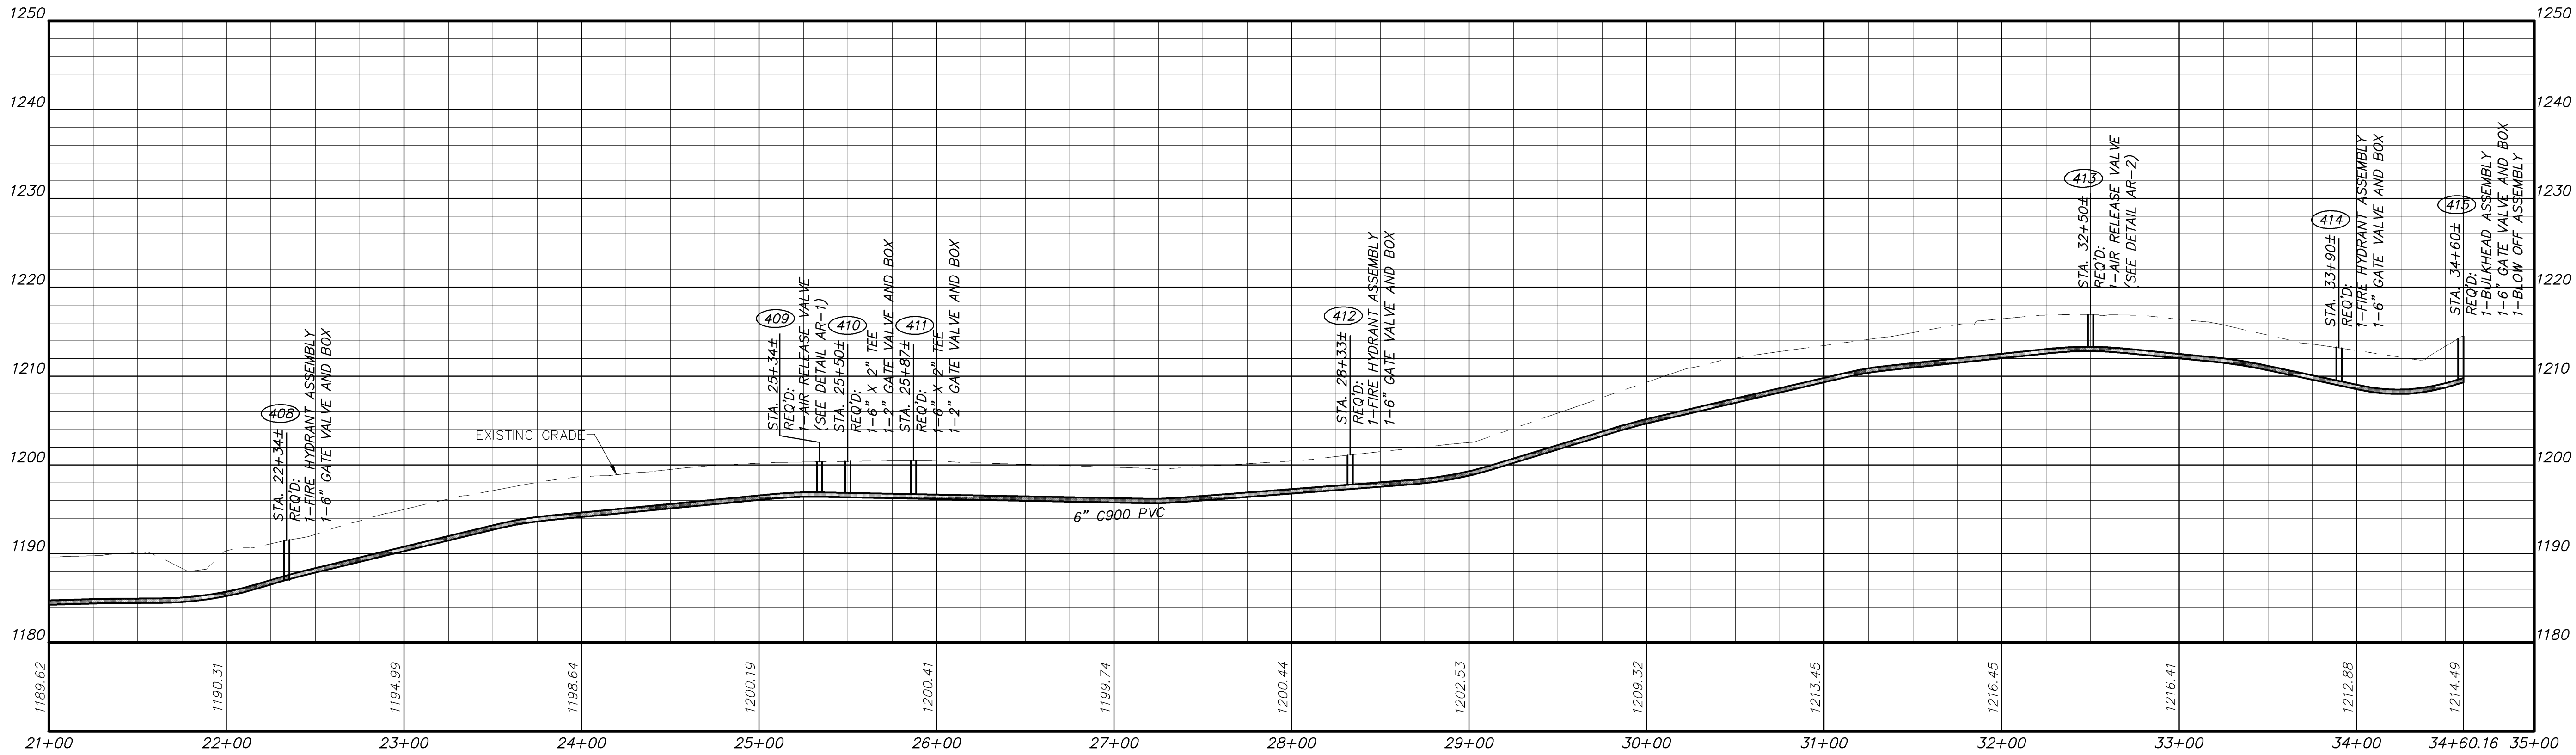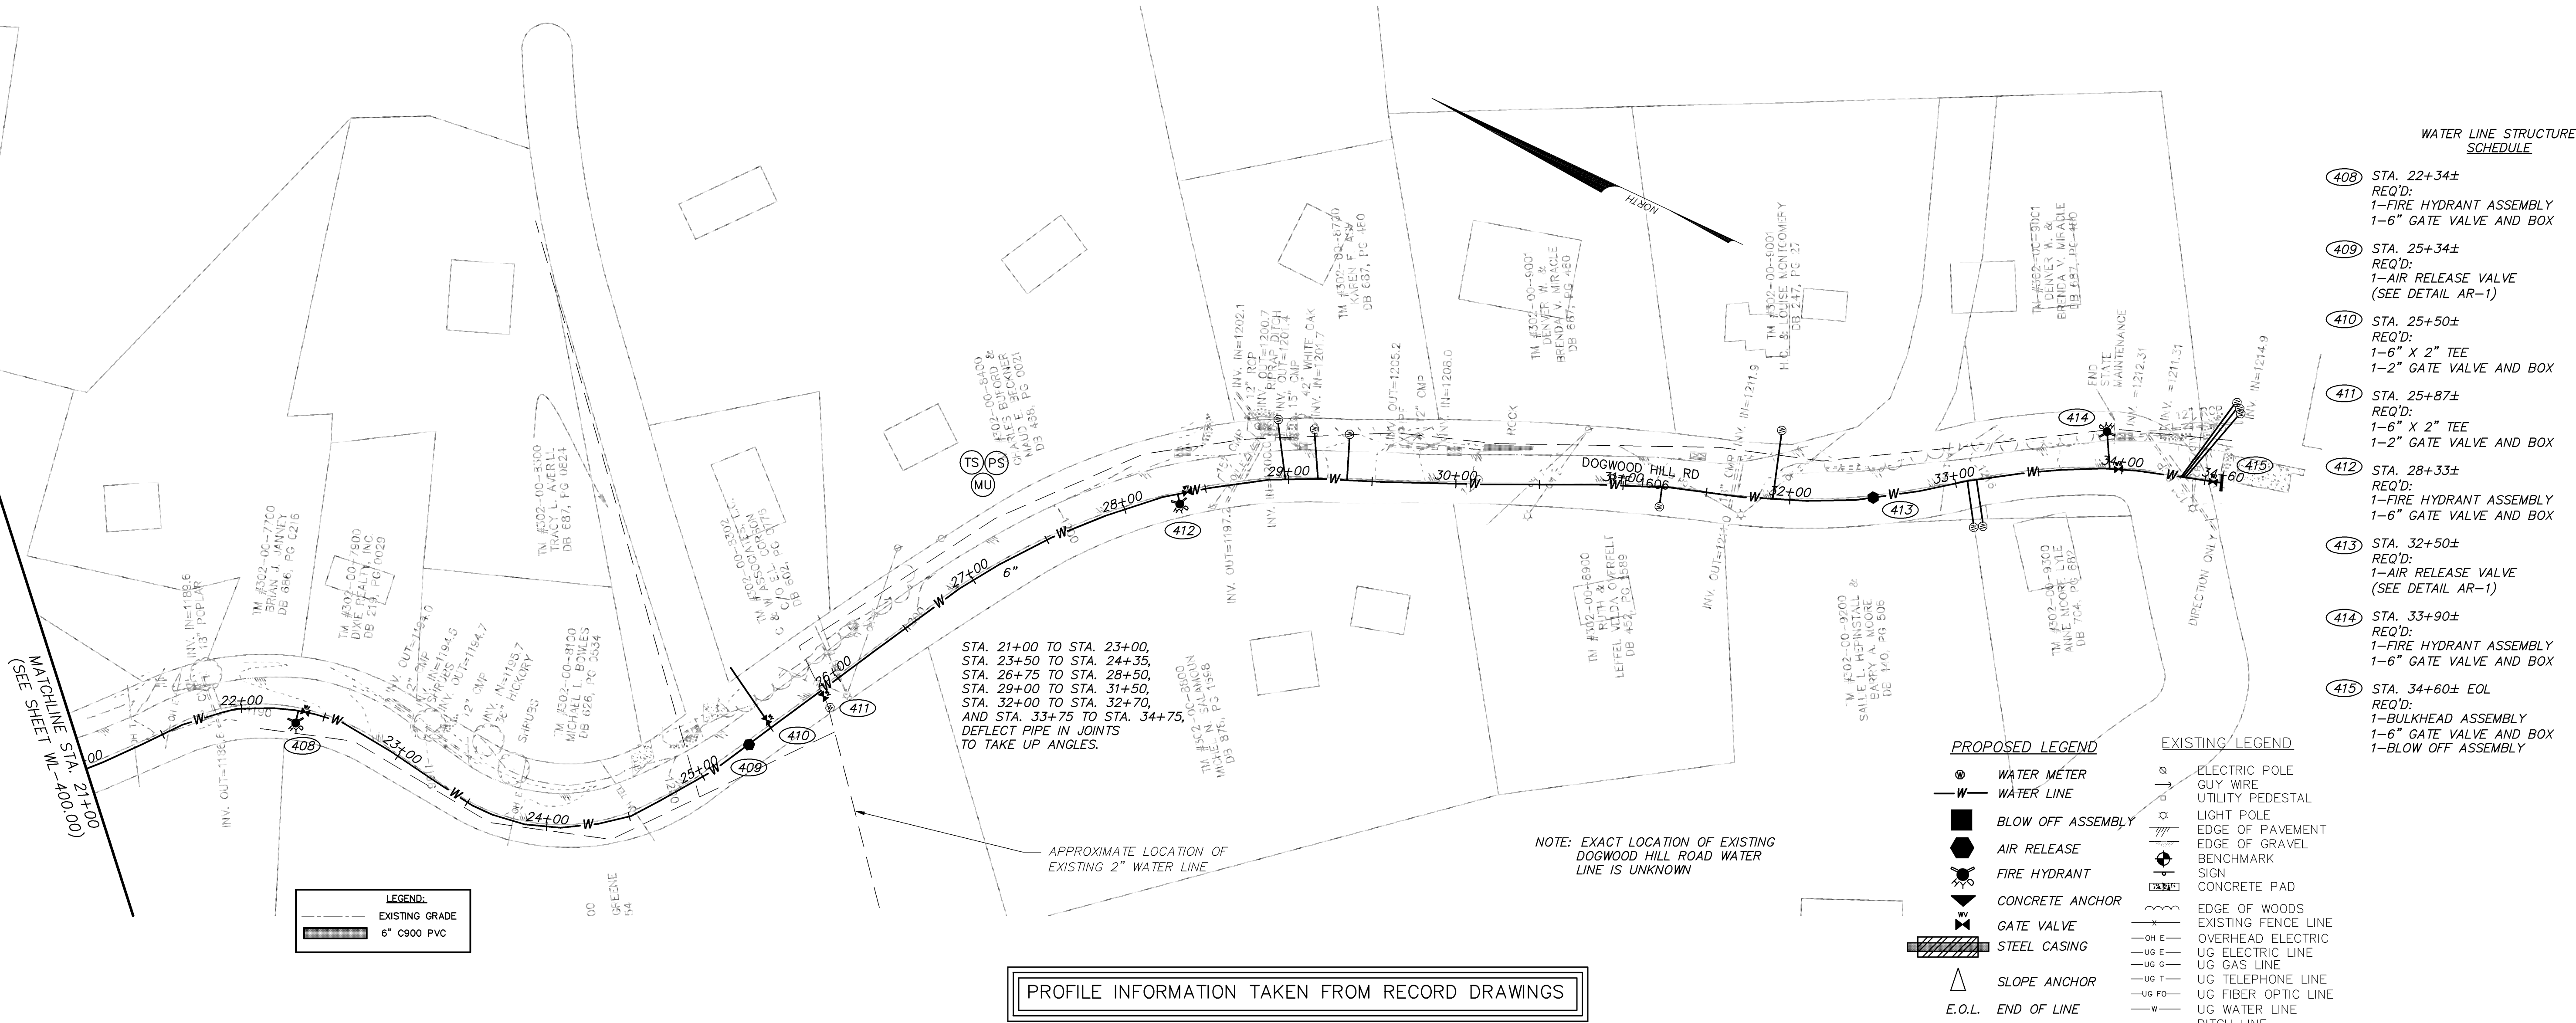

WATER LINE STRUCTURE  
SCHEDULE

408	STA. 22+34± REQ'D: 1-FIRE HYDRANT ASSEMBLY 1-6" GATE VALVE AND BOX
409	STA. 25+34± REQ'D: 1-AIR RELEASE VALVE (SEE DETAIL AR-1)
410	STA. 25+50± REQ'D: 1-6" X 2" TEE 1-2" GATE VALVE AND BOX
411	STA. 25+87± REQ'D: 1-6" X 2" TEE 1-2" GATE VALVE AND BOX
412	STA. 28+33± REQ'D: 1-FIRE HYDRANT ASSEMBLY 1-6" GATE VALVE AND BOX
413	STA. 32+50± REQ'D: 1-AIR RELEASE VALVE (SEE DETAIL AR-1)
414	STA. 33+90± REQ'D: 1-FIRE HYDRANT ASSEMBLY 1-6" GATE VALVE AND BOX
415	STA. 34+60± EOL REQ'D: 1-BULKHEAD ASSEMBLY 1-6" GATE VALVE AND BOX 1-BLOW OFF ASSEMBLY

\*ENGINEERING > SURVEYING > PLANNING

**HURT & PROFFITT**  
INCORPORATED  
2524 LANGHORNE ROAD  
LYNCHBURG VA 24501  
800.242.6906 TOLL FREE  
434.847.7796 FAX  
434.847.0047 FAX

**STA. 21+00 - 34+60± EOL DOGWOOD HILL ROAD-ASBUILT**  
**FOR**  
**TOWN OF BOONES MILL WATER SYSTEM REPLACEMENT, VOLUME 1**  
**TOWN OF BOONES MILL, BOONE DISTRICT, FRANKLIN COUNTY, VA**


PROJECT NO. 20080815  
G.L. NO. 297-03-A3.9  
FILE NO. G-12675  
DATE: 7/31/09  
DRAWN BY: WCH  
CHECKED BY: BLC

**HURT & PROFFITT**

SHEET NO.  
**WL-400.01**


1	8/28/09	VDH COMMENTS
2	9/3/09	OWNER COMMENTS
4	3/14/12	ASBUILTS

Mar 14, 2012, 10:30am V:\LandProj\Projects\20080815.dwg\Asbults-WL-ASBULT-P-Water.dwg

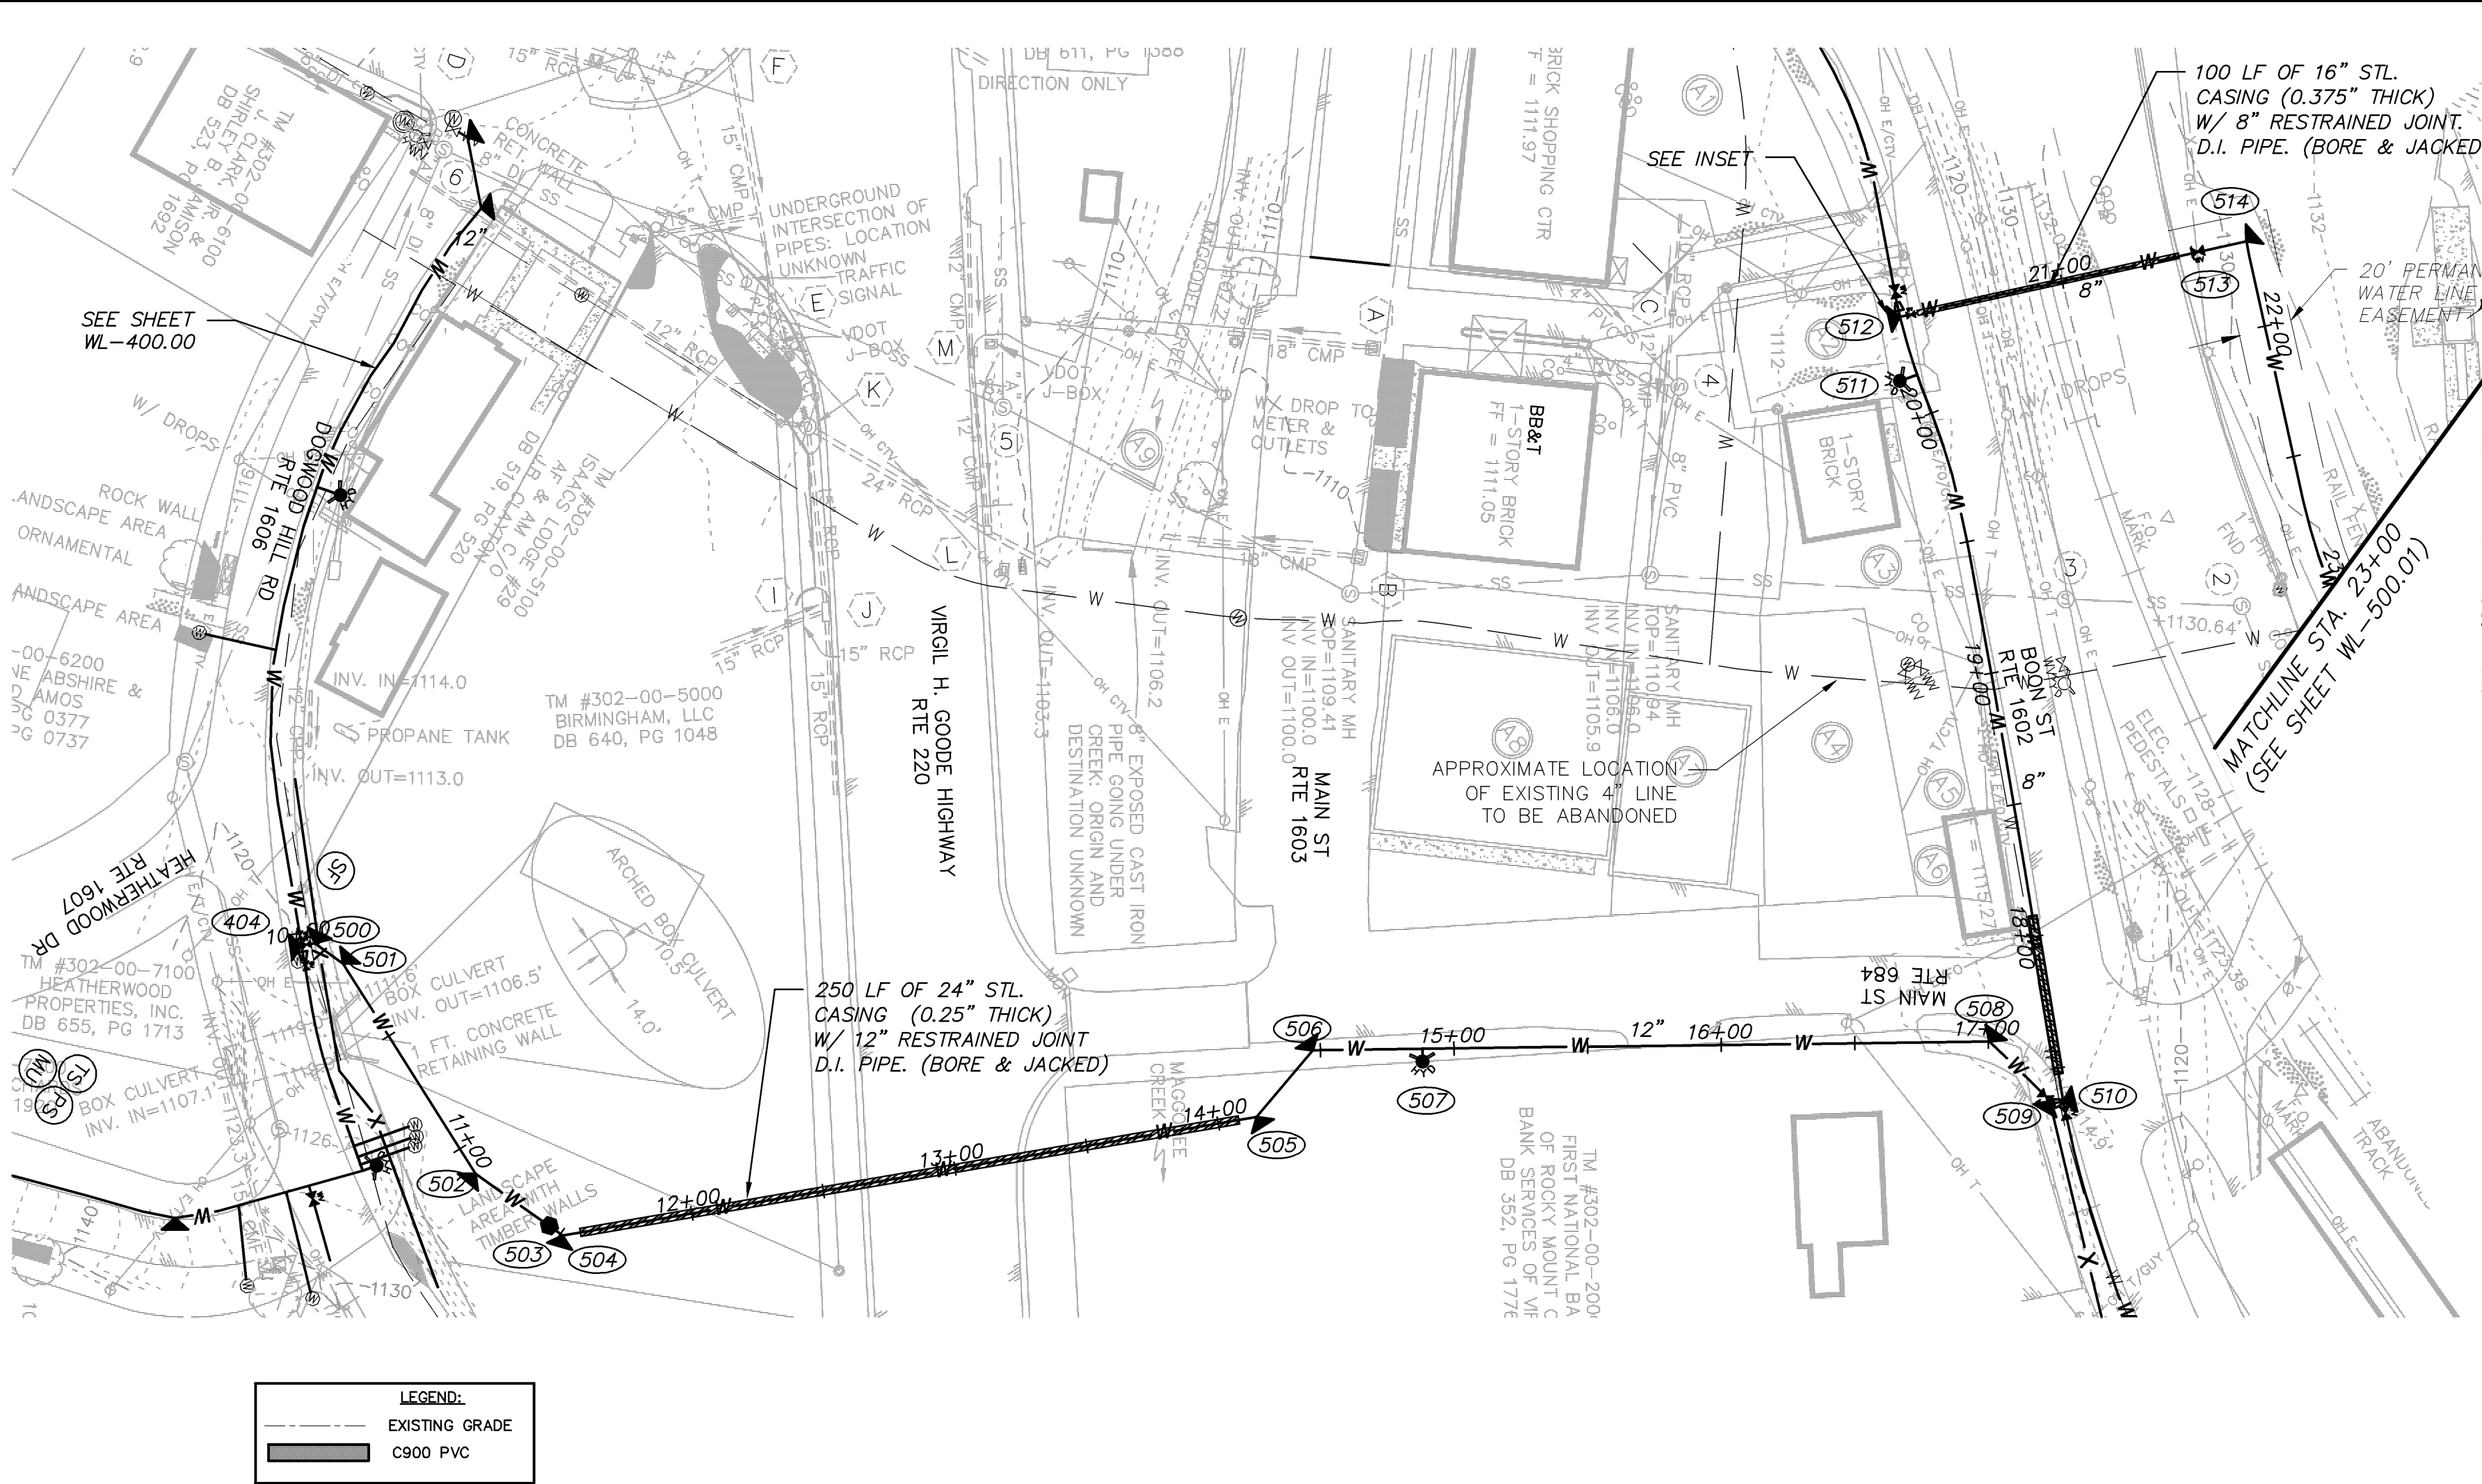

DIRECTIONAL DRILL FOR CROSSING  
US 220 & MAGGOE CREEK

28.8% DOWN	8'-2"
31.7% DOWN	12'-5"
28.8% DOWN	15'-2"
21.3% DOWN	16'-11"
10.9% DOWN	15'-7"
1.9% DOWN	16'-11"
3.8% DOWN	18'-5"
4.6% DOWN	20'-3"
7.5% DOWN	20'-7"
6.8% DOWN	10'-8"
5.1% DOWN	7'-10"
3.8% DOWN	7'-2"
2.2% UP	9'-6"
7.1% UP	9'-2"
15.1% UP	6'-1"
19.9% UP	

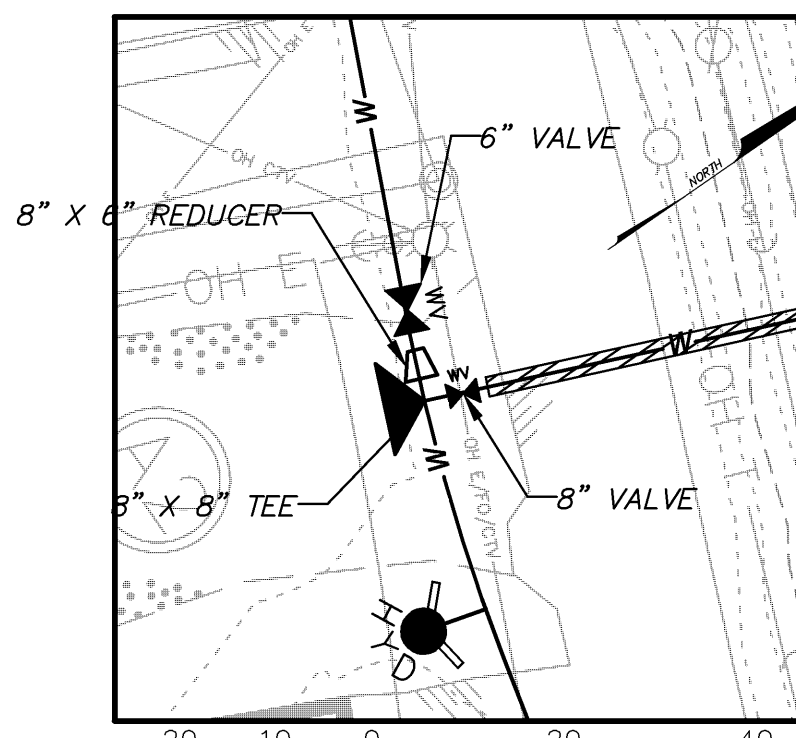

INSET



PROPOSED LEGEND

- WATER METER
- WATER LINE
- BLOW OFF ASSEMBLY
- AIR RELEASE
- FIRE HYDRANT
- CONCRETE ANCHOR
- GATE VALVE
- STEEL CASING
- SLOPE ANCHOR

E.O.L. END OF LINE

EXISTING LEGEND

- ELECTRIC POLE
- GUY WIRE
- UTILITY PEDESTAL
- LIGHT POLE
- EDGE OF PAVEMENT
- EDGE OF GRAVEL
- BENCHMARK
- SIGN
- CONCRETE PAD
- EDGE OF WOODS
- EXISTING FENCE LINE
- OVERHEAD ELECTRIC
- UG ELECTRIC LINE
- UG GAS LINE
- UG TELEPHONE LINE
- UG FIBER OPTIC LINE
- UG WATER LINE
- DITCH LINE

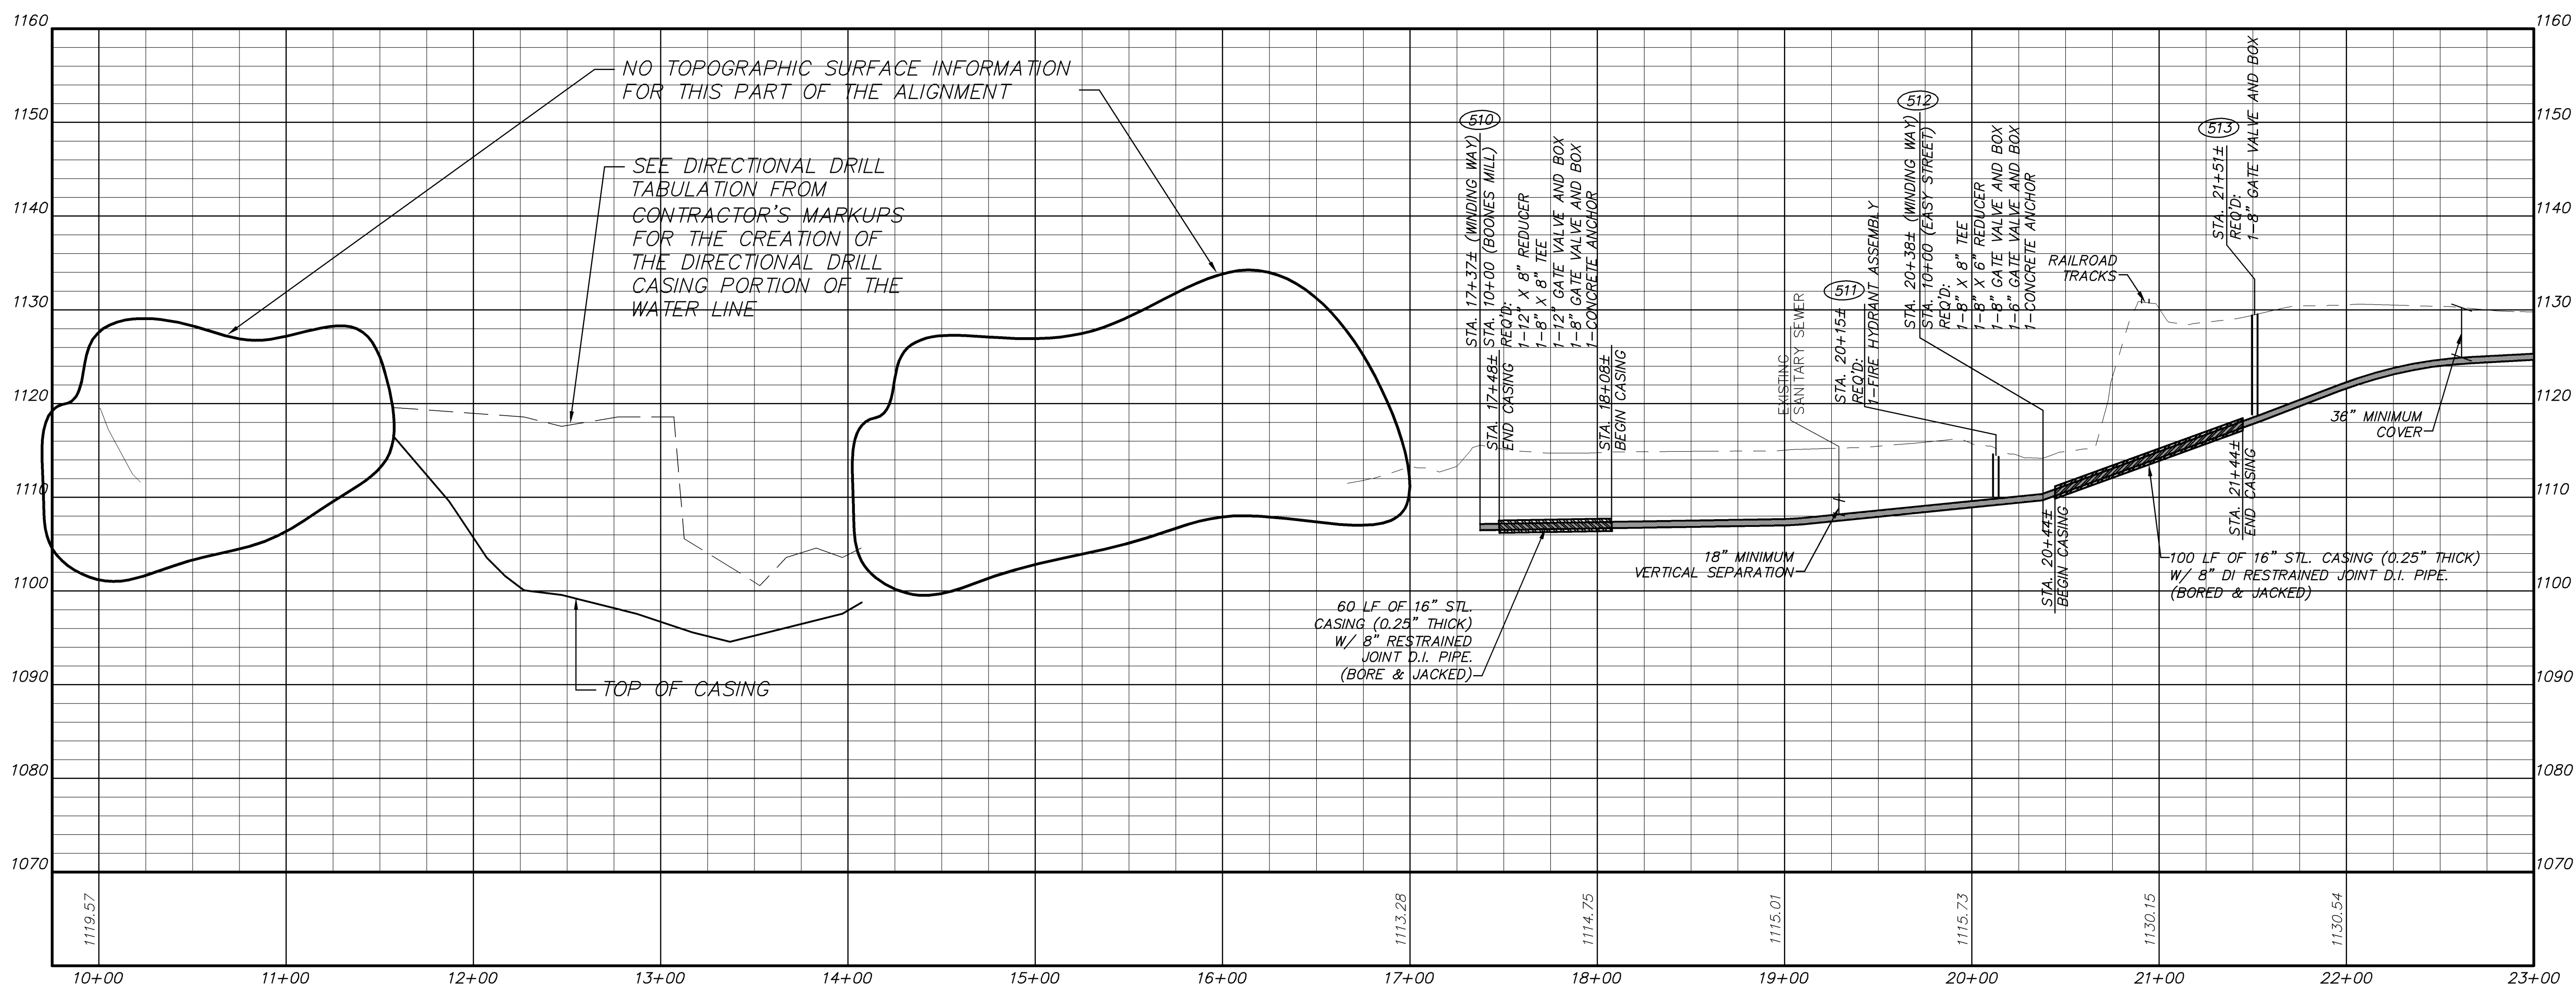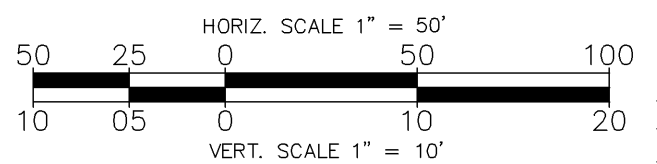

- 404 STA. 10+00 (WINDING WAY)  
STA. 13+27± (DOGWOOD HILL ROAD)  
REQ'D:  
1-12" X 12" TEE  
2-12" GATE VALVE AND BOX  
1-12" X 6" REDUCER  
1-6" GATE VALVE AND BOX  
1-CONCRETE ANCHOR
- 500 STA. 10+05±  
REQ'D:  
1-12" 45° BEND  
1-CONCRETE ANCHOR
- 501 STA. 10+18±  
REQ'D:  
1-12" 45° VERTICAL &  
HORIZONTAL BEND  
2-CONCRETE ANCHOR
- 502 STA. 11+11±  
REQ'D:  
1-12" 22.5° BEND  
1-CONCRETE ANCHOR
- 503 STA. 11+45±  
REQ'D:  
1-AIR RELEASE VALVE  
(SEE DETAIL AR-2)
- 504 STA. 11+51±  
REQ'D:  
1-12" 45° BEND  
1-CONCRETE ANCHOR
- 505 STA. 14+14±  
REQ'D:  
1-12" 45° BEND  
1-CONCRETE ANCHOR
- 506 STA. 14+47±  
REQ'D:  
1-12" 45° BEND  
1-CONCRETE ANCHOR
- 507 STA. 14+88±  
REQ'D:  
1-FIRE HYDRANT ASSEMBLY
- 508 STA. 17+00±  
REQ'D:  
1-12" 45° BEND  
1-CONCRETE ANCHOR
- 509 STA. 17+32±  
REQ'D:  
1-12" 45° BEND  
1-12" 22.5° BEND  
2-CONCRETE ANCHOR
- 510 STA. 17+37± (WINDING WAY)  
STA. 10+00 (BOONES MILL)  
REQ'D:  
1-12" X 8" REDUCER  
1-8" X 8" TEE  
1-12" GATE VALVE AND BOX  
1-8" GATE VALVE AND BOX  
1-CONCRETE ANCHOR
- 511 STA. 20+15±  
REQ'D:  
1-FIRE HYDRANT ASSEMBLY
- 512 STA. 20+38± (WINDING WAY)  
STA. 10+00 (EASY STREET)  
REQ'D:  
1-8" X 8" TEE  
1-8" X 6" REDUCER  
1-8" GATE VALVE AND BOX  
1-6" GATE VALVE AND BOX  
1-CONCRETE ANCHOR
- 513 STA. 21+51±  
REQ'D:  
1-8" GATE VALVE AND BOX
- 514 STA. 21+69±  
REQ'D:  
1-8" 90° HORIZONTAL &  
VERTICAL BEND  
1-CONCRETE ANCHOR

1	8/28/09	VDH COMMENTS
2	9/3/09	OWNER COMMENTS
3	2/17/10	REVISED ALIGNMENT
4	3/14/12	ASBULTS

\*ENGINEERING & SURVEYING >> PLANNING

**HURT & PROFFITT**  
INCORPORATED

2524 LANGHORNE ROAD  
LYNCHBURG VA 24501  
800.242.6906 TOLL FREE  
434.847.7796 MAIN  
434.847.0047 FAX

**STA. 10+00 - 23+00± WINDING WAY-ASBUILT**  
FOR

**TOWN OF BOONES MILL WATER SYSTEM REPLACEMENT, VOLUME 1**  
**TOWN OF BOONES MILL, BOONE DISTRICT, FRANKLIN COUNTY, VA**




PROJECT NO.	20080815
G.L. NO.	297-03-A3.9
FILE NO.	G-12675
DATE:	7/31/09
DRAWN BY:	WCH
CHECKED BY:	BLC

**HURT & PROFFITT**

SHEET NO.  
**WL-500.00**



Mar 14, 2012 - 10:31am V:\LandProjects\20080815\dwg\Asbuilts-WL-ASBUIL.T-P-Water.dwg

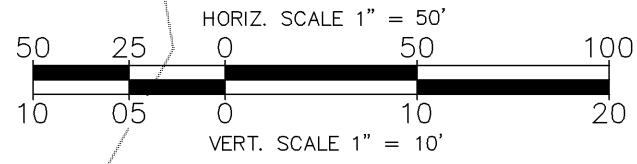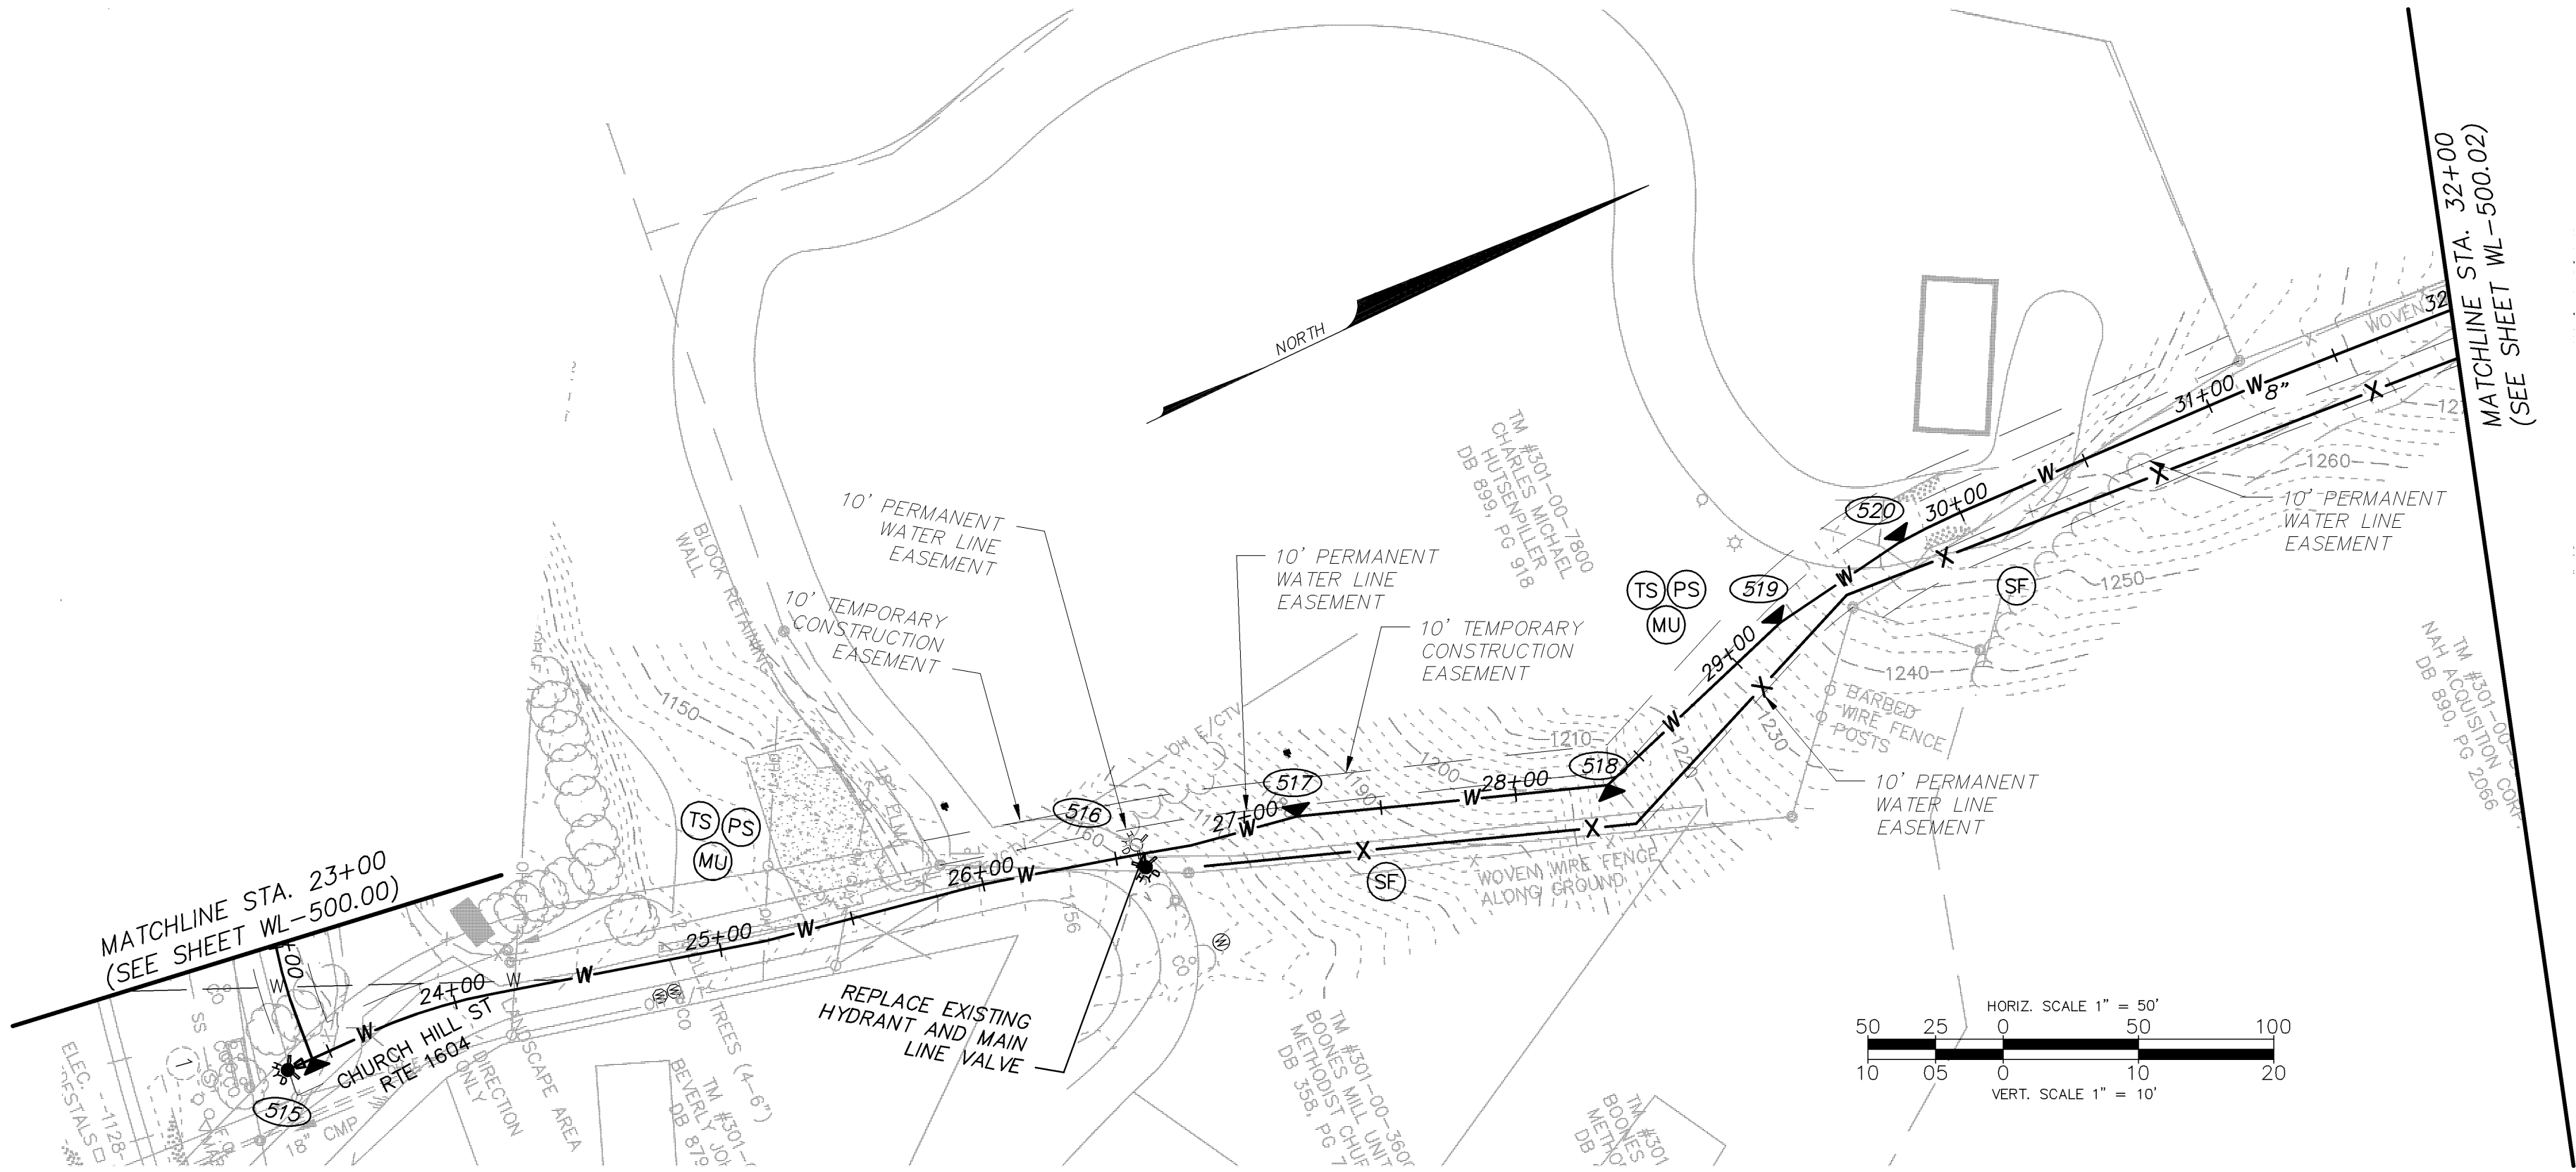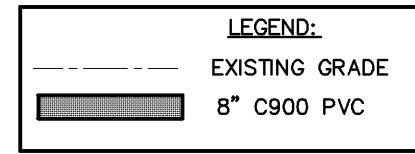

WATER LINE STRUCTURE  
SCHEDULE



- (515) STA. 23+42±  
REQ'D:  
1-8" X 8" TEE  
1-8" X 6" REDUCER  
1-FIRE HYDRANT ASSEMBLY  
1-CONCRETE ANCHOR
- (516) STA. 26+61±  
REQ'D:  
REMOVE AND DISPOSE OF EXISTING  
HYDRANT ASSEMBLY  
1-FIRE HYDRANT ASSEMBLY
- (517) STA. 27+19±  
REQ'D:  
1-8" 22.5° BEND  
1- CONCRETE ANCHOR
- (518) STA. 28+34±  
REQ'D:  
1-8" 45° BEND  
1-CONCRETE ANCHOR
- (519) STA. 29+22±  
REQ'D:  
1-8" 22.5° BEND  
1-CONCRETE ANCHOR
- (520) STA. 29+76±  
REQ'D:  
1-8" 11.25° BEND  
1-CONCRETE ANCHOR

EXISTING LEGEND

- ELECTRIC POLE  
GUY WIRE  
UTILITY PEDESTAL  
LIGHT POLE  
EDGE OF PAVEMENT  
EDGE OF GRAVEL  
BENCHMARK  
SIGN  
CONCRETE PAD  
EDGE OF WOODS  
EXISTING FENCE LINE  
OVERHEAD ELECTRIC  
UG ELECTRIC LINE  
UG GAS LINE  
UG TELEPHONE LINE  
UG FIBER OPTIC LINE  
UG WATER LINE  
DITCH LINE

PROPOSED LEGEND

- WATER METER  
WATER LINE  
BLOW OFF ASSEMBLY  
AIR RELEASE  
FIRE HYDRANT  
CONCRETE ANCHOR  
GATE VALVE  
STEEL CASING  
SLOPE ANCHOR  
E.O.L. END OF LINE

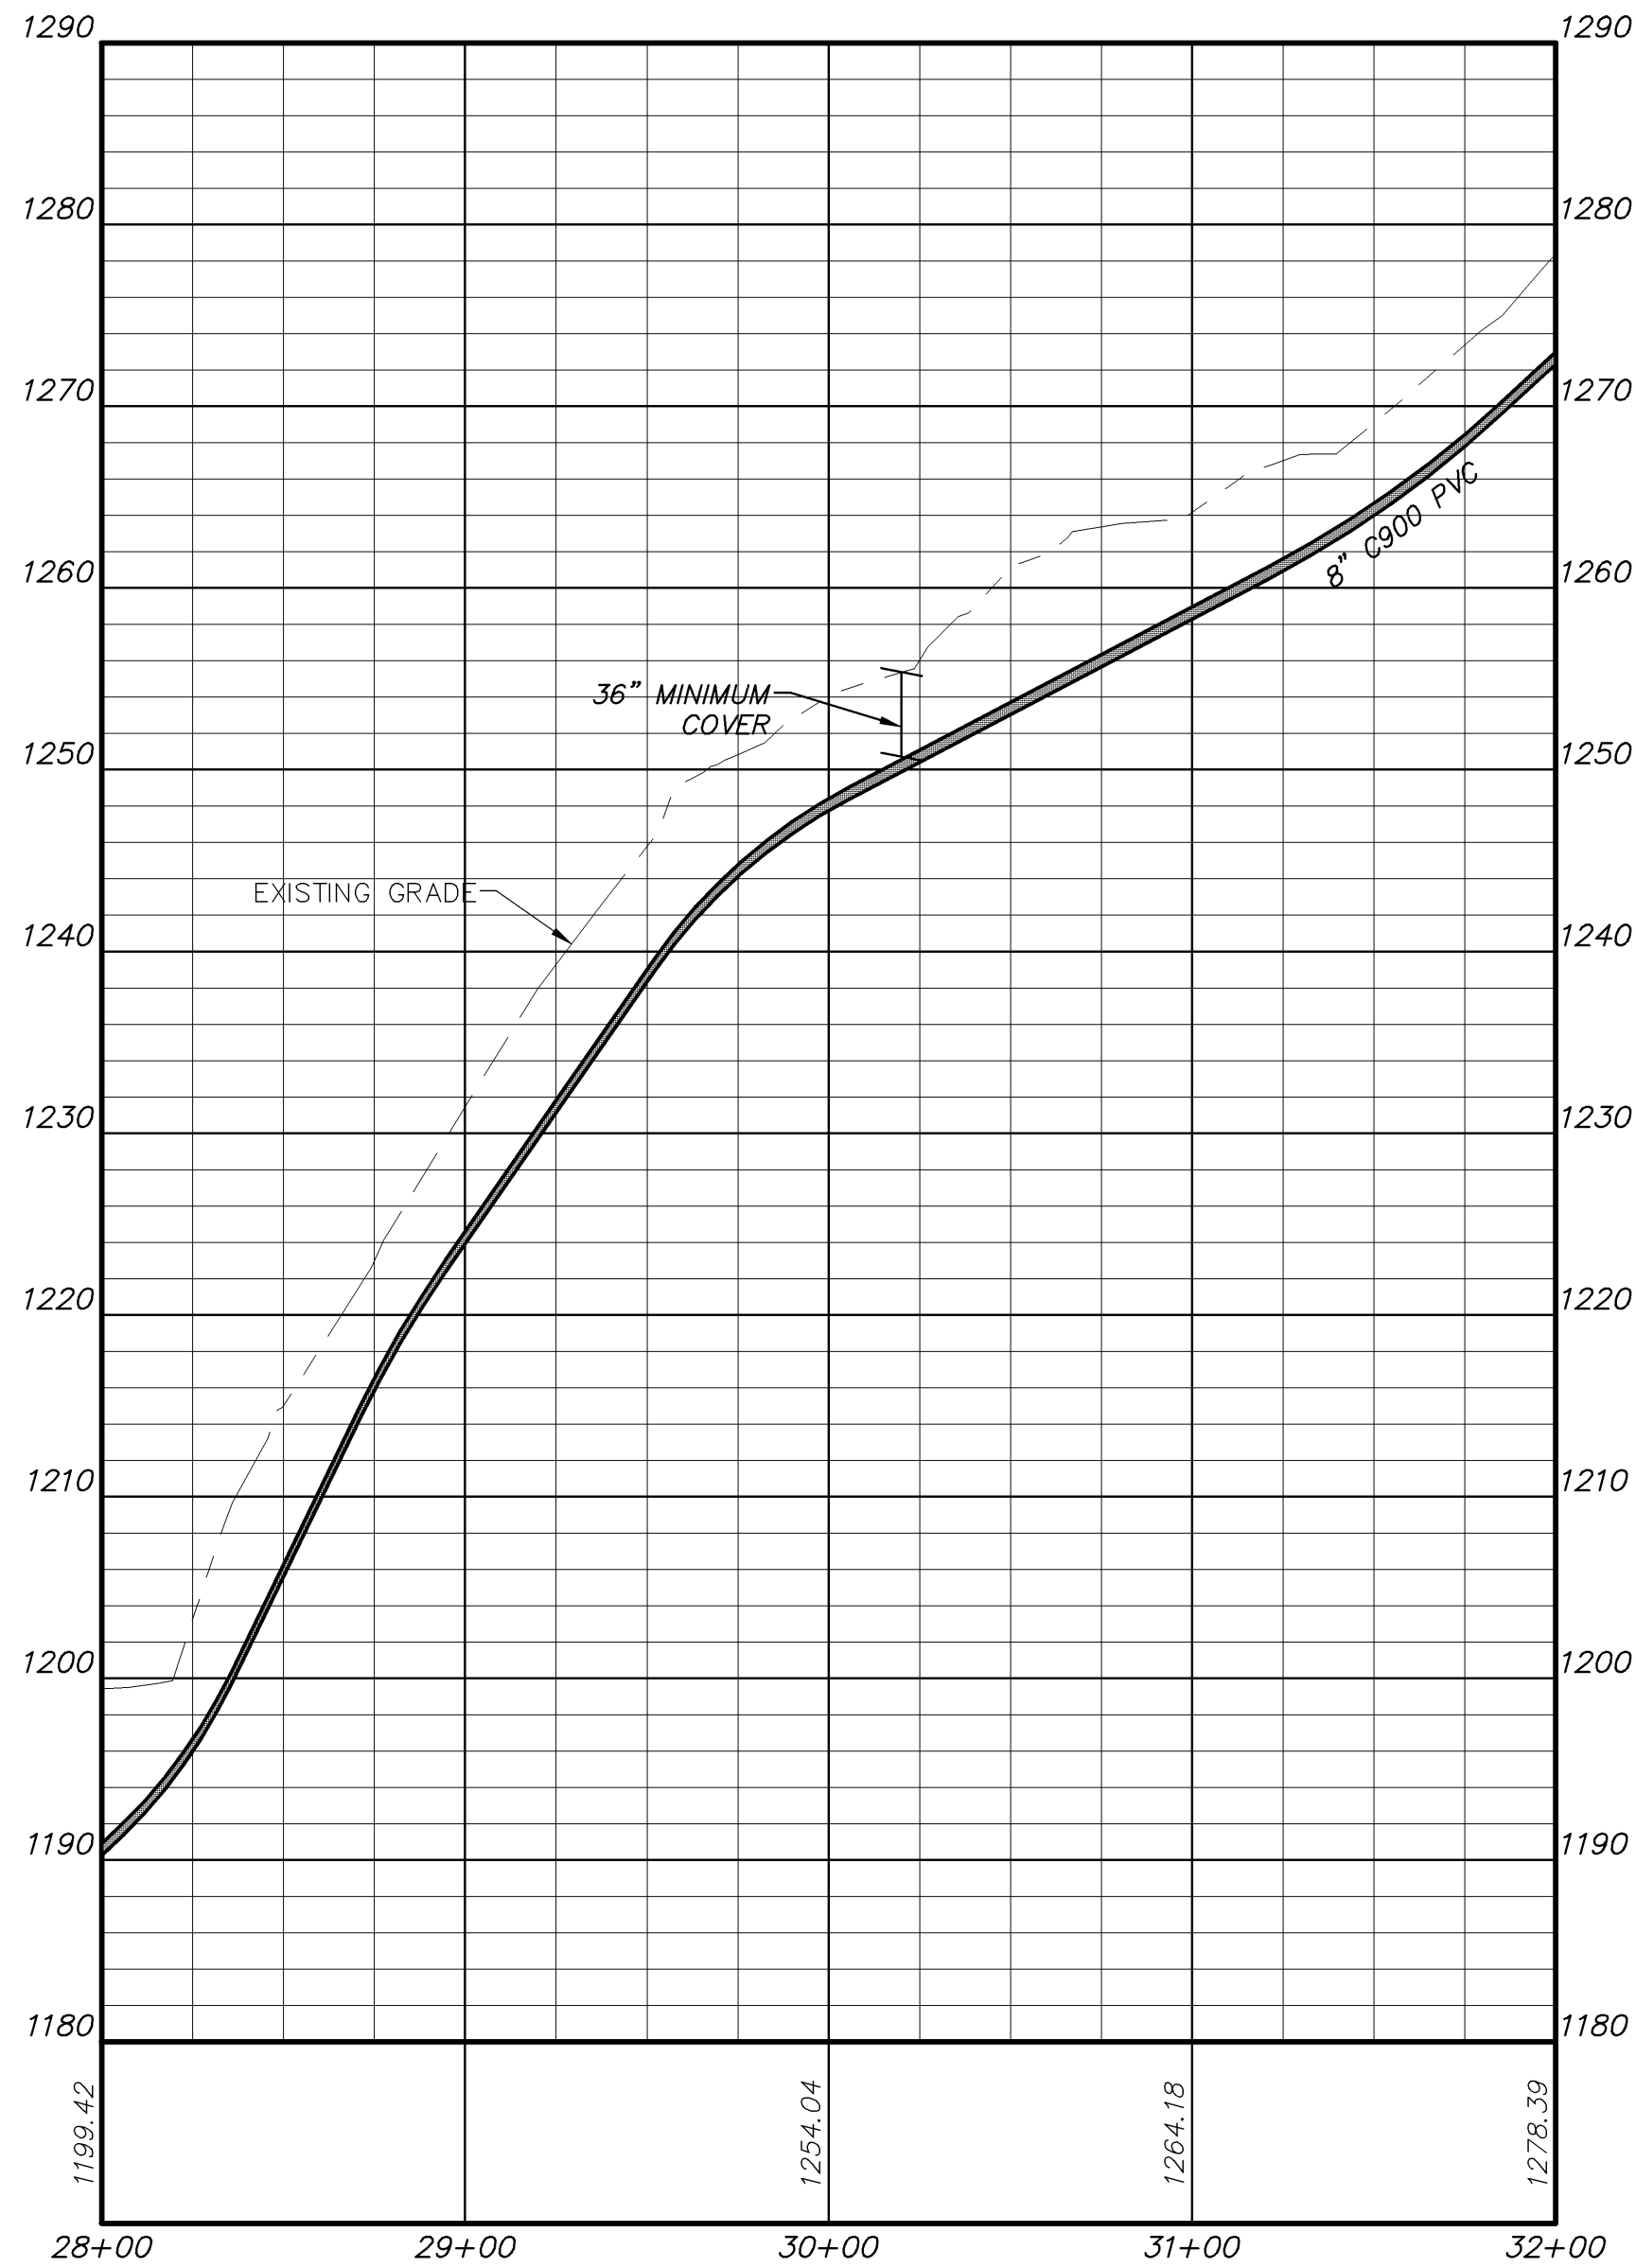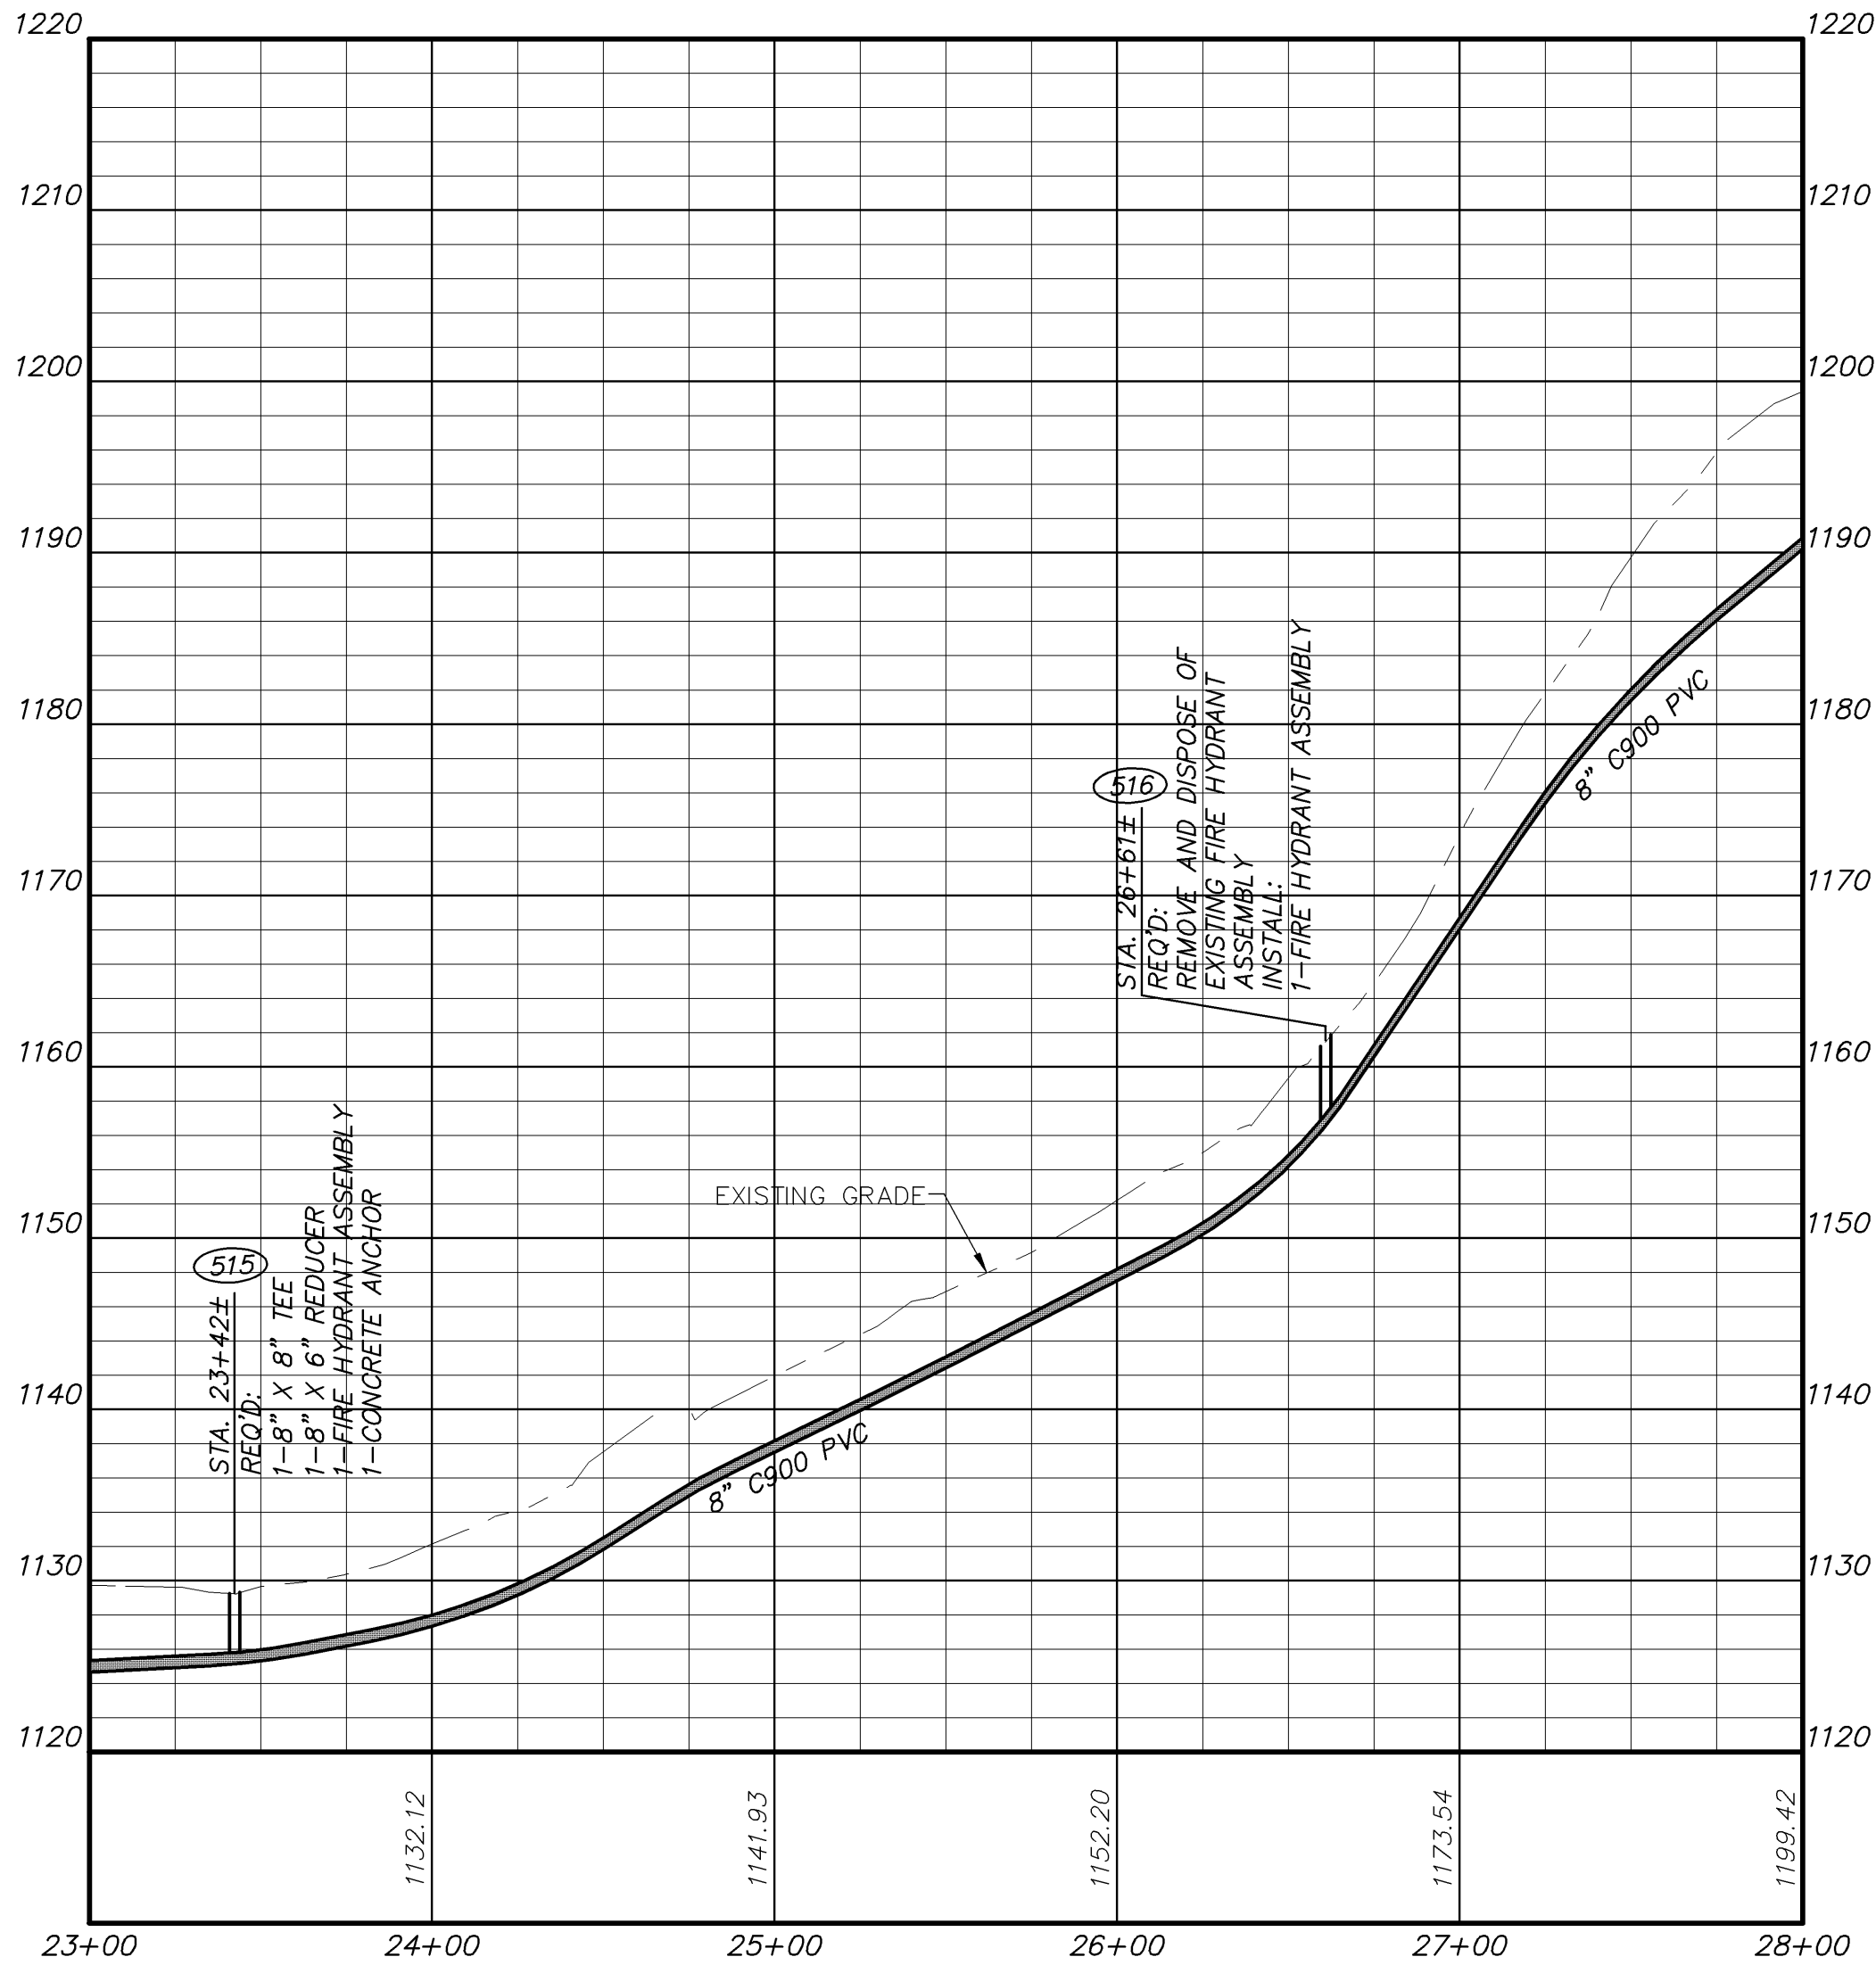

1	8/28/09	VDH COMMENTS
2	9/3/09	OWNER COMMENTS
4	3/14/12	ASBUILTS

\*ENGINEERING >> SURVEYING >> PLANNING

**HURT & PROFFITT**  
INCORPORATED

2524 LANGHORNE ROAD  
LYNCHBURG VA 24501  
800.242.4906 TOLL FREE  
434.847.7796 MAIN  
434.847.0047 FAX





**STA. 23+00 - 32+00± WINDING WAY-ASBUILT**  
**FOR**  
**TOWN OF BOONES MILL WATER SYSTEM REPLACEMENT, VOLUME 1**  
**TOWN OF BOONES MILL, BOONE DISTRICT, FRANKLIN COUNTY, VA**

PROJECT NO. 20080815  
G.L. NO. 297-03-A3.9  
FILE NO. G-12675  
DATE: 7/31/09  
DRAWN BY: WCH  
CHECKED BY: BLC


**HURT & PROFFITT**

SHEET NO.  
**WL-500.01**


Mar 14, 2012 - 10:32am V:\LandProjects\20080815\dwg\asbults-WL-ASBULT-P-Water.dwg

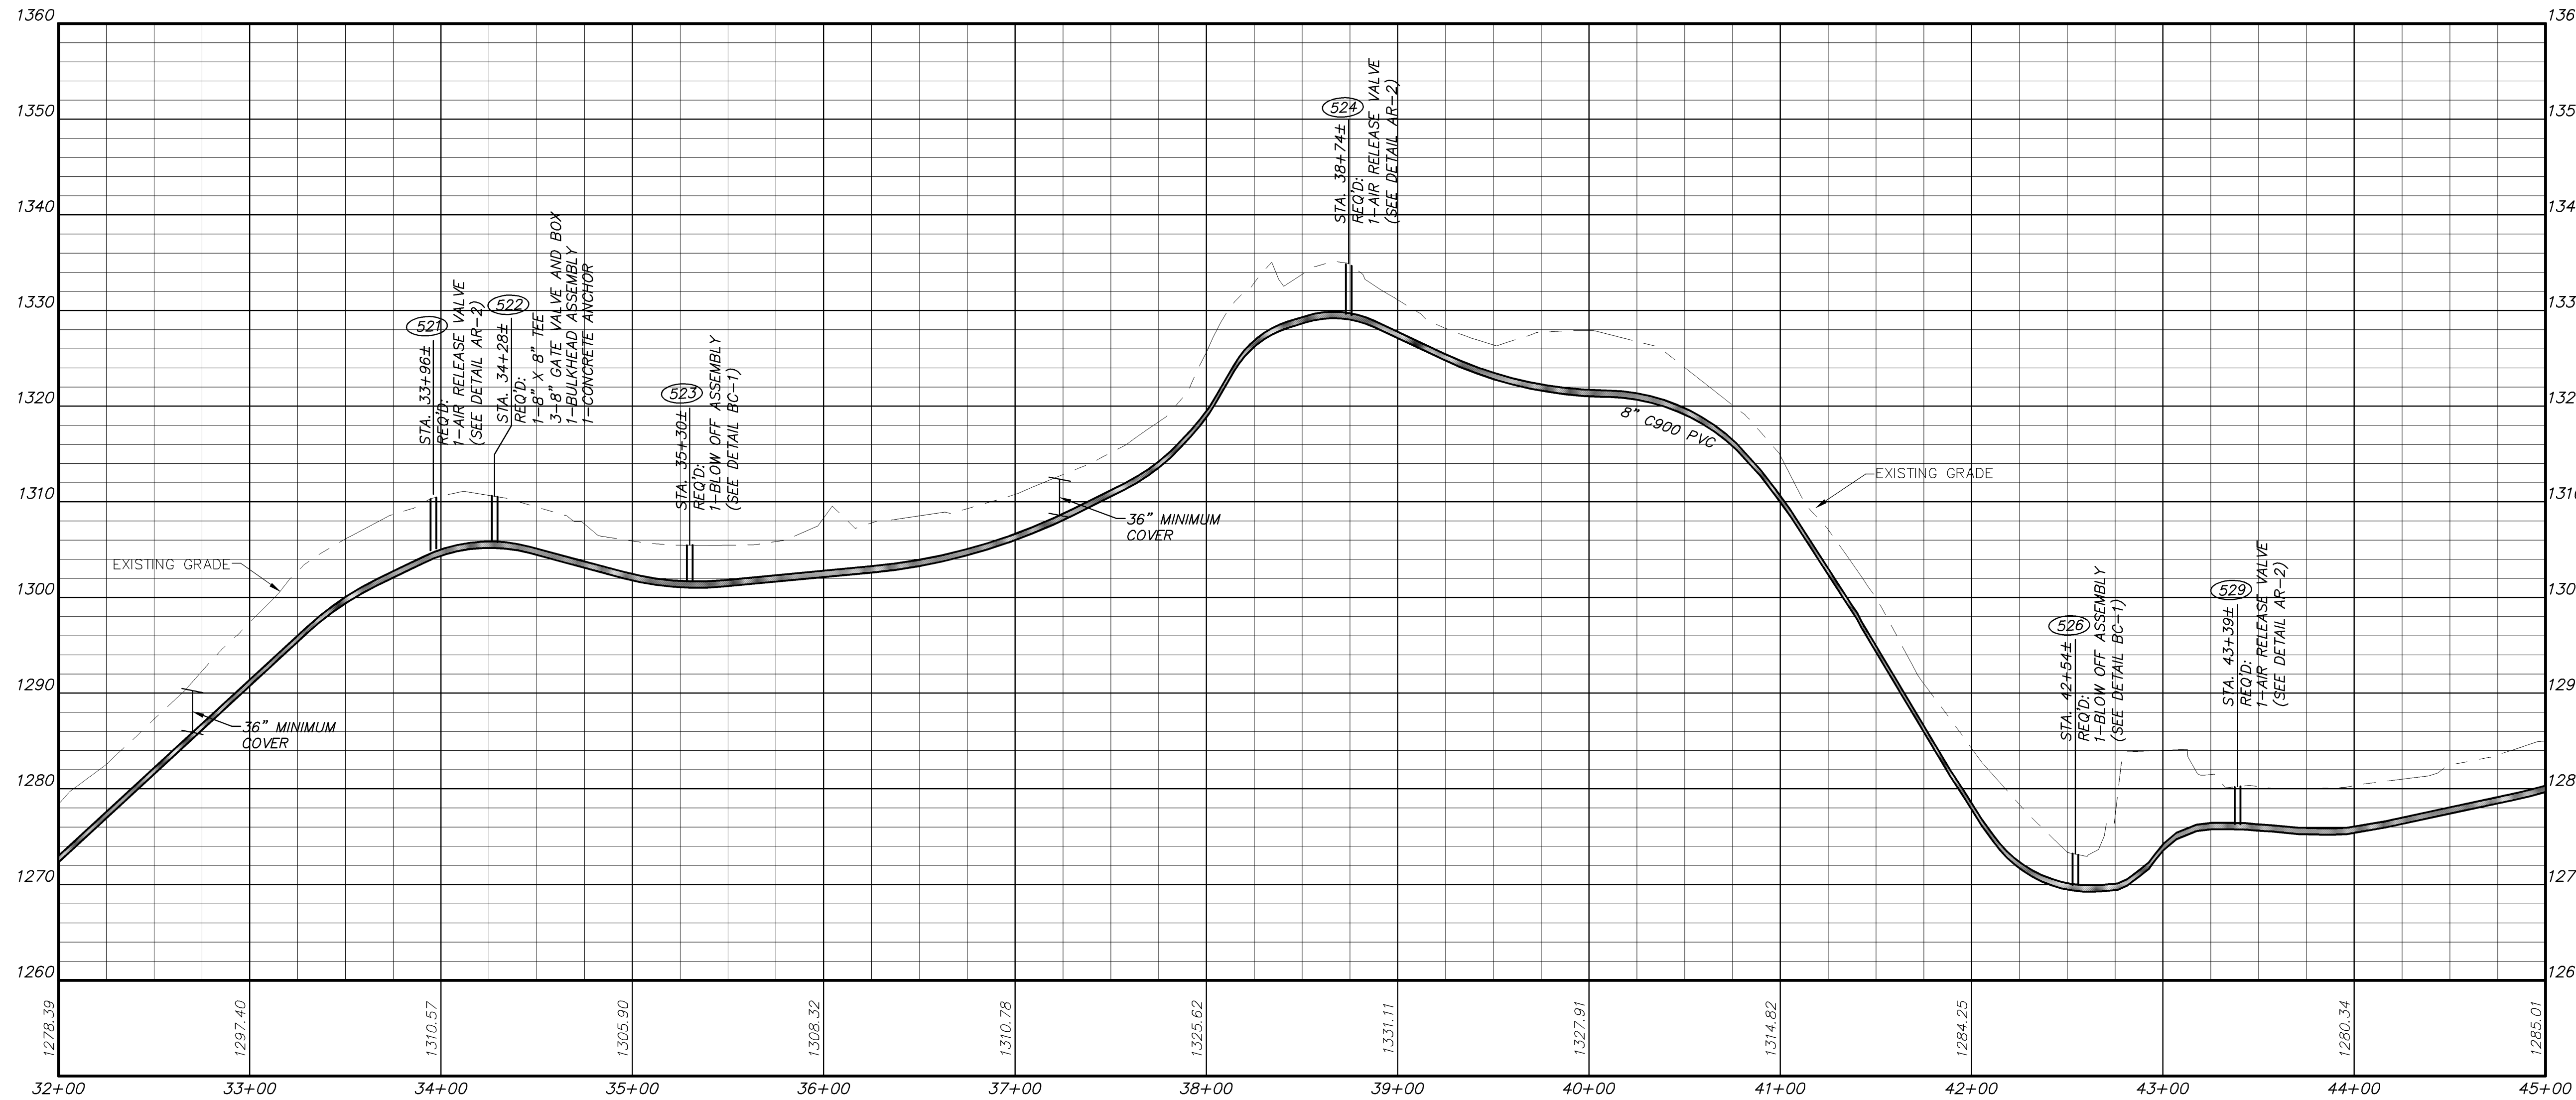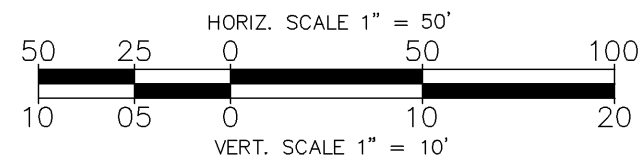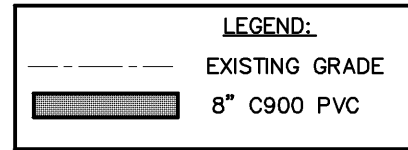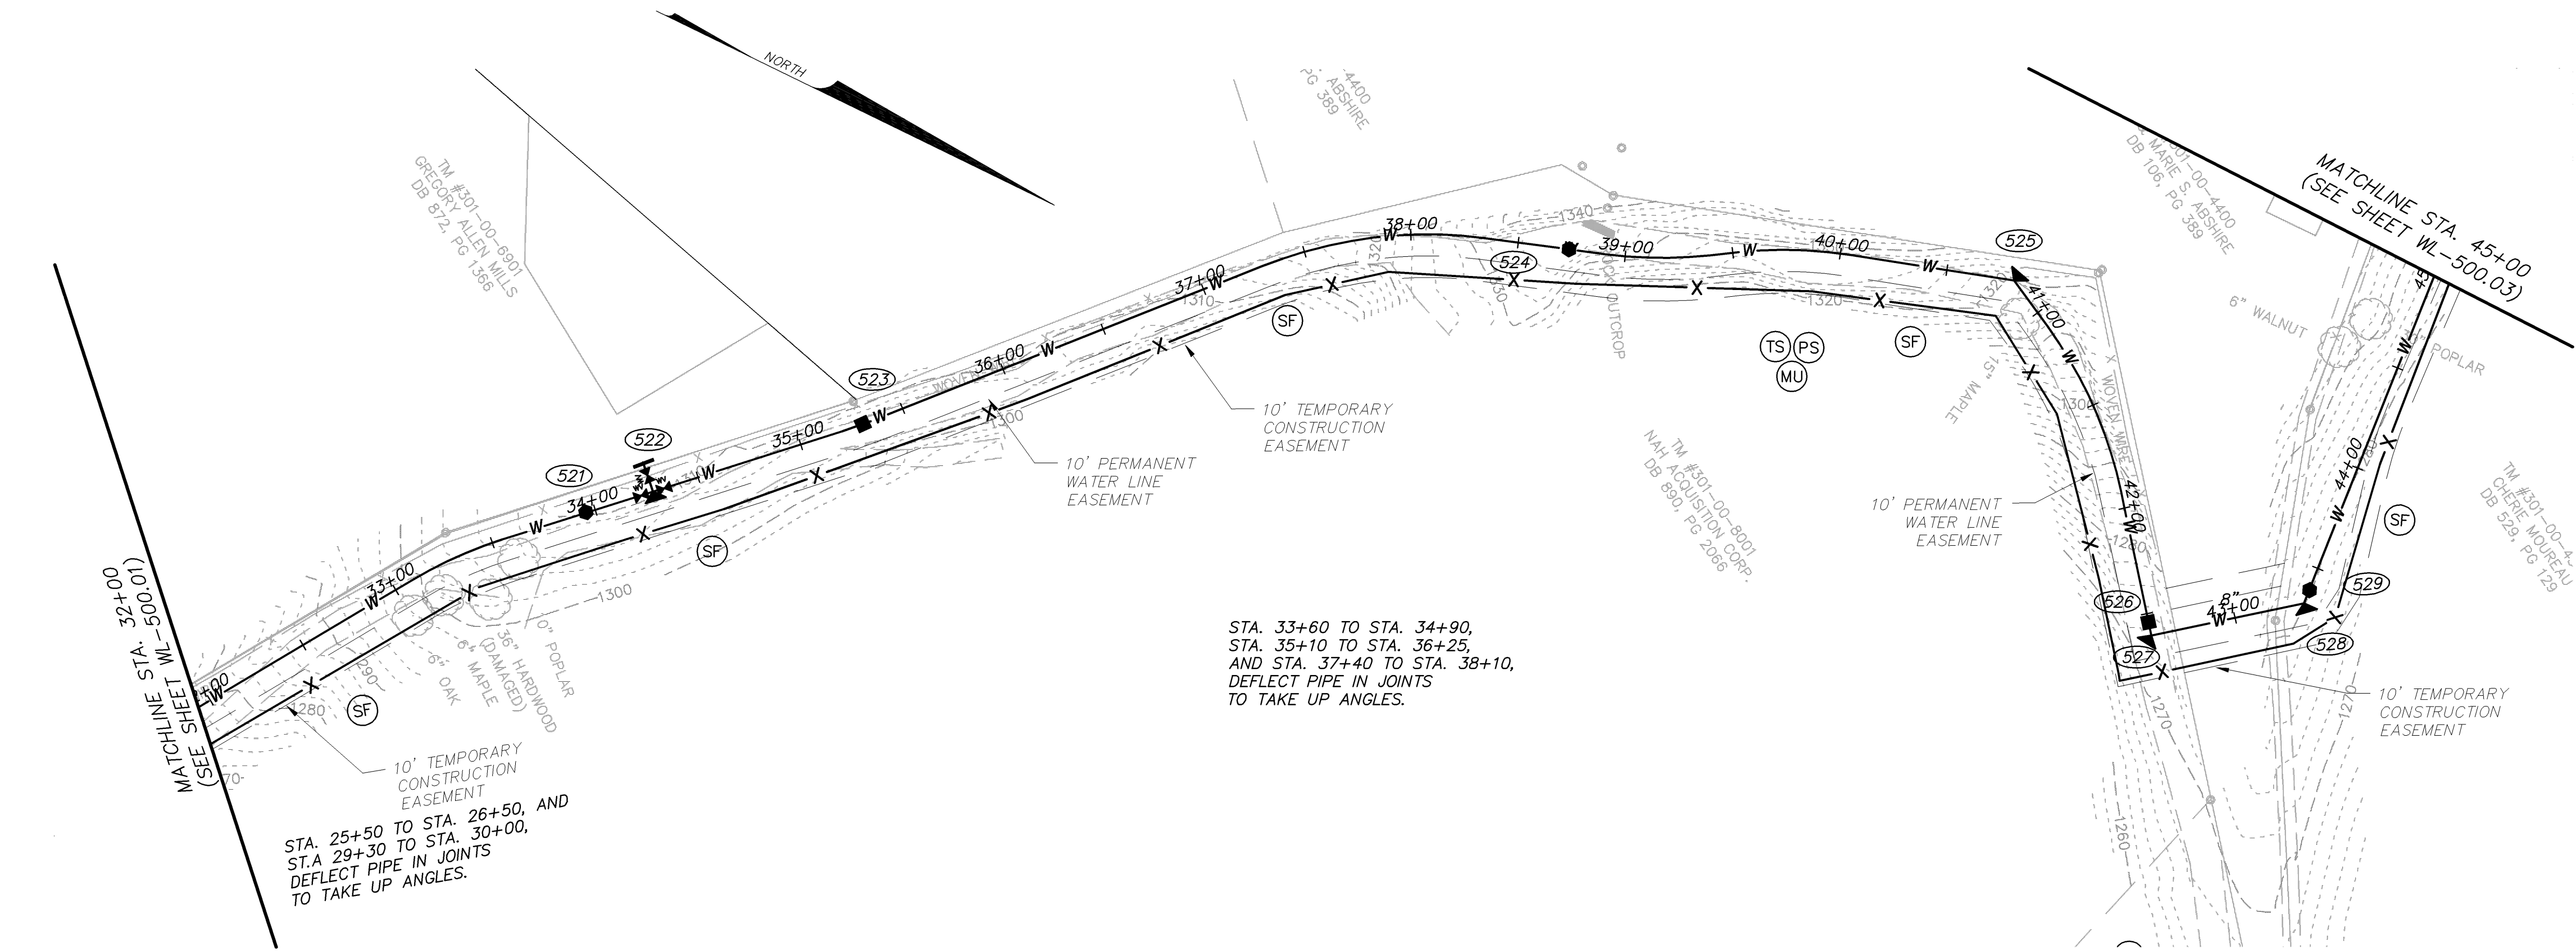

EXISTING LEGEND

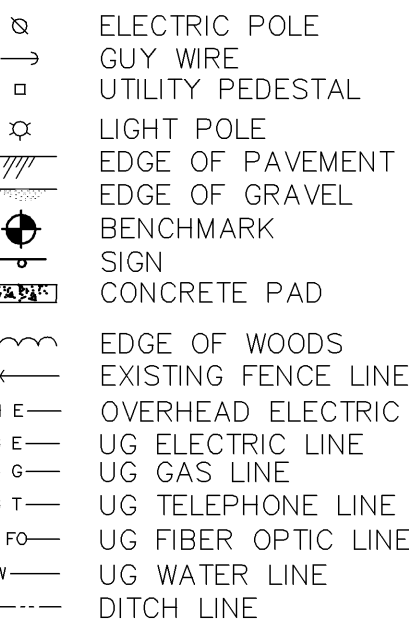


PROPOSED LEGEND

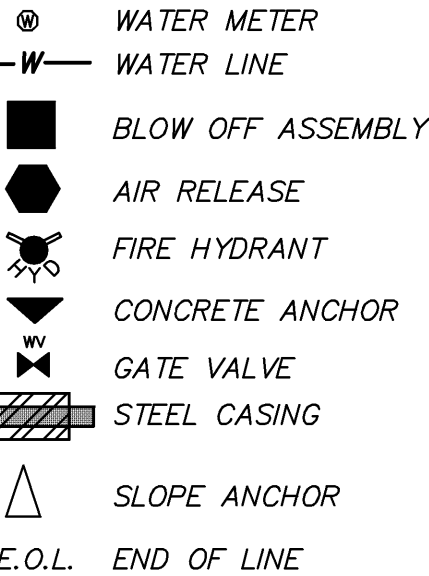

WATER LINE STRUCTURE SCHEDULE

- (521) STA. 33+96±  
REQ'D:  
1-AIR RELEASE VALVE  
(SEE DETAIL AR-2)
- (522) STA. 34+28±  
REQ'D:  
1-8" X 8" TEE  
3-8" GATE VALVE AND BOX  
1-BULKHEAD ASSEMBLY  
1-CONCRETE ANCHOR  
CONTRACTOR TO COORDINATE EXACT LOCATION OF TEE WITH TOWN
- (523) STA. 35+30±  
REQ'D:  
1-BLOW OFF ASSEMBLY  
(SEE DETAIL BC-1)
- (524) STA. 38+74±  
REQ'D:  
1-AIR RELEASE VALVE  
(SEE DETAIL AR-2)
- (525) STA. 40+81±  
REQ'D:  
1-8" 45° BEND  
1-CONCRETE ANCHOR
- (526) STA. 42+54±  
REQ'D:  
1-BLOW OFF ASSEMBLY  
(SEE DETAIL BC-1)
- (527) STA. 42+61±  
REQ'D:  
1-8" 90° BEND  
1-CONCRETE ANCHOR
- (528) STA. 43+33±  
REQ'D:  
1-8" 45° BEND  
1-CONCRETE ANCHOR
- (529) STA. 43+39±  
REQ'D:  
1-AIR RELEASE VALVE  
(SEE DETAIL AR-2)

\*ENGINEERING & SURVEYING >> PLANNING

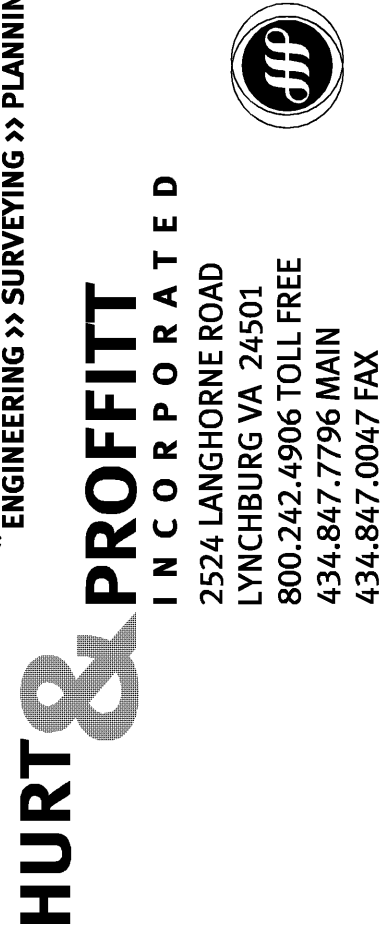

STA. 32+00 - 45+00± WINDING WAY-ASBUILT  
FOR  
TOWN OF BOONES MILL WATER SYSTEM REPLACEMENT, VOLUME 1  
TOWN OF BOONES MILL, BOONE DISTRICT, FRANKLIN COUNTY, VA

PROJECT NO.	20080815
G.L. NO.	297-03-A3.9
FILE NO.	G-12675
DATE:	7/31/09
DRAWN BY:	WCH
CHECKED BY:	BLC



HURT & PROFFITT

SHEET NO.  
WL-500.02

1	8/28/09	VDH COMMENTS
2	9/3/09	OWNER COMMENTS
4	3/14/12	ASBULTS



Mar 14, 2012 - 10:33am V:\LandProjects\20080815\dwg\Asbults-WL-500-03-Water.dwg

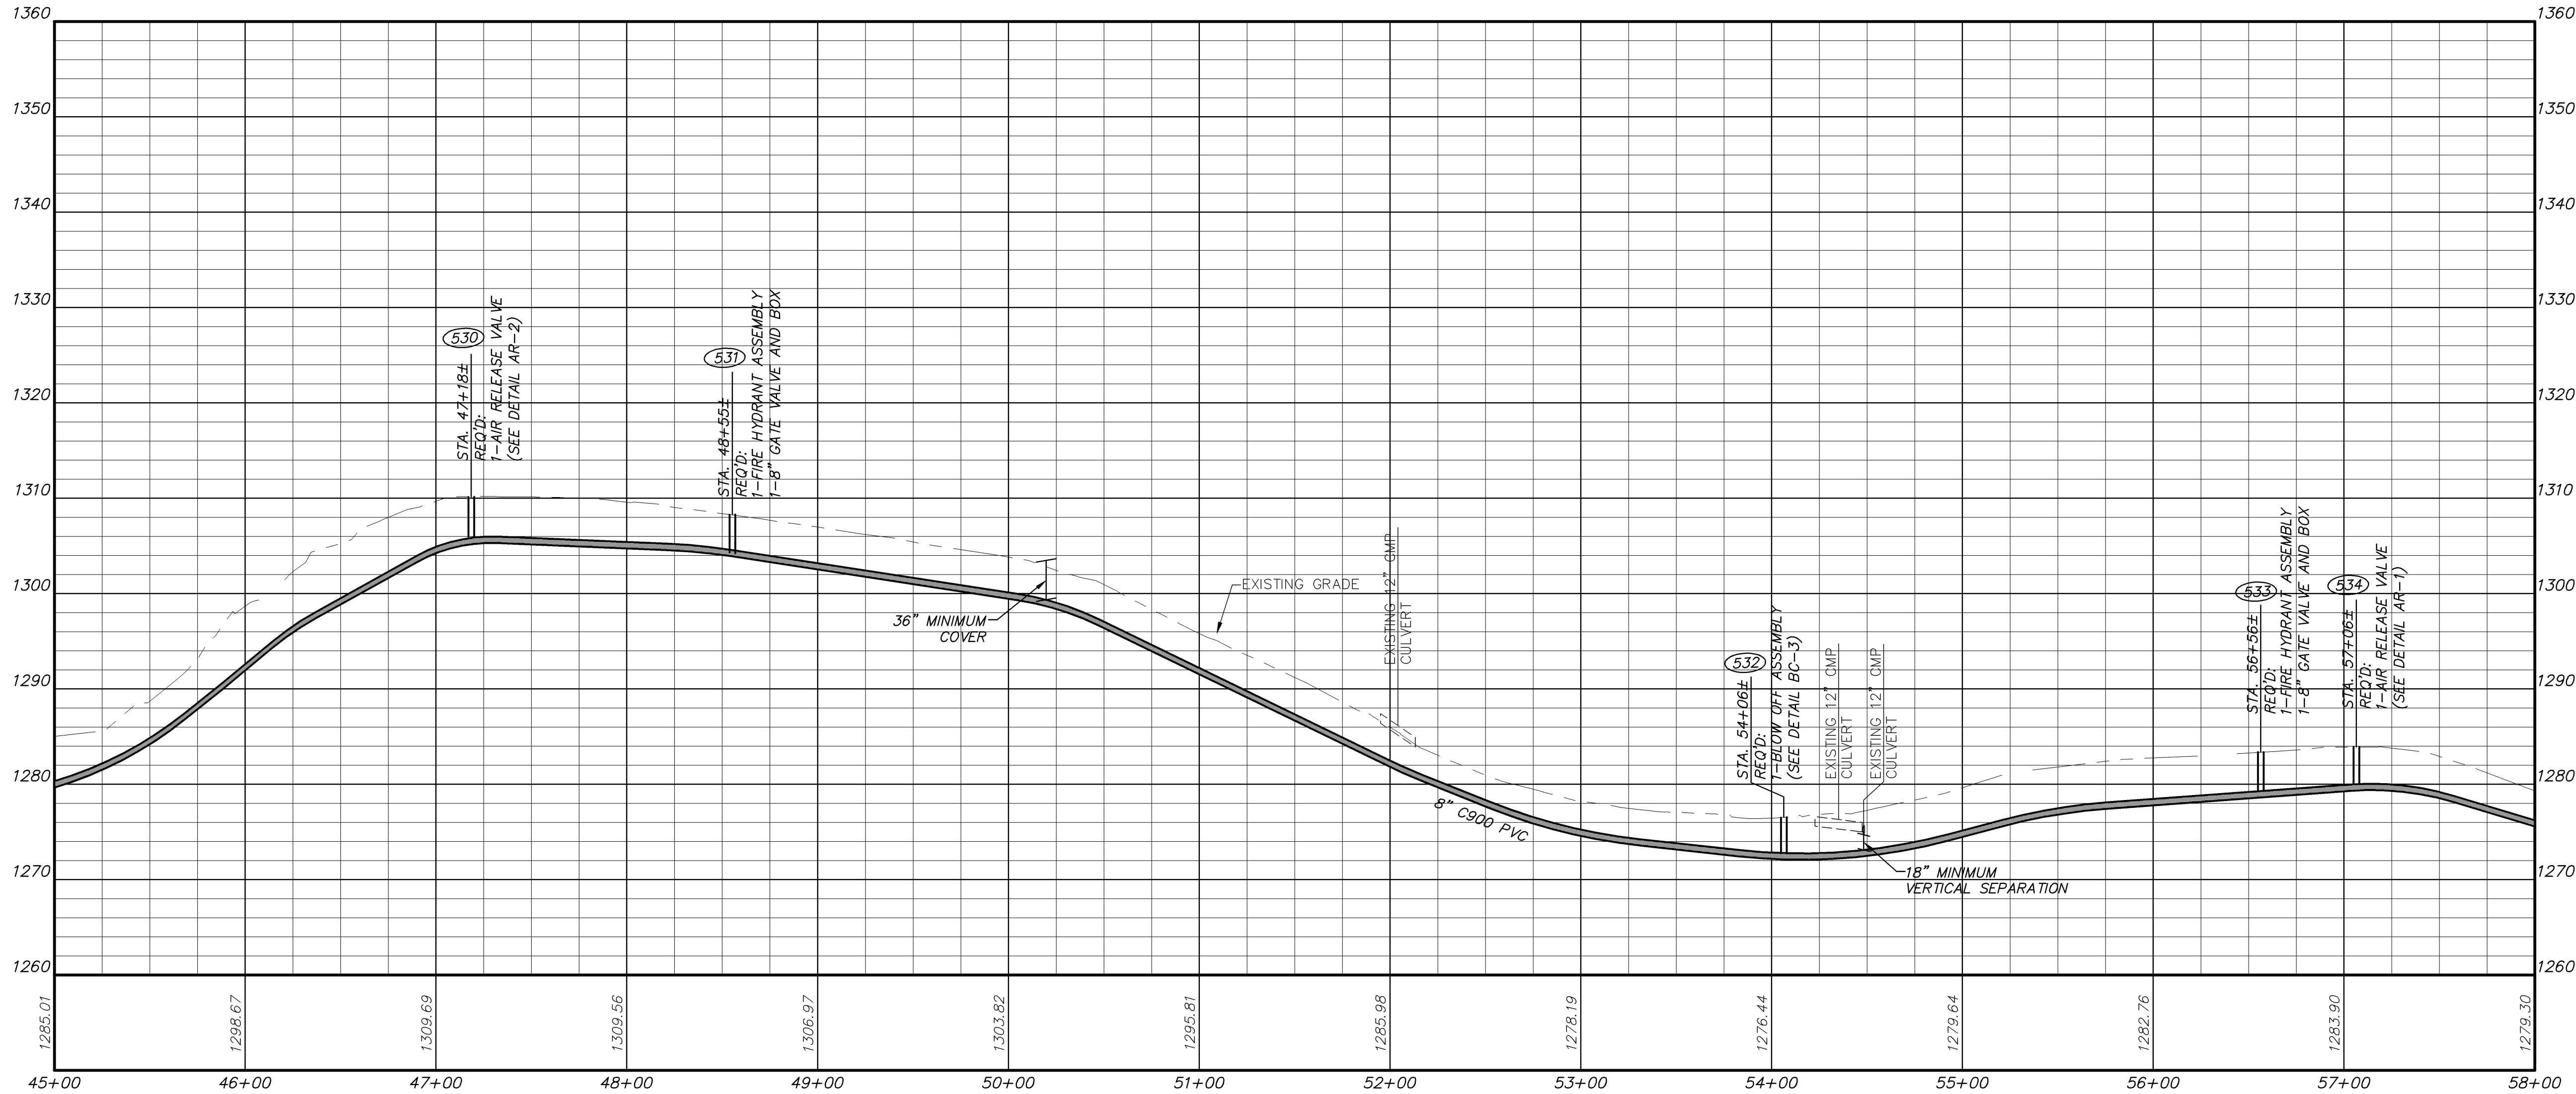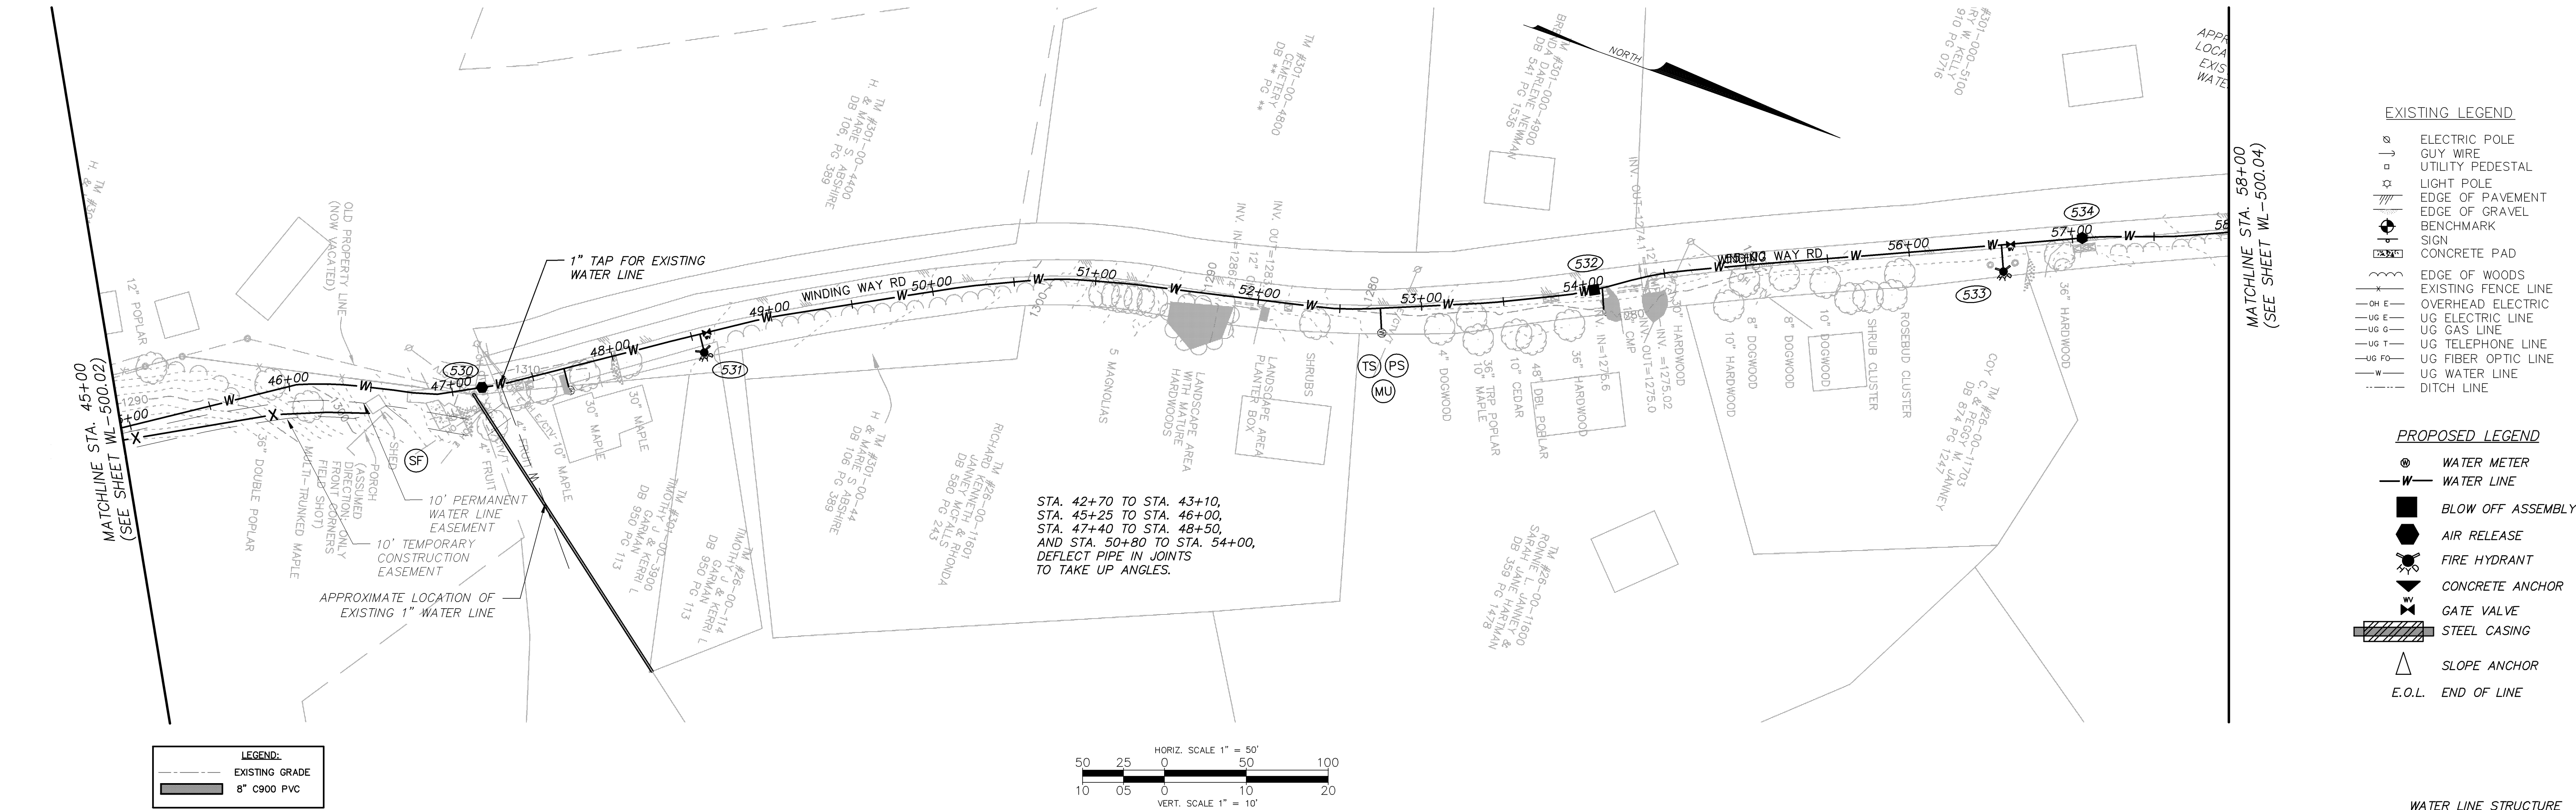

#### EXISTING LEGEND

- ELECTRIC POLE
- GUY WIRE
- UTILITY PEDESTAL
- LIGHT POLE
- EDGE OF PAVEMENT
- EDGE OF GRAVEL
- BENCHMARK
- SIGN
- CONCRETE PAD
- EDGE OF WOODS
- EXISTING FENCE LINE
- OVERHEAD ELECTRIC
- UG ELECTRIC LINE
- UG GAS LINE
- UG TELEPHONE LINE
- UG FIBER OPTIC LINE
- UG WATER LINE
- DITCH LINE

#### PROPOSED LEGEND

- WATER METER
- WATER LINE
- BLOW OFF ASSEMBLY
- AIR RELEASE
- FIRE HYDRANT
- CONCRETE ANCHOR
- GATE VALVE
- STEEL CASING
- SLOPE ANCHOR
- E.O.L. END OF LINE

#### WATER LINE STRUCTURE SCHEDULE

- STA. 47+18±  
REQ'D:  
1-AIR RELEASE VALVE  
(SEE DETAIL AR-2)
- STA. 48+55±  
REQ'D:  
1-FIRE HYDRANT ASSEMBLY  
1-8" GATE VALVE AND BOX
- STA. 54+06±  
REQ'D:  
1-BLOW OFF ASSEMBLY  
(SEE DETAIL BC-3)
- STA. 56+56±  
REQ'D:  
1-FIRE HYDRANT ASSEMBLY  
1-8" GATE VALVE AND BOX
- STA. 57+06±  
REQ'D:  
1-AIR RELEASE VALVE  
(SEE DETAIL AR-1)

\*ENGINEERING & SURVEYING >> PLANNING

**HURT & PROFFITT**  
INCORPORATED  
2524 LANGHORNE ROAD  
LYNCHBURG VA 24501  
800.242.6906 TOLL FREE  
434.847.7796 MAIN  
434.847.0047 FAX

## STA. 45+00 - 58+00± WINDING WAY-ASBUILT FOR TOWN OF BOONES MILL WATER SYSTEM REPLACEMENT, VOLUME 1 TOWN OF BOONES MILL, BOONE DISTRICT, FRANKLIN COUNTY, VA


PROJECT NO. 20080815  
G.L. NO. 297-03-A3.9  
FILE NO. G-12675  
DATE: 7/31/09  
DRAWN BY: WCH  
CHECKED BY: BLC

**HURT & PROFFITT**





SHEET NO.  
**WL-500.03**

1	8/28/09	VDH COMMENTS
2	9/3/09	OWNER COMMENTS
4	3/14/12	ASBUILTS

Mar 14, 2012 - 10:34am V:\LandProjects\20080815.dwg\Asbults-WL\_A5BULLT-P-Water.dwg

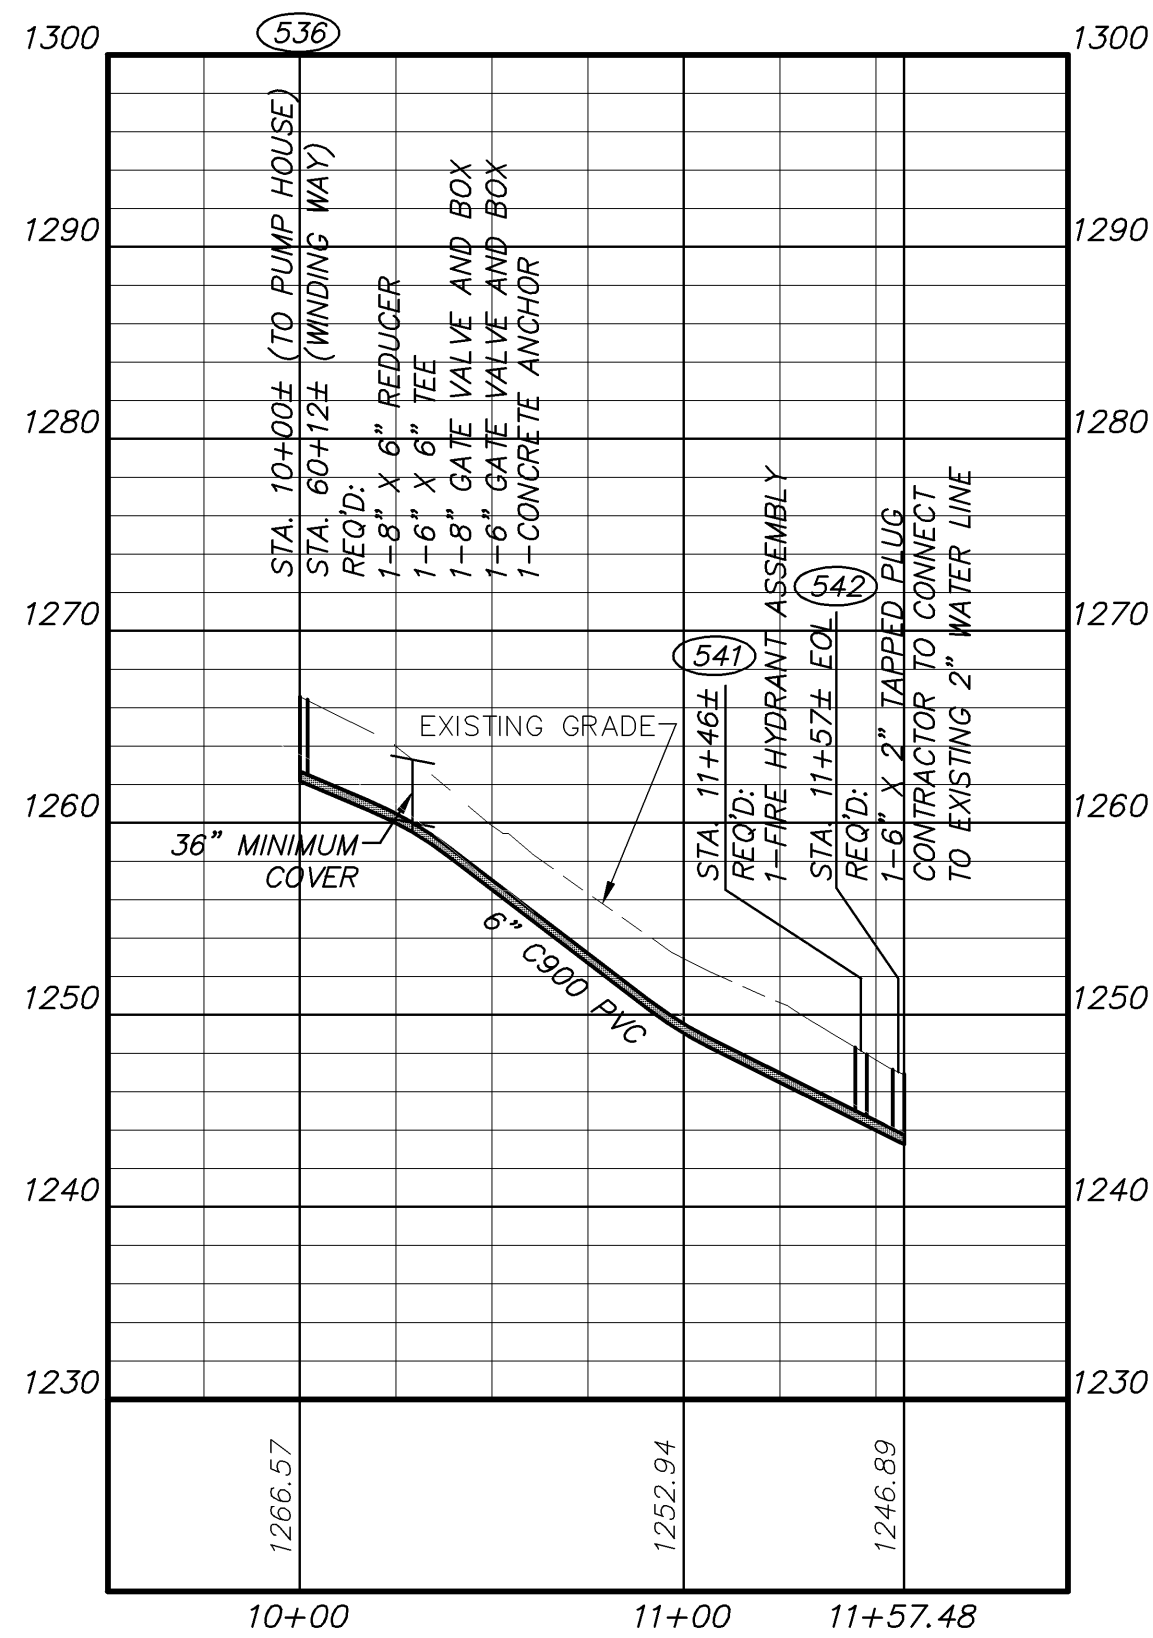

LINE TO PUMP HOUSE

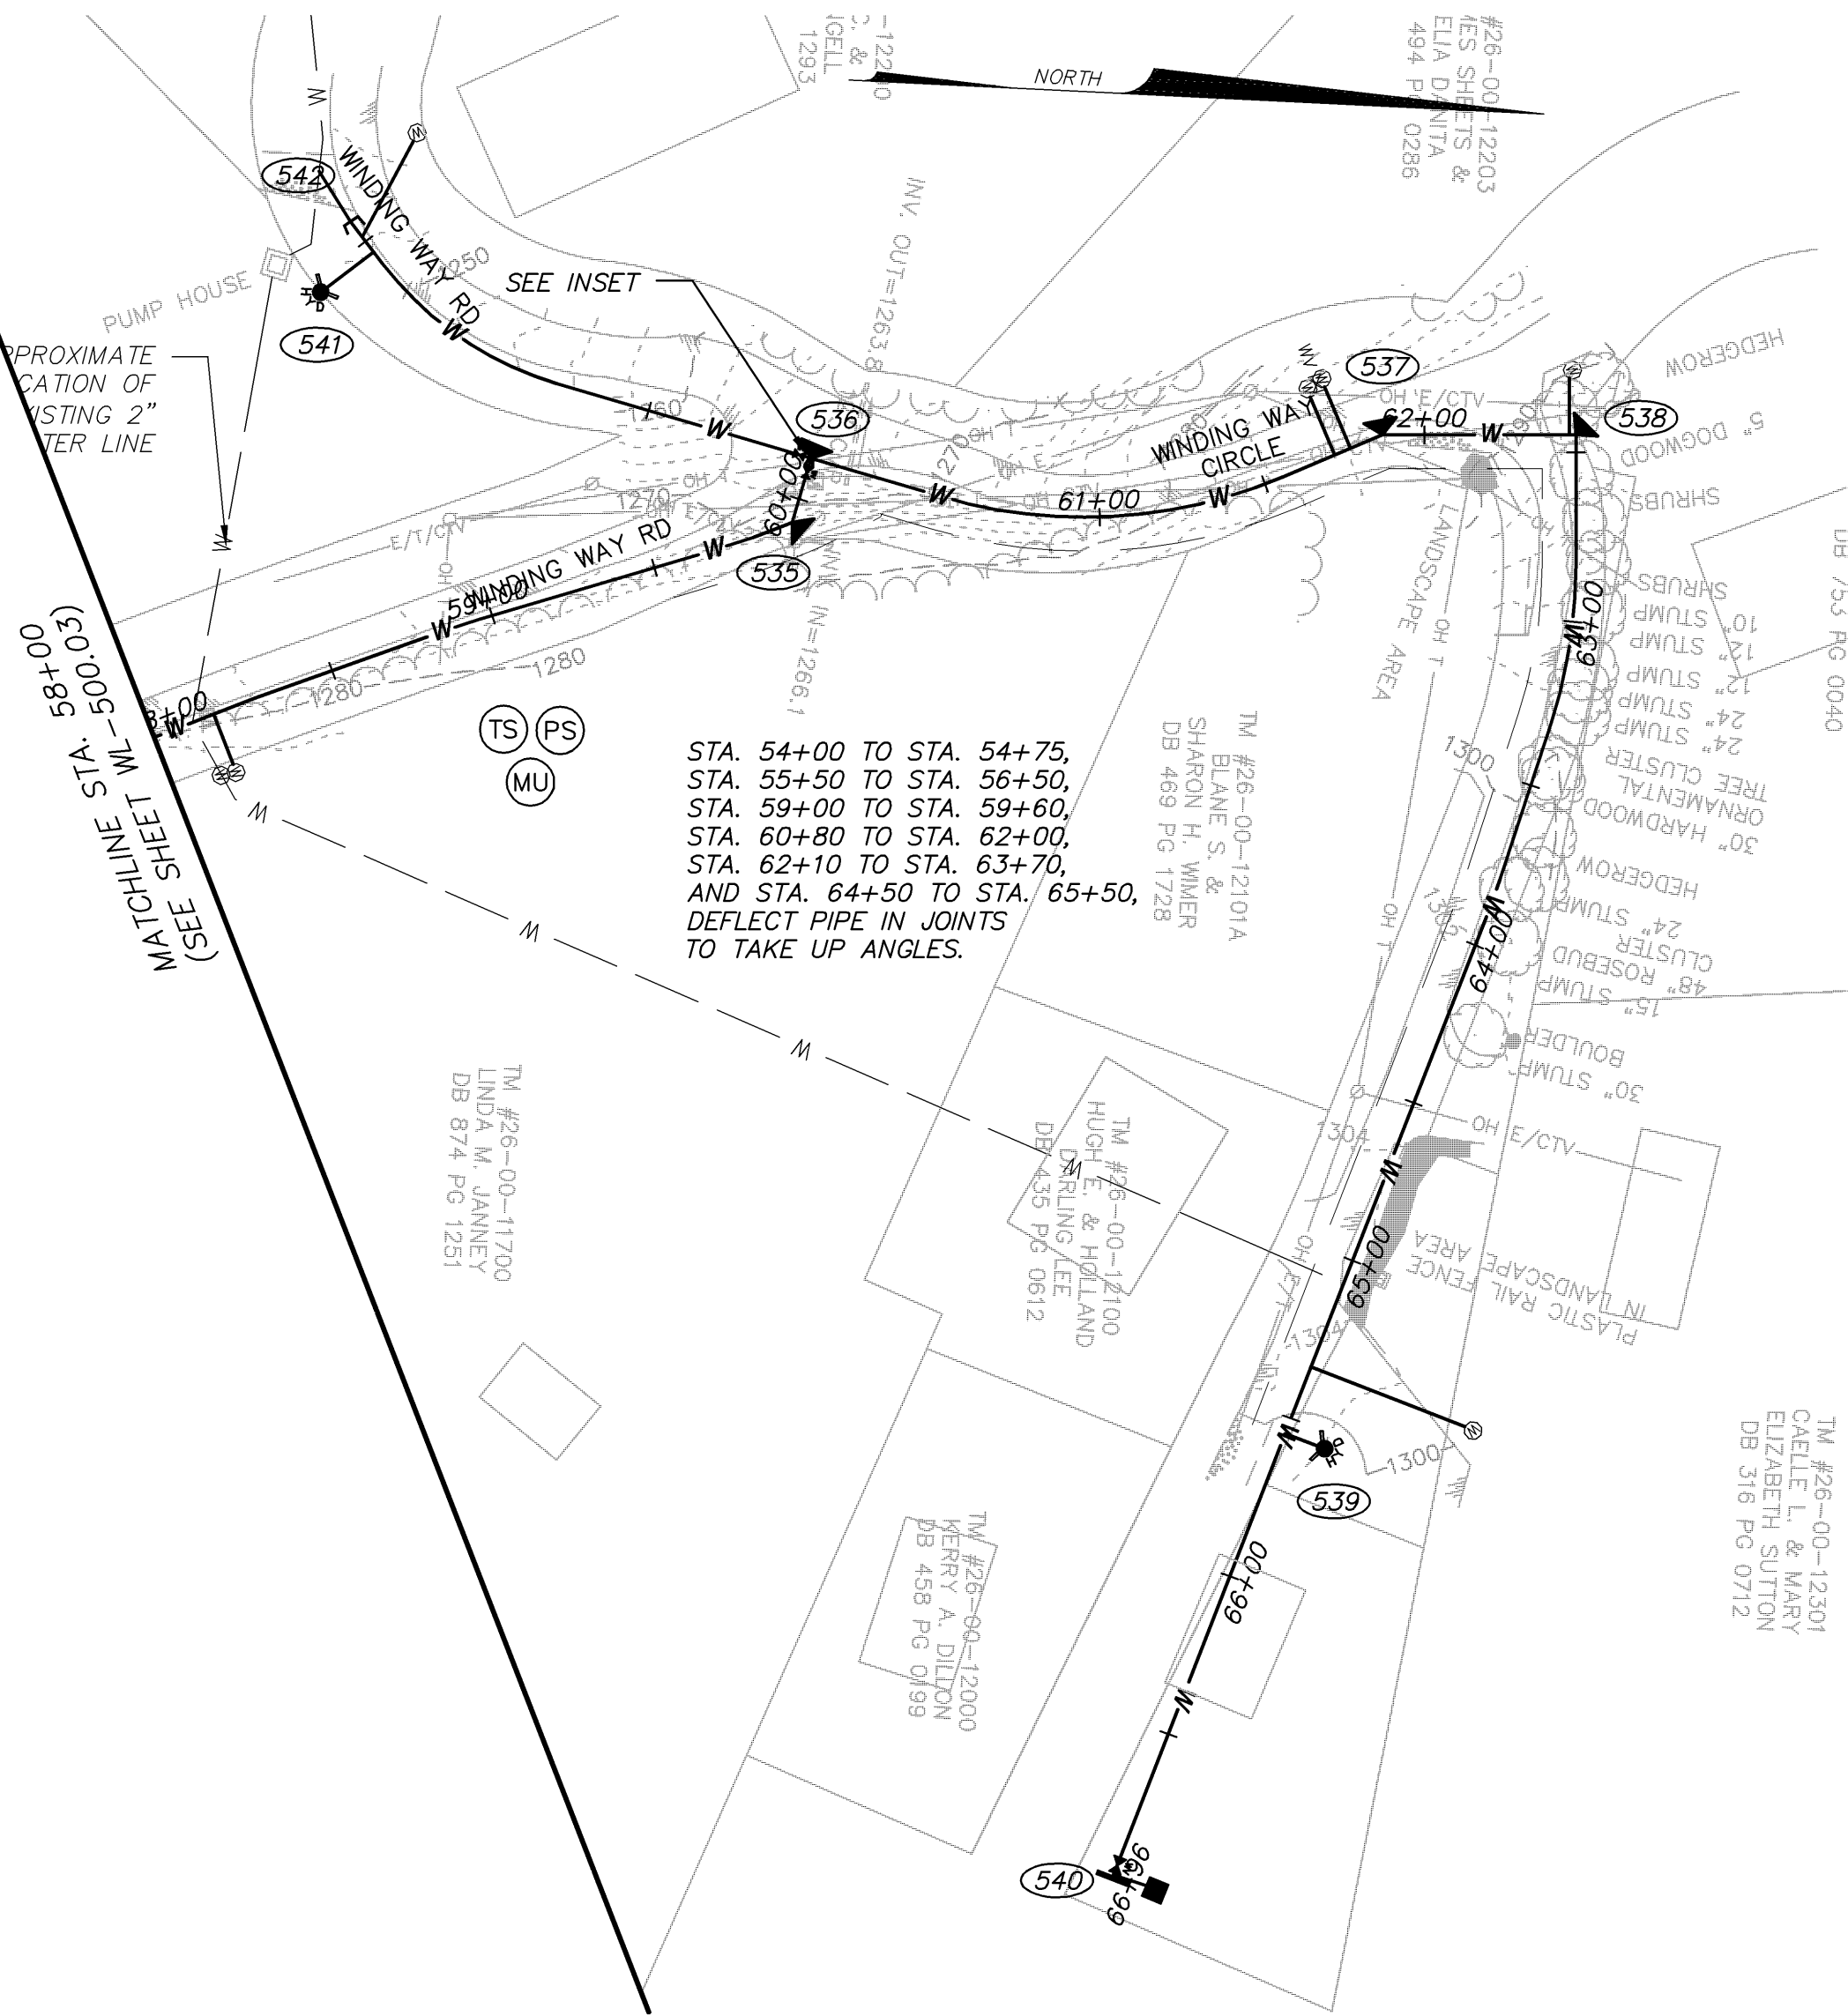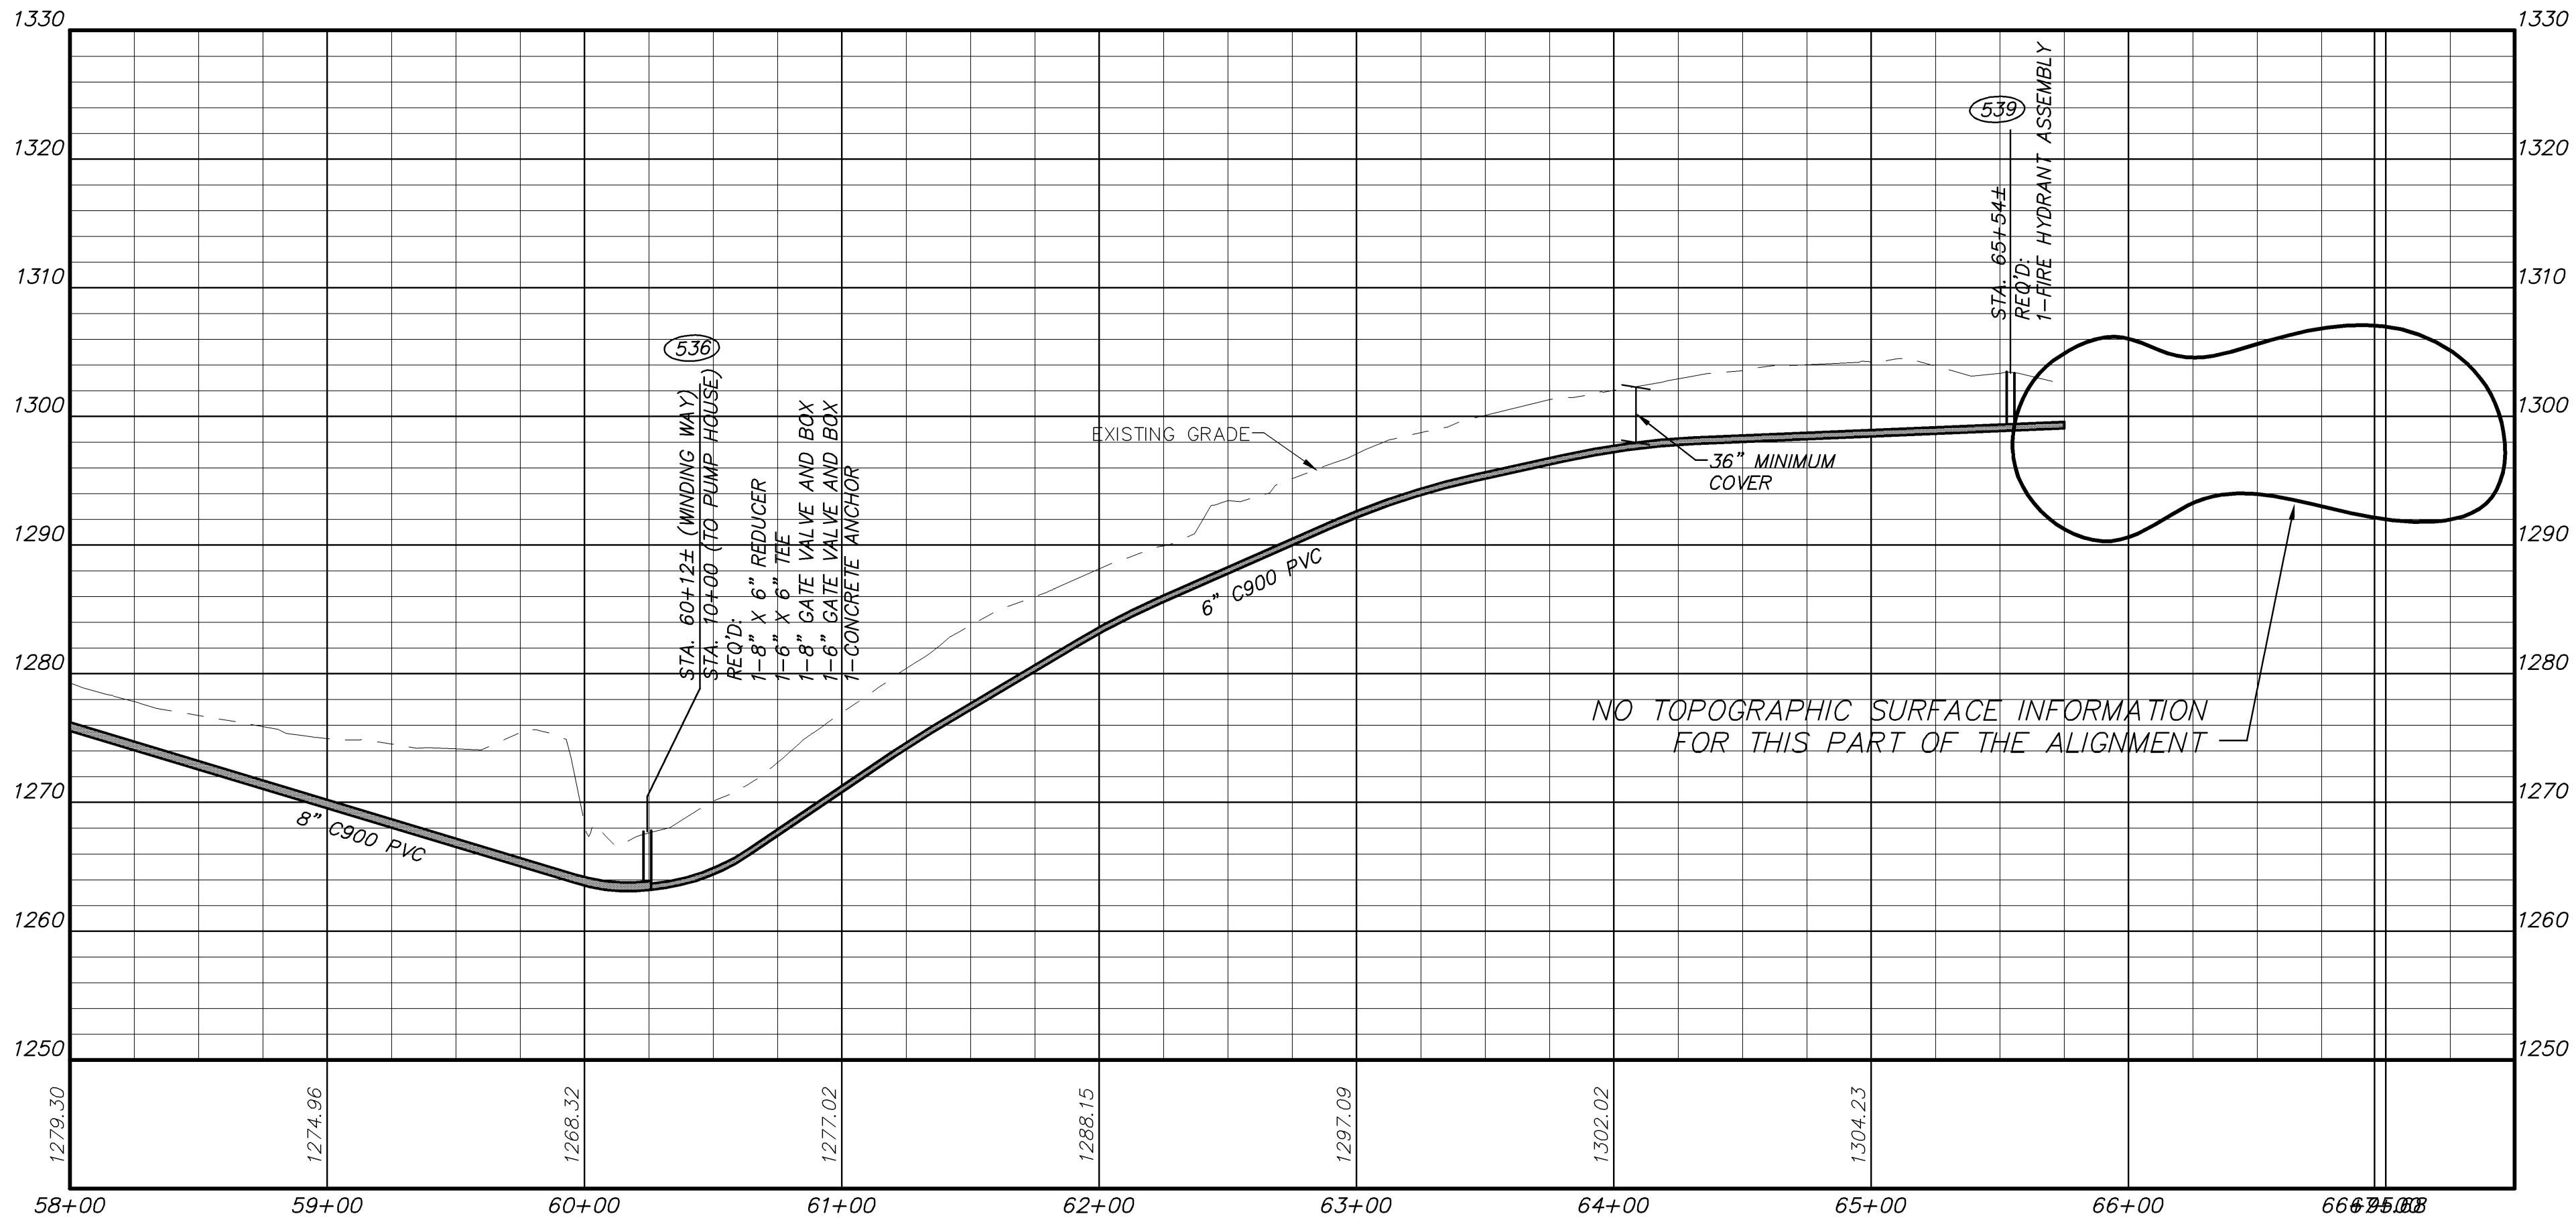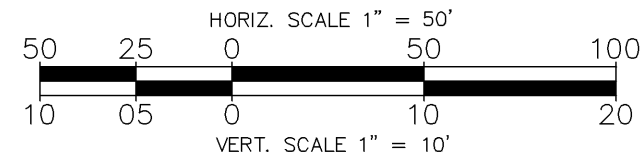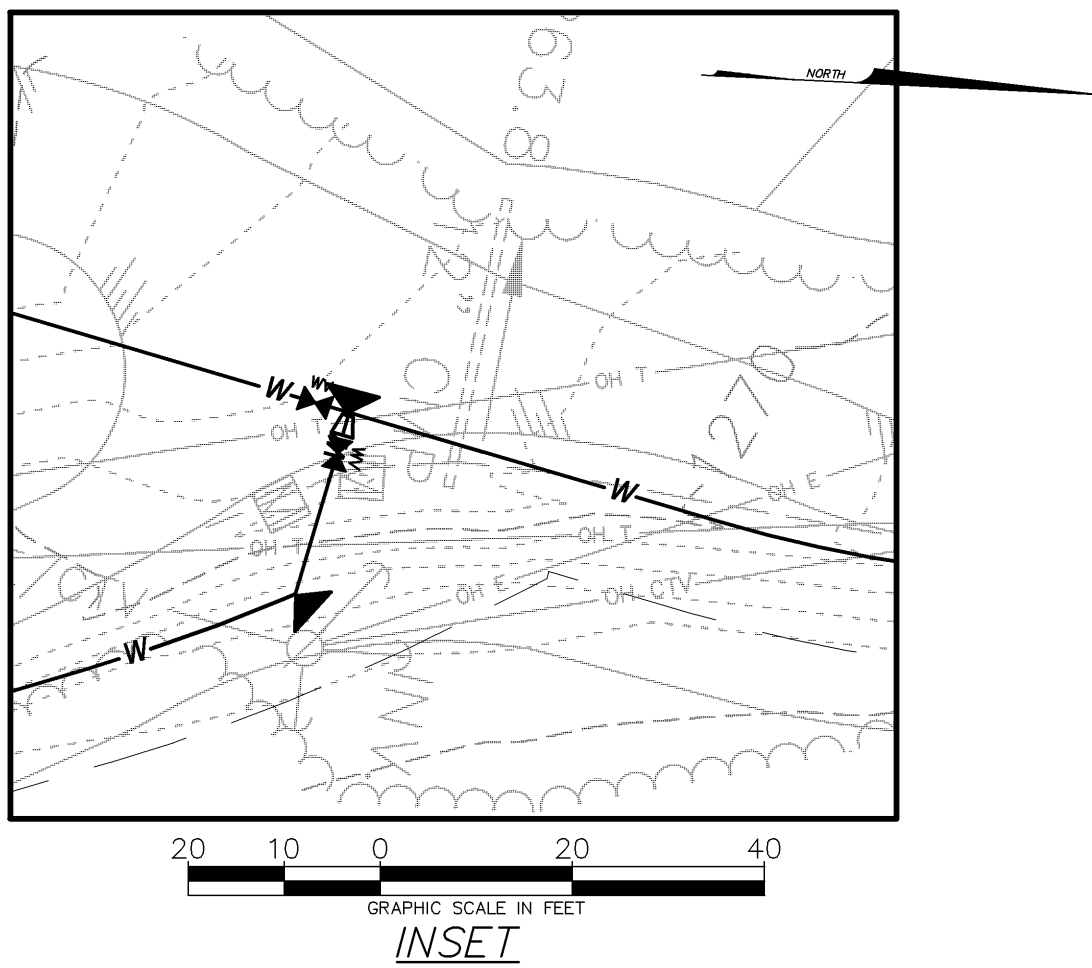

PROPOSED LEGEND		EXISTING LEGEND	
	WATER METER		ELECTRIC POLE
	WATER LINE		GUY WIRE
	BLOW OFF ASSEMBLY		UTILITY PEDESTAL
	AIR RELEASE		LIGHT POLE
	FIRE HYDRANT		EDGE OF PAVEMENT
	CONCRETE ANCHOR		EDGE OF GRAVEL
	GATE VALVE		BENCHMARK
	STEEL CASING		SIGN
	SLOPE ANCHOR		CONCRETE PAD
	E.O.L. END OF LINE		EDGE OF WOODS
			EXISTING FENCE LINE
			OVERHEAD ELECTRIC
			UG ELECTRIC LINE
			UG GAS LINE
			UG TELEPHONE LINE
			UG FIBER OPTIC LINE
			UG WATER LINE
			DITCH LINE

WATER LINE STRUCTURE SCHEDULE	
536	STA. 59+92± REQ'D: 1-8" 45° BEND 1-8" 22.5° BEND 2-CONCRETE ANCHOR
536	STA. 60+12± (WINDING WAY) STA. 10+00 (LINE TO PUMP HOUSE) REQ'D: 1-8" X 6" REDUCER 1-6" X 6" TEE 1-8" GATE VALVE AND BOX 1-6" GATE VALVE AND BOX 1-CONCRETE ANCHOR
537	STA. 61+87± REQ'D: 1-6" 22.5° BEND 1-CONCRETE ANCHOR
538	STA. 62+45± REQ'D: 1-6" 90° BEND 1-CONCRETE ANCHOR
539	STA. 65+54± REQ'D: 1-FIRE HYDRANT ASSEMBLY
540	STA. 66+96± EOL (WINDING WAY) REQ'D: 1-6" GATE VALVE AND BOX 1-BLOW OFF ASSEMBLY
541	STA. 11+46± (LINE TO PUMP HOUSE) REQ'D: 1-FIRE HYDRANT ASSEMBLY
542	STA. 11+57± EOL (LINE TO PUMP HOUSE) REQ'D: 1-6" X 2" TAPPED PLUG CONTRACTOR TO CONNECT TO EXISTING 2" WATER LINE

ENGINEERING > SURVEYING > PLANNING

**HURT & PROFFITT**  
INCORPORATED

2524 LANGHORNE ROAD  
LYNCHBURG VA 24501  
800.242.6906 TOLL FREE  
434.847.7796 MAIN  
434.847.0047 FAX

**STA. 58+00 - 66+96± EOL WINDING WAY-ASBUILT**

FOR

**TOWN OF BOONES MILL WATER SYSTEM REPLACEMENT, VOLUME 1**

**TOWN OF BOONES MILL, BOONE DISTRICT, FRANKLIN COUNTY, VA**

PROJECT NO.	20080815
G.L. NO.	297-03-A3.9
FILE NO.	G-12675
DATE:	7/31/09
DRAWN BY:	WCH
CHECKED BY:	BLC


HURT & PROFFITT

SHEET NO.  
**WL-500.04**


1	8/28/09	VDH COMMENTS
2	9/3/09	OWNER COMMENTS
4	3/14/12	ASBUILTS



Mar 14, 2012, 10:35am V:\LandProjects\20080815.dwg\Asbults-WL\_ASBULT-P-Water.dwg

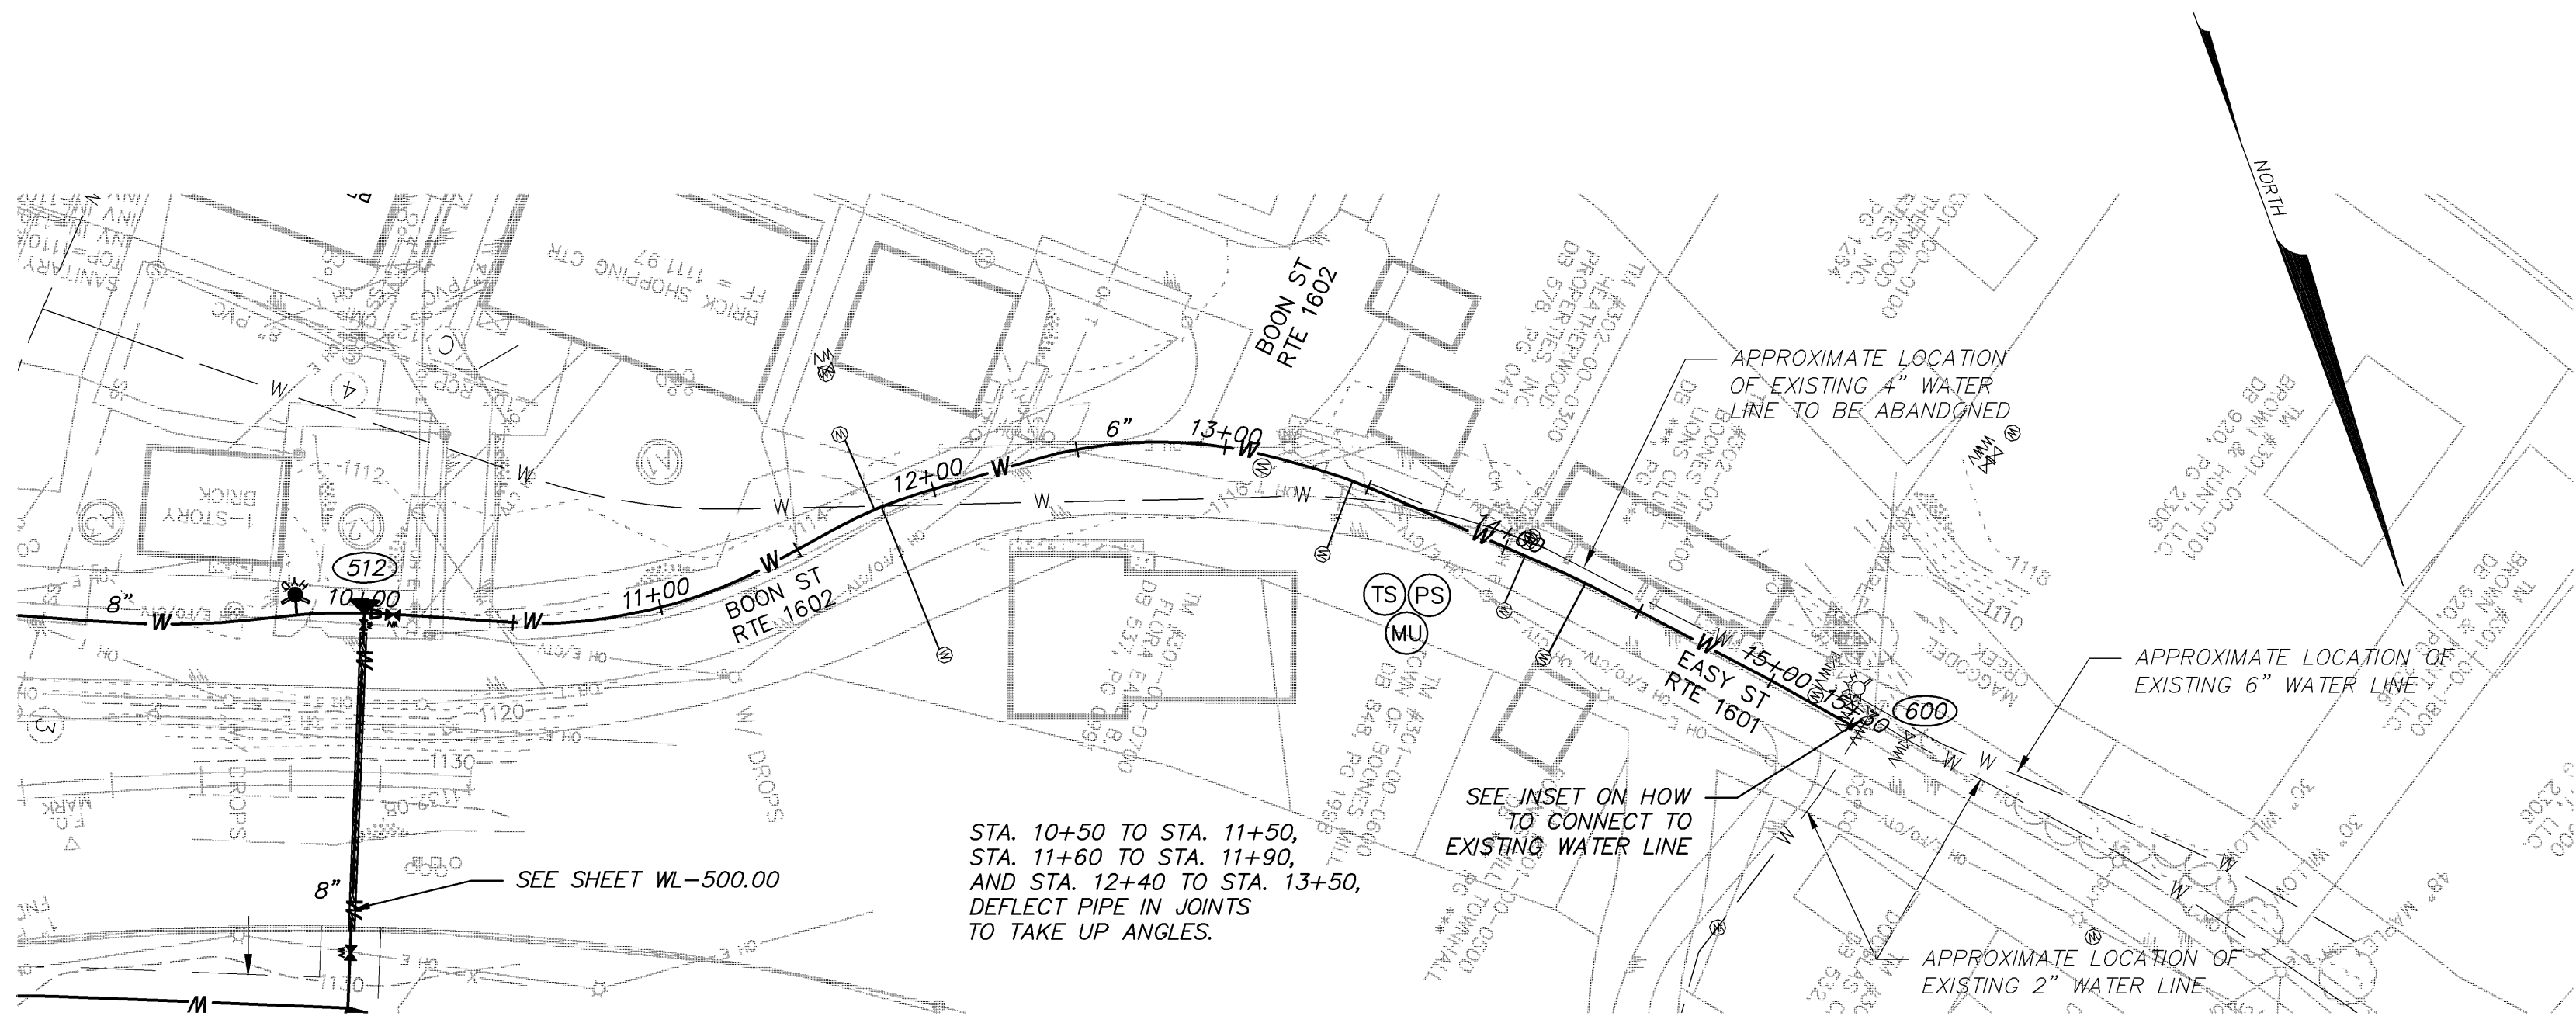


WATER LINE STRUCTURE SCHEDULE	
(512)	STA. 10+00 (EASY STREET) STA. 20+38± (WINDING WAY) REQ'D: 1-8" X 8" TEE 1-8" X 6" REDUCER 1-8" GATE VALVE AND BOX 1-6" GATE VALVE AND BOX 1-CONCRETE ANCHOR
(600)	STA. 15+30± EOL REQ'D: 1-6" 90° BEND 2-CONCRETE ANCHOR 1-6" X 6" TAPPING SLEEVE 1-6" TAPPING VALVE AND BOX CONNECT TO EXISTING LINE (SEE INSET ON THIS SHEET)

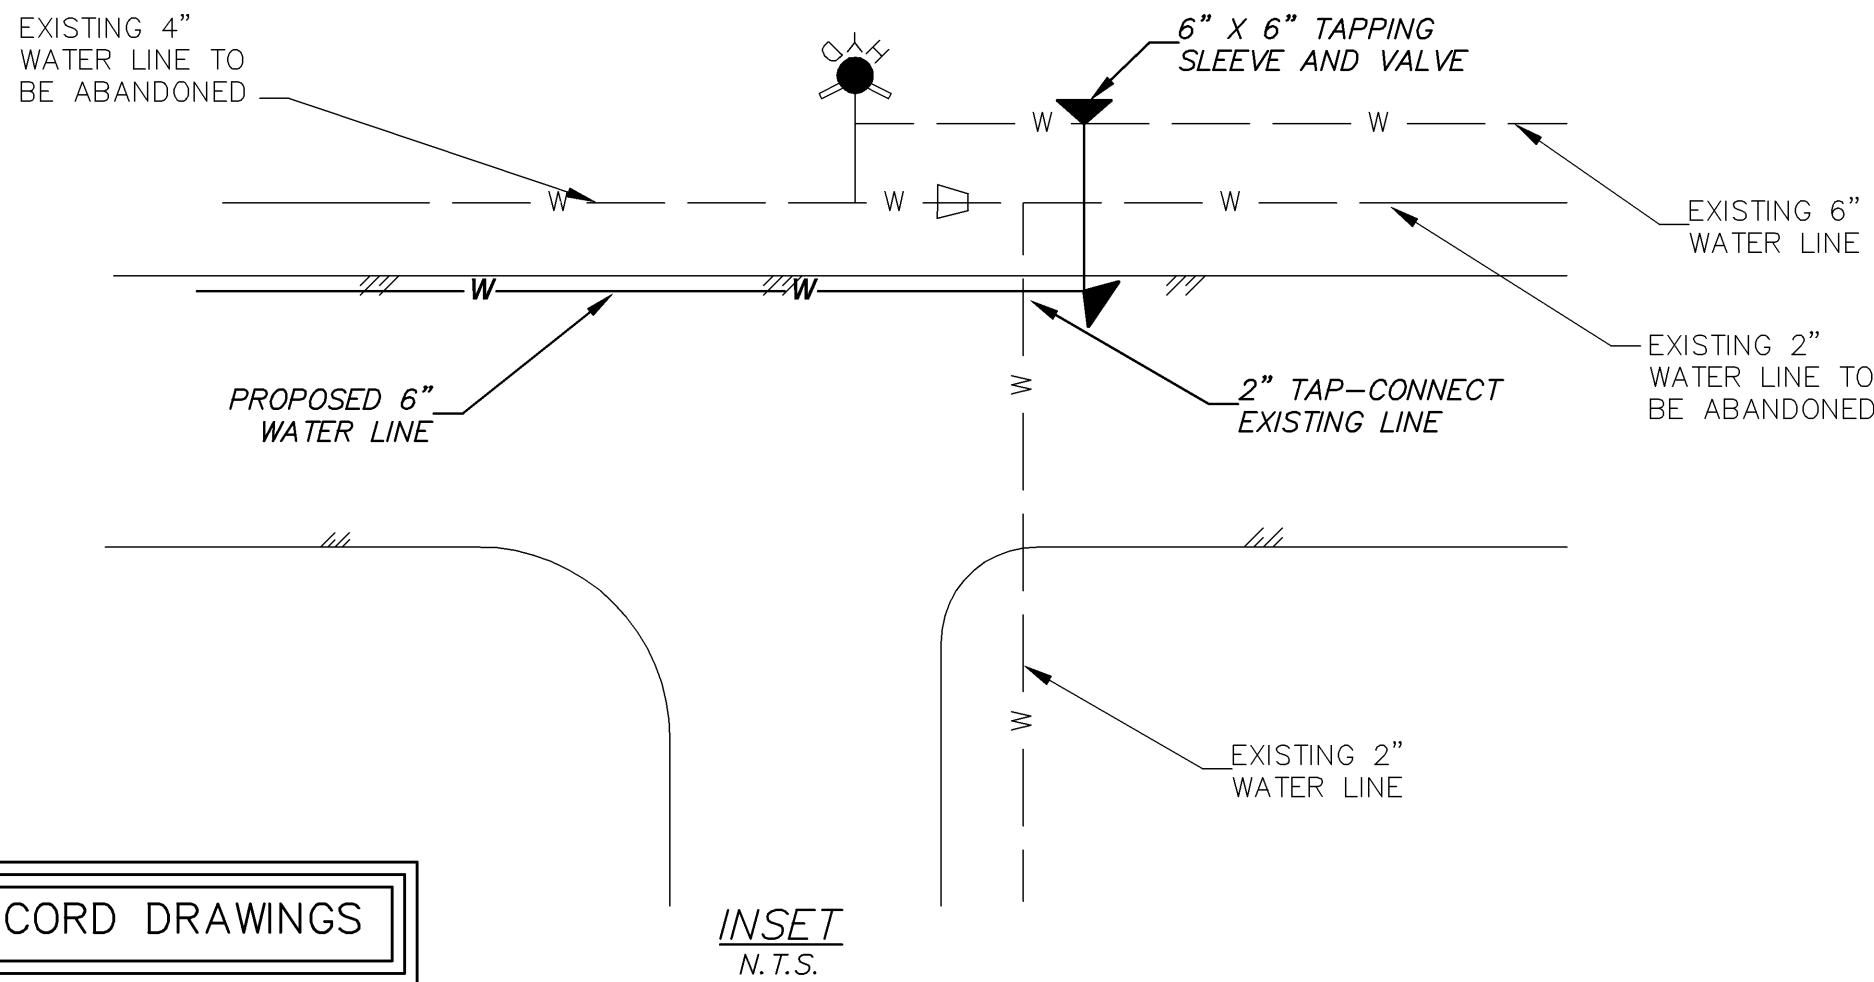


PROFILE INFORMATION TAKEN FROM RECORD DRAWINGS

LEGEND:	
---	EXISTING GRADE
—	6" C900 PVC

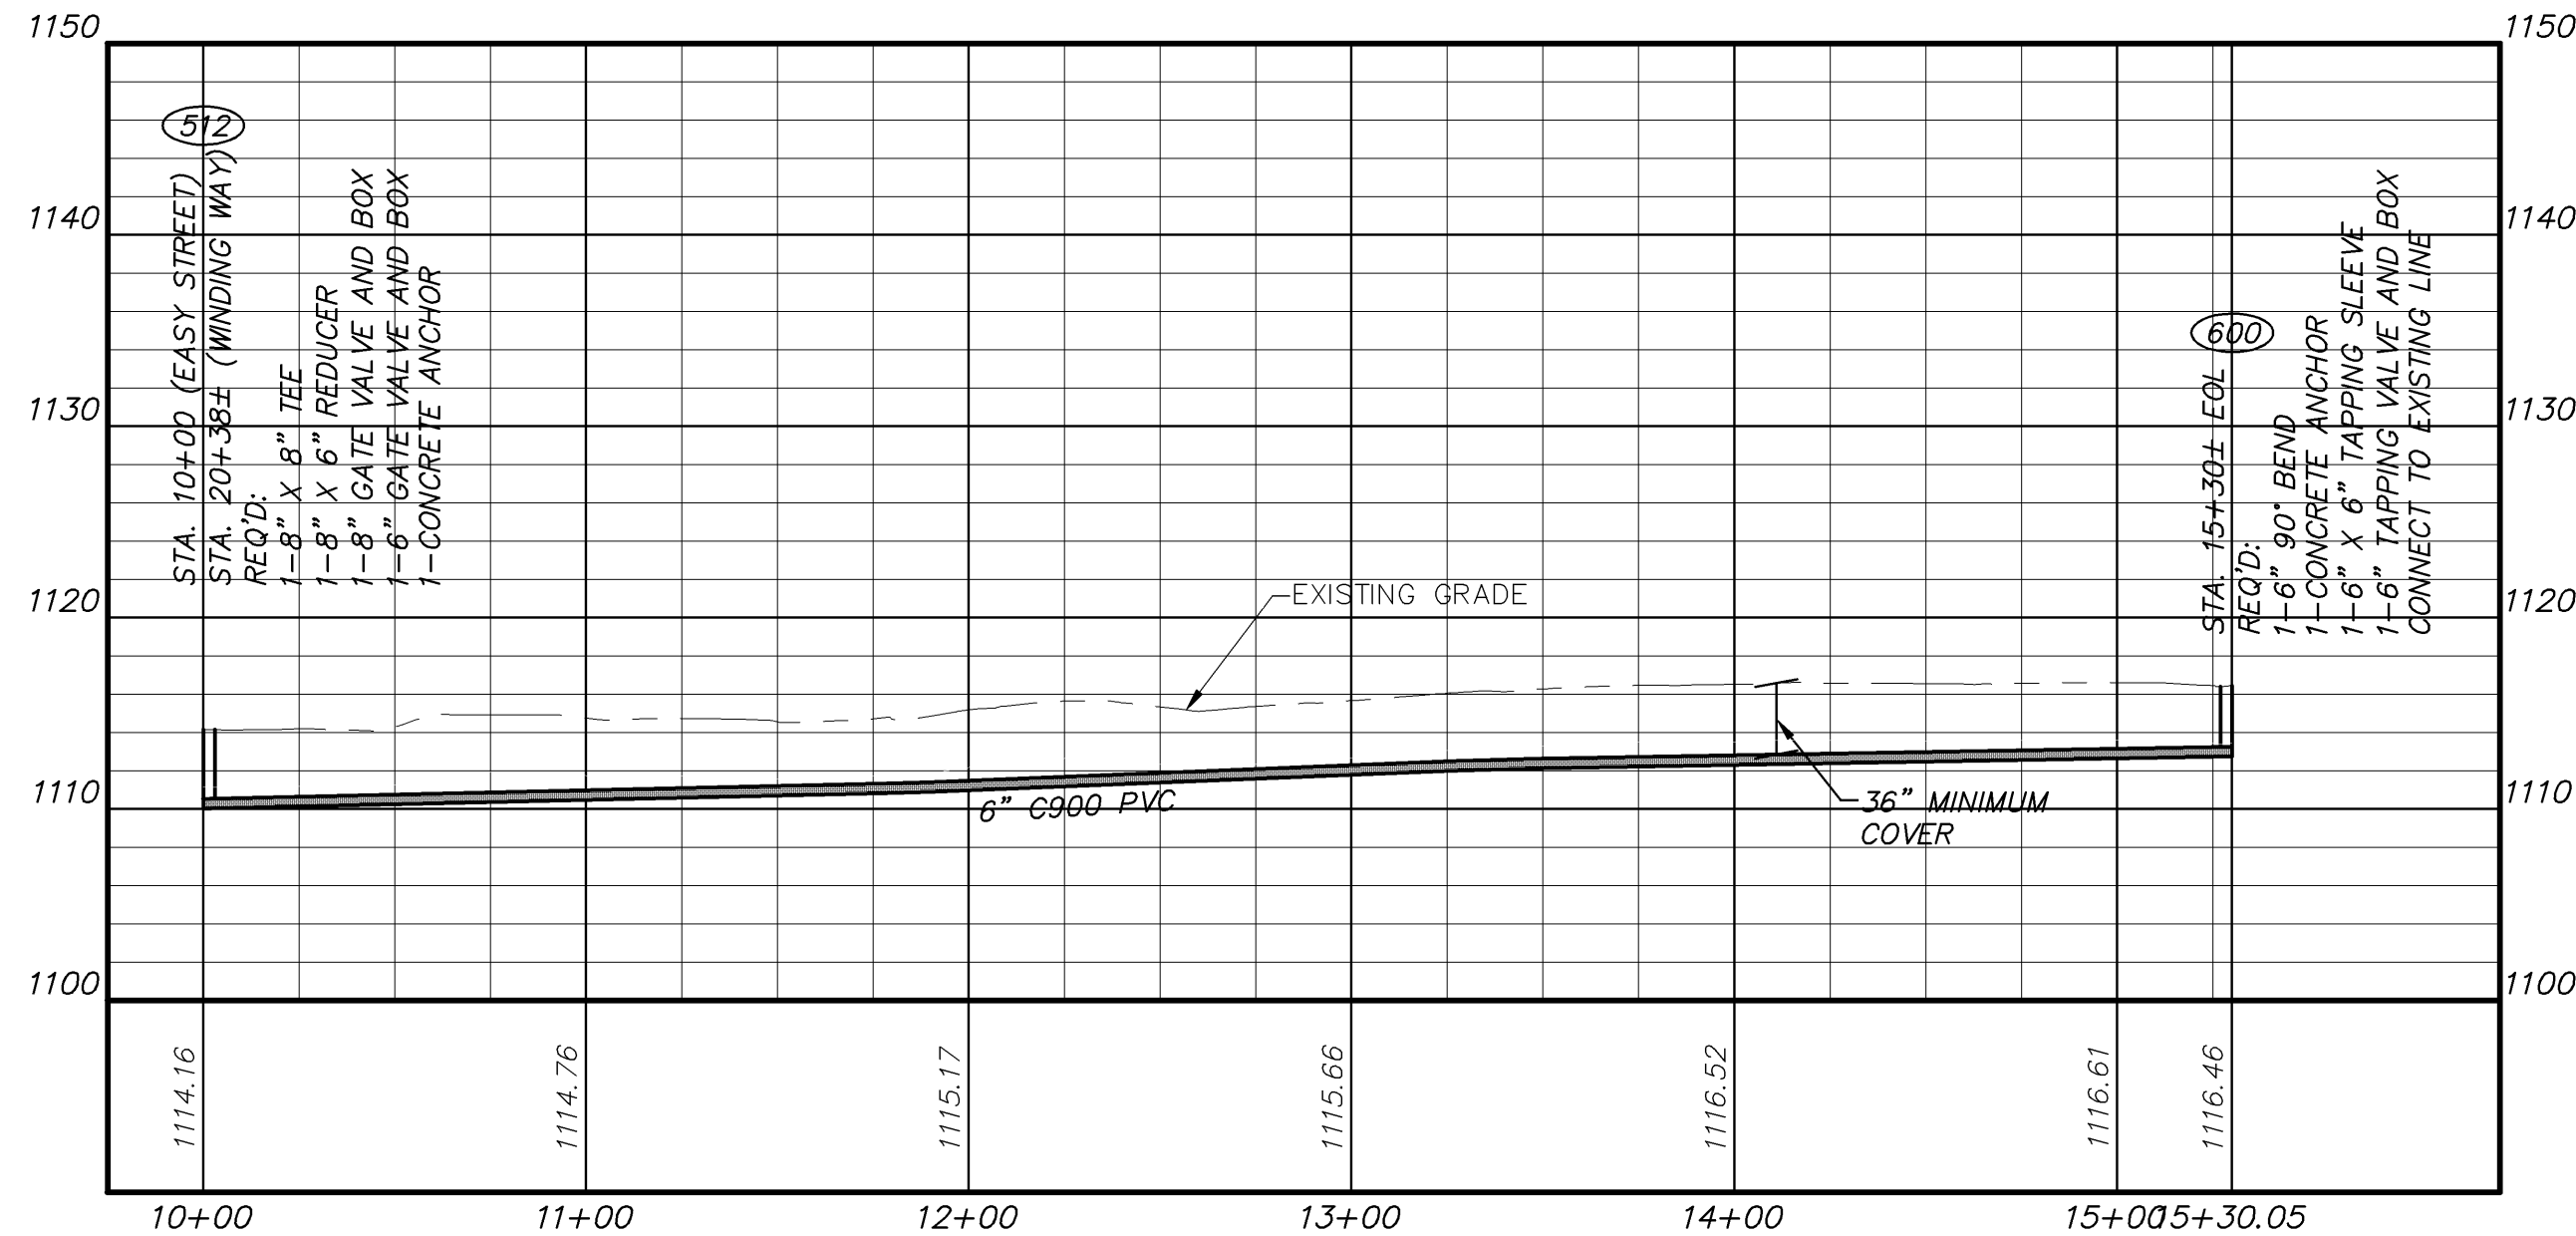

PROPOSED LEGEND	
⊙	WATER METER
—W—	WATER LINE
■	BLOW OFF ASSEMBLY
⬢	AIR RELEASE
⊕	FIRE HYDRANT
⬢	CONCRETE ANCHOR
⬢	GATE VALVE
⬢	STEEL CASING
△	SLOPE ANCHOR
E.O.L.	END OF LINE
EXISTING LEGEND	
⊙	ELECTRIC POLE
⊙	GUY WIRE
⊙	UTILITY PEDESTAL
⊙	LIGHT POLE
⊙	EDGE OF PAVEMENT
⊙	EDGE OF GRAVEL
⊙	BENCHMARK
⊙	SIGN
⊙	CONCRETE PAD
⊙	EDGE OF WOODS
⊙	EXISTING FENCE LINE
⊙	OVERHEAD ELECTRIC
⊙	UG ELECTRIC LINE
⊙	UG GAS LINE
⊙	UG TELEPHONE LINE
⊙	UG FIBER OPTIC LINE
⊙	UG WATER LINE
⊙	DITCH LINE


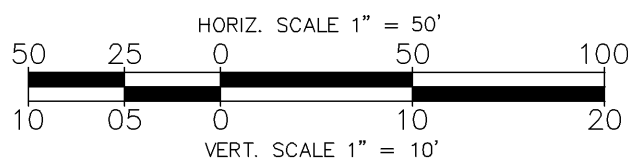


**STA. 10+00 - 15+30± EOL EASY STREET-ASBULT**  
**FOR**  
**TOWN OF BOONES MILL WATER SYSTEM REPLACEMENT, VOLUME 1**  
**TOWN OF BOONES MILL, BOONE DISTRICT, FRANKLIN COUNTY, VA**

PROJECT NO.	20080815
G.L. NO.	297-03-A3.9
FILE NO.	G-12675
DATE:	7/31/09
DRAWN BY:	WCH
CHECKED BY:	BLC

1	8/28/09	VDH COMMENTS
2	9/3/09	OWNER COMMENTS
3	2/17/10	REVISED ALIGNMENT
4	3/14/12	ASBULTS

Mar 14, 2012 - 10:35am V:\LandProjects\20080815\dwg\Asbults-WL-ASBULT-P-P-Water.dwg

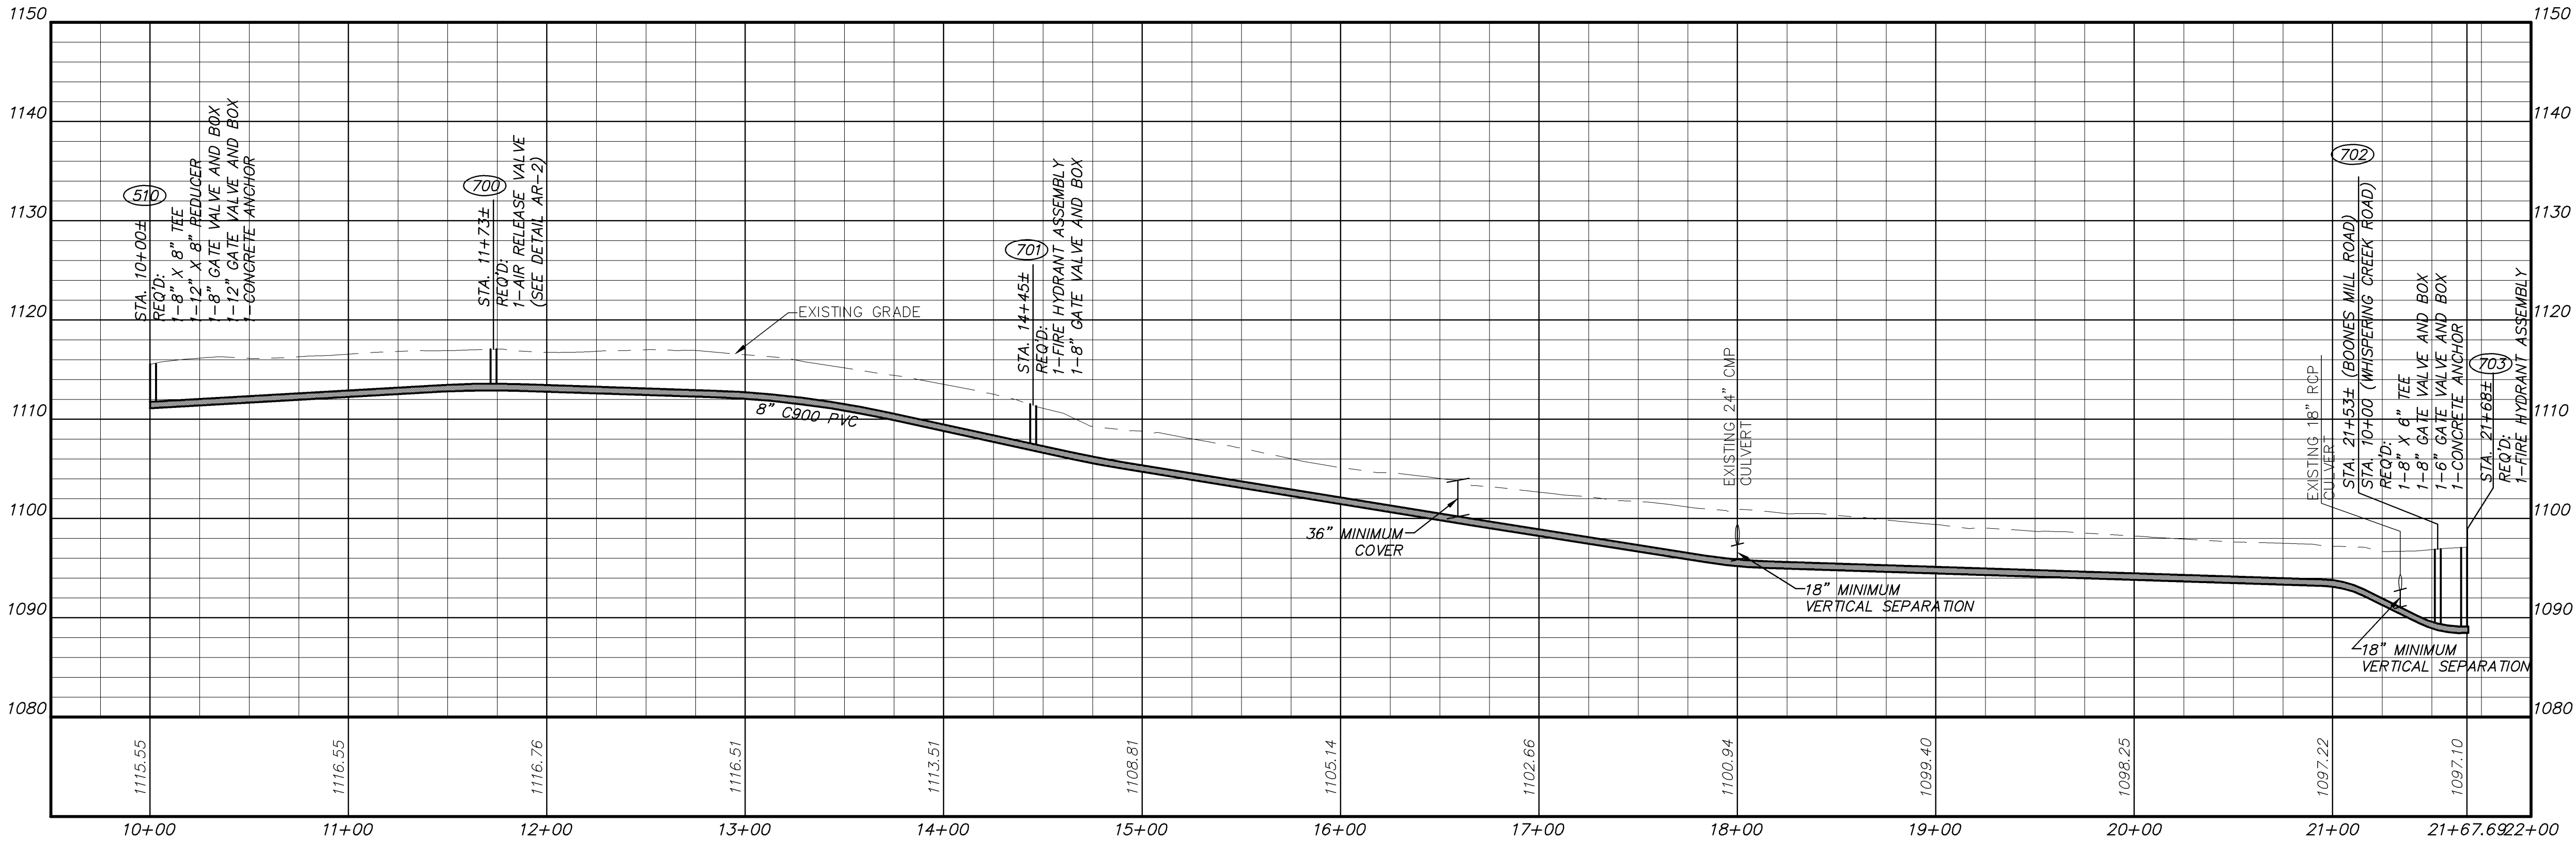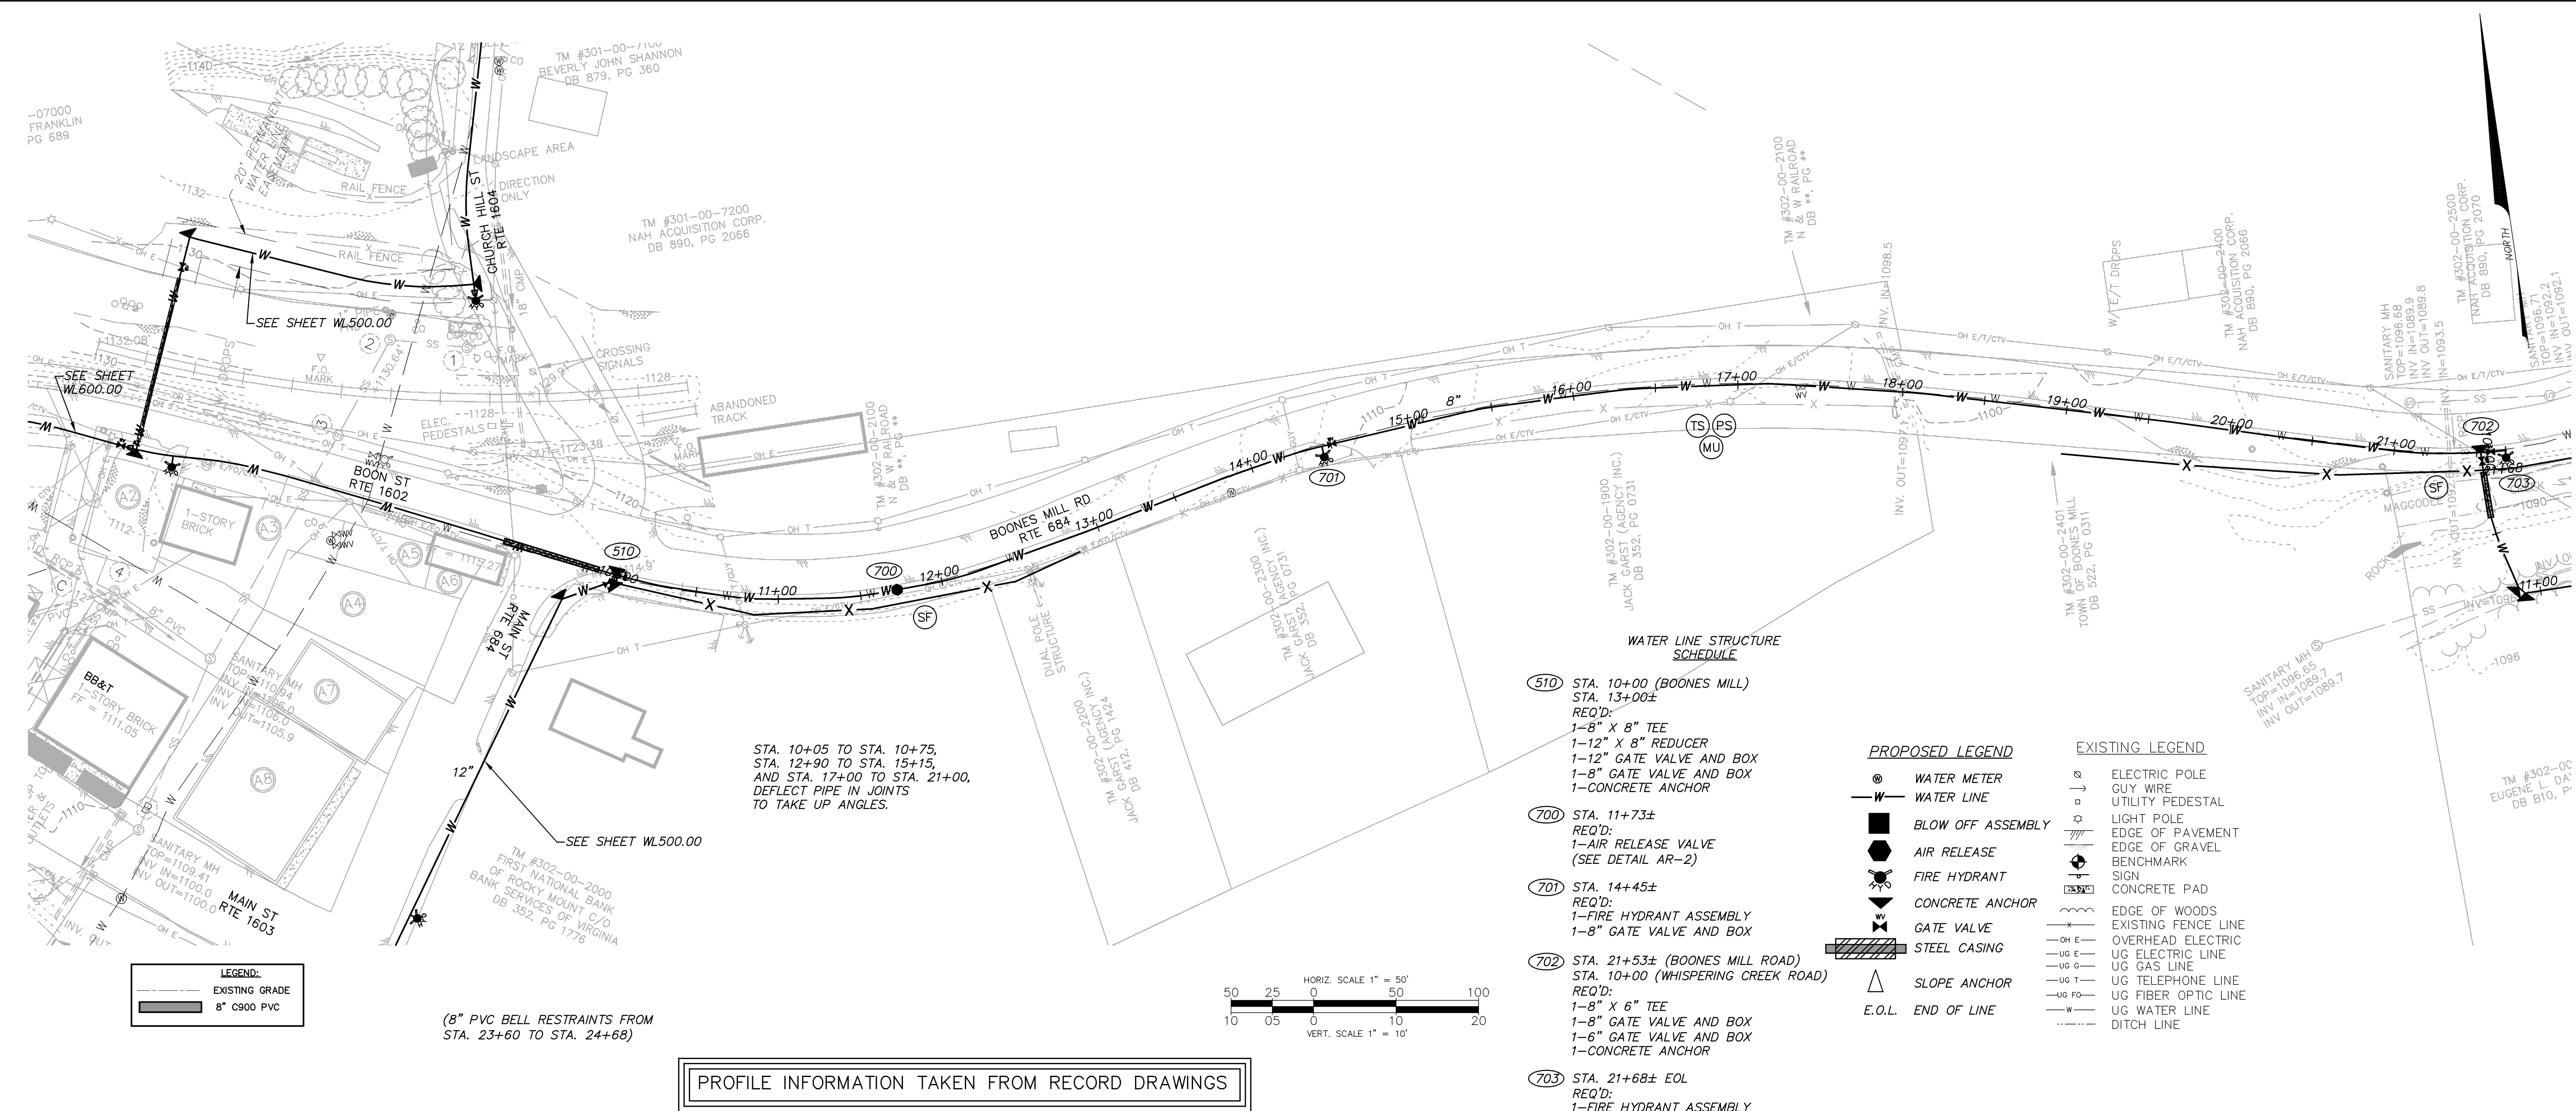

1	8/28/09	VDH COMMENTS
2	9/3/09	OWNER COMMENTS
3	2/17/10	REVISED ALIGNMENT
4	3/14/12	ASBULTS

**HURT & PROFFITT**  
INCORPORATED  
2524 LARGHORNE ROAD  
LYNCHBURG VA 24501  
800.242.4906 TOLL FREE  
434.847.7796 MAIN  
434.847.0047 FAX

**STA. 10+00 - 21+68 EOL BOONES MILL ROAD-ASBULT**  
**FOR**  
**TOWN OF BOONES MILL WATER SYSTEM REPLACEMENT, VOLUME 1**  
**TOWN OF BOONES MILL, BOONE DISTRICT, FRANKLIN COUNTY, VA**

PROJECT NO. 20080815  
G.L. NO. 297-03-A3.9  
FILE NO. G-12675  
DATE: 7/31/09  
DRAWN BY: WCH  
CHECKED BY: BLC




**HURT & PROFFITT**

SHEET NO.  
**WL-700.00**



Mar 14, 2012, 10:36am V:\LandProjects\20080815.dwg\ASBUILT-P\_P-Water.dwg

LEGEND:  
--- EXISTING GRADE  
--- 6" C900 PVC

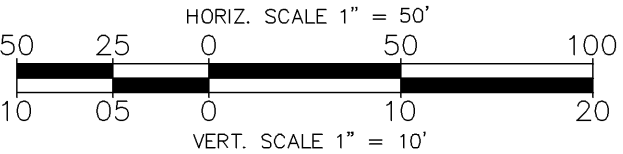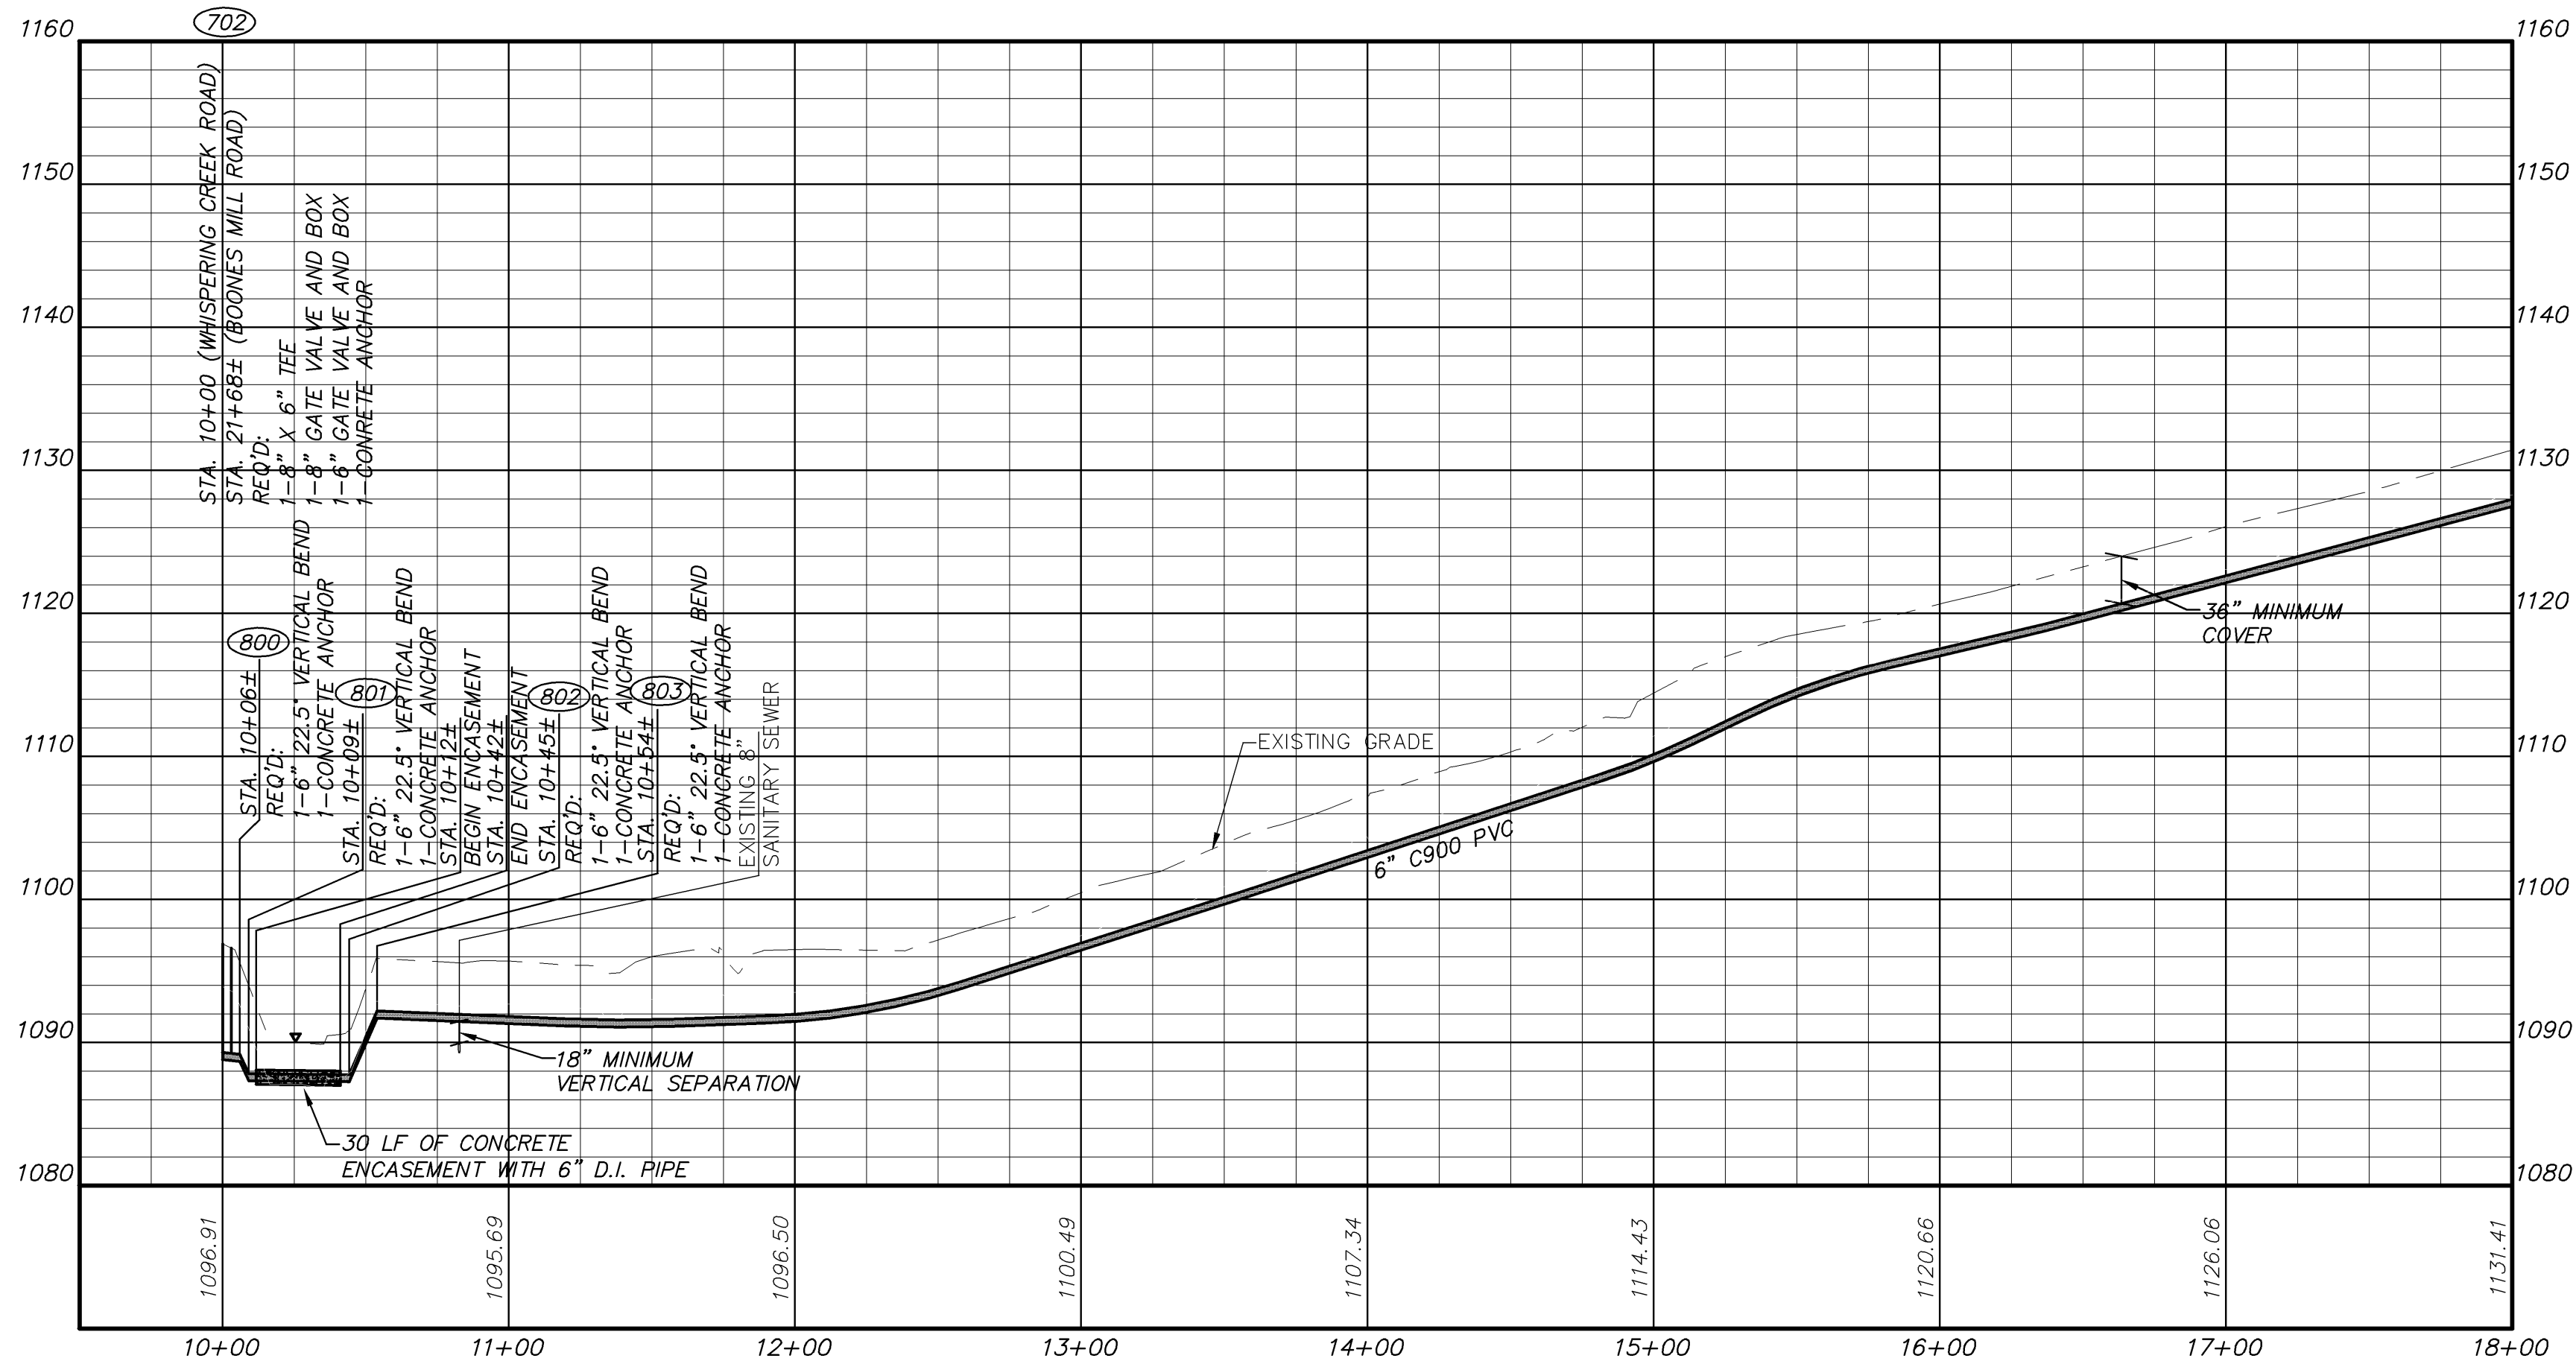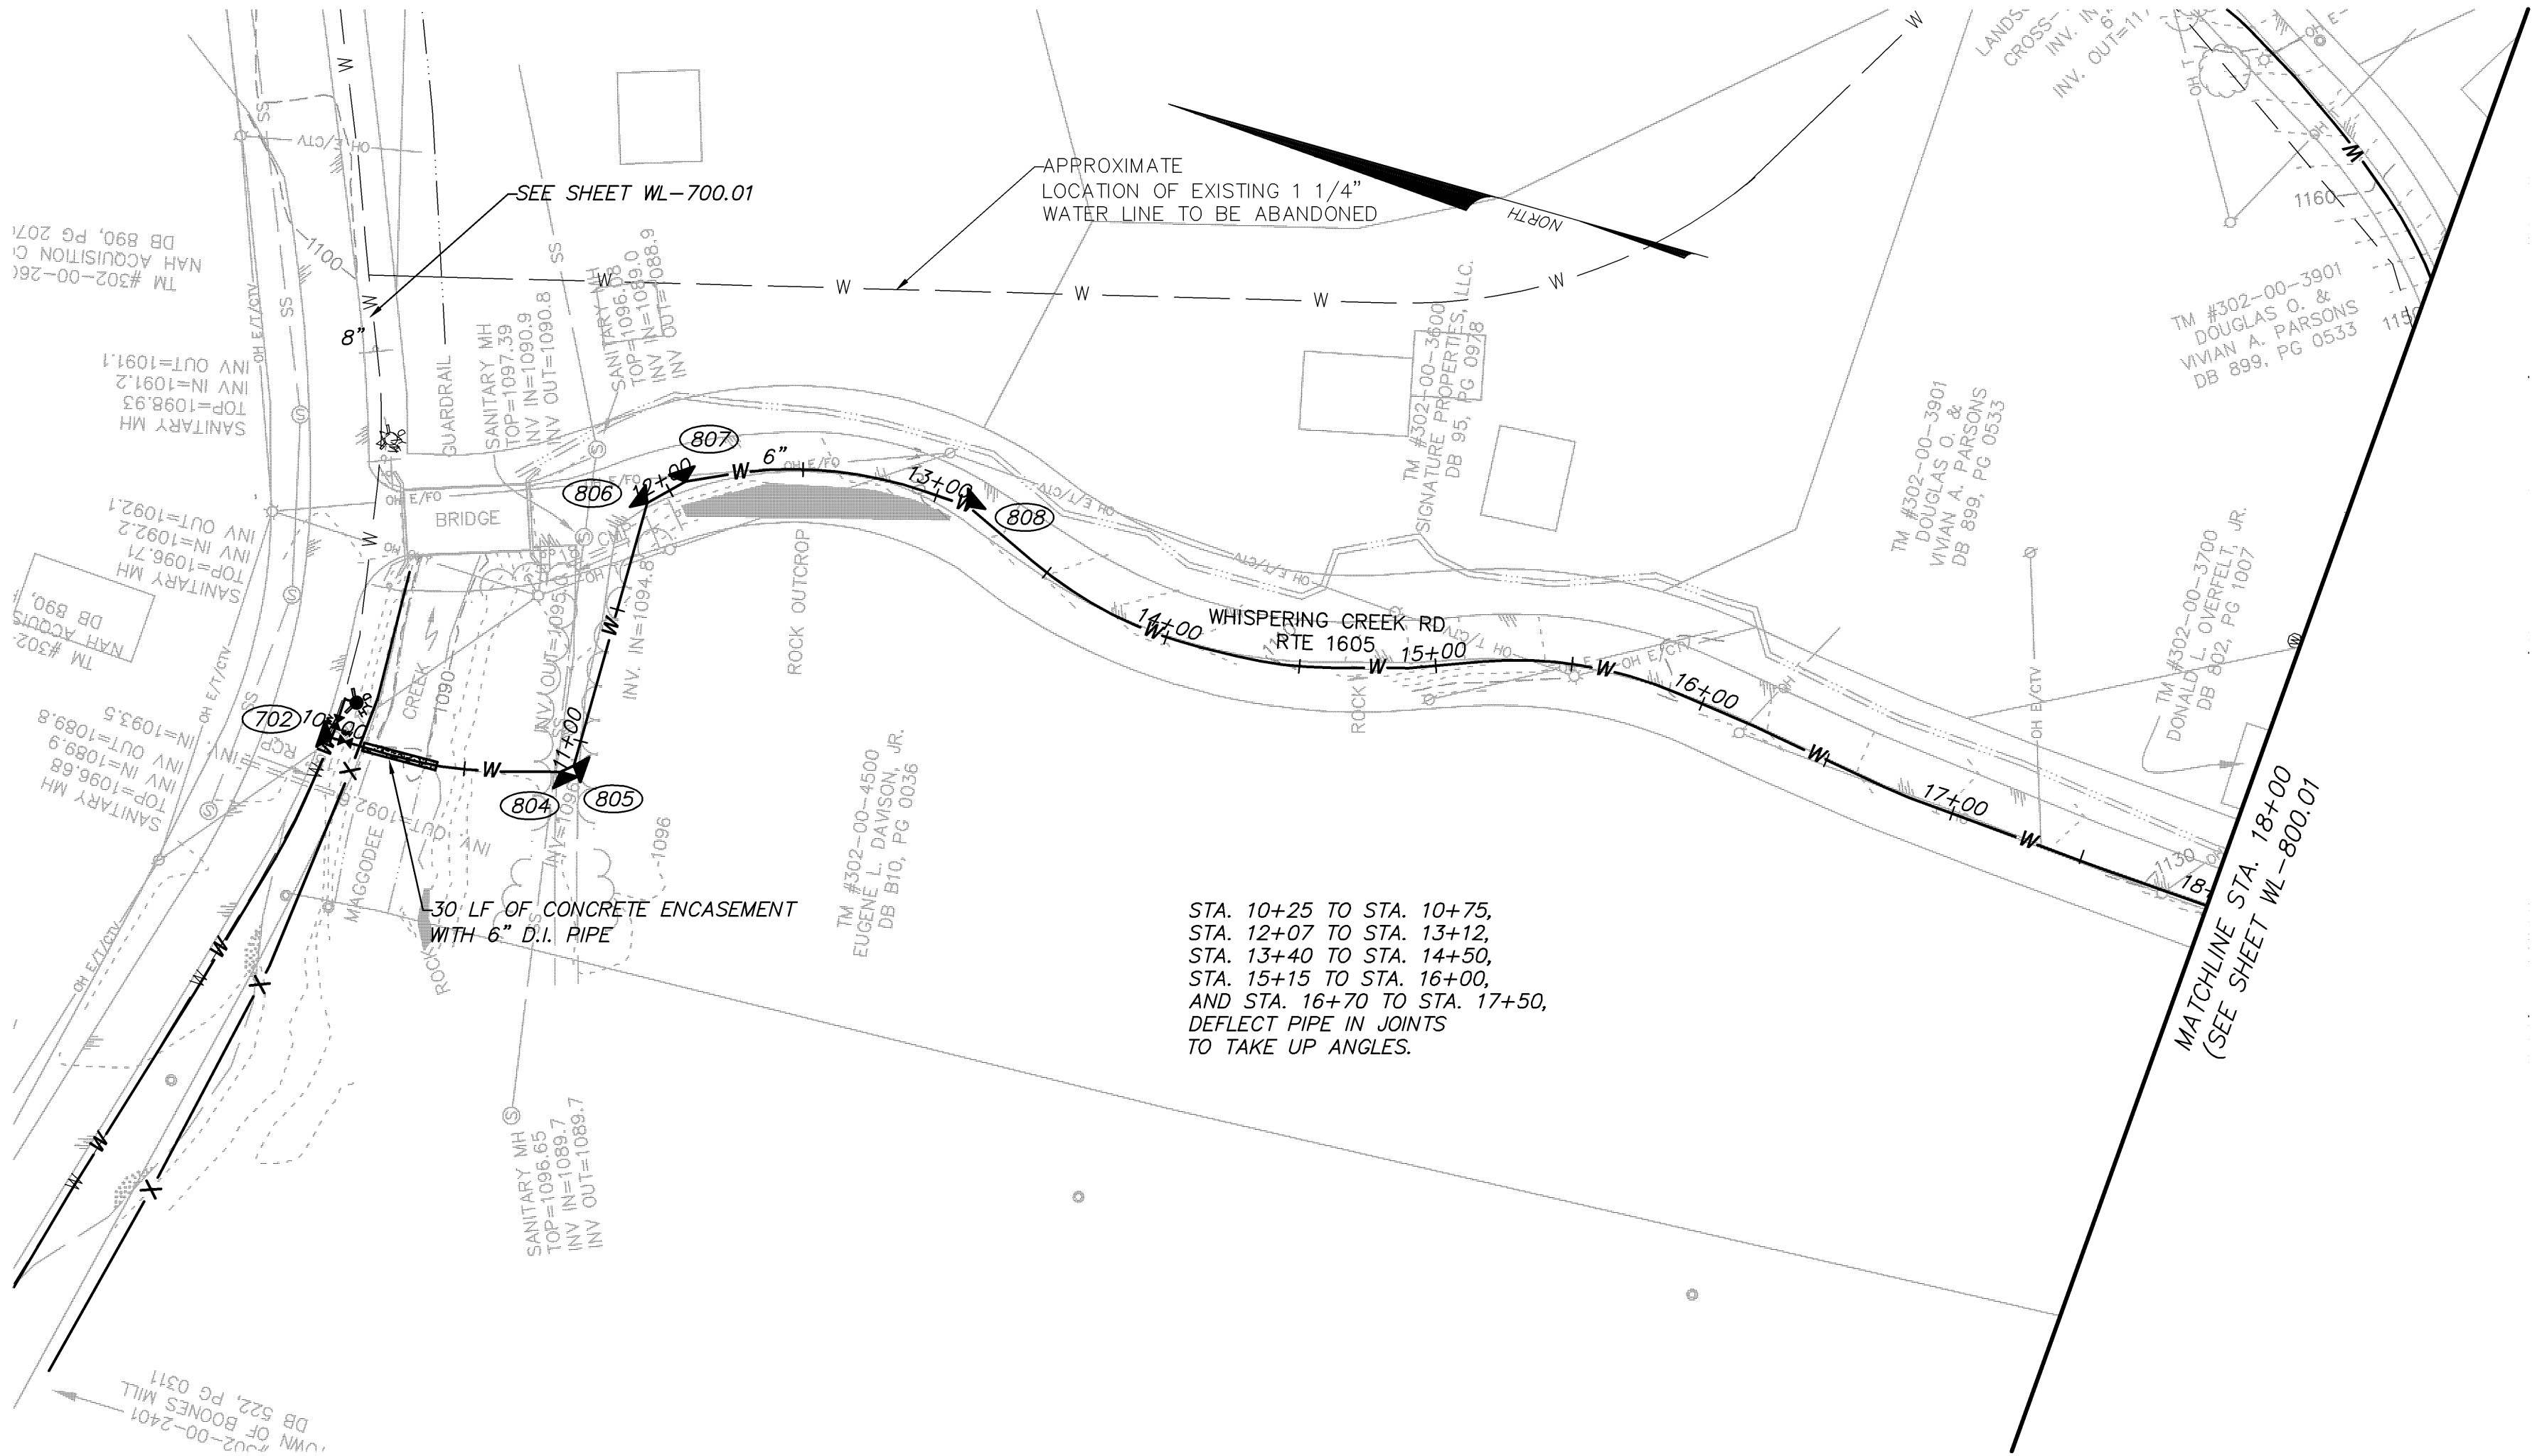

- PROPOSED LEGEND**

  - WATER METER
  - WATER LINE
  - BLOW OFF ASSEMBLY
  - AIR RELEASE
  - FIRE HYDRANT
  - CONCRETE ANCHOR
  - GATE VALVE
  - STEEL CASING
  - SLOPE ANCHOR
  - E.O.L. END OF LINE
- EXISTING LEGEND**

  - ELECTRIC POLE
  - GUY WIRE
  - UTILITY PEDESTAL
  - LIGHT POLE
  - EDGE OF PAVEMENT
  - EDGE OF GRAVEL
  - BENCHMARK
  - SIGN
  - CONCRETE PAD
  - EDGE OF WOODS
  - EXISTING FENCE LINE
  - OVERHEAD ELECTRIC
  - UG ELECTRIC LINE
  - UG GAS LINE
  - UG TELEPHONE LINE
  - UG FIBER OPTIC LINE
  - UG WATER LINE
  - DITCH LINE

- WATER LINE STRUCTURE SCHEDULE**
- 702** STA. 10+00 (WHISPERING CREEK ROAD)  
STA. 21+53± (BOONES MILL)  
REQ'D:  
1-8" X 6" TEE  
1-8" GATE VALVE AND BOX  
1-6" GATE VALVE AND BOX  
1-CONCRETE ANCHOR
  - 800** STA. 10+06±  
REQ'D:  
1-6" 22.5' VERTICAL BEND  
1-CONCRETE ANCHOR
  - 801** STA. 10+09±  
REQ'D:  
1-6" 22.5' VERTICAL BEND  
1-CONCRETE ANCHOR
  - 802** STA. 10+45±  
REQ'D:  
1-6" 22.5' VERTICAL BEND  
1-CONCRETE ANCHOR
  - 803** STA. 10+54±  
REQ'D:  
1-6" 22.5' VERTICAL BEND  
1-CONCRETE ANCHOR
  - 804** STA. 10+85±  
REQ'D:  
1-6" 22.5' BEND  
1-CONCRETE ANCHOR
  - 805** STA. 10+91±  
REQ'D:  
1-6" 45' BEND  
1-CONCRETE ANCHOR
  - 806** STA. 11+91±  
REQ'D:  
1-6" 45' BEND  
1-CONCRETE ANCHOR
  - 807** STA. 12+07±  
REQ'D:  
1-6" 22.5' BEND  
1-CONCRETE ANCHOR
  - 808** STA. 13+12±  
REQ'D:  
1-6" 22.5' BEND  
1-CONCRETE ANCHOR

1	8/28/09	VDH COMMENTS
2	9/3/09	OWNER COMMENTS
4	3/14/12	ASBUILTS

**HURT & PROFFITT**  
INCORPORATED  
2524 LANGHORNE ROAD  
LYNCHBURG VA 24501  
800.242.6906 TOLL FREE  
434.847.7796 MAIN  
434.847.0047 FAX




**STA. 10+00 - 18+00 WHISPERING CREEK ROAD-ASBUILT**  
**FOR**  
**TOWN OF BOONES MILL WATER SYSTEM REPLACEMENT, VOLUME 1**  
**TOWN OF BOONES MILL, BOONE DISTRICT, FRANKLIN COUNTY, VA**

PROJECT NO. 20080815  
G.L. NO. 297-03-A3.9  
FILE NO. G-12675  
DATE: 7/31/09  
DRAWN BY: WCH  
CHECKED BY: BLC

**HURT & PROFFITT**

SHEET NO.  
**WL-800.00**


Mar 14, 2012 - 10:37am V:\LandProjects\20080815.dwg\Asbults-WL\_ASBULT-P-P-Water.dwg

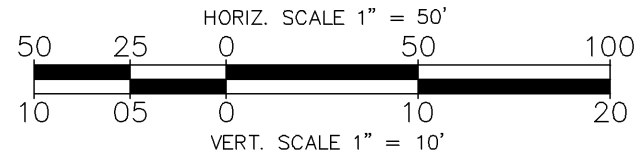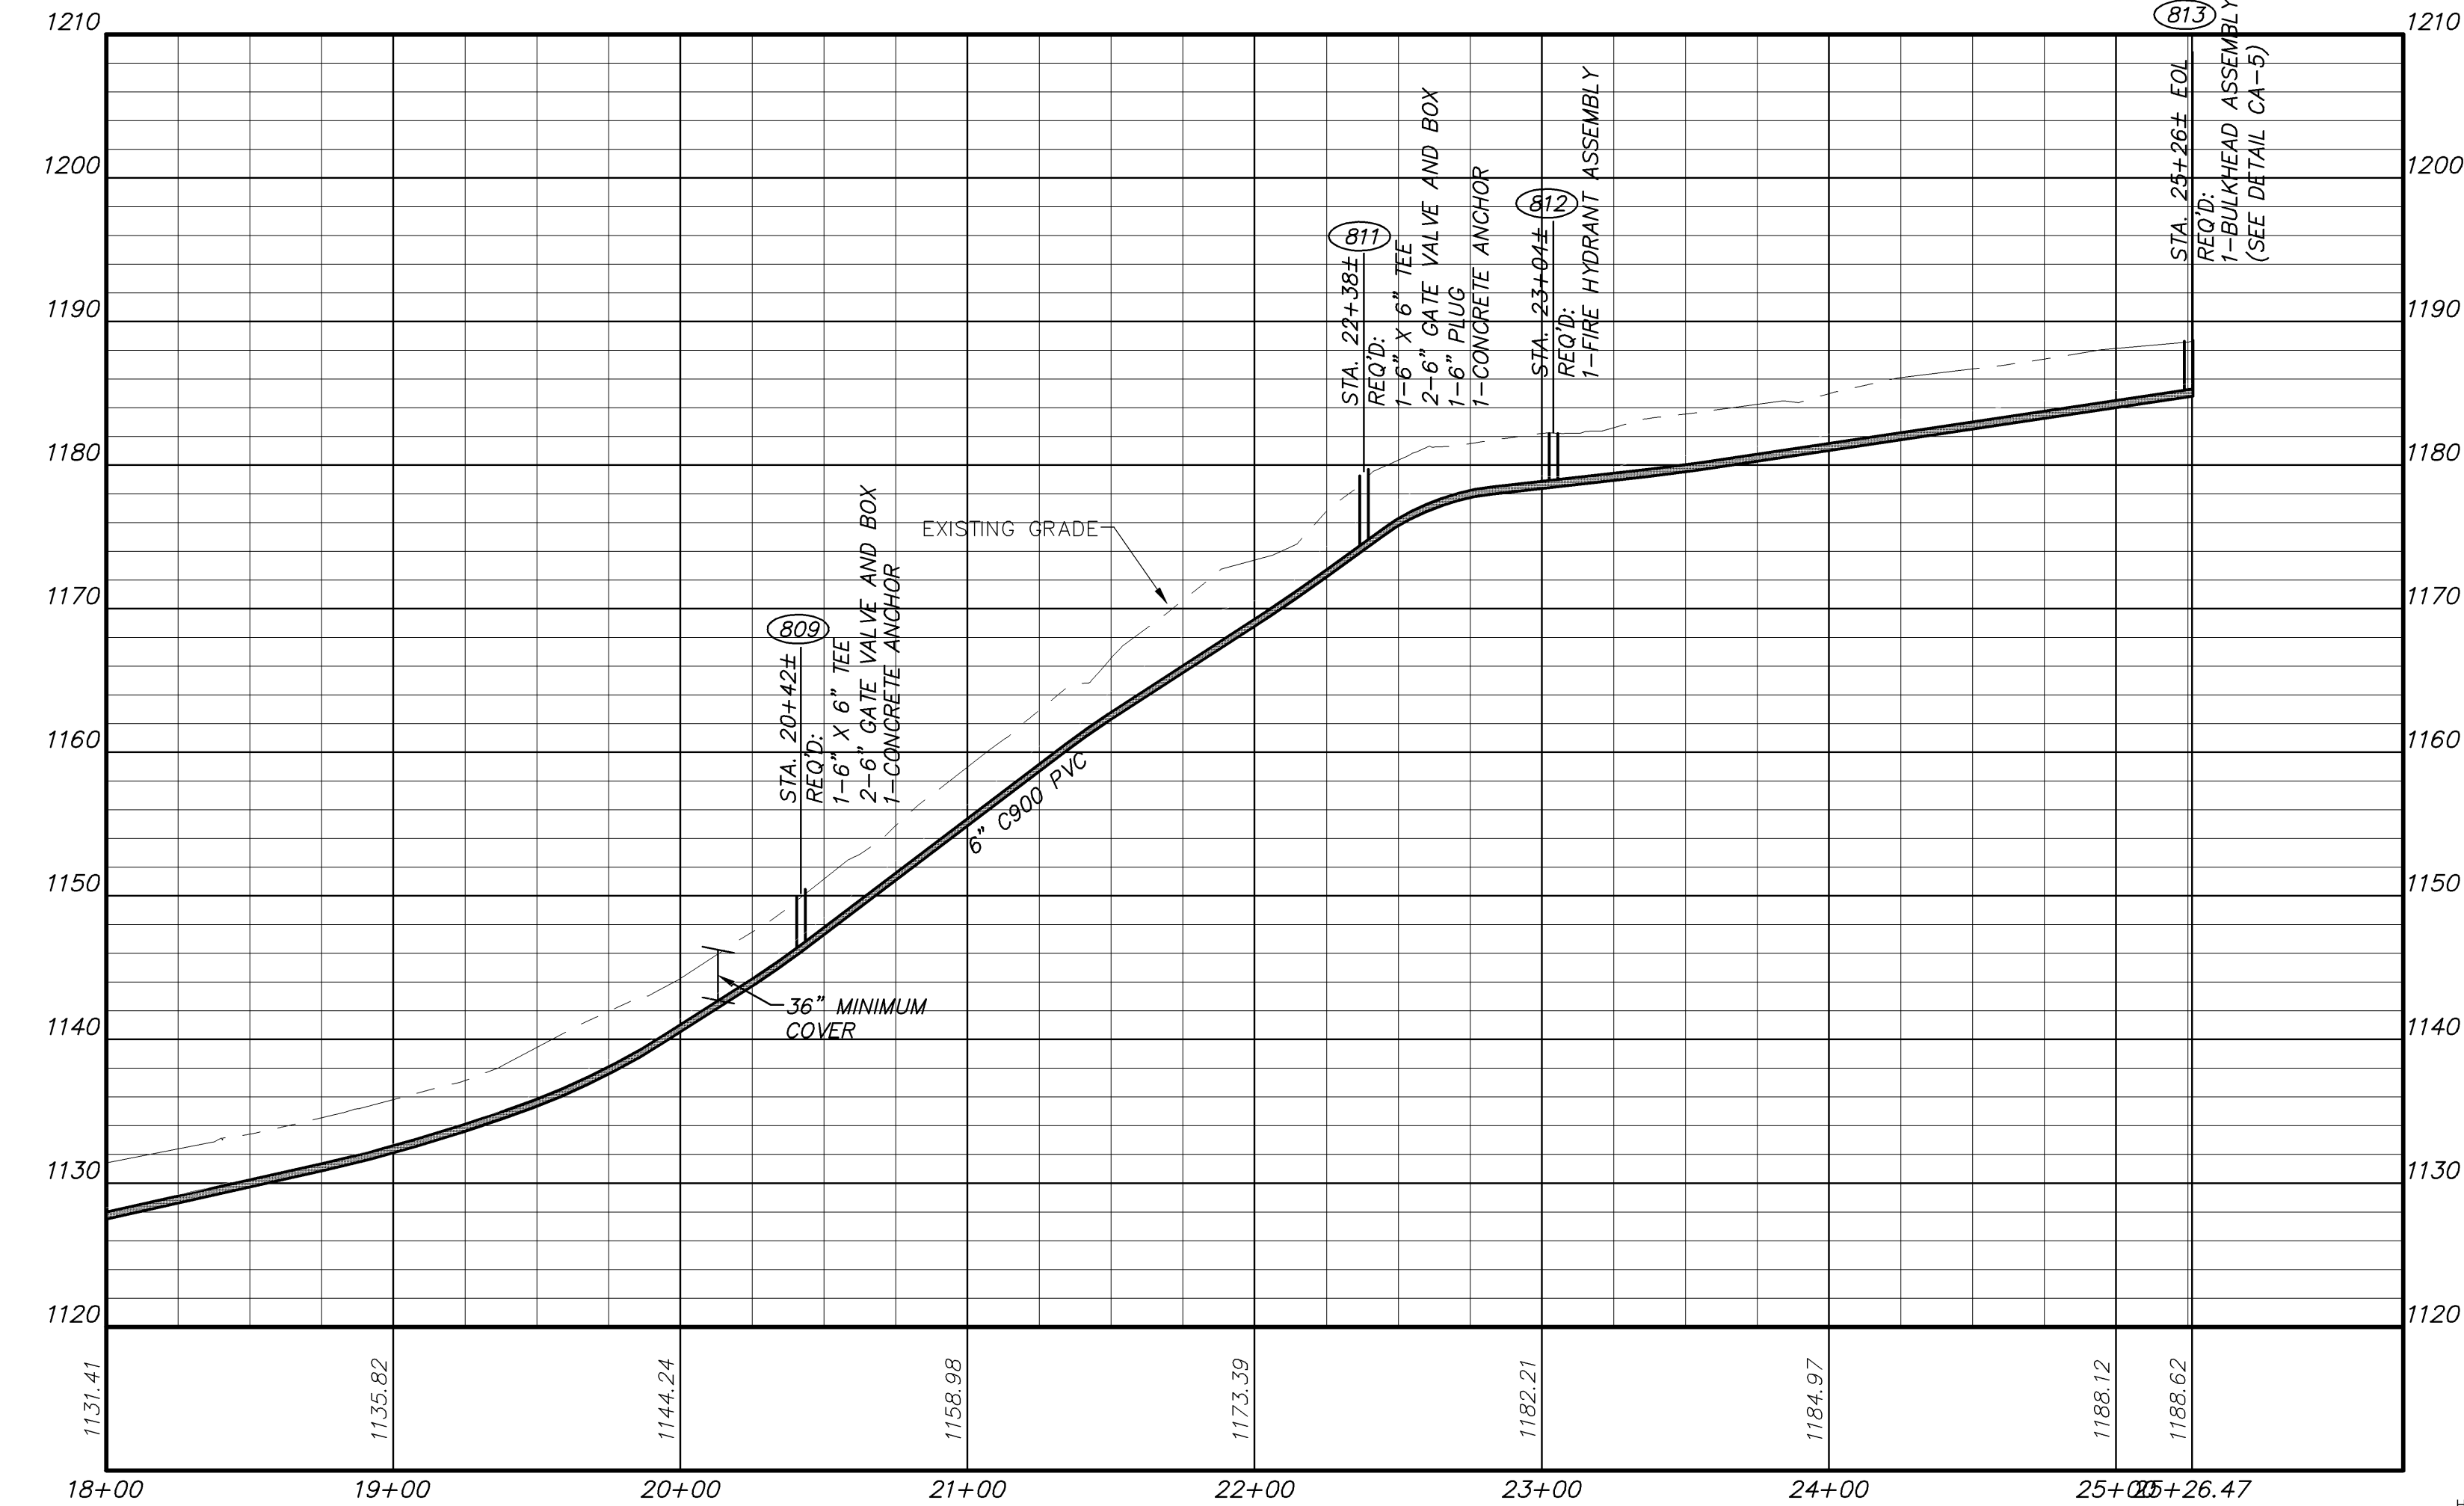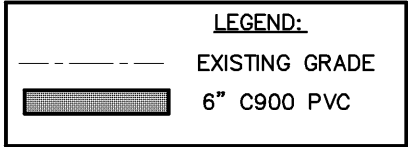

WATER LINE STRUCTURE SCHEDULE

- (809) STA. 20+42± (WHISPERING CREEK ROAD)  
STA. 10+00 (TURNER LANE)  
REQ'D:  
1-6" X 6" TEE  
2-6" GATE VALVE AND BOX  
1-CONCRETE ANCHOR
- (810) STA. 21+85±  
REQ'D:  
1-6" 45° BEND  
1-CONCRETE ANCHOR
- (811) STA. 22+38±  
REQ'D:  
1-6" X 6" TEE  
2-6" GATE VALVE AND BOX  
1-6" PLUG  
1-CONCRETE ANCHOR
- (812) STA. 23+04±  
REQ'D:  
1-FIRE HYDRANT ASSEMBLY
- (813) STA. 25+26± EOL  
REQ'D:  
1-BULKHEAD ASSEMBLY  
(SEE DETAIL CA-5)  
2-1" WATER METERS  
(CONTRACTOR TO INSTALL WATER METERS AND CONNECT EXISTING LINES TO NEW METERS)

1	8/28/09	VDH COMMENTS
2	9/3/09	OWNER COMMENTS
4	3/14/12	ASBUILTS

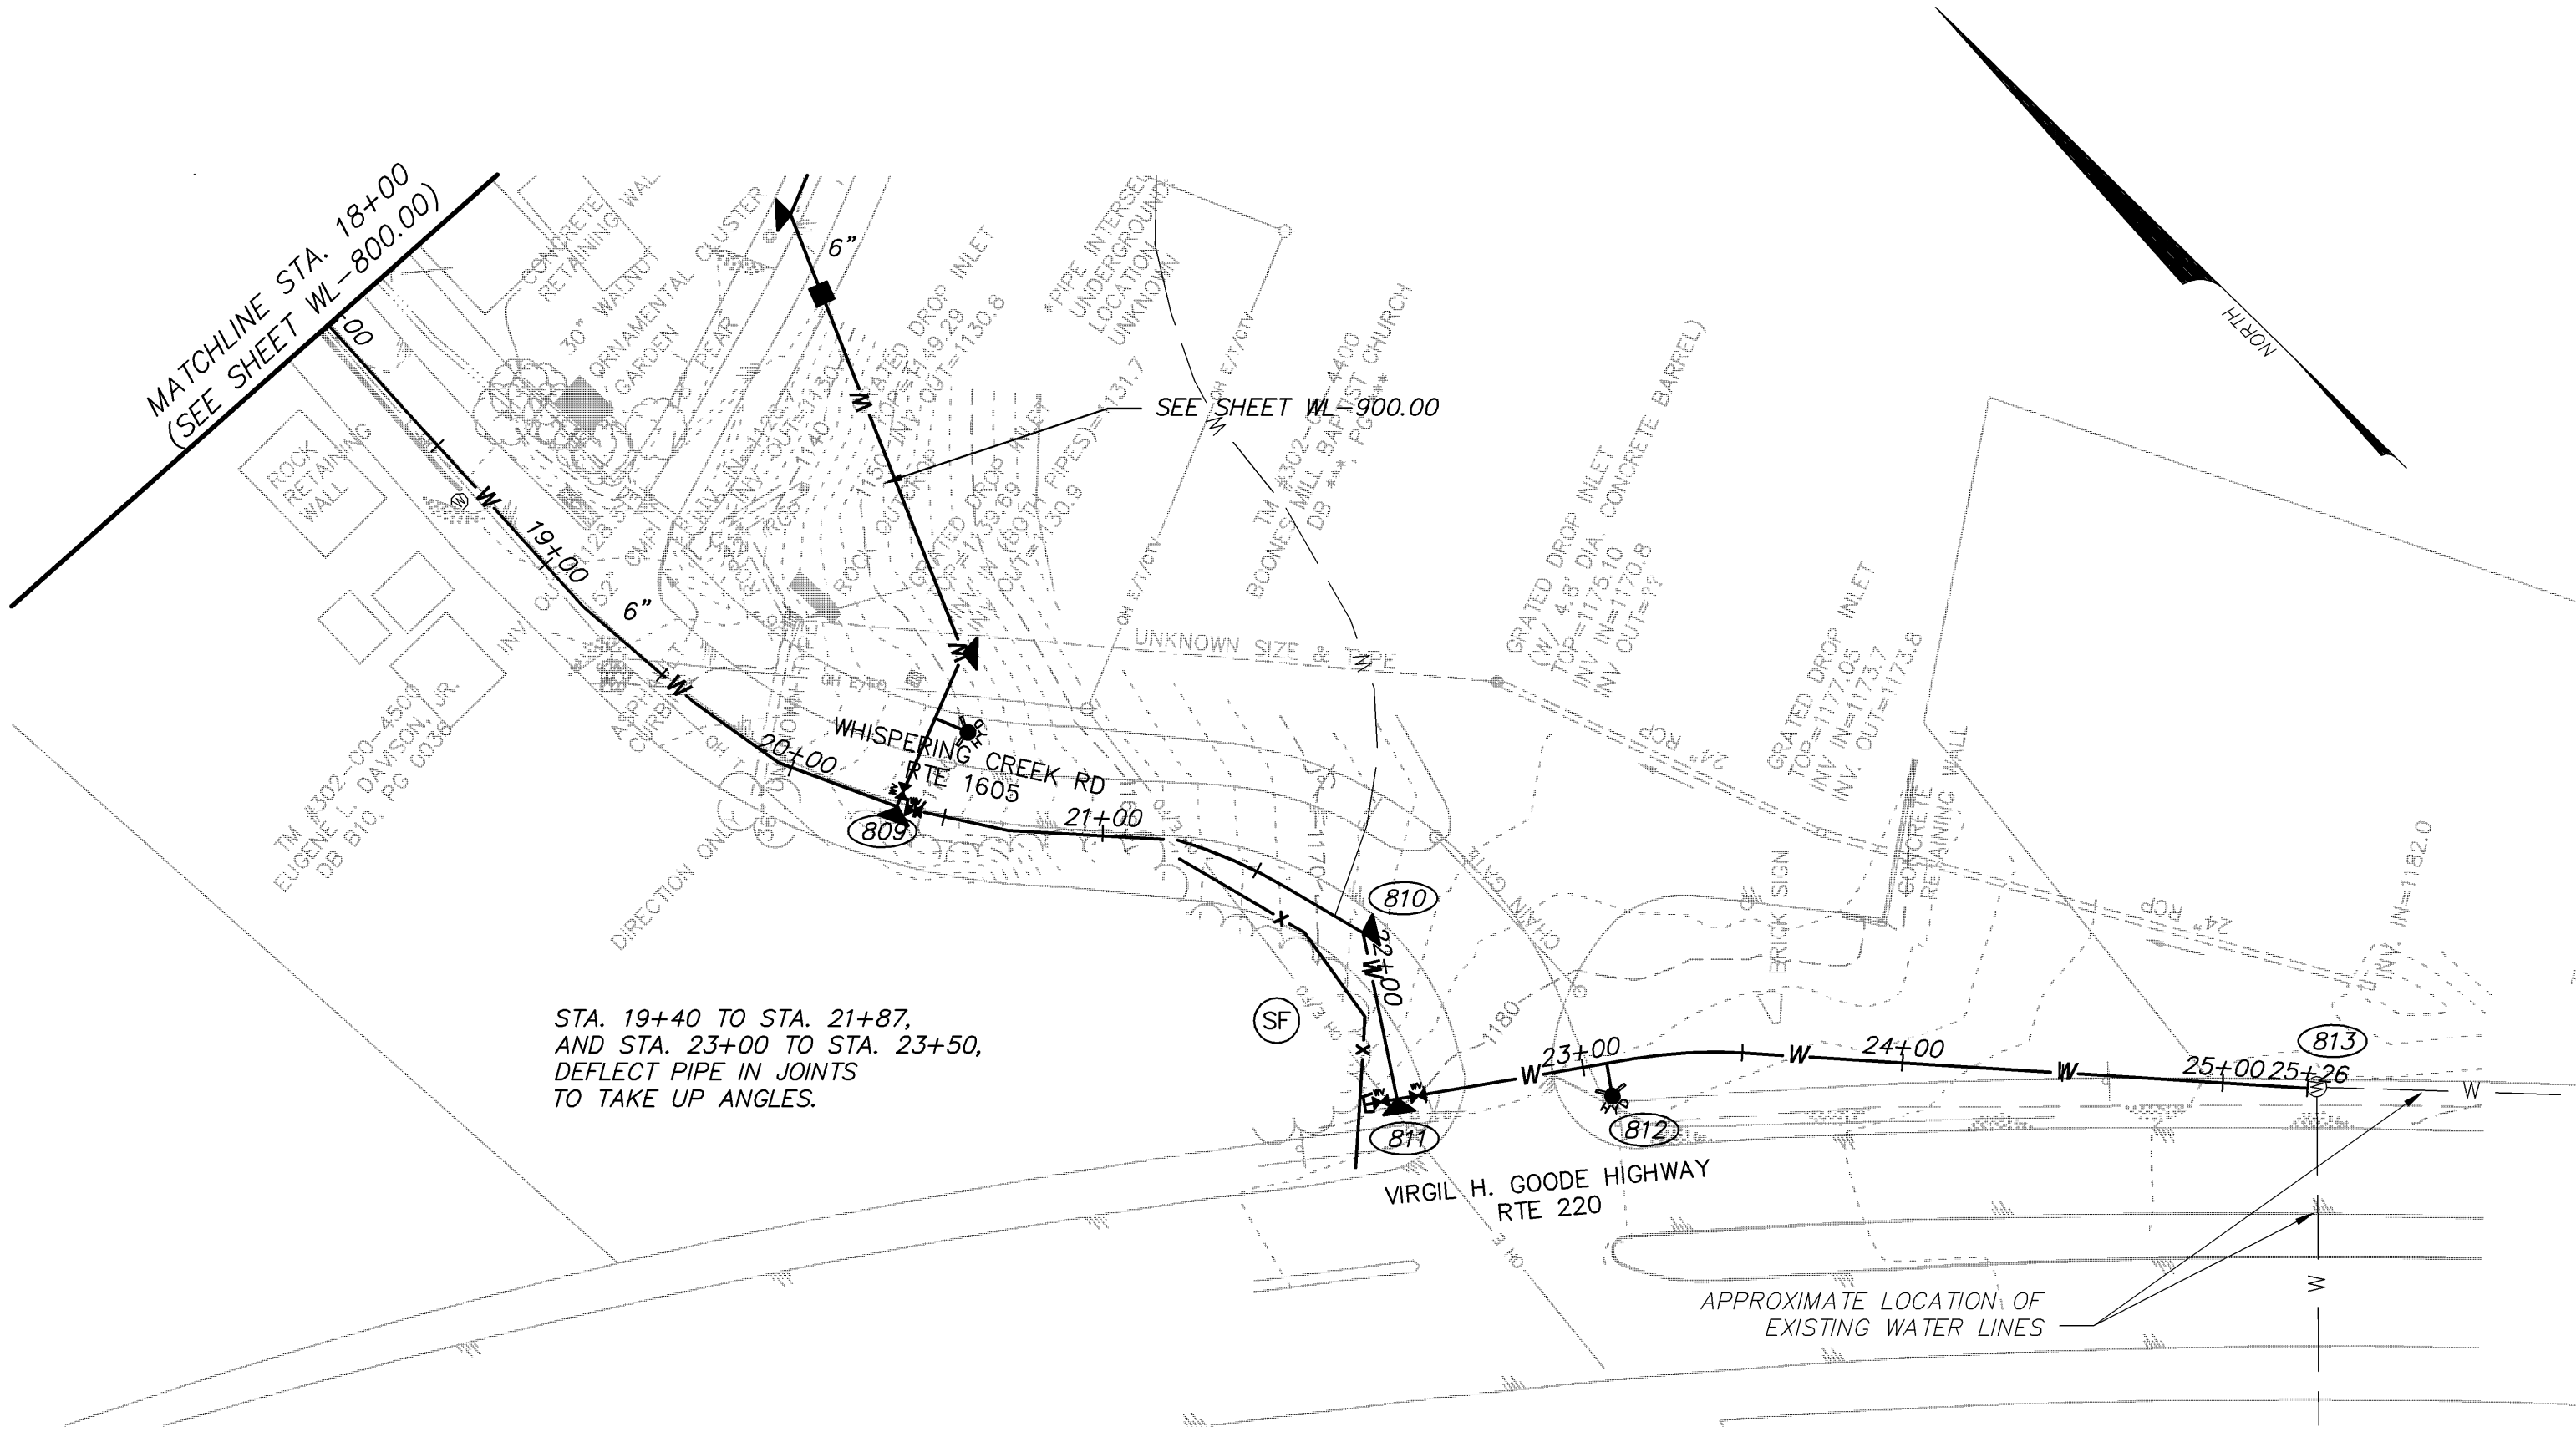

PROPOSED LEGEND

- ⊗ WATER METER
- W— WATER LINE
- BLOW OFF ASSEMBLY
- ⬢ AIR RELEASE
- ⊕ FIRE HYDRANT
- ⊕ CONCRETE ANCHOR
- ⊕ GATE VALVE
- ⊕ STEEL CASING
- △ SLOPE ANCHOR
- E.O.L. END OF LINE

EXISTING LEGEND

- ⊕ ELECTRIC POLE
- ⊕ GUY WIRE
- ⊕ UTILITY PEDESTAL
- ⊕ LIGHT POLE
- P— EDGE OF PAVEMENT
- G— EDGE OF GRAVEL
- ⊕ BENCHMARK
- ⊕ SIGN
- ⊕ CONCRETE PAD
- E— EDGE OF WOODS
- F— EXISTING FENCE LINE
- E— OVERHEAD ELECTRIC
- G— UG GAS LINE
- T— UG TELEPHONE LINE
- FO— UG FIBER OPTIC LINE
- W— UG WATER LINE
- DITCH LINE

\*ENGINEERING >> SURVEYING >> PLANNING

**HURT & PROFFITT**  
INCORPORATED  
2524 LANGHORNE ROAD  
LYNCHBURG VA 24501  
800.242.6906 TOLL FREE  
434.847.7796 MAIN  
434.847.0047 FAX


STA. 18+00 - 25+26± EOL WHISPERING CREEK ROAD-ASBUILT  
FOR  
TOWN OF BOONES MILL WATER SYSTEM REPLACEMENT, VOLUME 1  
TOWN OF BOONES MILL, BOONE DISTRICT, FRANKLIN COUNTY, VA

PROJECT NO.	20080815
G.L. NO.	297-03-A3.9
FILE NO.	G-12675
DATE:	7/31/09
DRAWN BY:	WCH
CHECKED BY:	BLC

**HURT & PROFFITT**

SHEET NO.  
**WL-800.01**







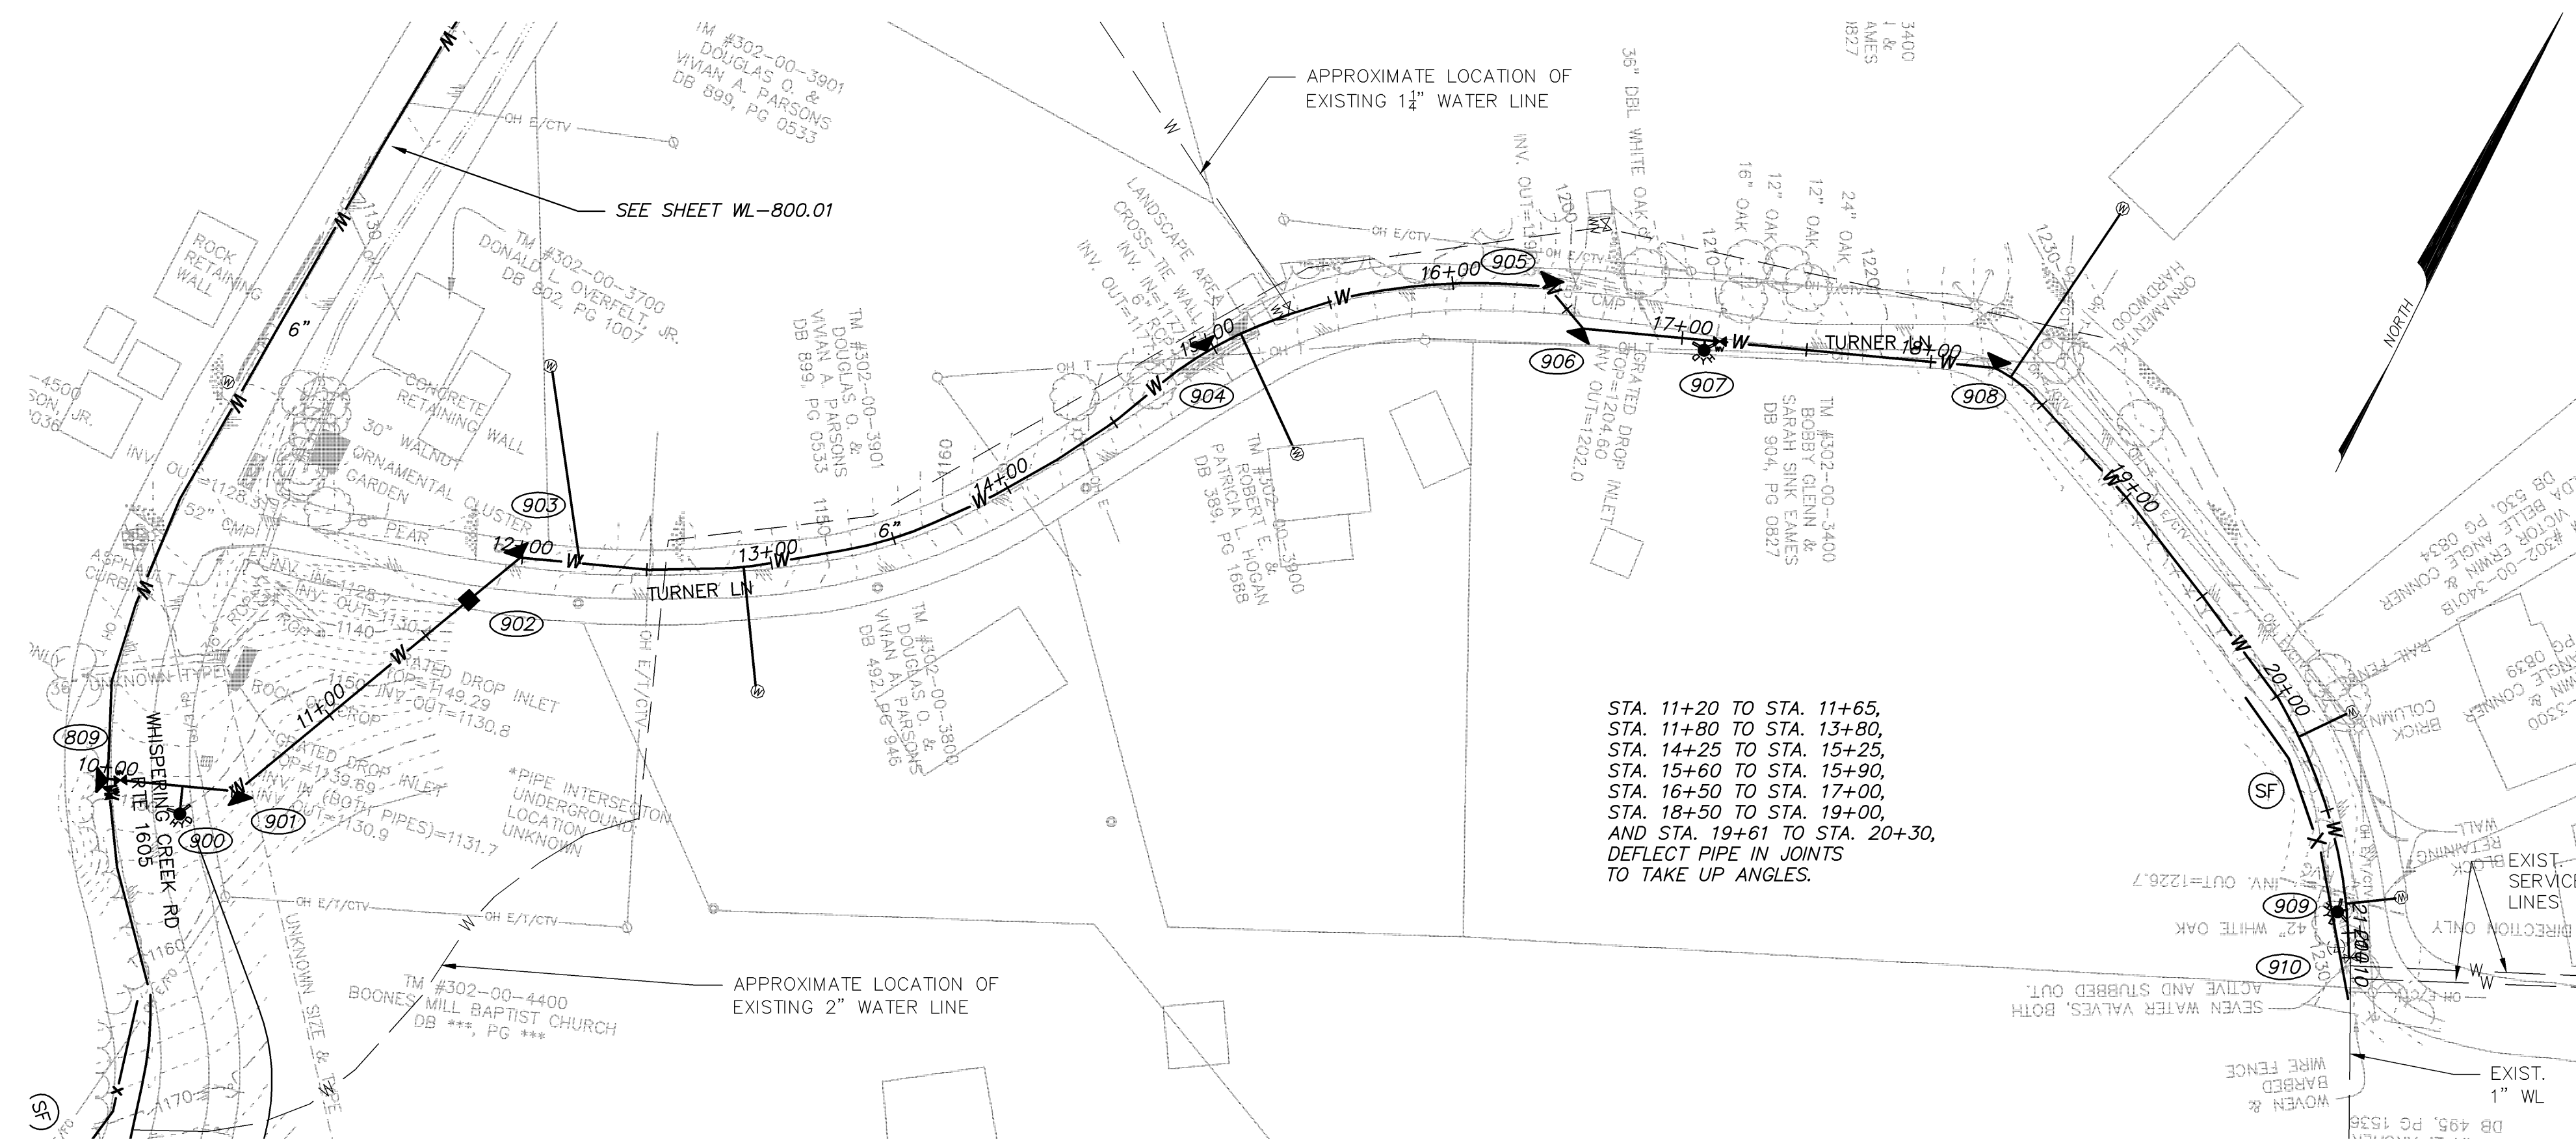

STA. 11+20 TO STA. 11+65,  
STA. 11+80 TO STA. 13+80,  
STA. 14+25 TO STA. 15+25,  
STA. 15+60 TO STA. 15+90,  
STA. 16+50 TO STA. 17+00,  
STA. 18+50 TO STA. 19+00,  
AND STA. 19+61 TO STA. 20+30,  
DEFLECT PIPE IN JOINTS  
TO TAKE UP ANGLES.

6" PVC WITH BELL RESTRAINTS FROM:  
STA. 10+80 - 12+58  
STA. 20+15 - 21+10

PROFILE INFORMATION TAKEN FROM RECORD DRAWINGS	
1	2
3	4
5	6
99	100

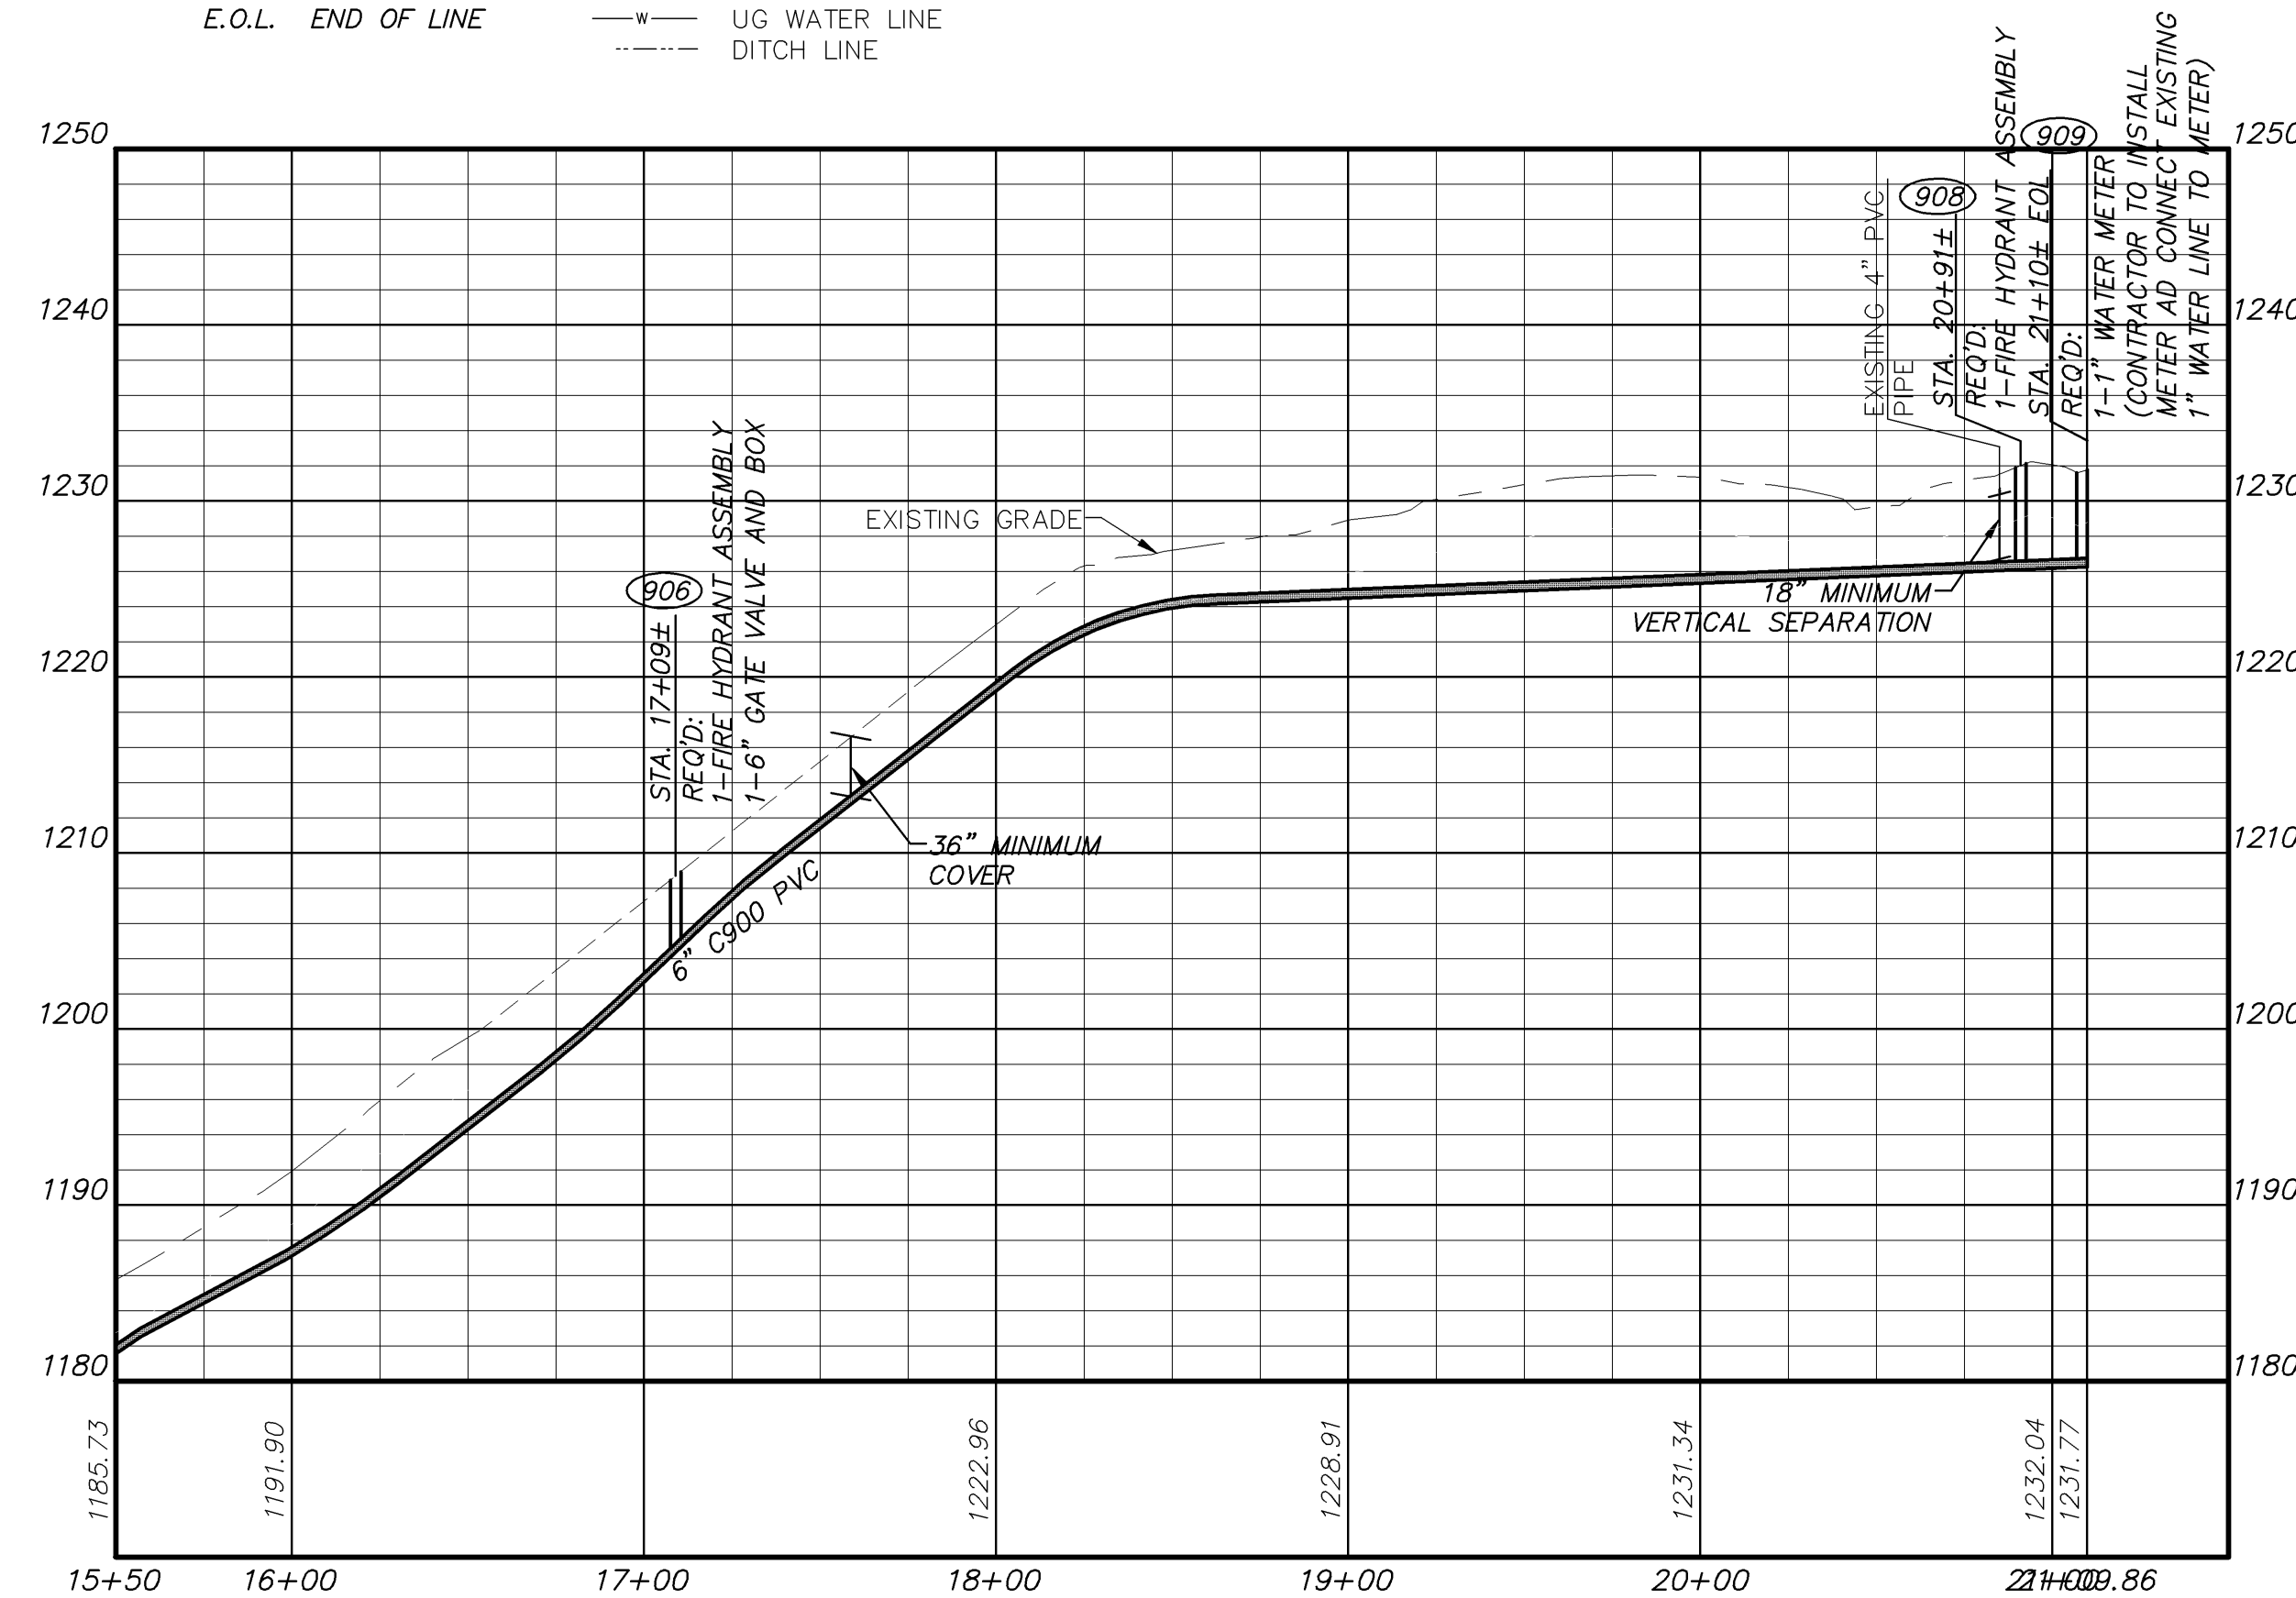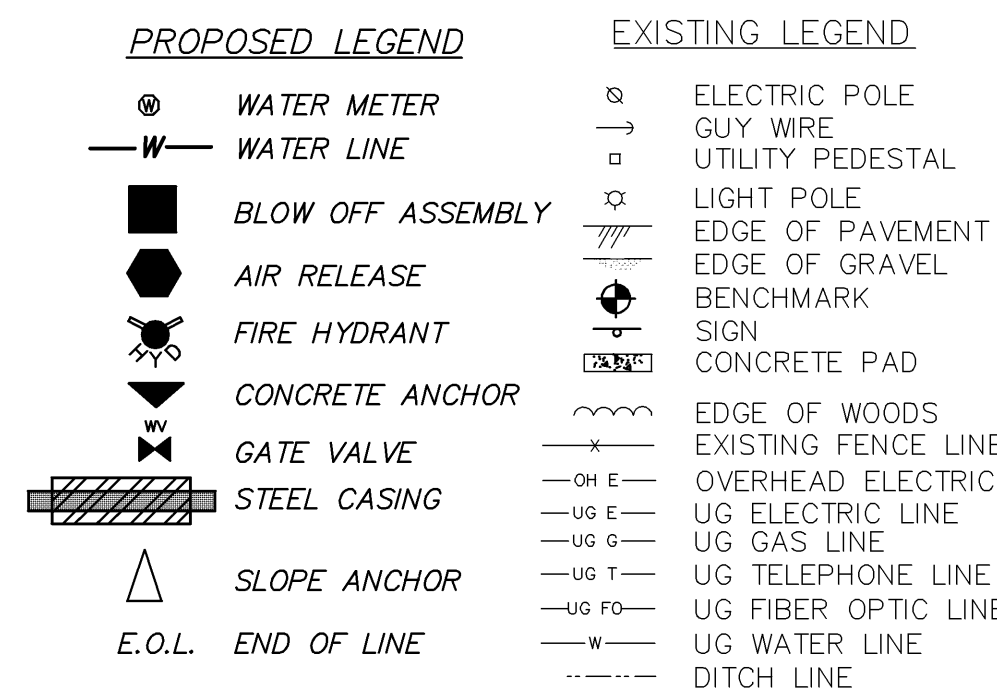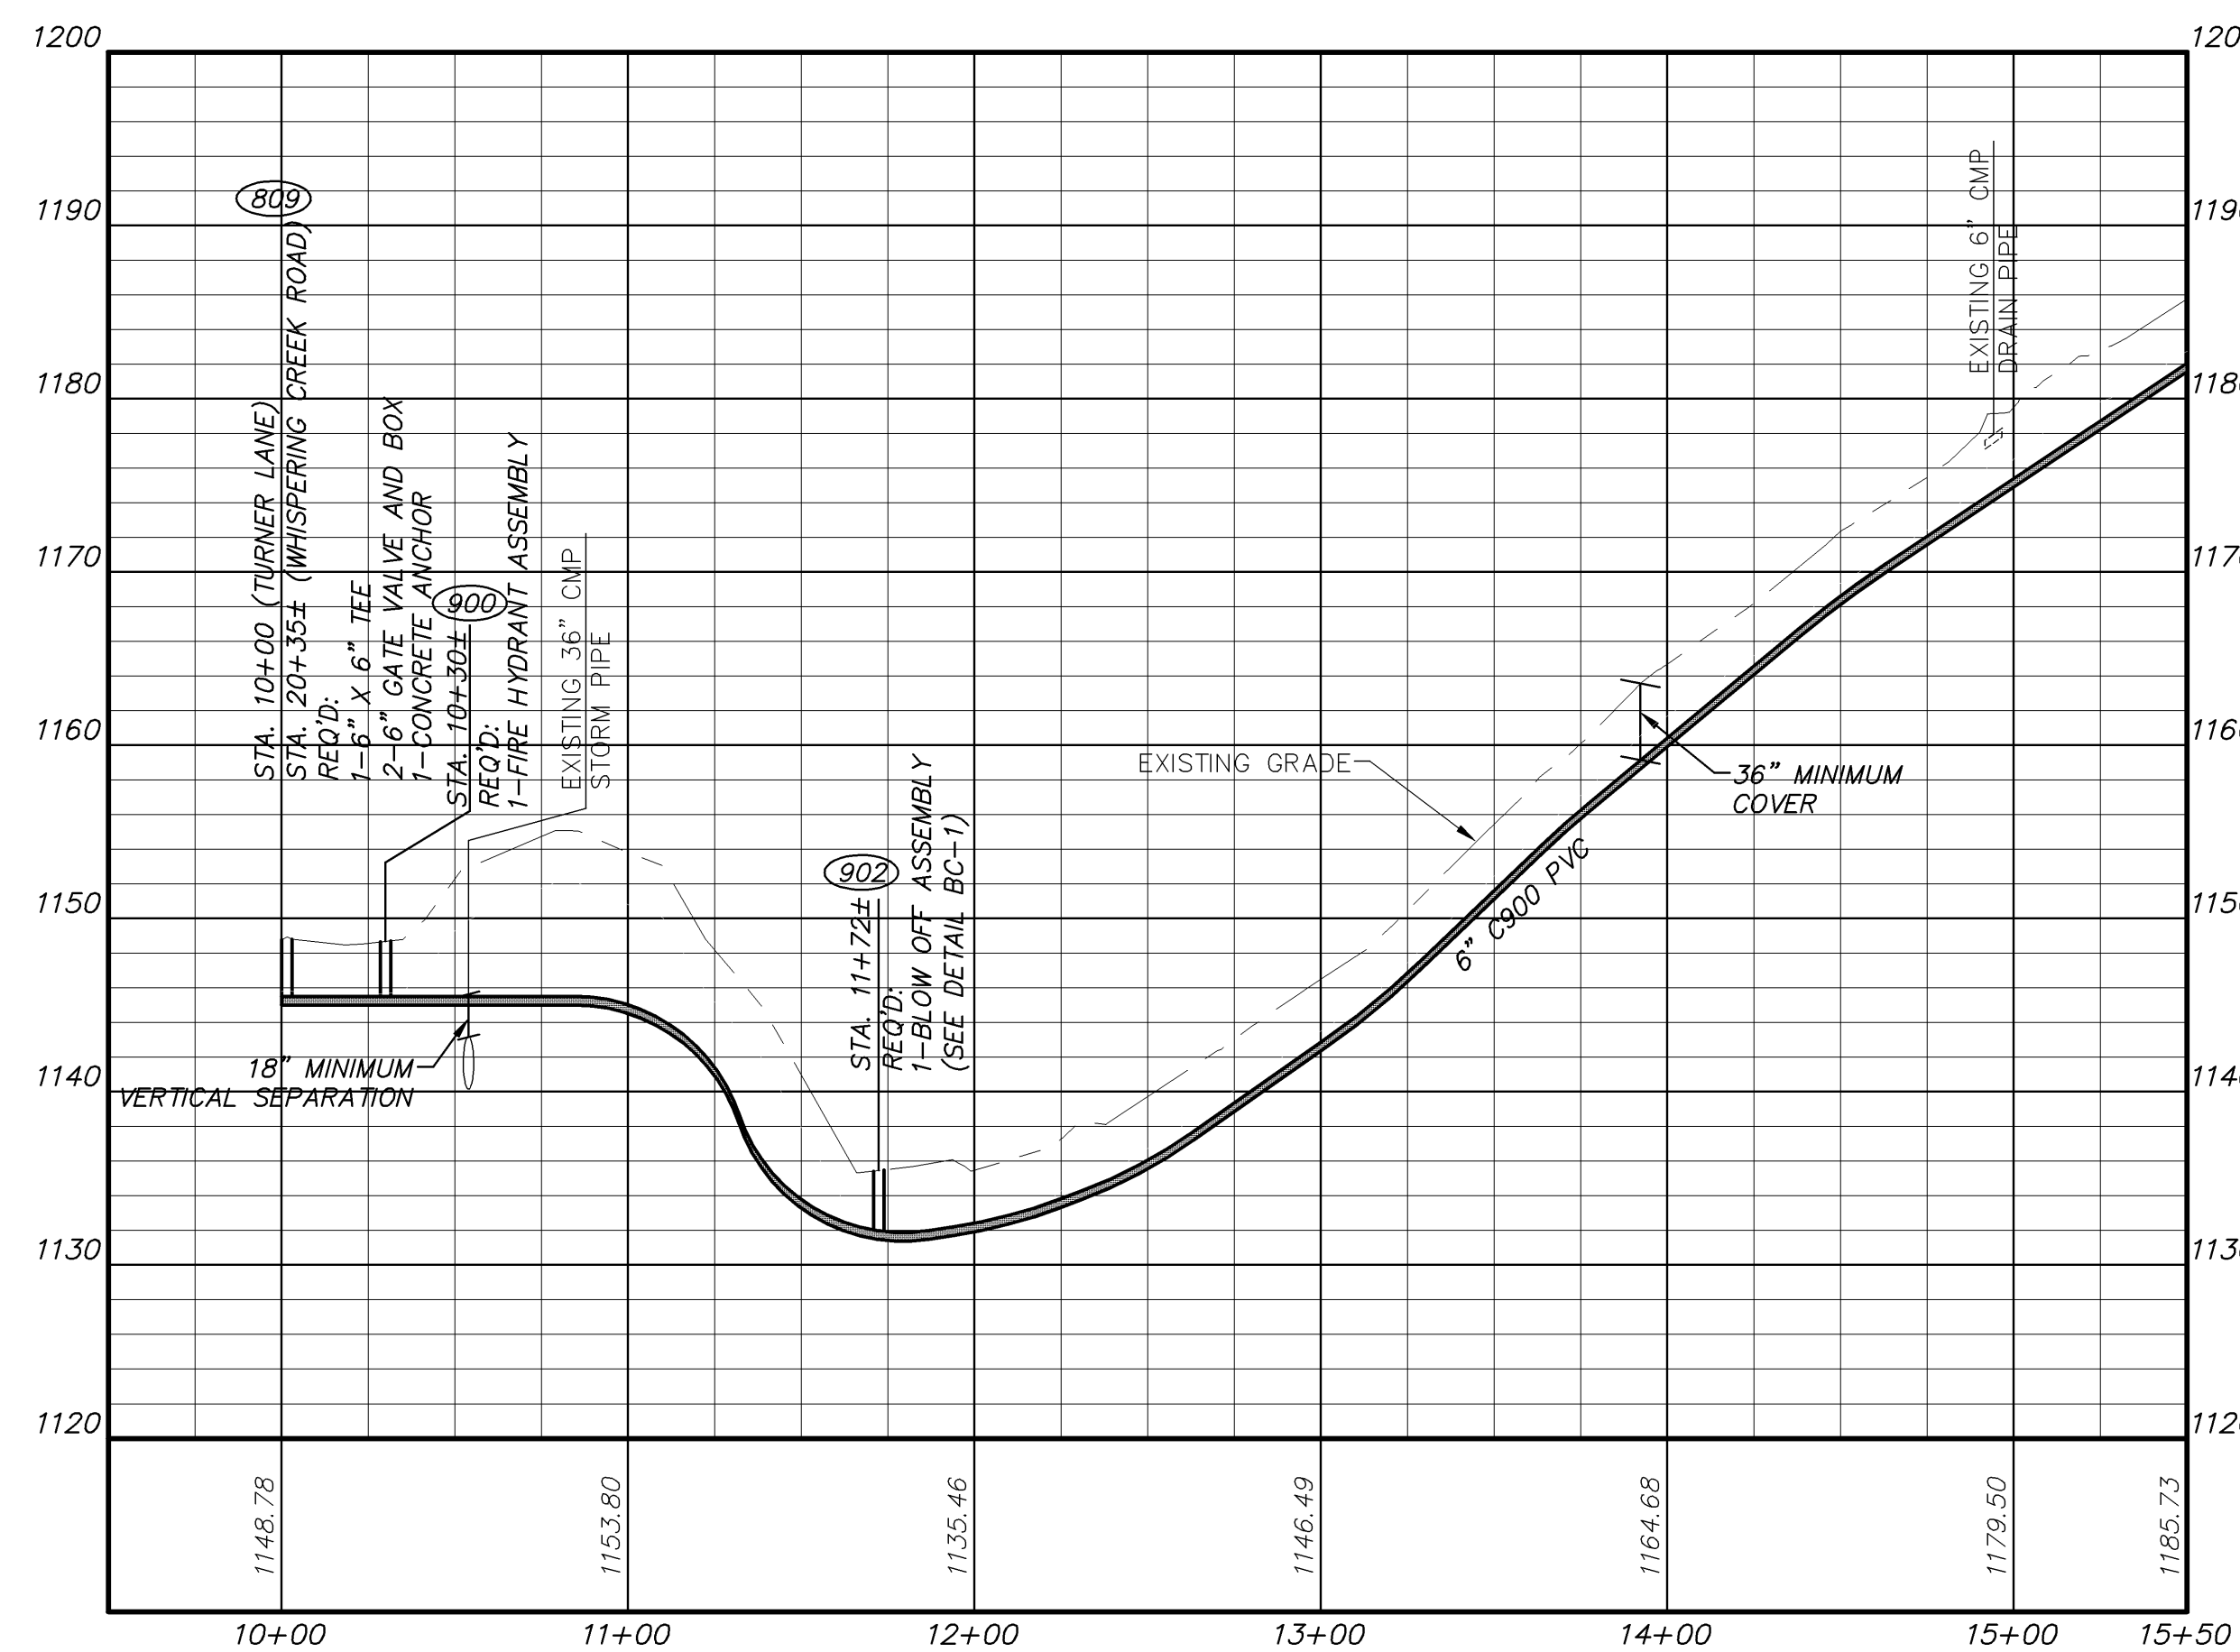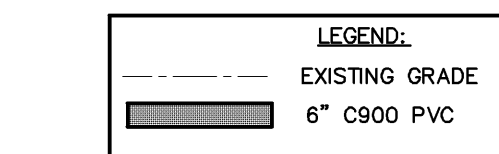

WATER LINE STRUCTURE  
SCHEDULE

(809) STA. 10+00 (TURNER LANE)  
STA. 20+35± (WHISPERING CREEK ROAD)  
1-6" X 6" TEE  
2-6" GATE VALVE AND BOX  
1-CONCRETE ANCHOR

(900) STA. 10+30±  
REQ'D:  
1-FIRE HYDRANT ASSEMBLY

(901) STA. 10+52±  
REQ'D:  
1-6" 45° BEND  
1-CONCRETE ANCHOR

(902) STA. 11+72±  
REQ'D:  
1-BLOW OFF ASSEMBLY  
(SEE DETAIL BC-1)

(903) STA. 11+99±  
REQ'D:  
1-6" 45° BEND  
1-CONCRETE ANCHOR

(904) STA. 14+97±  
REQ'D:  
1-6" 11.25° BEND  
1-CONCRETE ANCHOR

(905) STA. 16+38±  
REQ'D:  
1-6" 45° BEND  
1-CONCRETE ANCHOR

(906) STA. 16+60±  
REQ'D:  
1-6" 45° BEND  
1-CONCRETE ANCHOR

(907) STA. 17+09±  
REQ'D:  
1-FIRE HYDRANT ASSEMBLY  
1-6" GATE VALVE AND BOX

(908) STA. 18+25±  
REQ'D:  
1-6" 22.5° BEND  
1-CONCRETE ANCHOR

(909) STA. 20+91±  
REQ'D:  
1-FIRE HYDRANT ASSEMBLY

(910) STA. 21+10± EOL  
REQ'D:  
1-1" WATER METER  
(CONTRACTOR TO INSTALL METER AD  
CONNECT EXISTING 1" WATER LINE TO  
METER)

**\* ENGINEERING >> SURVEYING >> PLANNING**

**HURT & PROFFITT**  
INCORPORATED  
2574 LANGHORNE ROAD  
LYNCHBURG VA 24501  
800.242.4806 TOLL FREE  
434.847.7796 MAIN  
434.847.0047 FAX



\*ENGINEERING >> SURVEYING >> PLANNING

**STA. 10+00 - 21+10± EOL TURNER LANE-ASBUILT  
FOR  
TOWN OF BOONES MILL WATER SYSTEM REPLACEMENT, VOLUME 1  
TOWN OF BOONES MILL- BOONE DISTRICT, FRANKLIN COUNTY, VA**

PROJECT NO.	20080815
G.L. NO.	297-03-A3.9
FILE NO.	G-12675
DATE:	7/31/09
DRAWN BY:	WCH
CHECKED BY:	BLC

**HURT & PROFFITT**

SHEET NO.  
**WL-900.00**

1	8/28/09	VDH COMMENTS
2	9/3/09	OWNER COMMENTS
4	3/14/12	ASBUILTS

Mar 14, 2012 - 10:38am V:\LandProjects\20080815\dwg\asbults-WL-ASBULT-P-Water.dwg

LEGEND:	
	EXISTING GRADE
	6" C900 PVC

PROPOSED LEGEND	
	WATER METER
	WATER LINE
	BLOW OFF ASSEMBLY
	AIR RELEASE
	FIRE HYDRANT
	CONCRETE ANCHOR
	GATE VALVE
	STEEL CASING
	SLOPE ANCHOR
	E.O.L. END OF LINE
EXISTING LEGEND	
	ELECTRIC POLE
	GUY WIRE
	UTILITY PEDESTAL
	LIGHT POLE
	EDGE OF PAVEMENT
	EDGE OF GRAVEL
	BENCHMARK
	SIGN
	CONCRETE PAD
	EDGE OF WOODS
	EXISTING FENCE LINE
	OVERHEAD ELECTRIC
	UG ELECTRIC LINE
	UG GAS LINE
	UG TELEPHONE LINE
	UG FIBER OPTIC LINE
	UG WATER LINE
	DITCH LINE

DEPTH TO TOP OF CASING


STA. 10+10	3.50 FT
STA. 10+20	4.83 FT
STA. 10+30	6.17 FT
STA. 10+40	6.83 FT
STA. 10+47	7.42 FT
STA. 10+61	7.25 FT
STA. 10+73	5.75 FT
STA. 10+83	4.00 FT
STA. 11+02	3.50 FT

6" HDPE PIPE FROM STA. 10+00 TO 11+04±

6" PVC PIPE FROM STA. 11+04 TO 14+46±

WATER LINE STRUCTURE  
SCHEDULE

1000	STA. 10+00 REQ'D: 1-12" X 6" TAPPING SLEEVE 1-6" TAPPING VALVE
1001	STA. 10+09± REQ'D: 1-6" 90° BEND 1-CONCRETE ANCHOR
1002	STA. 12+60± REQ'D: 1-6" 90° BEND 1-CONCRETE ANCHOR
1003	STA. 12+83± REQ'D: 1-6" 90° BEND 1-CONCRETE ANCHOR
1004	STA. 19+54± REQ'D: 1-FIRE HYDRANT ASSEMBLY
1005	STA. 24+46± EOL REQ'D: 1-2" BLOW OFF ASSEMBLY 1-6" GATE VALVE AND BOX

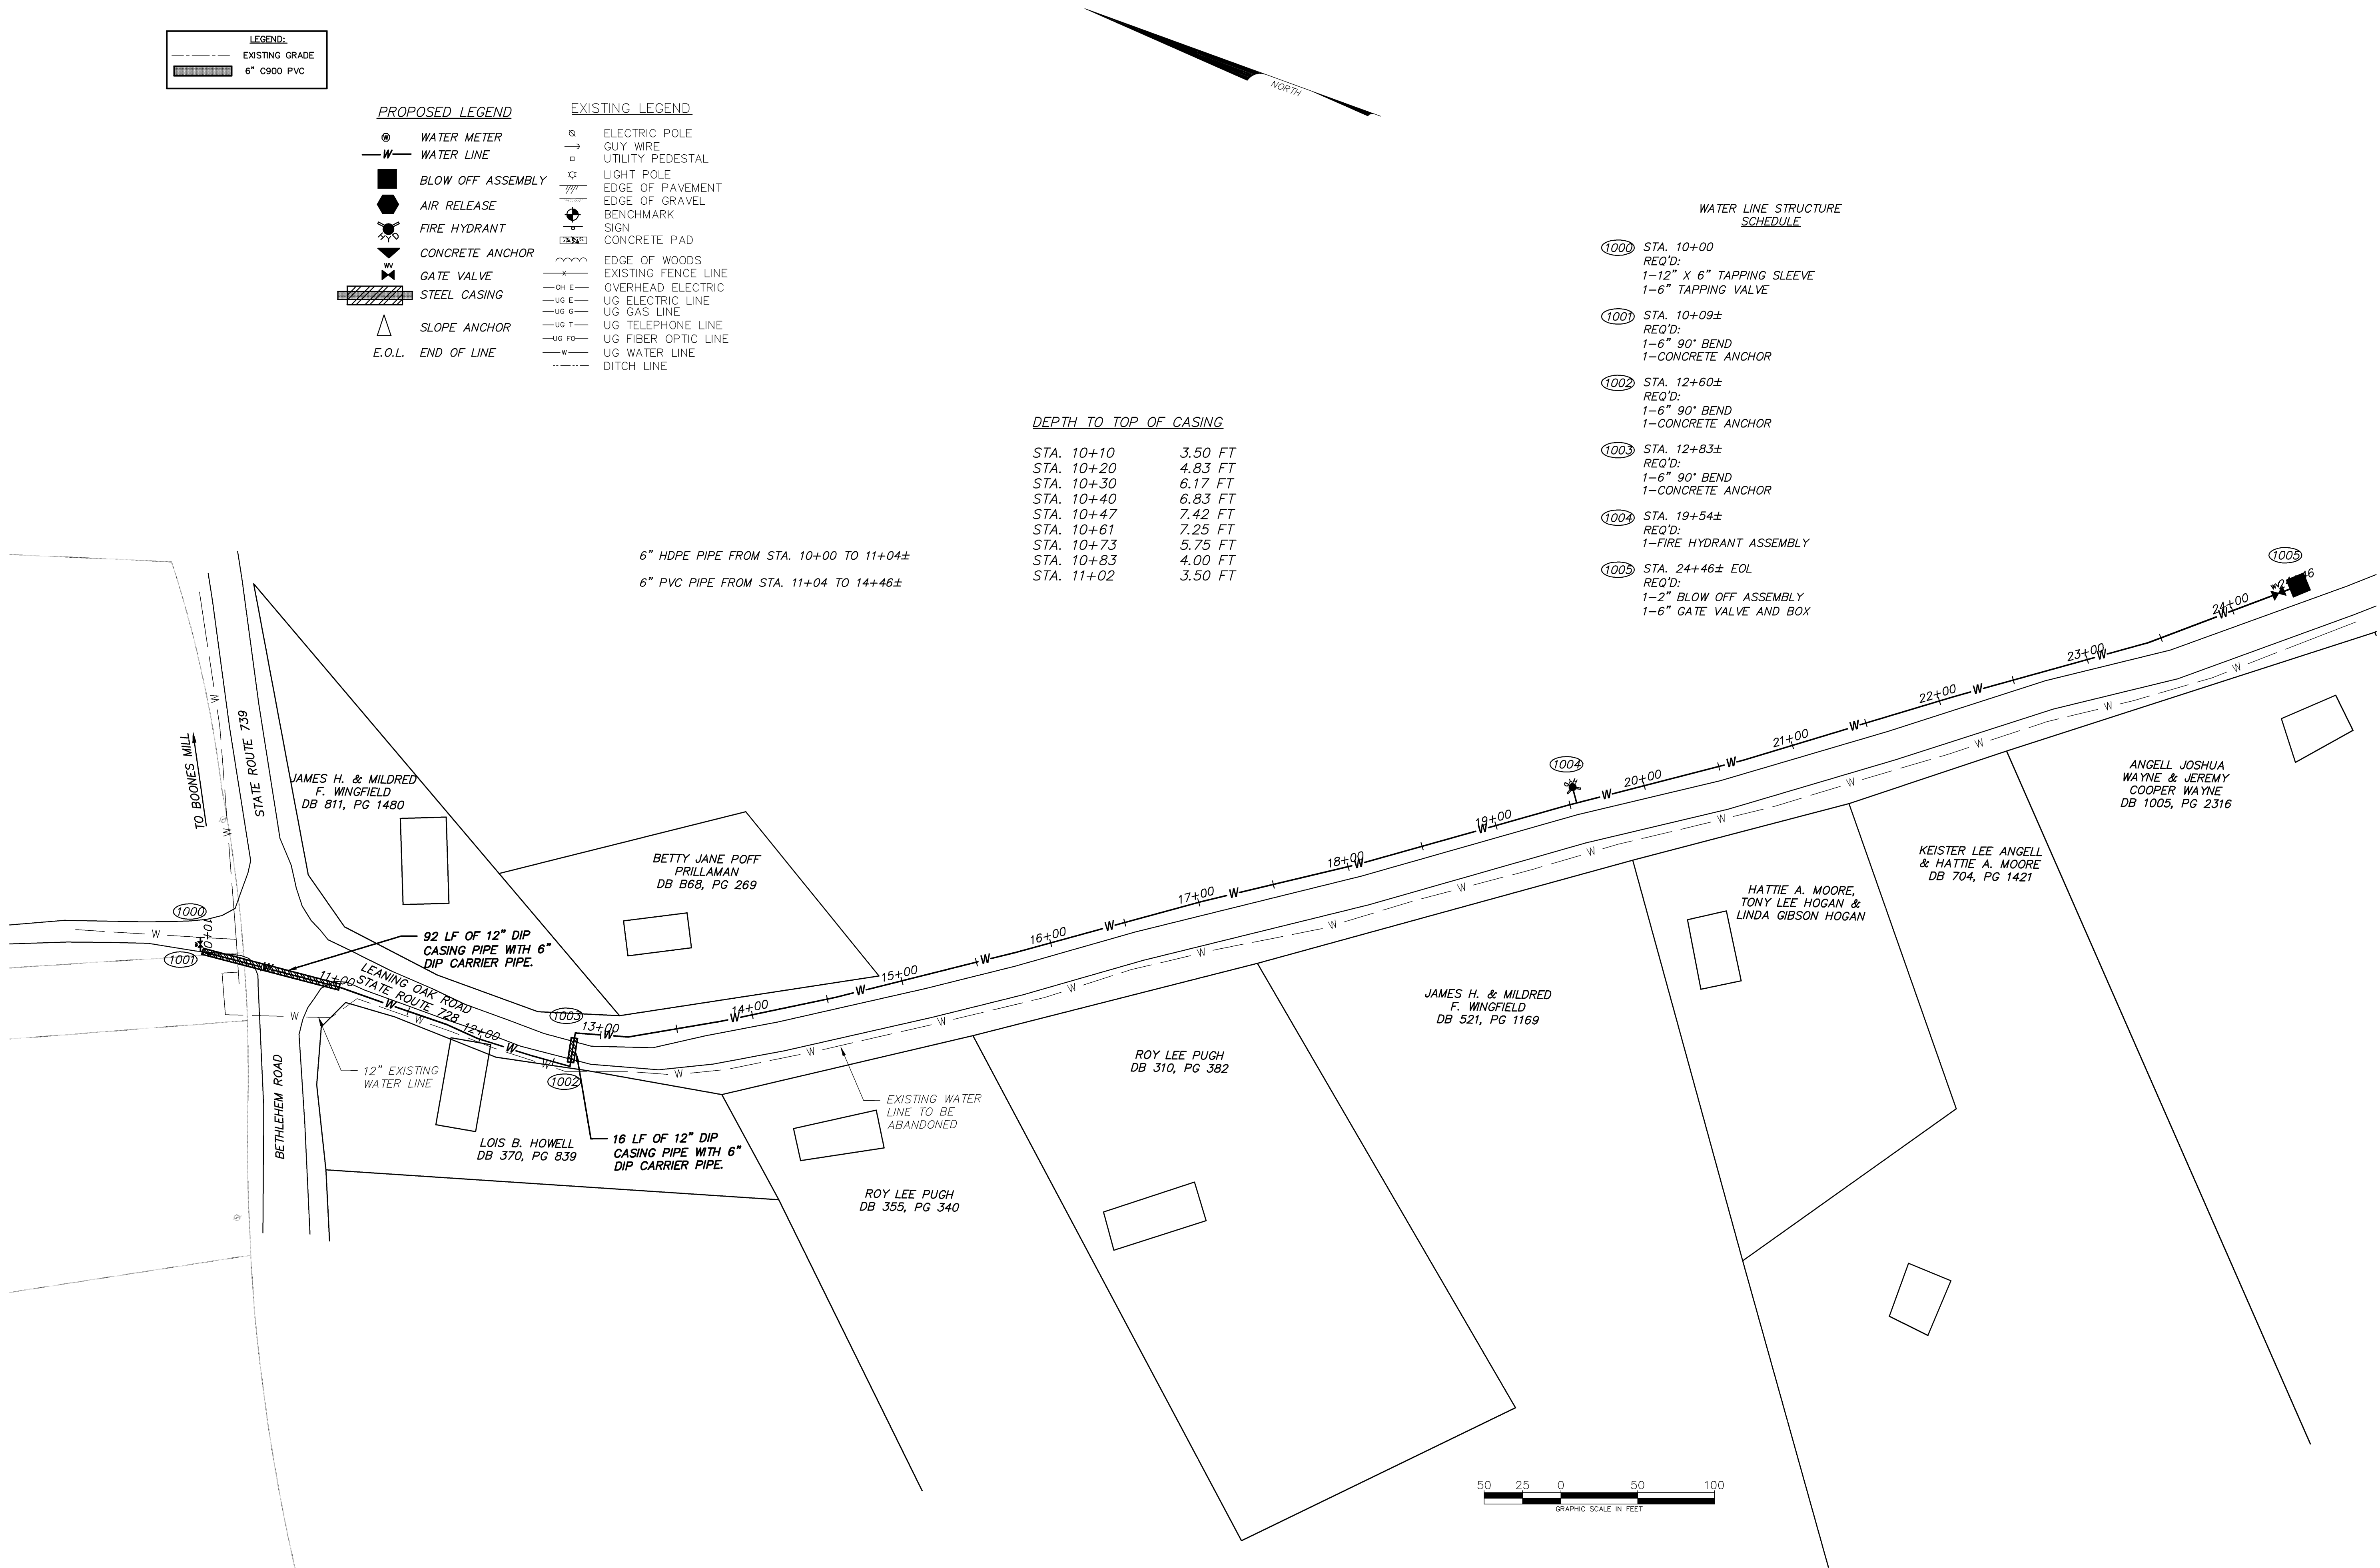

\*ENGINEERING >> SURVEYING >> PLANNING

**HURT & PROFFITT**  
INCORPORATED  
2524 LANGHORNE ROAD  
LYNCHBURG VA 24501  
800.242.6906 TOLL FREE  
434.847.7796 MAIN  
434.847.0047 FAX

**STA. 10+00 - 24+46± EOL LEANING OAK-ASBUILT**  
**FOR**  
**TOWN OF BOONES MILL WATER SYSTEM REPLACEMENT, VOLUME 1**  
**TOWN OF BOONES MILL, BOONE DISTRICT, FRANKLIN COUNTY, VA**

PROJECT NO.	20080815
G.L. NO.	297-03-A3.9
FILE NO.	G-12675
DATE:	7/31/09
DRAWN BY:	WCH
CHECKED BY:	BLC



**HURT & PROFFITT**

SHEET NO.  
**WL-1000.00**




0000

Mar 14, 2012 10:38am V:\LandProjects\20080815\dwg\Asbuilts-WL\ASBUILD-Details.dwg

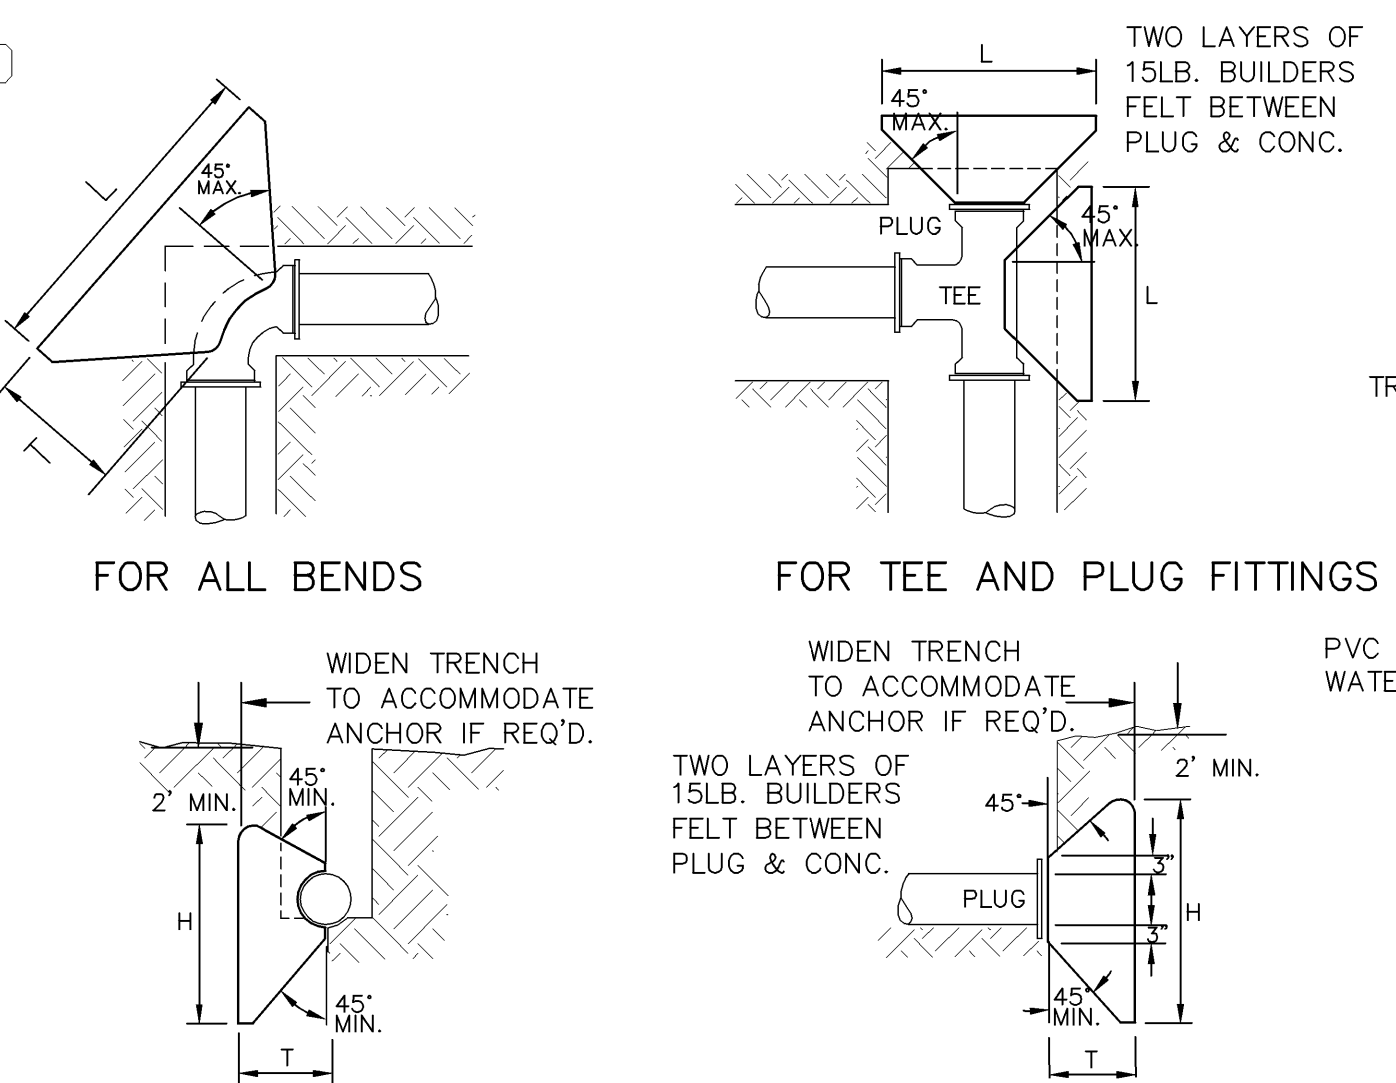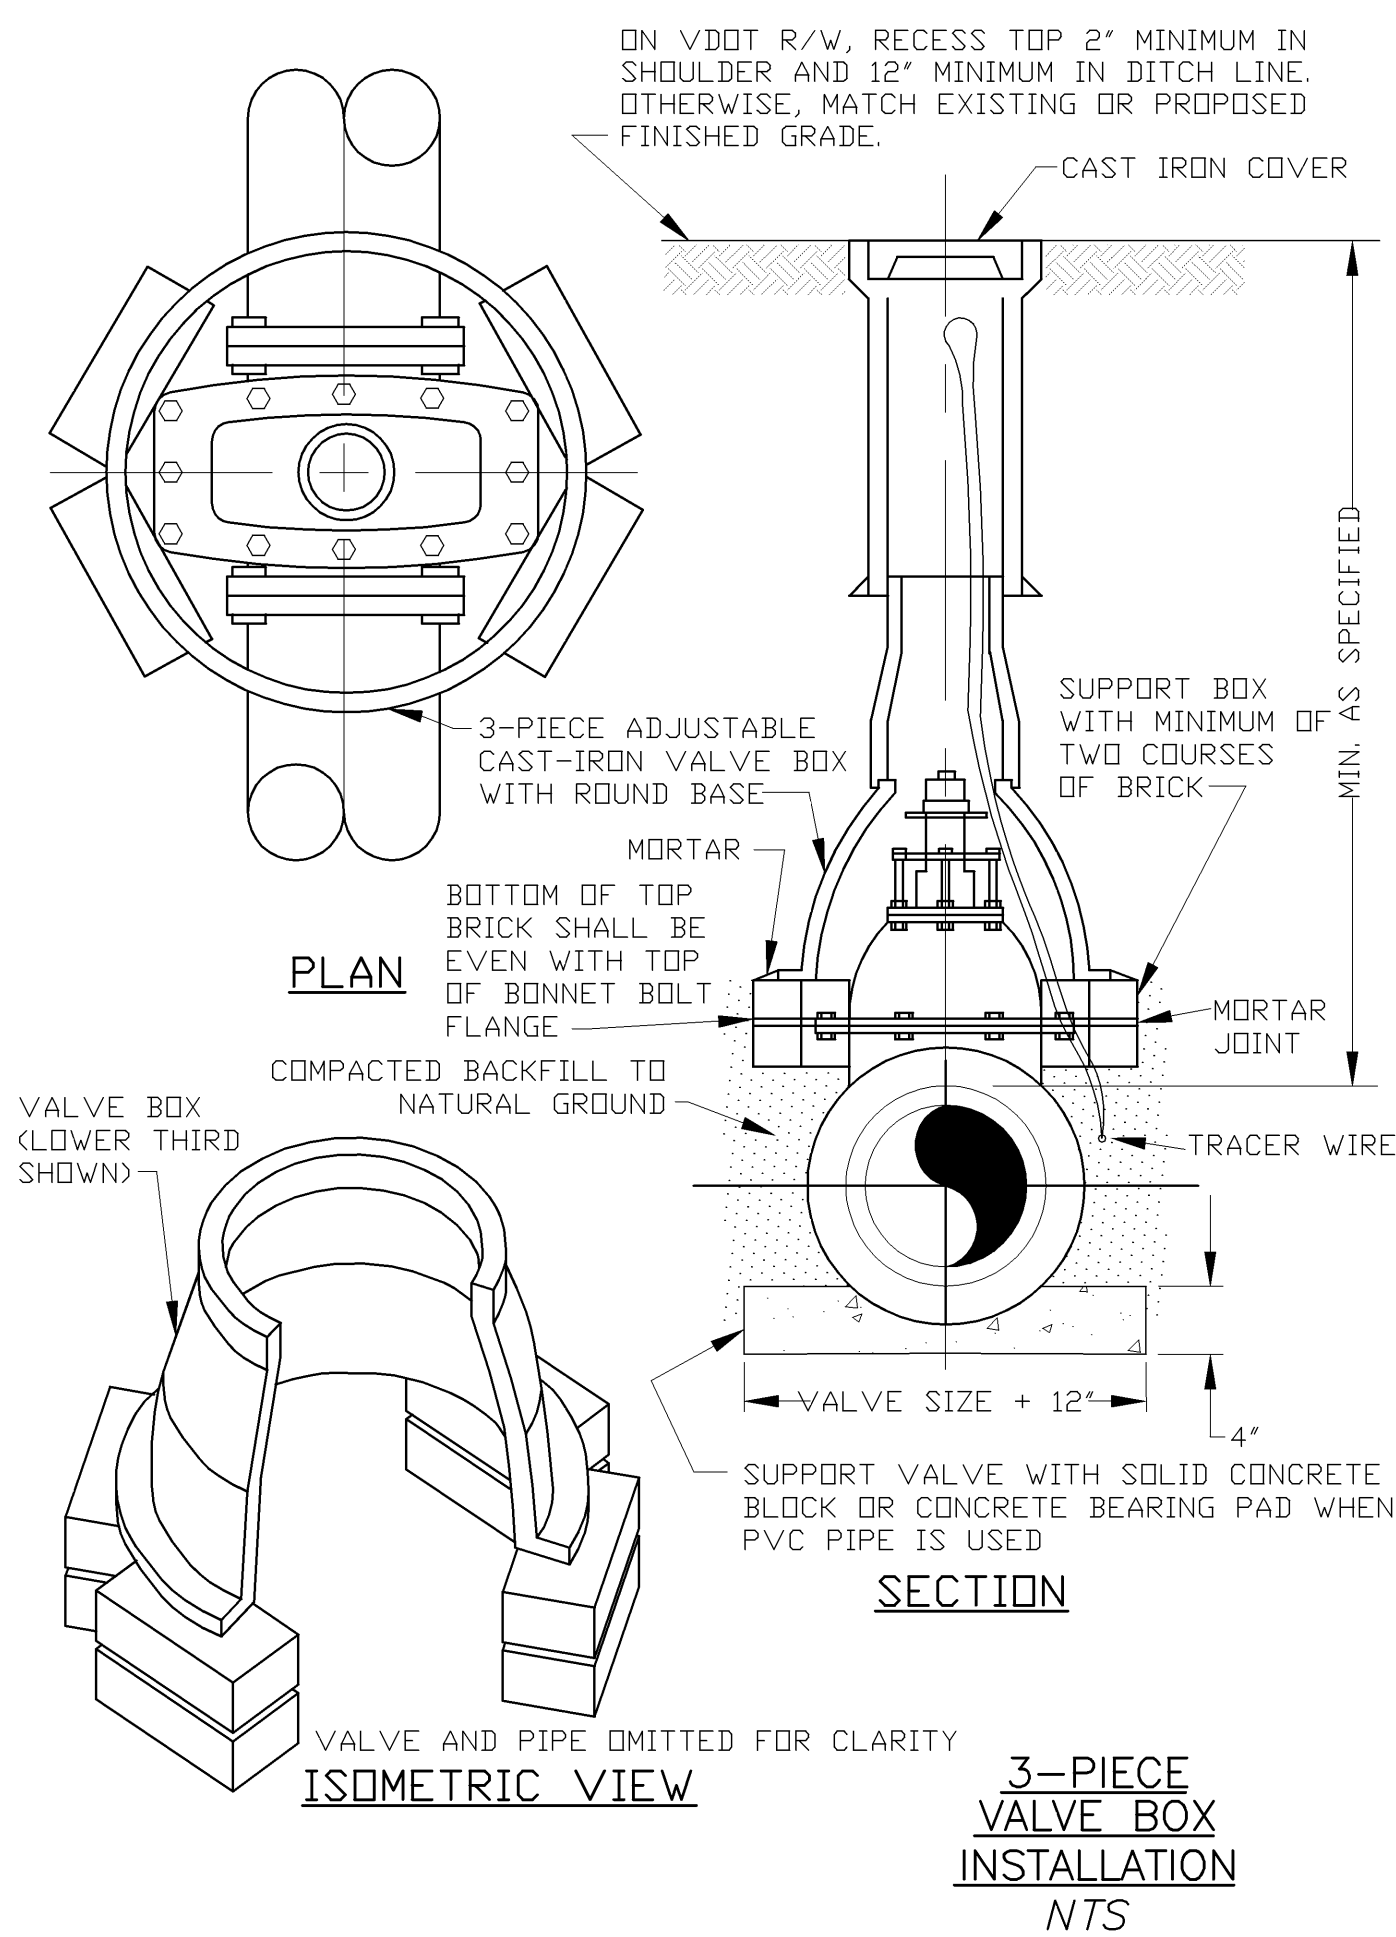


TYPE "F" ANCHOR BLOCK FOR 250 PSI WORKING PRESSURE					
TYPE FITTING	PIPE SIZE, INCH	DIMENSIONS (FT)			VOL. CONC. CU. YARDS
		L	H	T	
90°	4	2.33	2.33	2.81	0.19
45°	4	1.33	1.83	2.42	0.08
22.5°	4	1.33	1.83	2.35	0.07
11.25°	4	1.33	1.83	2.33	0.07
TEE	4	1.83	2.08	2.33	0.11
PLUG	4	1.83	2.08	2.33	0.11
90°	6	3.50	3.00	3.01	0.41
45°	6	2.50	2.50	2.60	0.21
22.5°	6	1.50	2.00	2.52	0.10
11.25°	6	1.50	2.00	2.50	0.10
TEE	6	3.00	2.75	2.50	0.26
PLUG	6	3.00	2.75	2.50	0.26
90°	8	4.75	3.74	3.21	0.71
45°	8	3.66	3.16	2.77	0.42
22.5°	8	2.40	2.41	2.69	0.19
11.25°	8	1.80	2.16	2.67	0.13
TEE	8	4.16	3.41	2.66	0.49
PLUG	8	4.16	3.41	2.66	0.49

CONCRETE ANCHOR BLOCK  
N.T.S.

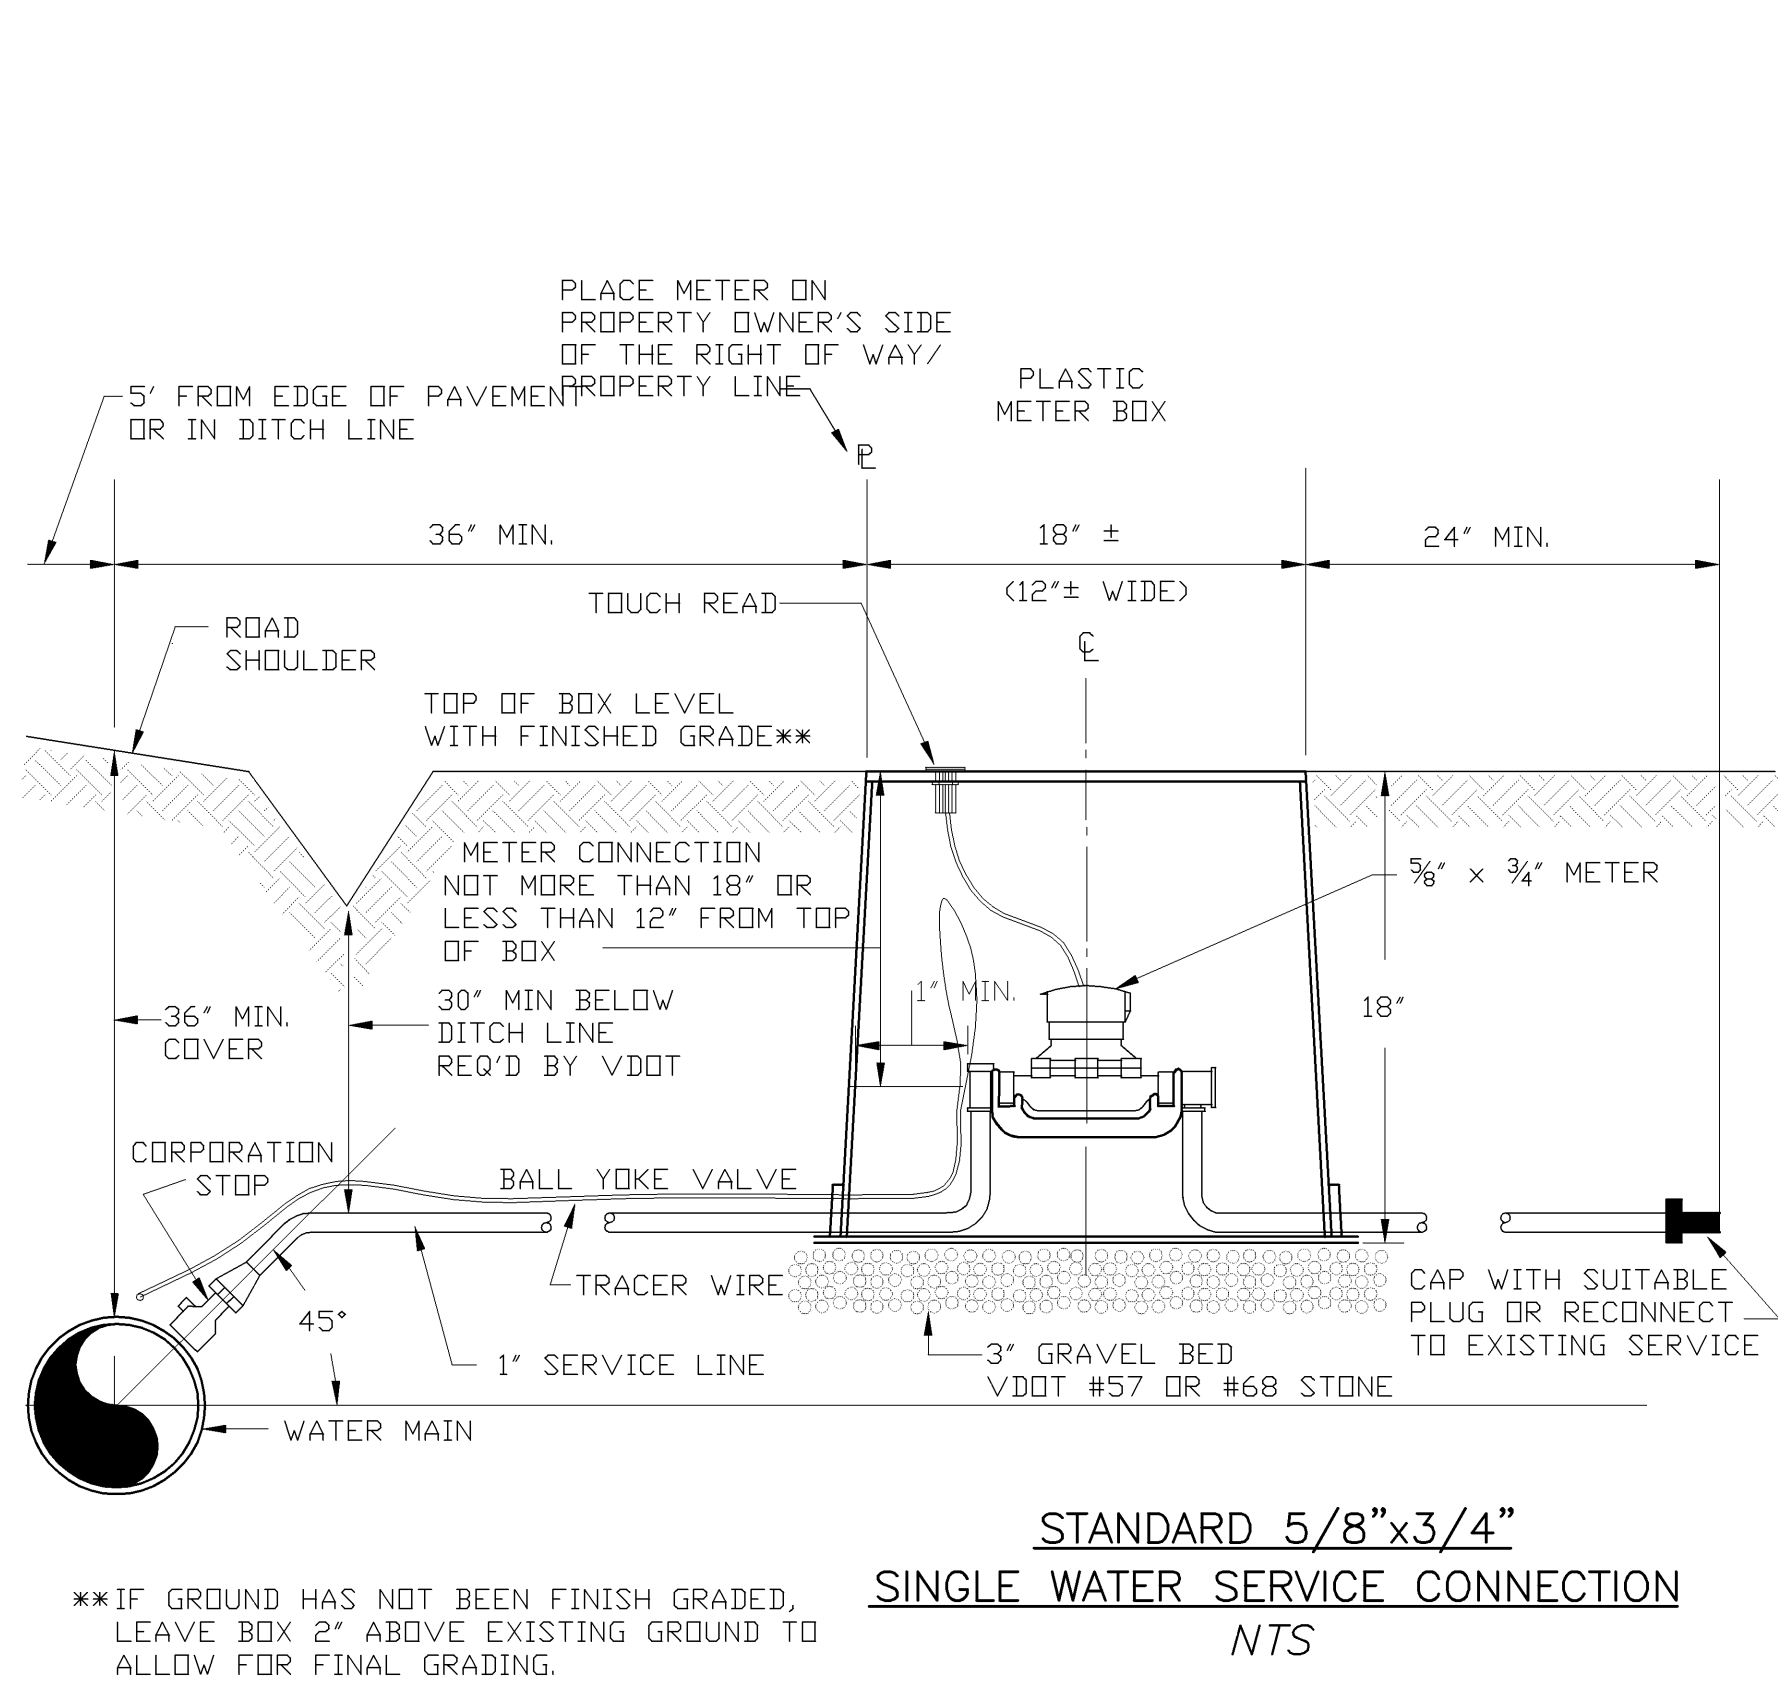


STANDARD 5/8"x3/4"  
SINGLE WATER SERVICE CONNECTION  
N.T.S.

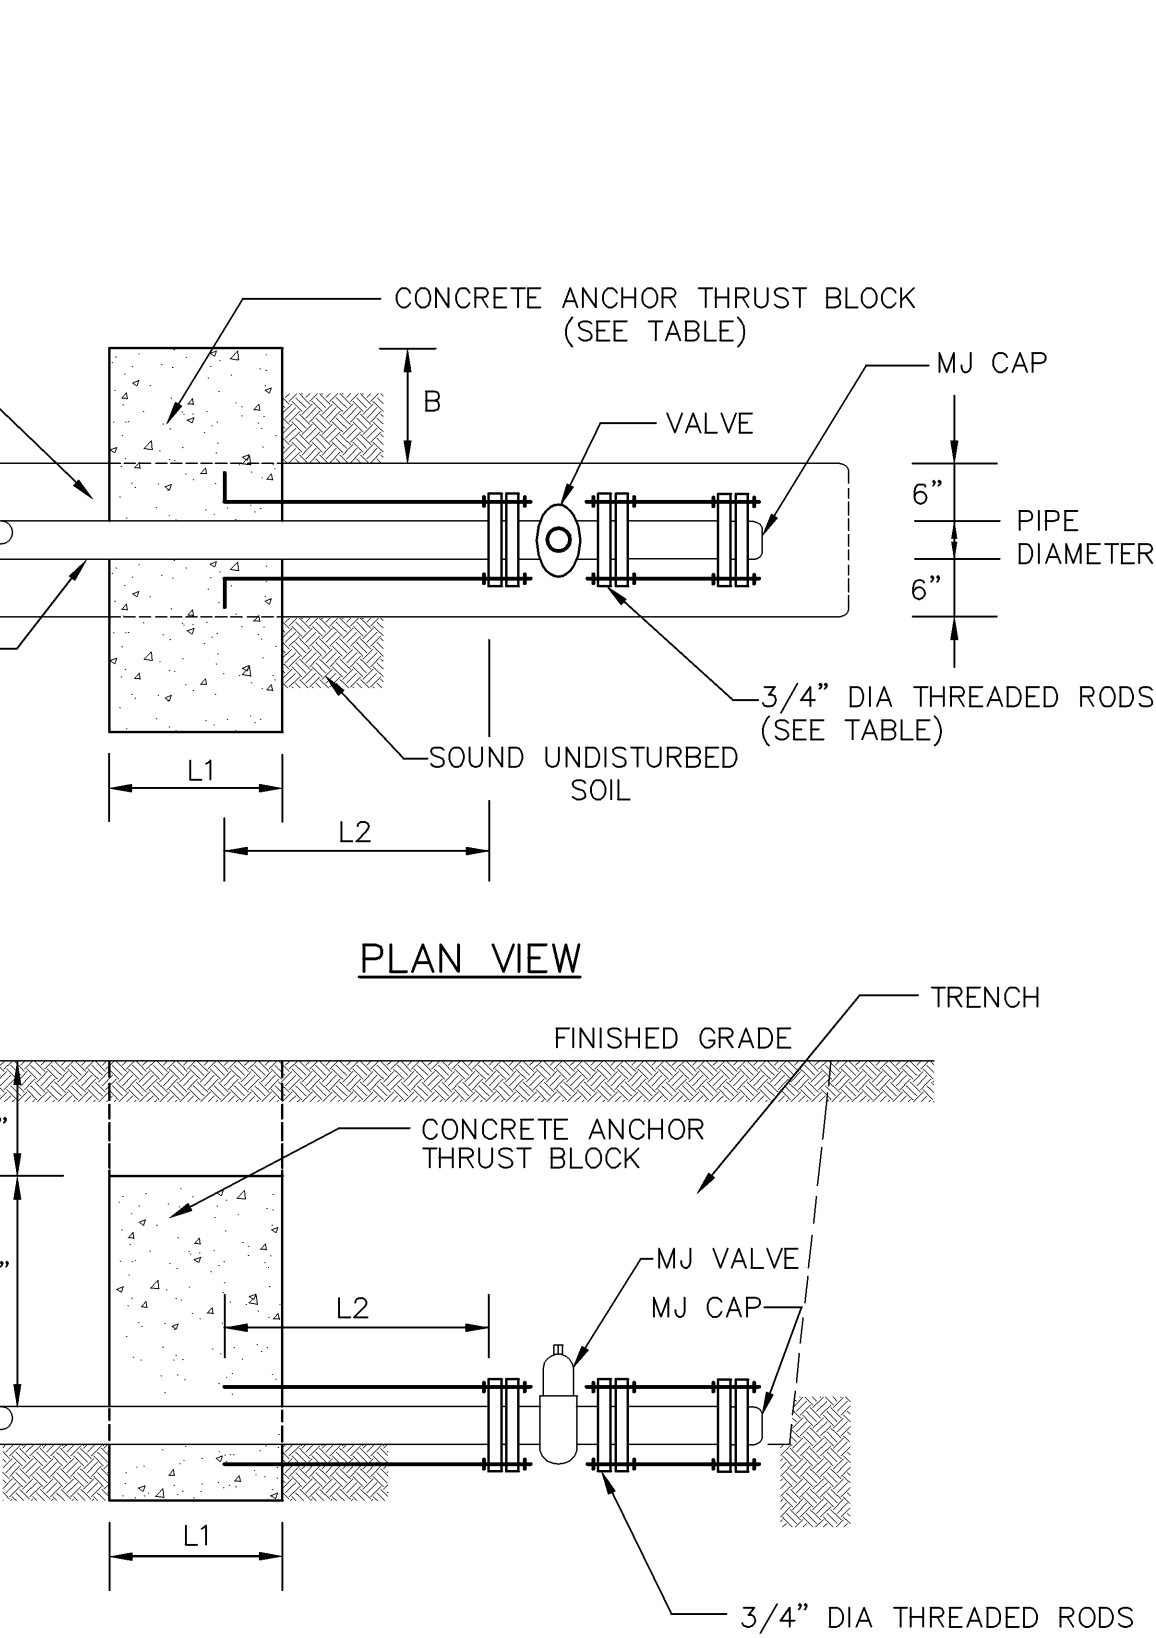


SECTION VIEW				
RETAINER GLAND FOR PVC PIPE SHALL BE SERIES 2000 PV, AND FOR DIP PIPE SERIES 100, BY EBAA IRON SALES, INC. "MEGA-LUG" OR APPROVED EQUAL				
PIPE DIAMETER (IN)	B MIN (IN)	L1 MIN (IN)	NUMBER OF RODS PER RETAINER	L2 MIN (IN)
4-8	12	18	4	27
10-12	27	33	4	50
14-16	44	50	6	75

NOTE: FOR USE WITH TEST OR WORKING PRESSURES 200 PSI OR LESS.  
WATERLINE BULKHEAD ANCHOR DETAIL CA-4  
N.T.S.

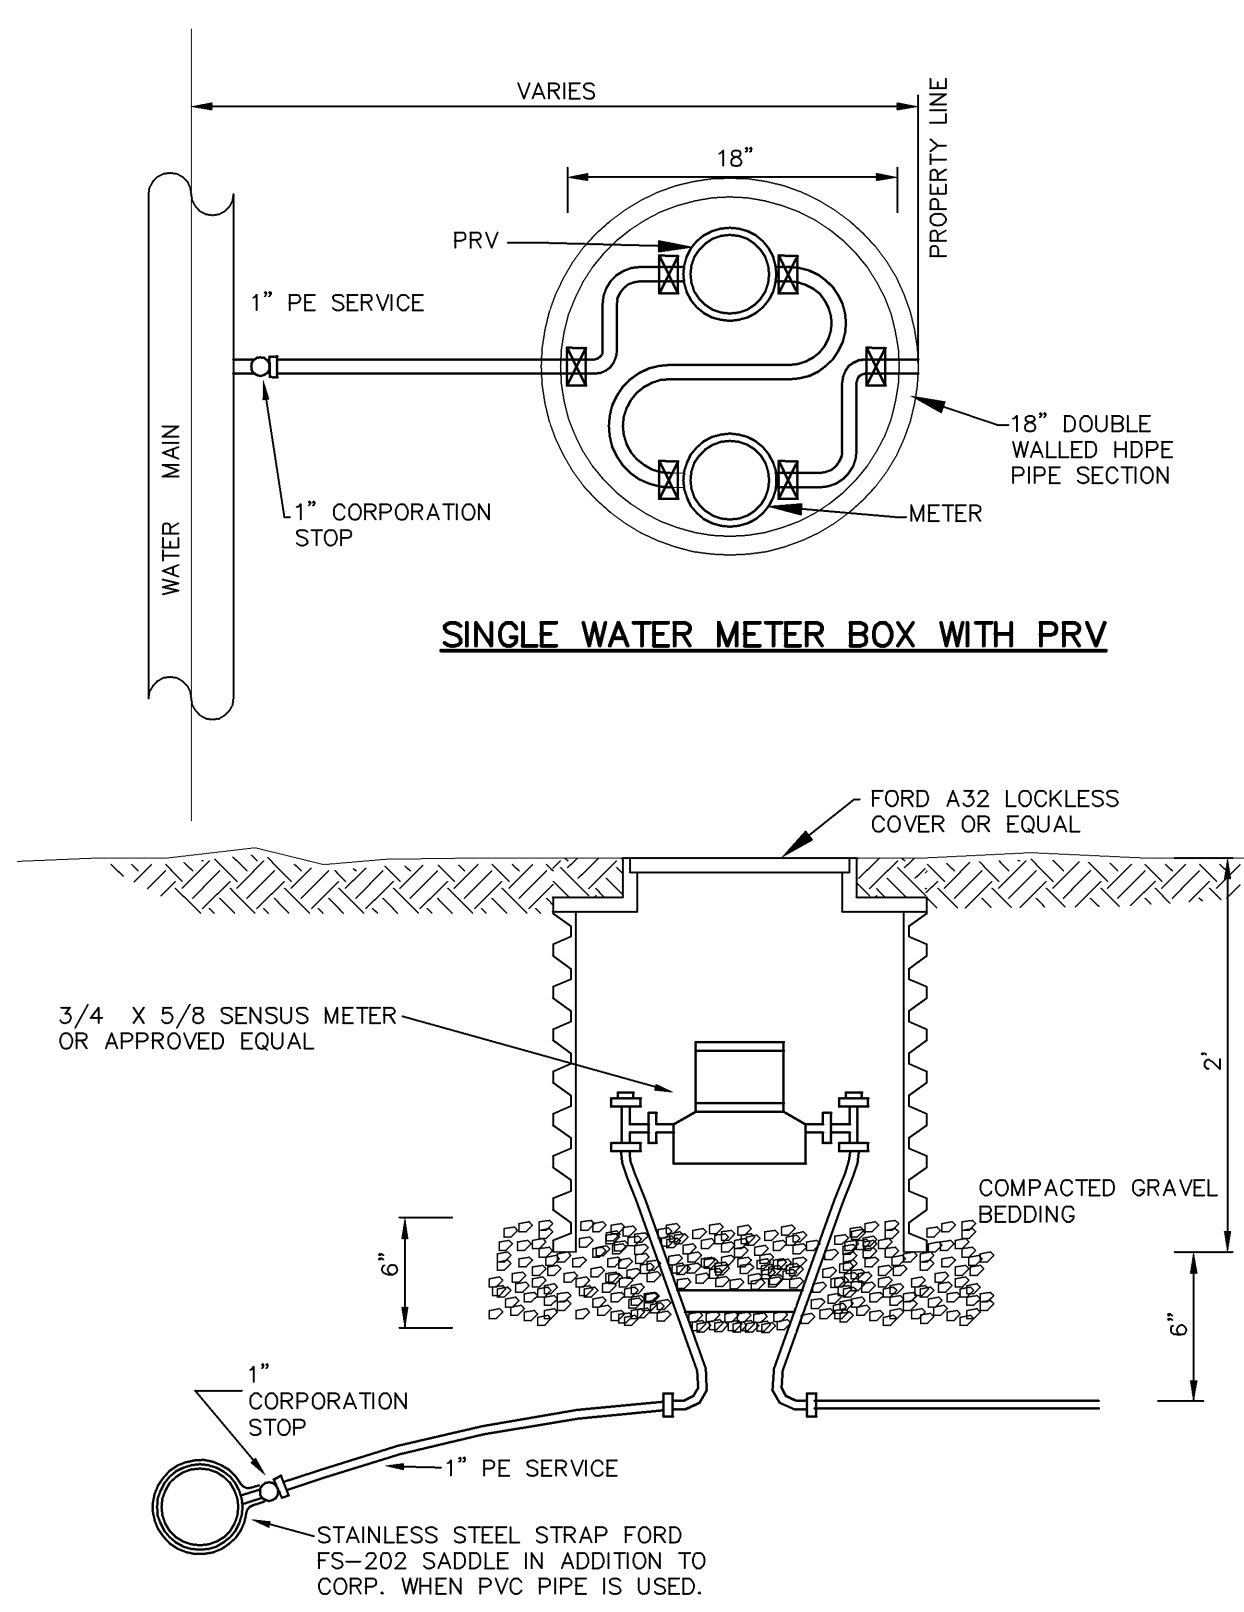


- METER MATERIALS LIST
- METER BOX EQUAL TO 18" DOUBLE WALLED HDPE PIPE SECTION W/ FORD A32 LOCKLESS LID
  - METER SETTER MUST BE FORD VBHH 71-81 OR APPROVED EQUAL
  - METER MUST BE SENSUS POSITIVE DISPLACEMENT METER OR APPROVED EQUAL.
  - CORPORATION STOP MUST BE FORD F-1000 OR APPROVED EQUAL.
  - SERVICE LINE MUST BE 200 PSI TUBING.
  - FOR 1" METERS ALL FITTINGS & COMPONENTS MUST BE UPSIZED TO 1"
  - METAL INSERTS REQUIRED IN TUBING AT ALL FITTINGS.


WATER METER INSTALLATION, 5/8" & 1"  
N.T.S.

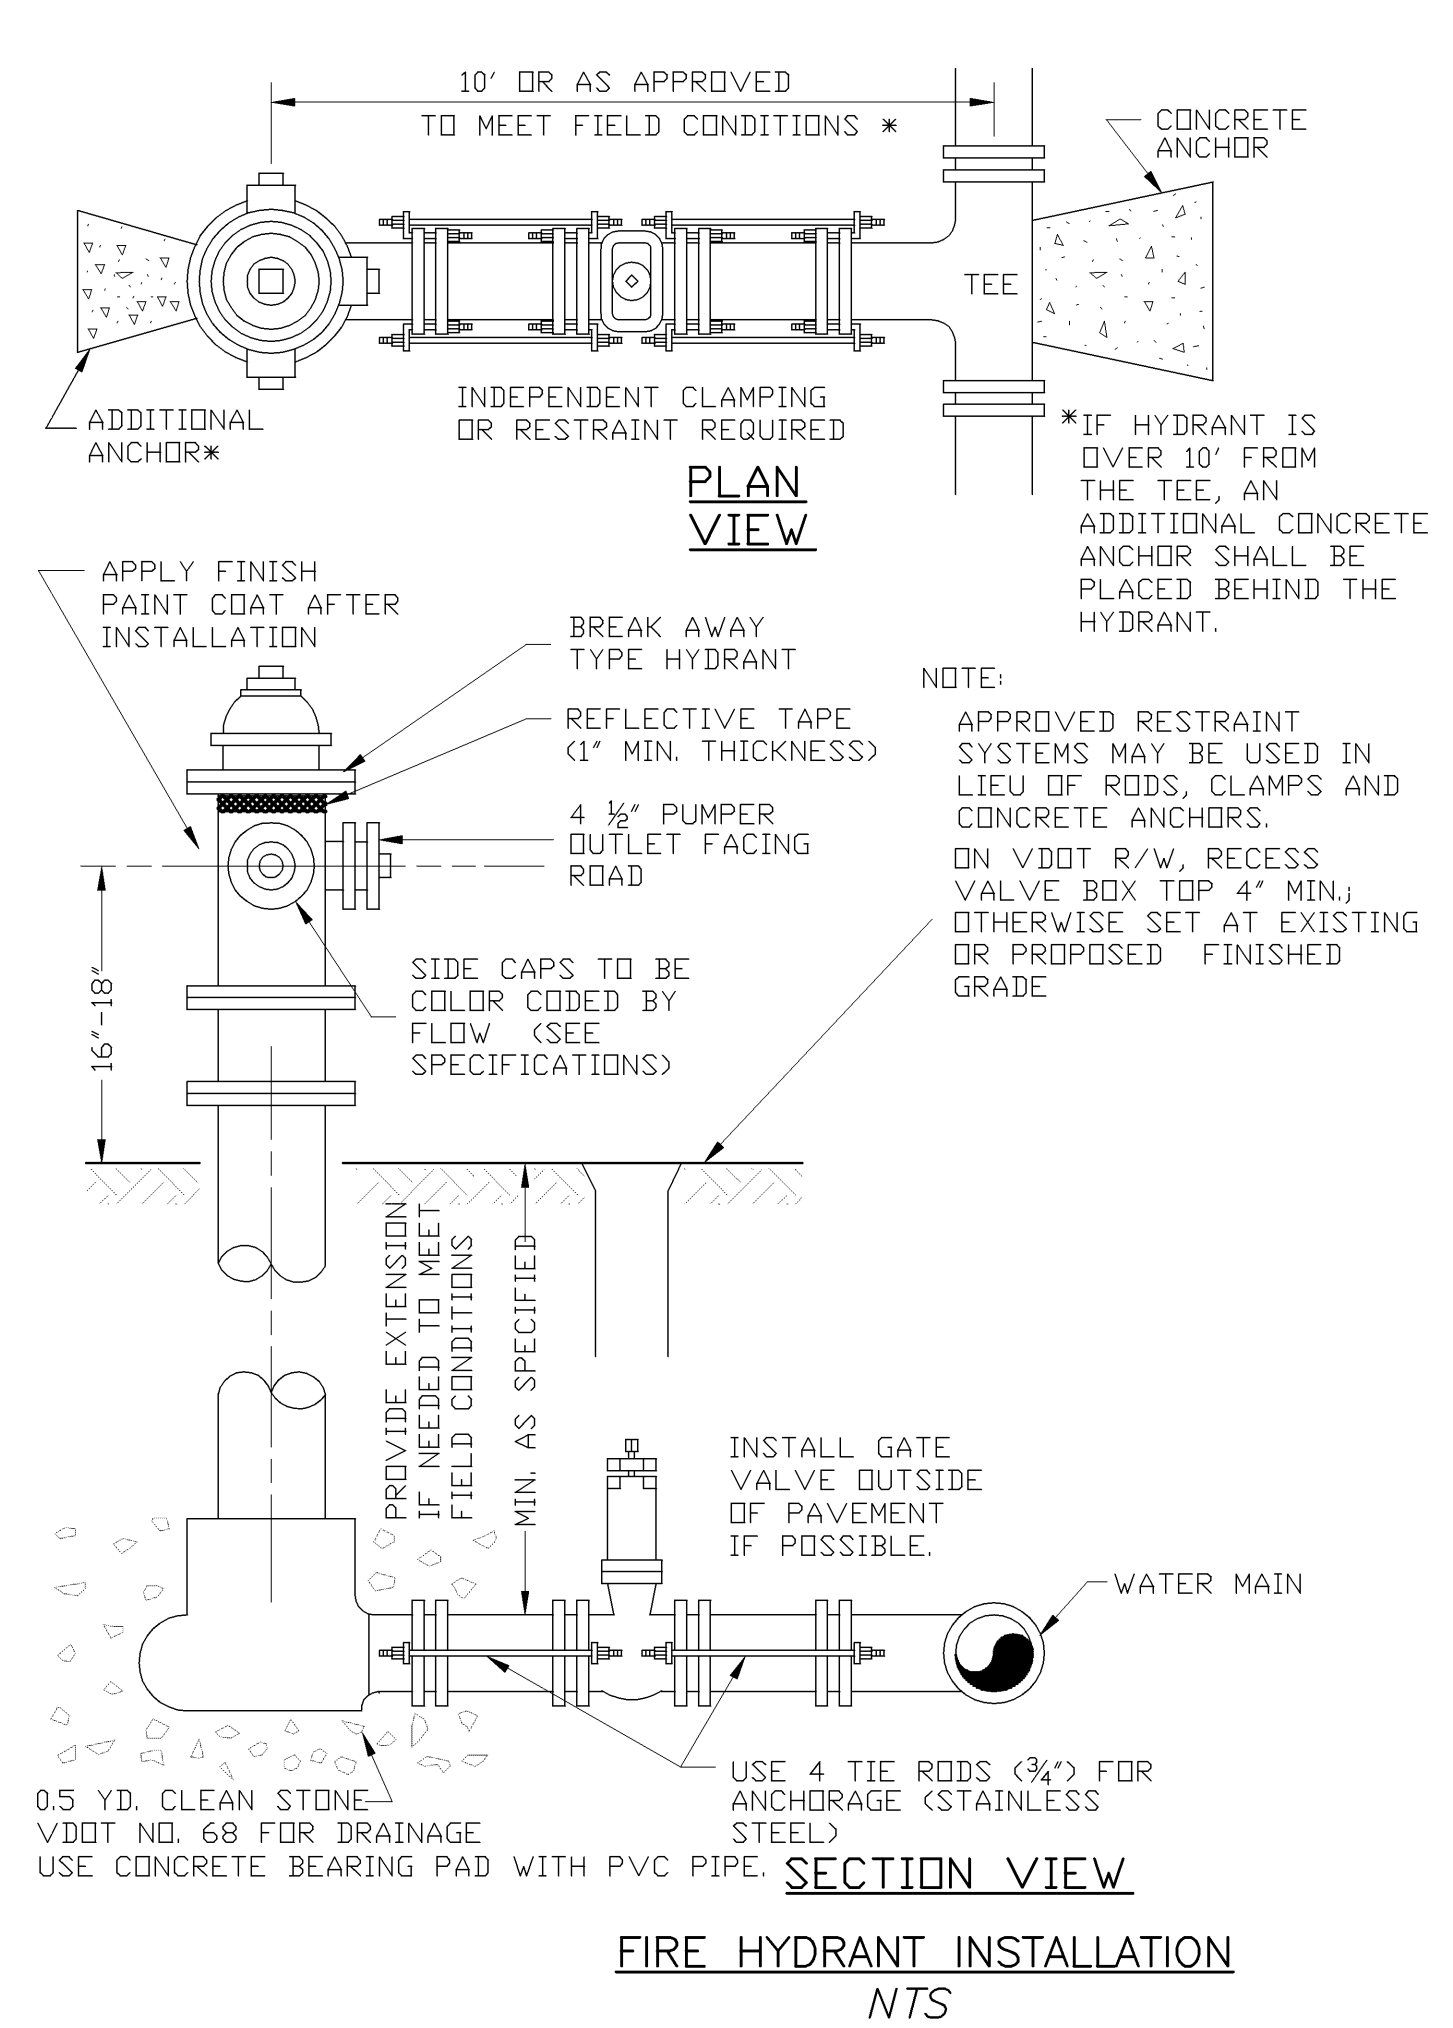

FIRE HYDRANT INSTALLATION  
N.T.S.

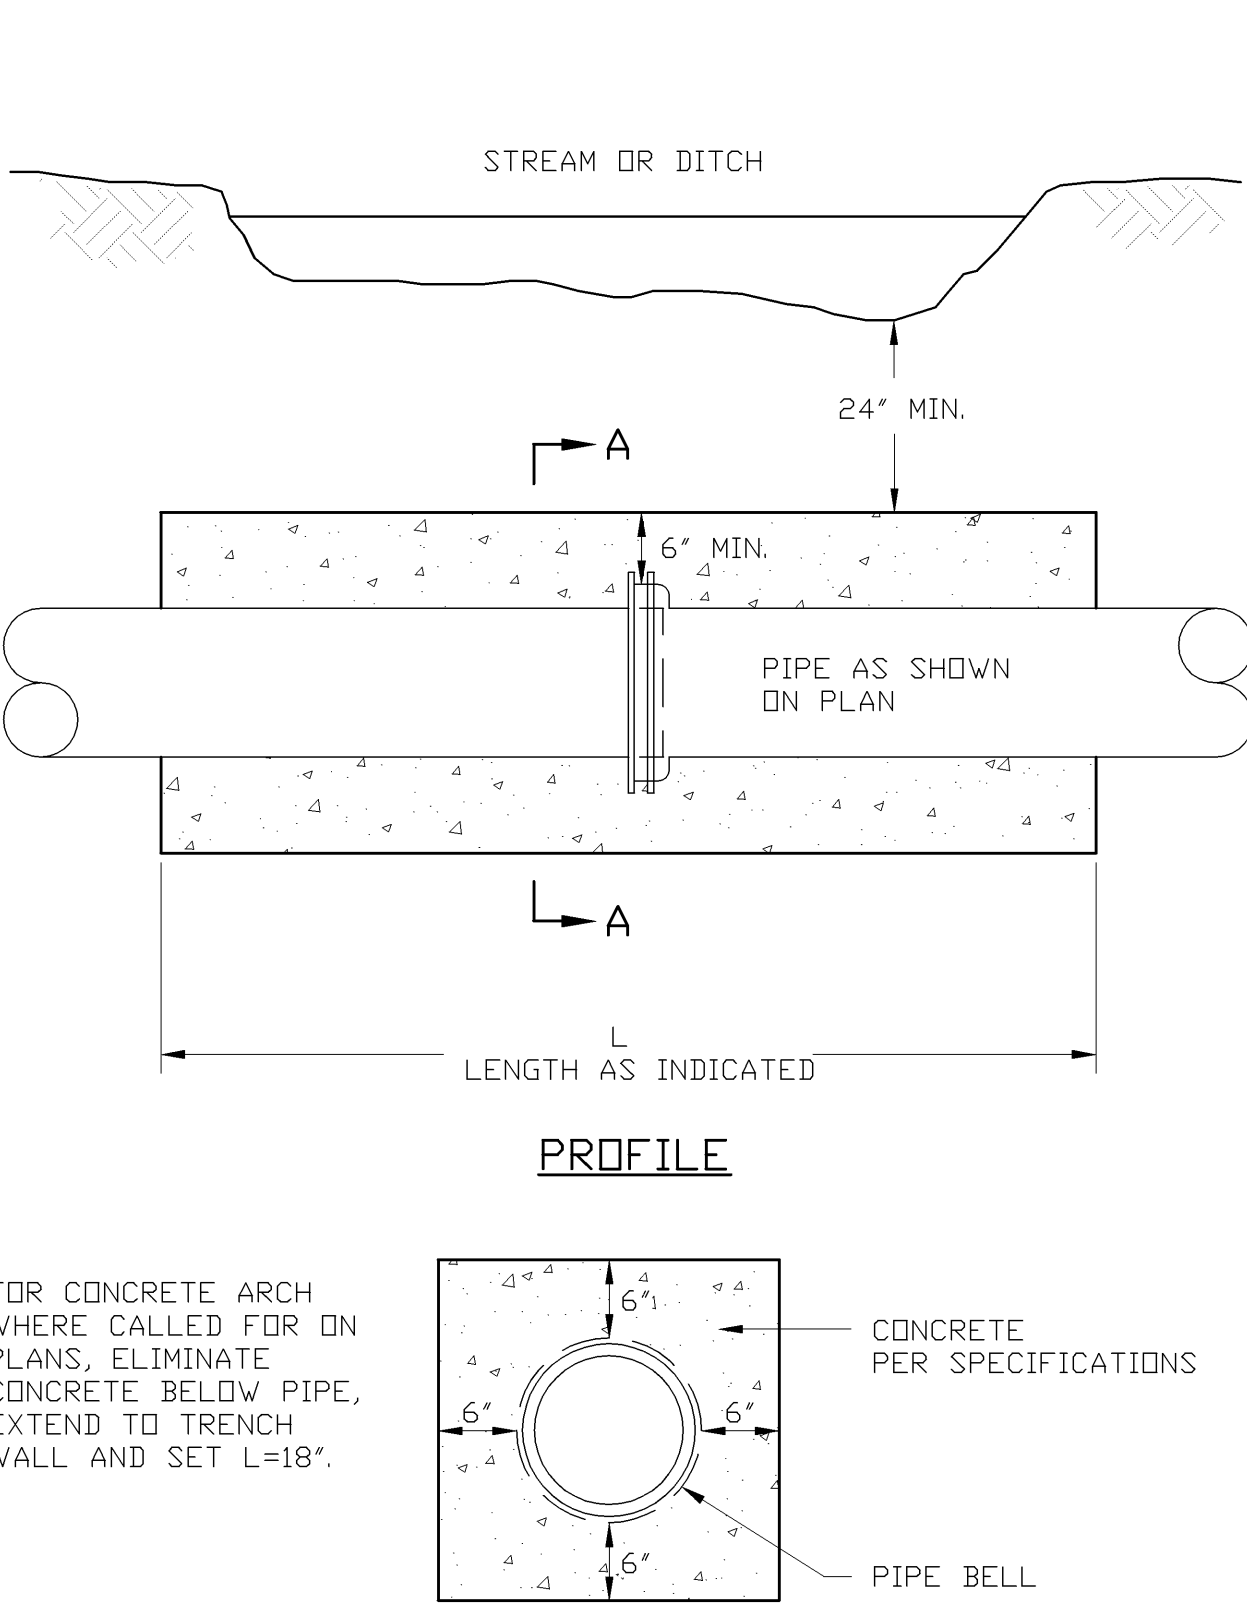

SECTION A-A  
CONCRETE ENCASEMENT  
N.T.S.

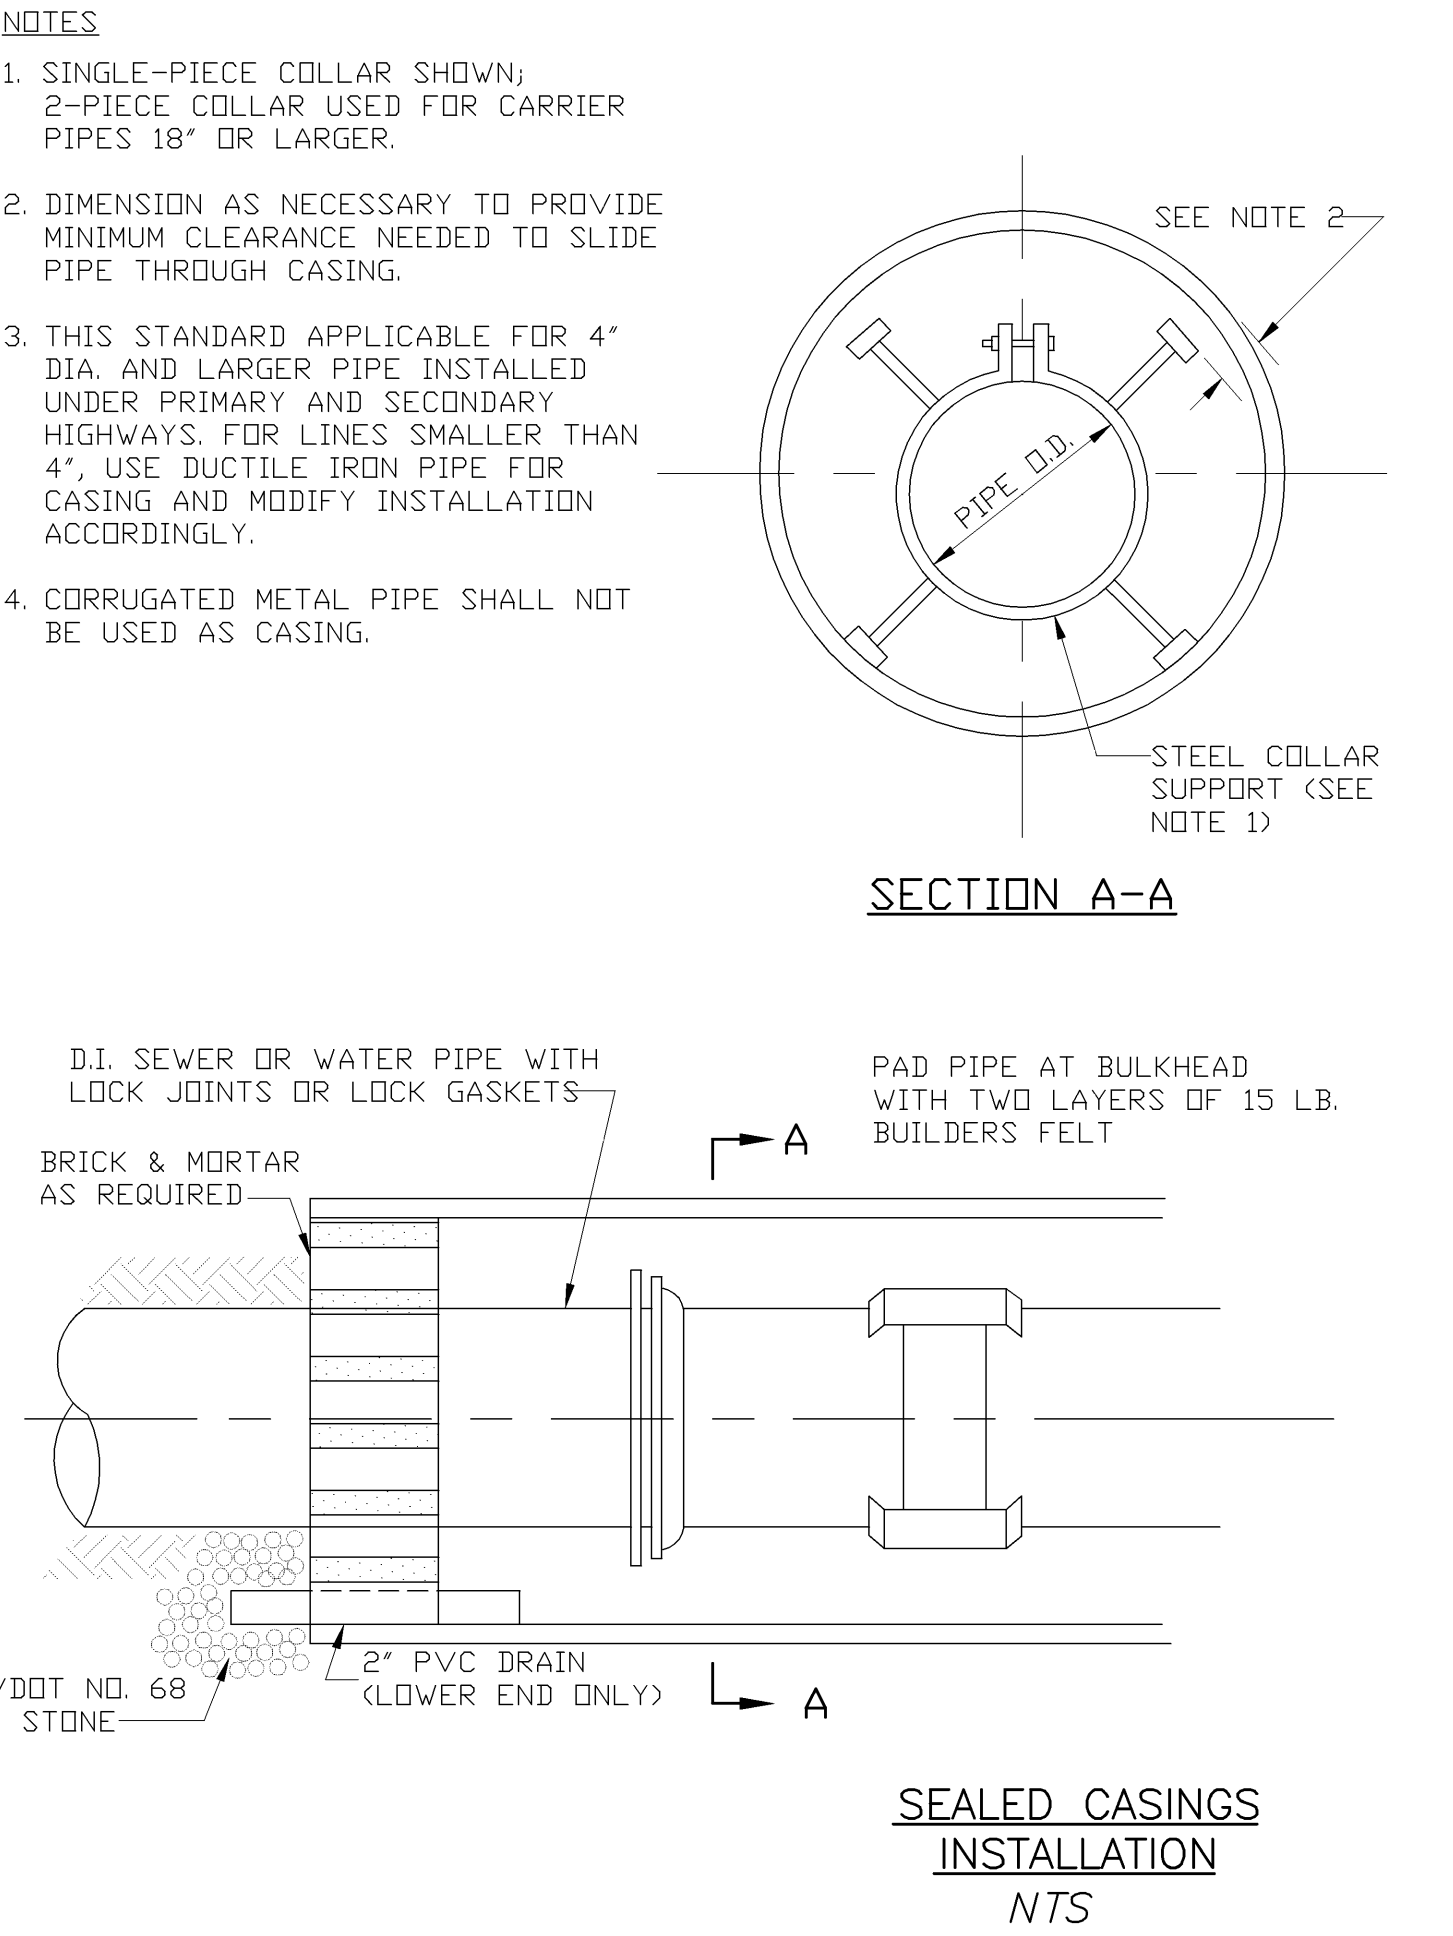

SEALED CASINGS INSTALLATION N.T.S.		
1	8/28/09	VDH COMMENTS
2	9/3/09	OWNER COMMENTS
4	3/14/12	ASBUILTS

ENGINEERING >> SURVEYING >> PLANNING

HURT & PROFFITT

INCORPORATED

2524 LANGHORNE ROAD  
LYNCHBURG VA 24501  
800.242.4906 TOLL FREE  
434.847.7796 MAIN  
434.847.0047 FAX

WATER LINE DETAILS-ASBUILT

FOR

TOWN OF BOONES MILL WATER SYSTEM REPLACEMENT, VOLUME 1

TOWN OF BOONES MILL, BOONE DISTRICT, FRANKLIN COUNTY, VA

PROJECT NO. 20080815

G.L. NO. 297-03-A3.9

FILE NO. G-12675


DATE: 7/31/09

DRAWN BY: WCH

CHECKED BY: BLC


HURT & PROFFITT

SHEET NO. WL-1

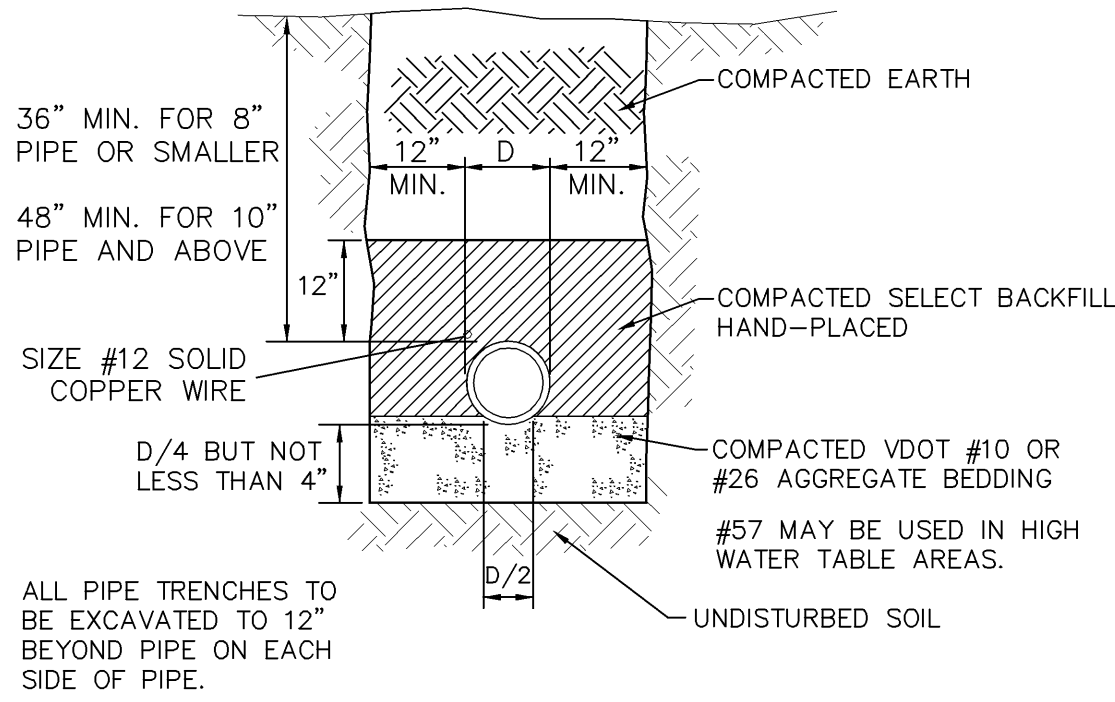


WATER LINE TRENCH  
N.T.S.

- NOTES:
1. IN PAVEMENT, USE PRECAST CHAMBER SHOWN IN BC-3.
  2. USE TEFLON TAPE ON ALL PIPE JOINTS AND CAP.

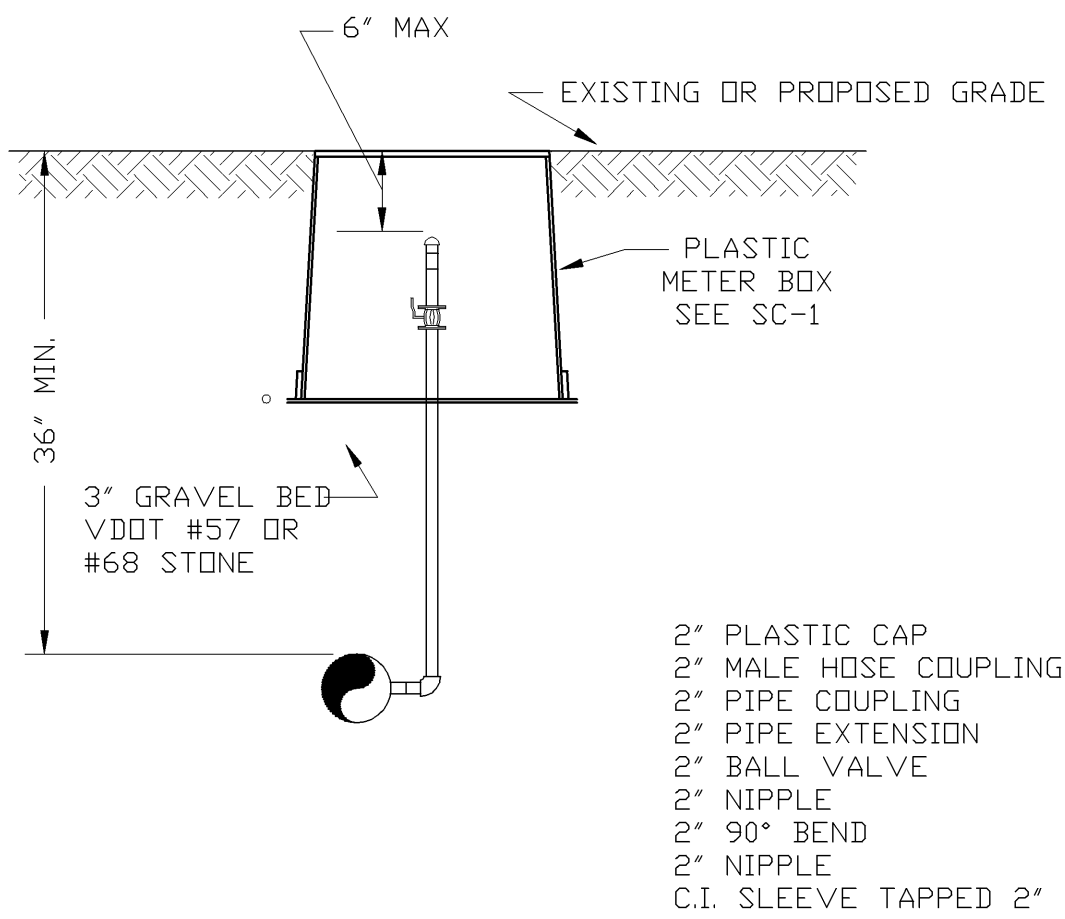


BLOW-OFF CHAMBER  
BC-1  
NTS


- NOTES:
1. IN PAVEMENT, USE PRECAST CHAMBER AS SHOWN IN AR-1.
  2. USE TEFLON TAPE ON ALL PIPE JOINTS AND CAP.
  3. ALL PIPE AND FITTINGS SHALL BE LEAD FREE BRASS OR STAINLESS STEEL. GALVANIZED AND BLACK IRON PIPE WILL NOT BE ALLOWED.

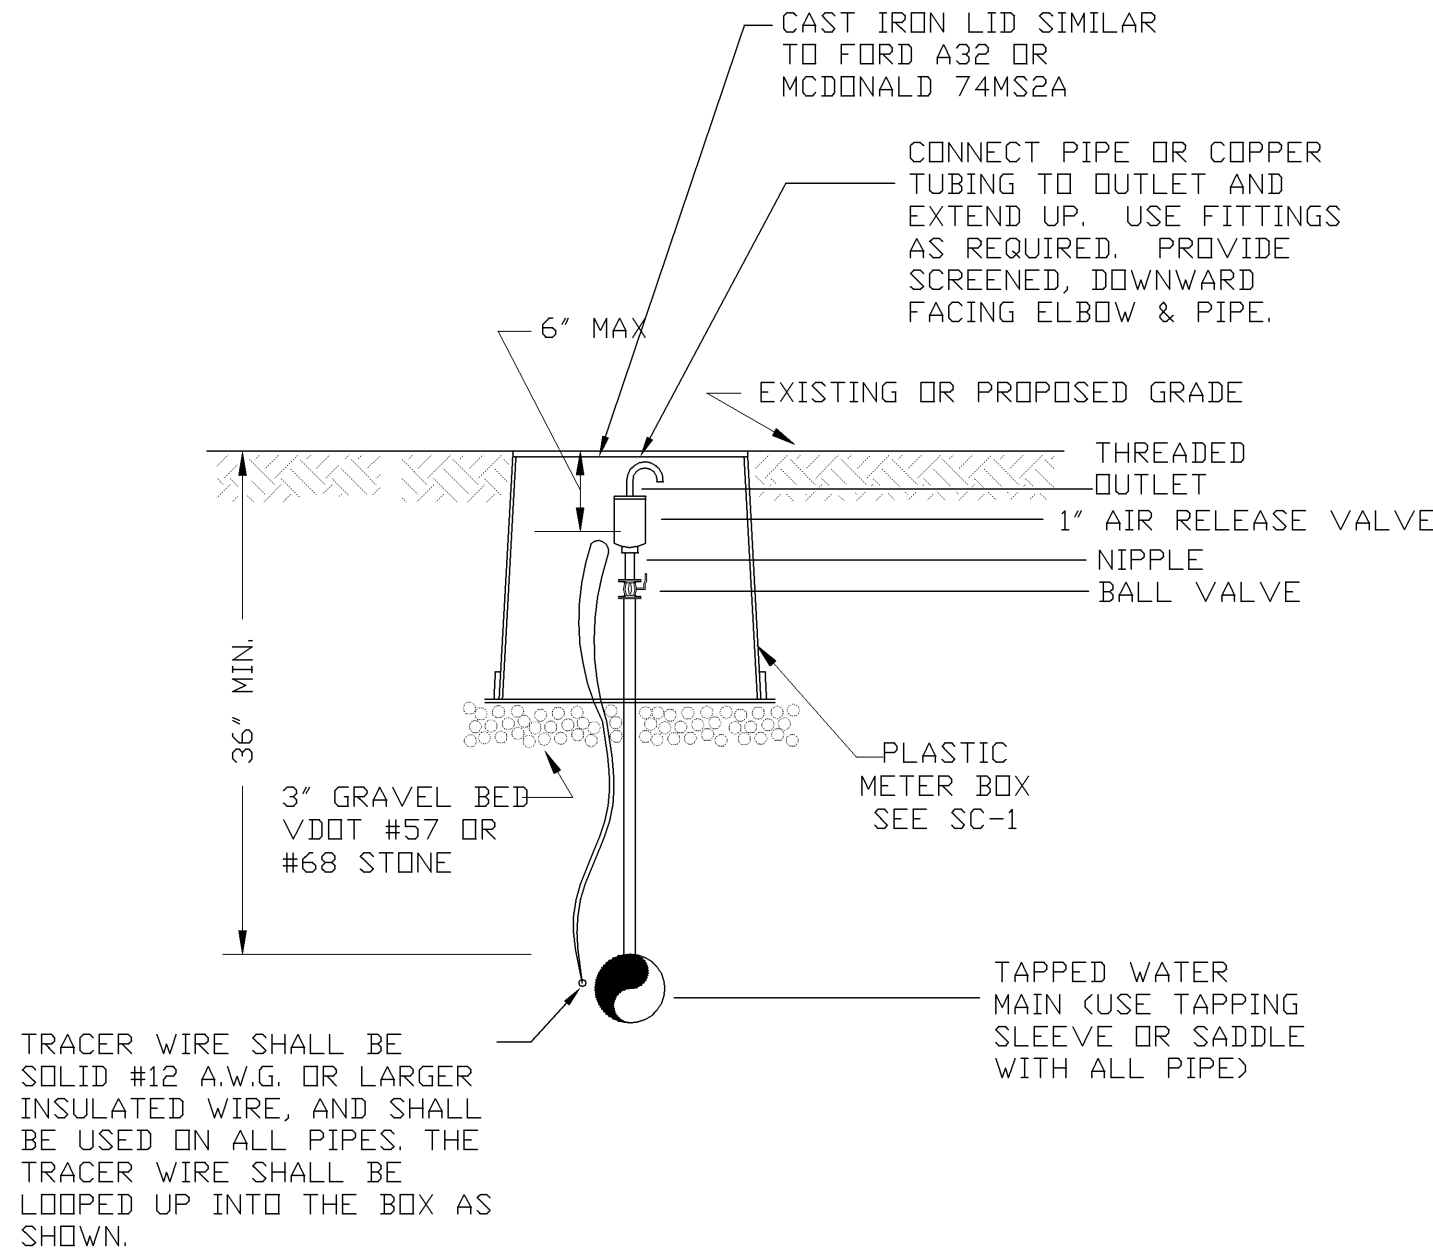

1" AIR RELEASE VALVE  
AR-2  
NTS

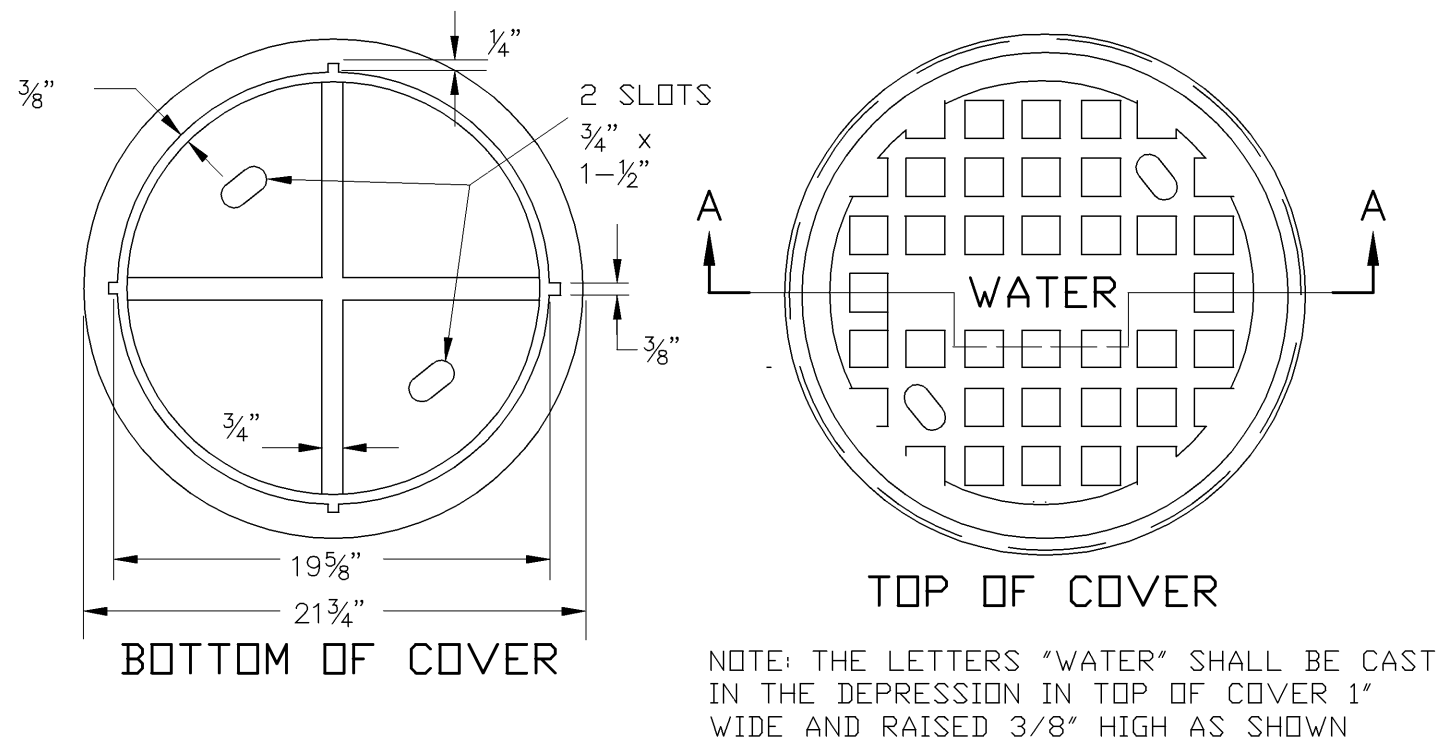


USE SOLID COVER AND CONCEALED LIFTING HOLE WHEN TOP IS BURIED BELOW GRADE

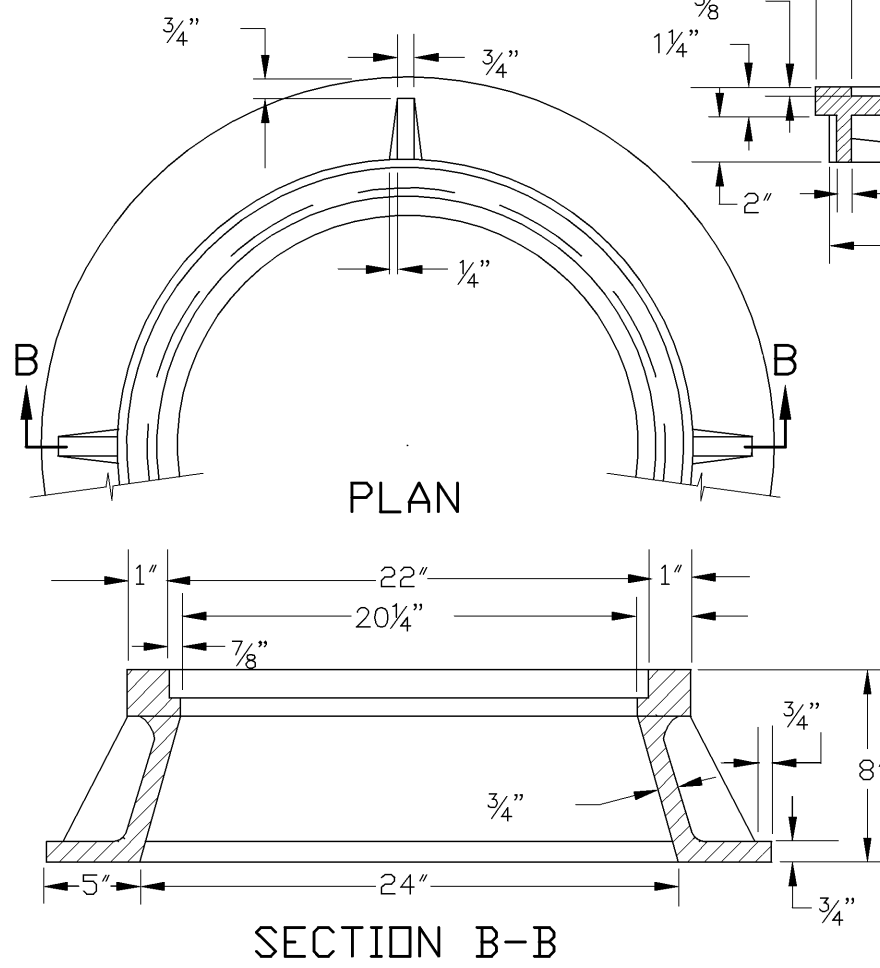


STANDARD MANHOLE  
FRAME & COVER  
FC-1  
NTS


NOTE: MATERIALS AND FABRICATION IN ACCORDANCE WITH MH-2 MANHOLE. SIZE OF AIR RELEASE VALVE AND SIZE OF GATE VALVE AS SPECIFIED. WHERE NOTED ON PLANS, USE STANDARD METER BOX AS CHAMBER AND SUPPORT WITH TWO (2) COURSES OF BRICK.

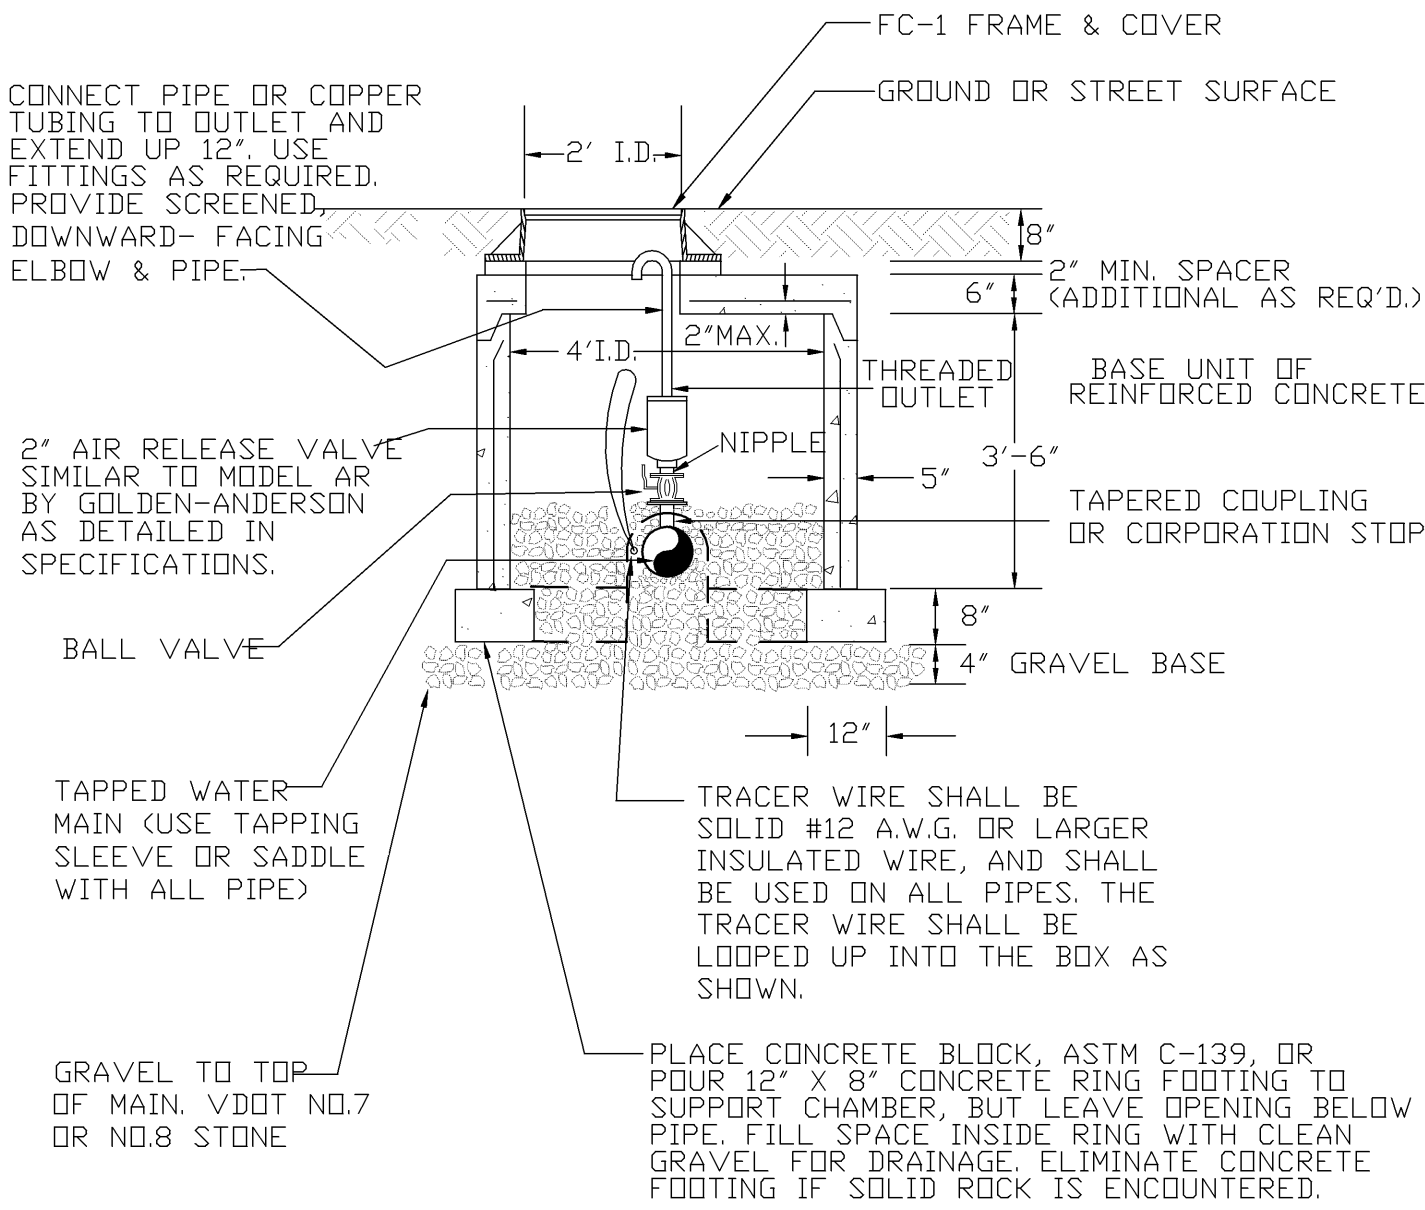

PRECAST CHAMBER FOR  
AIR RELEASE VALVE  
AR-1  
NTS

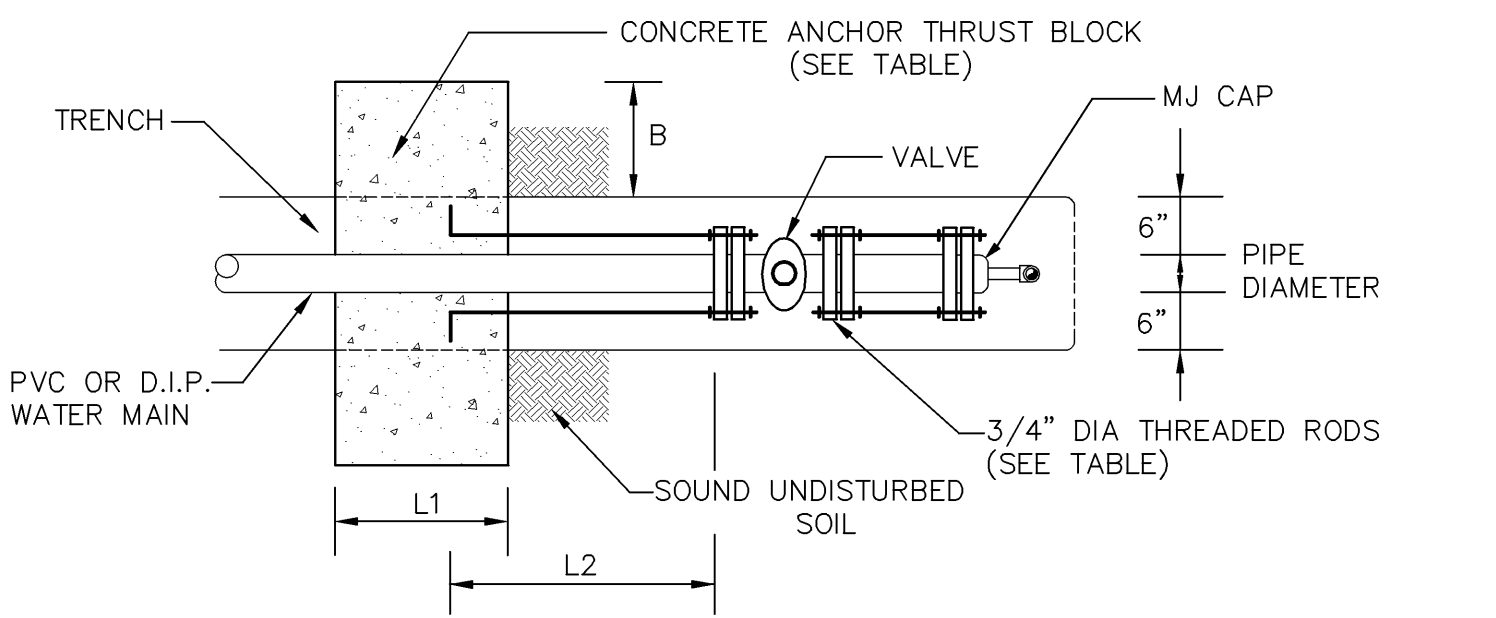

PLAN VIEW

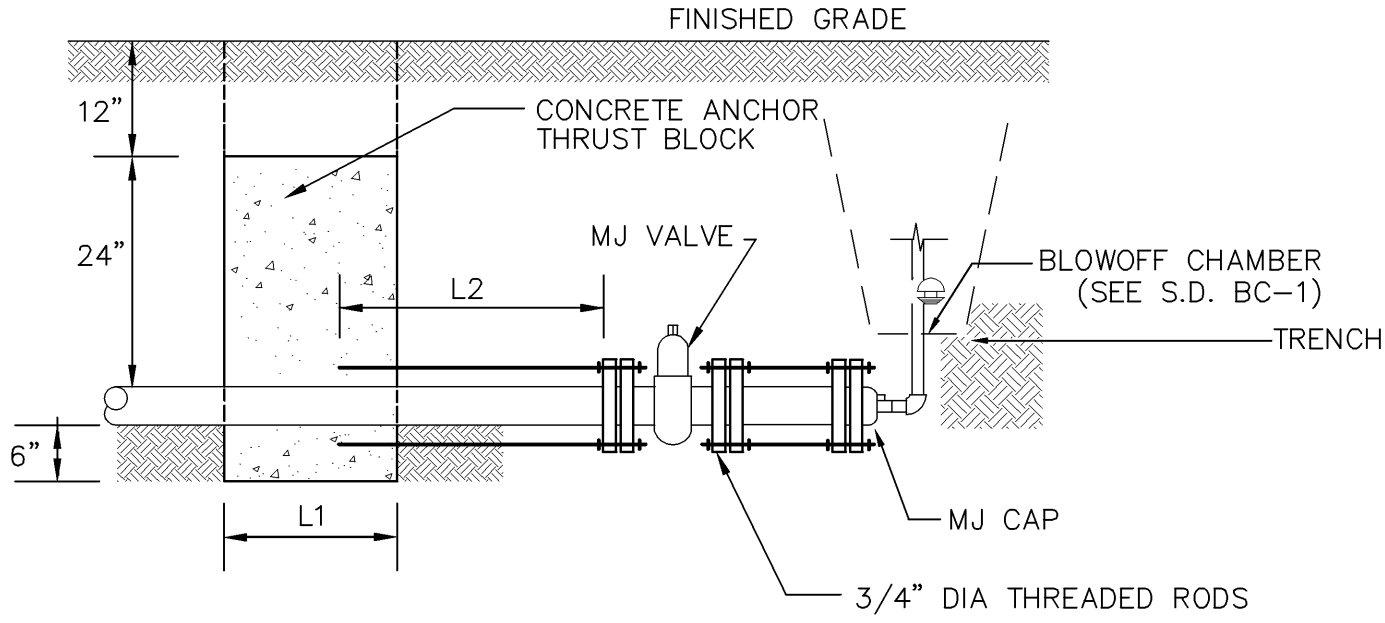

SECTION VIEW

RETAINER GLAND FOR PVC PIPE SHALL BE SERIES 2000 PV, AND FOR DIP PIPE SERIES 100, BY EBAA IRON SALES, INC. "MEGA-LUG" OR APPROVED EQUAL


PIPE DIAMETER (IN)	B MIN (IN)	L1 MIN (IN)	NUMBER OF RODS PER RETAINER	L2 MIN (IN)
4-8	12	18	4	27
10-12	27	33	4	50
14-16	44	50	6	75

NOTE: FOR USE WITH TEST OR WORKING PRESSURES 200 PSI OR LESS.


WATERLINE BULKHEAD ANCHOR  
WITH BLOWOFF DETAIL CA-5

NTS

NOTE: MATERIALS AND FABRICATION IN ACCORDANCE WITH MH-2 MANHOLE. SIZE OF AIR RELEASE VALVE AND SIZE OF GATE VALVE AS SPECIFIED. WHERE NOTED ON PLANS, USE STANDARD METER BOX AS CHAMBER AND SUPPORT WITH TWO (2) COURSES OF BRICK.

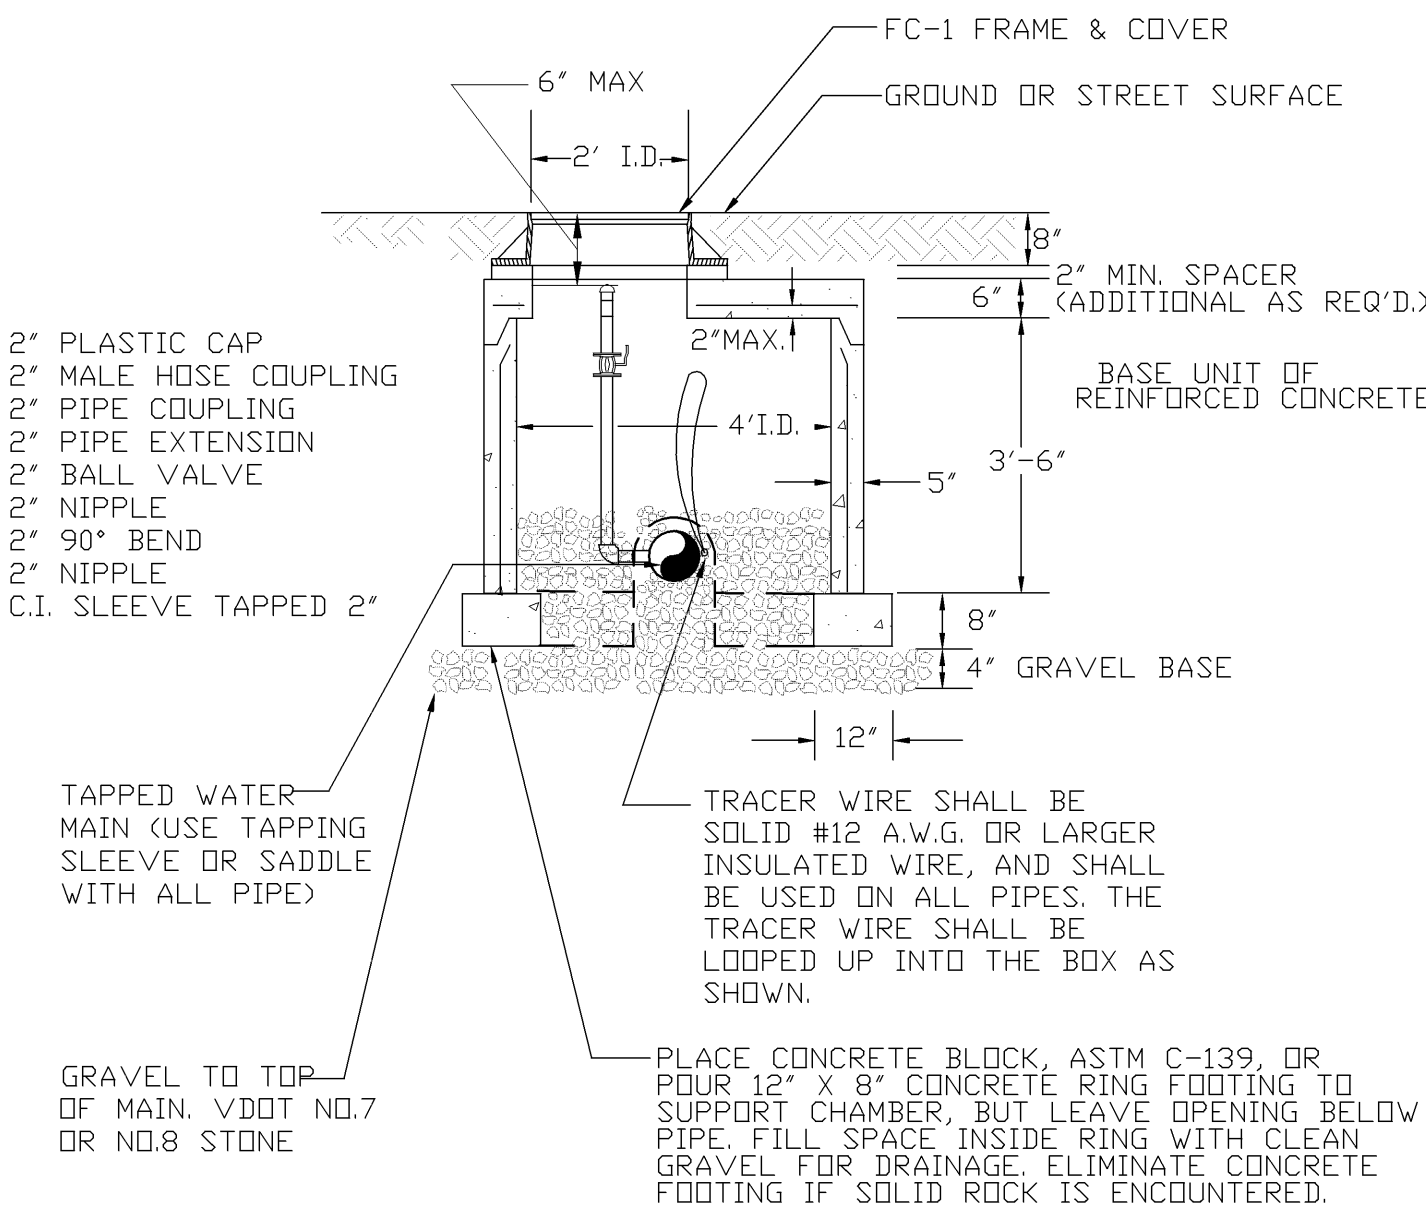

PRECAST CHAMBER FOR  
BLOW-OFF VALVE  
BC-3  
NTS

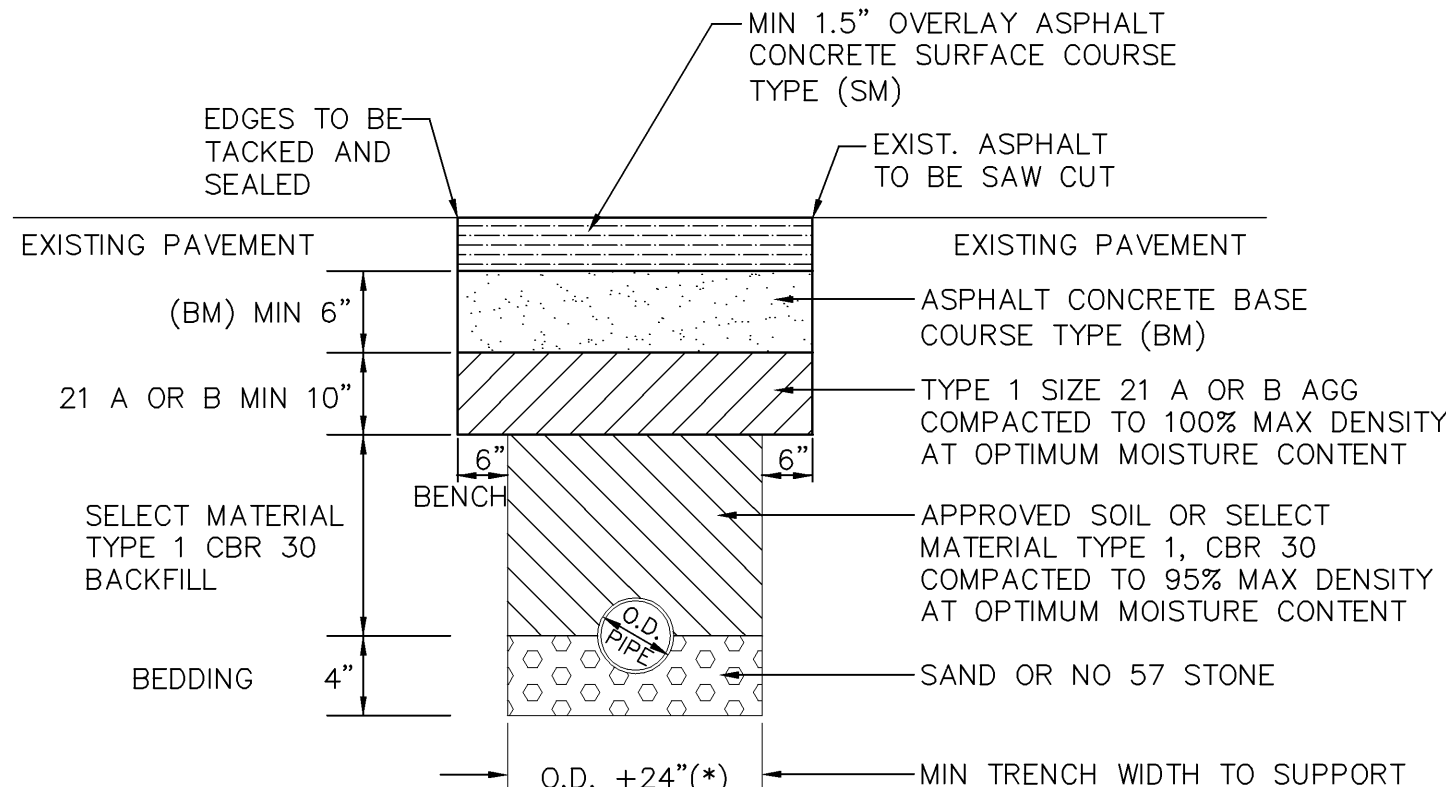

\*FOR PIPE LESS THAN 12" THE TRENCH WIDTH MAY BE 36" MAXIMUM SEE UB-1 (ROAD AND BRIDGE STANDARDS VOLUME II)

- NOTES:
1. TRENCH MAY BE BACKFILLED WITH VDOT NO. 57 STONE FROM PIPE TO BOTTOM OF ASPHALT BASE IN LIEU OF STANDARD DETAIL.
  2. IF PAVEMENT BEING REPLACED IS SURFACE TREATMENT, CONTRACTOR TO REPLACE WITH AN EQUIVALENT PAVEMENT SECTION.

CUT REPLACEMENT IN ROADS WITH ASPHALT  
CONCRETE BASE AND SURFACE  
N.T.S.

\*ENGINEERING >> SURVEYING >> PLANNING

HURT & PROFFITT  
INCORPORATED



2524 LANGHORNE ROAD  
LYNCHBURG VA 24501  
800.242.4906 TOLL FREE  
434.847.7796 MAIN  
434.847.0047 FAX

WATER LINE DETAILS-ASBUILT  
FOR

TOWN OF BOONES MILL WATER SYSTEM REPLACEMENT, VOLUME 1  
TOWN OF BOONES MILL, BOONE DISTRICT, FRANKLIN COUNTY, VA


PROJECT NO. 20080815  
G.L. NO. 297-03-A3.9  
FILE NO. G-12675  
DATE: 7/31/09  
DRAWN BY: WCH  
CHECKED BY: BLC

HURT & PROFFITT

SHEET NO.  
WL-2

1	8/28/09	VDH COMMENTS
2	9/3/09	OWNER COMMENTS
4	3/14/12	ASBUILTS



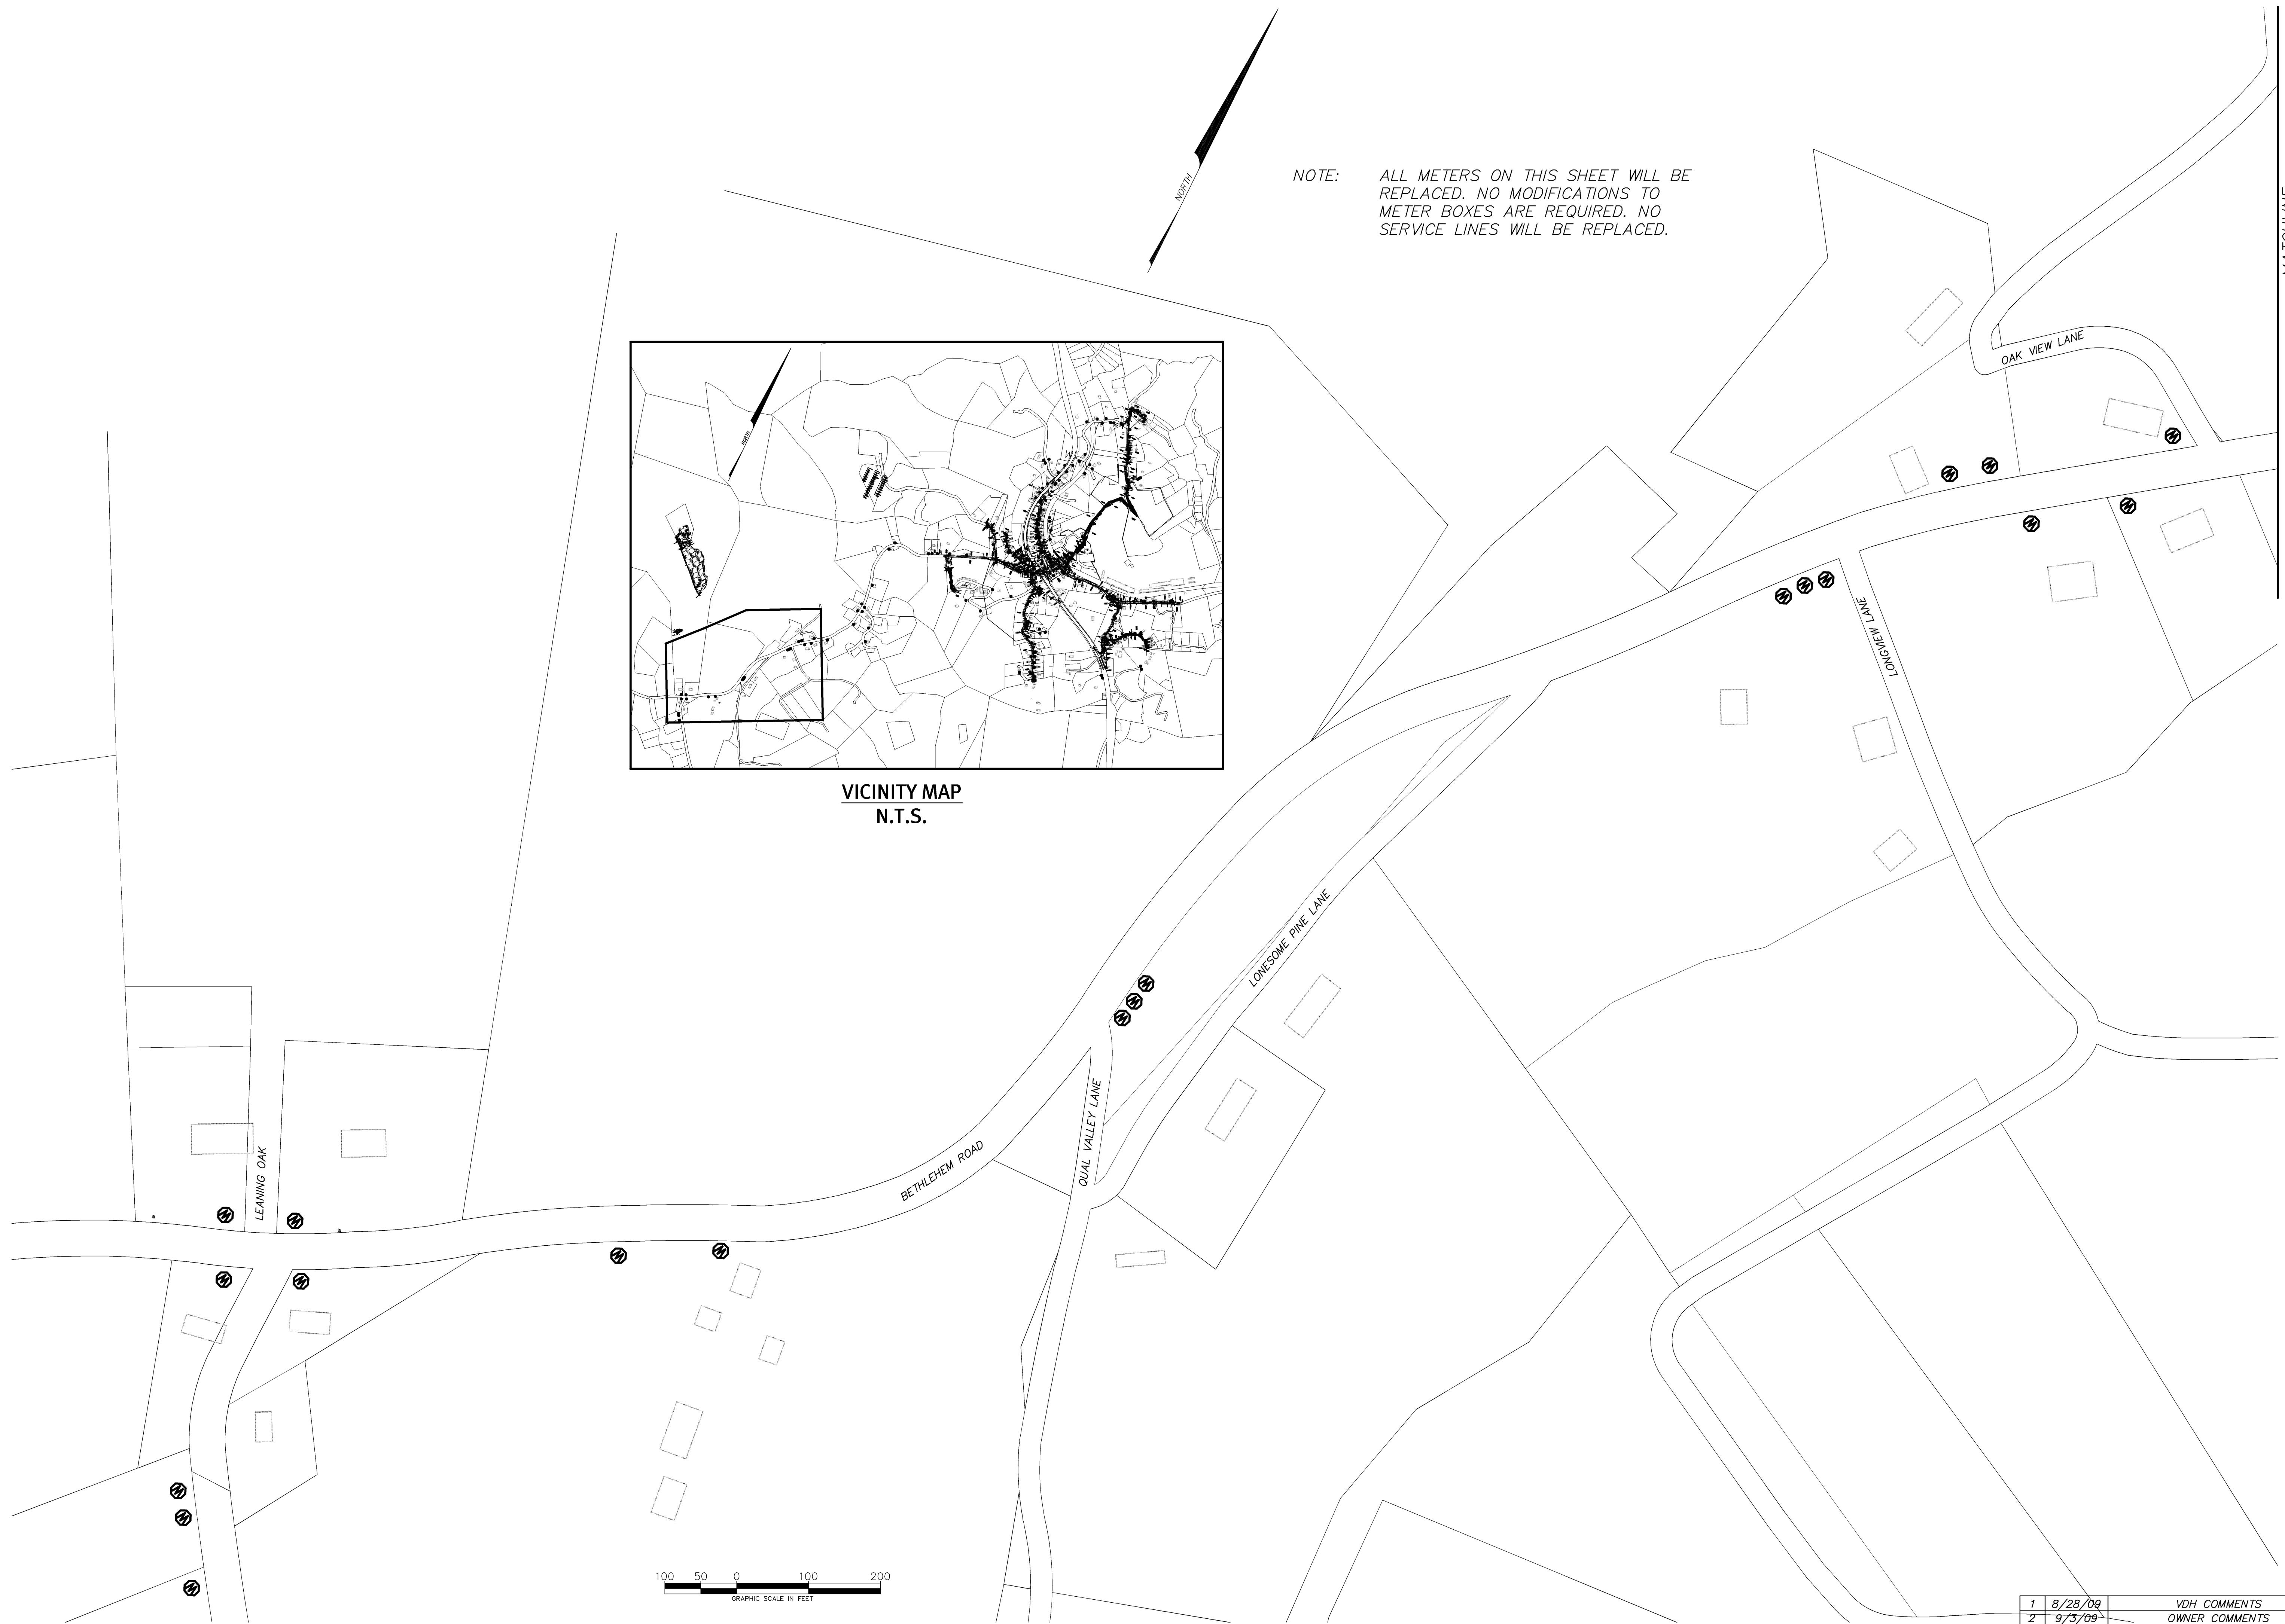

(SEE SHEET M2.0)

**\* ENGINEERING >> SURVEYING >> PLANNING**

**HURT & PROFFITT**



2524 LANGHORNE ROAD  
LYNCHBURG VA 24501  
800.242.4906 TOLL FREE  
434.847.7796 MAIN  
434.847.0047 FAX


**METER MAP 1-ASBUILT**  
**FOR**  
**TOWN OF BOONES MILL WATER SYSTEM REPLACEMENT, VOLUME 1**  
**TOWN OF BOONES MILL, BOONE DISTRICT, FRANKLIN COUNTY, VA**

PROJECT NO.	20080815
G.L. NO.	297-03-A3.9
FILE NO.	G-12675
DATE:	8/28/09
DRAWN BY:	WCH
CHECKED BY:	BLC

**HURT & PROFFITT**

**SHEET NO.**  
**M1.0**

1	8/28/09	VDH COMMENTS
2	9/3/09	OWNER COMMENTS
4	3/14/12	ASBUILTS

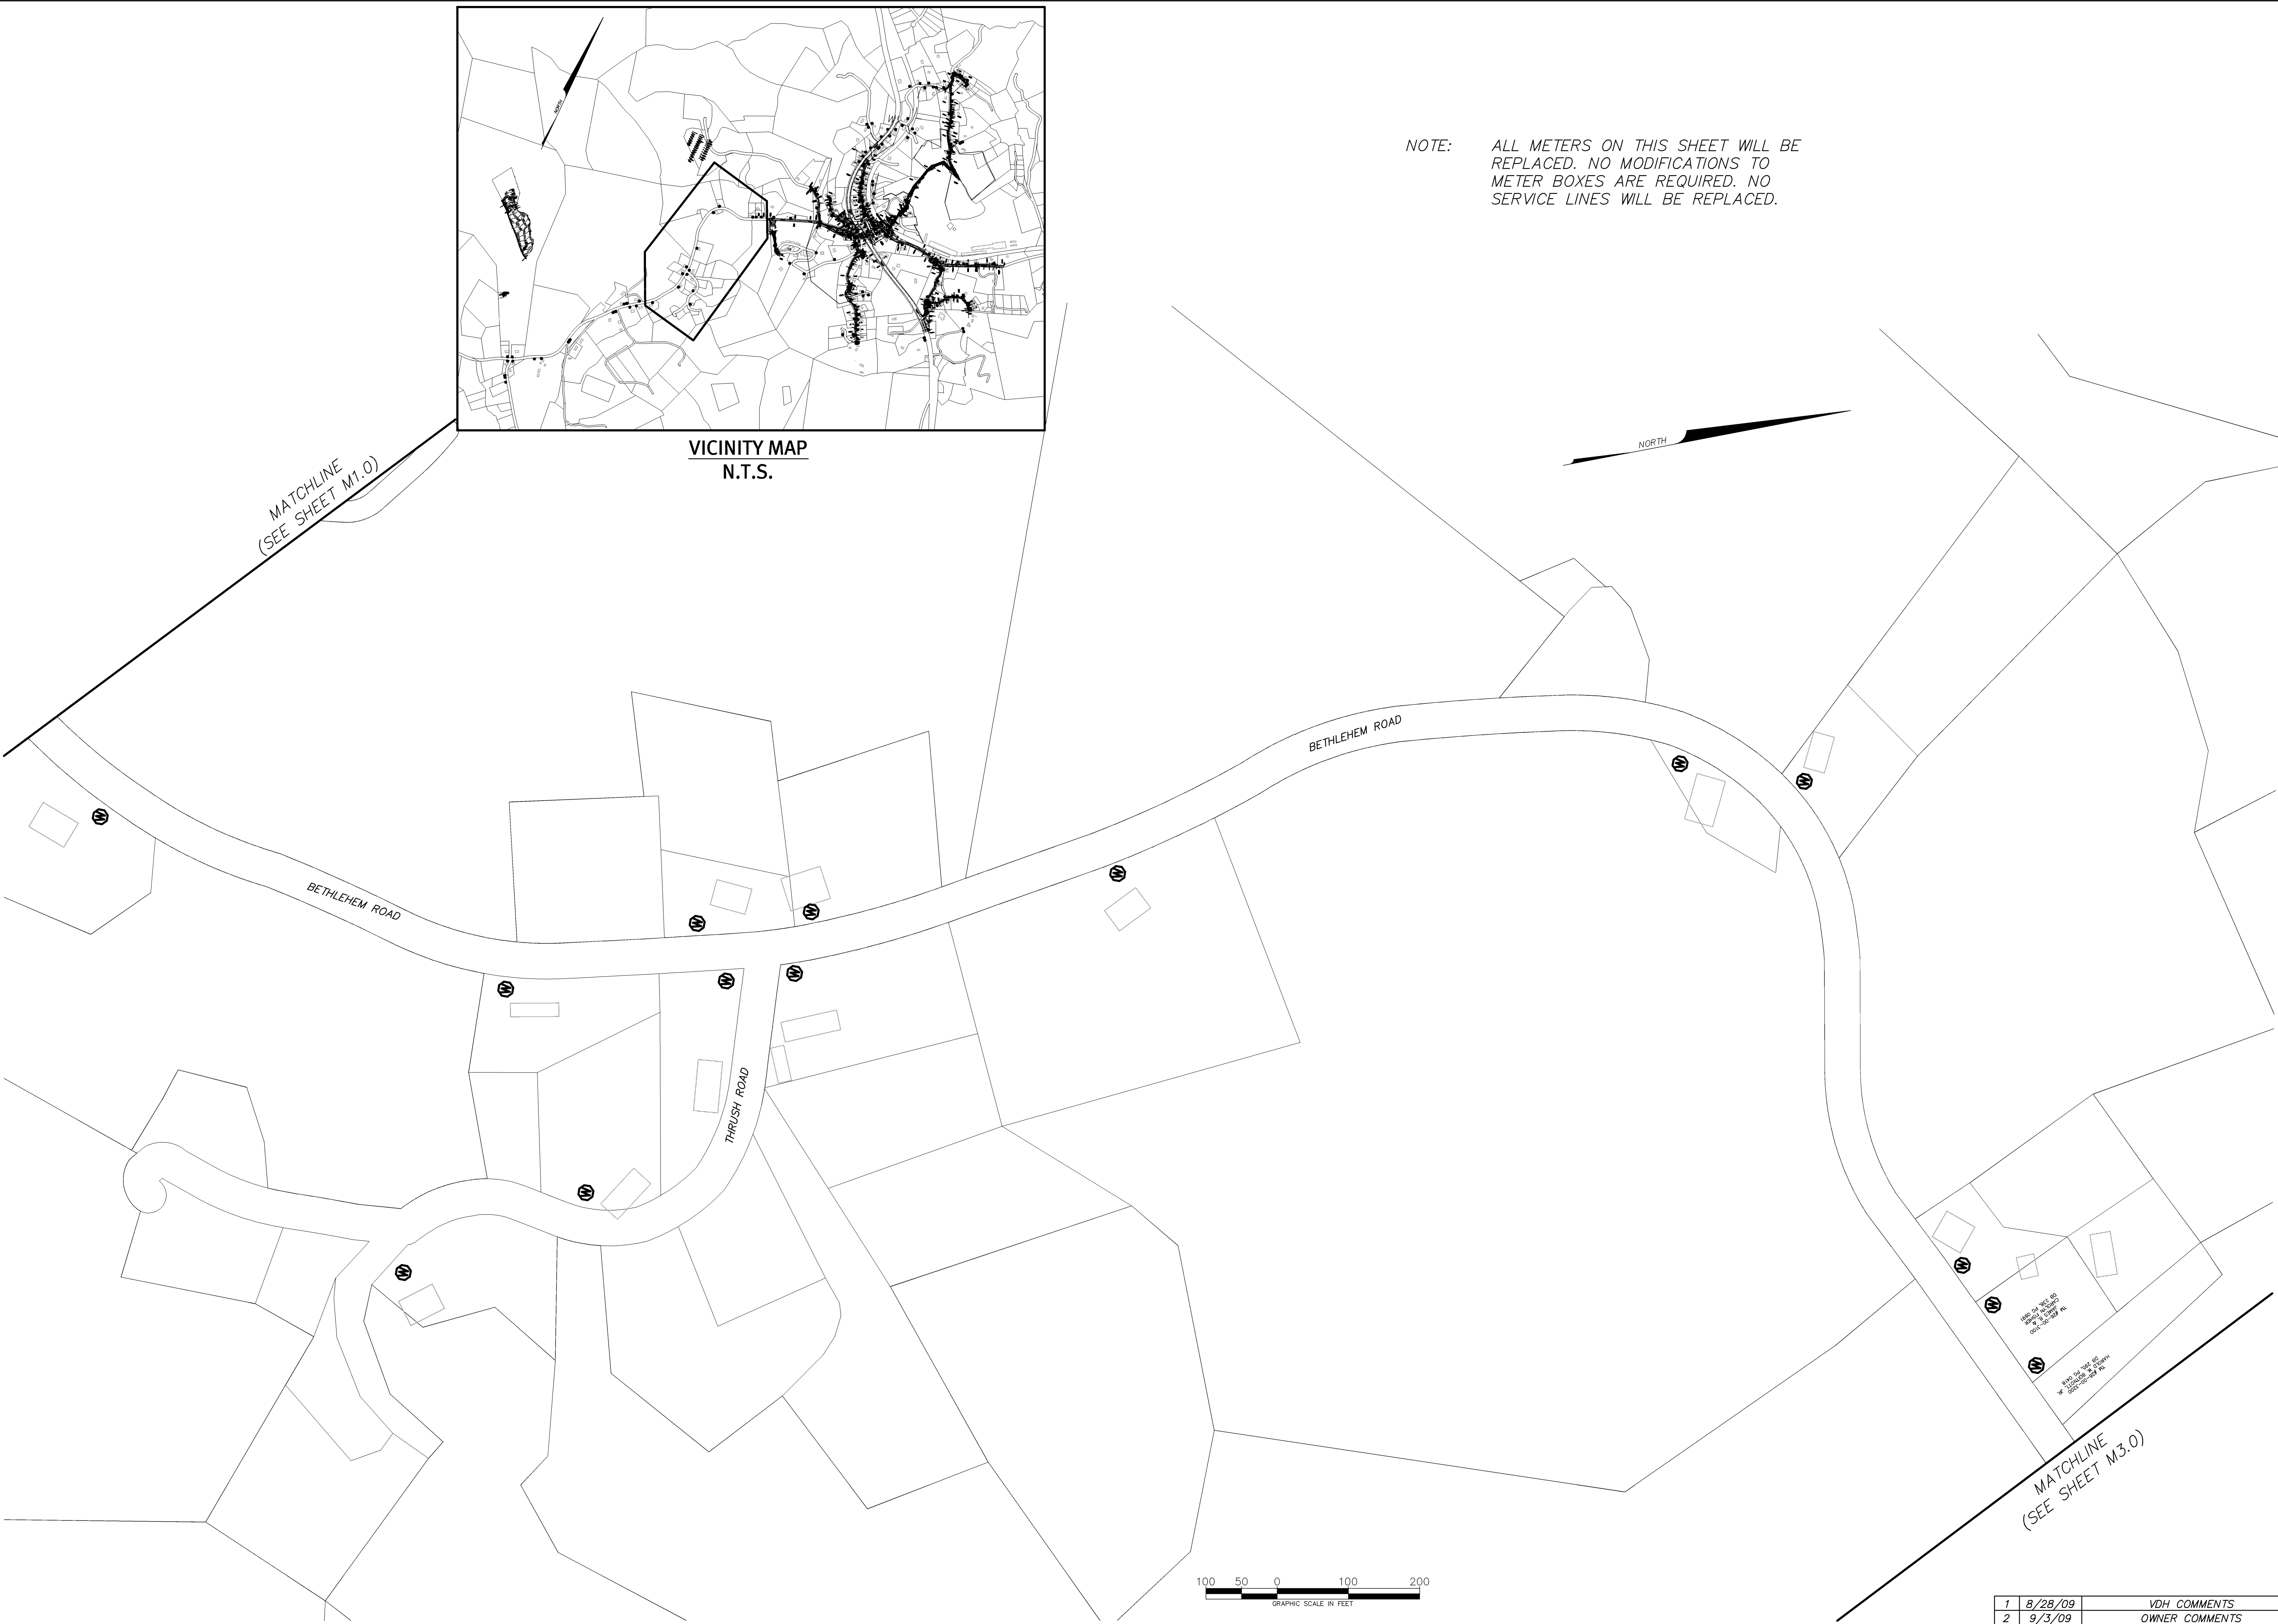

NOTE: ALL METERS ON THIS SHEET WILL BE REPLACED. NO MODIFICATIONS TO METER BOXES ARE REQUIRED. NO SERVICE LINES WILL BE REPLACED.

**\*ENGINEERING >> SURVEYING >> PLANNING**

**HURT & PROFFITT**  
\*ENGINEERING >> S



2524 LANGHORNE ROAD  
LYNCHBURG VA 24501  
800.242.4906 TOLL FREE  
434.847.7796 MAIN  
434.847.0047 FAX

**METER MAP 2-ASBUILT**  
**FOR**  
**TOWN OF BOONES MILL WATER SYSTEM REPLACEMENT, VOLUME 1**  
**TOWN OF BOONES MILL, BOONE DISTRICT, FRANKLIN COUNTY, VA**

PROJECT NO.	20080815
G.L. NO.	297-03-A3.9
FILE NO.	G-12675
DATE:	8/28/09
DRAWN BY:	WCH
CHECKED BY:	BLC

HURT &amp; PROFFITT

**SHEET NO.**  
**M2.0**

1	8/28/09	VDH COMMENTS
2	9/3/09	OWNER COMMENTS
4	3/14/12	ASBUILTS





Mar 14, 2012 - 10:39am V:\LoudProj\20080815\dwg\Asbults-WL\ASBULT-Water Meter.dwg



1	8/28/09	VDH COMMENTS
2	9/3/09	OWNER COMMENTS
4	3/14/12	ASBUILTS

**HURT & PROFFITT**  
INCORPORATED

2524 LANGHORNE ROAD  
LYNCHBURG VA 24501  
800.242.4906 TOLL FREE  
434.847.7796 MAIN  
434.847.0047 FAX

\*ENGINEERING >> SURVEYING >> PLANNING

**METER MAP 4-ASBUILT**  
FOR  
**TOWN OF BOONES MILL WATER SYSTEM REPLACEMENT, VOLUME 1**  
**TOWN OF BOONES MILL, BOONE DISTRICT, FRANKLIN COUNTY, VA**

PROJECT NO. 20080815  
G.L. NO. 297-03-A3.9  
FILE NO. G-12675  
DATE: 8/28/09  
DRAWN BY: WCH  
CHECKED BY: BLC

**HURT & PROFFITT**

SHEET NO.  
**M4.0**





MATCHLINE  
(SEE SHEET M3.0)

MATCHLINE  
(SEE SHEET M6.0)


NOTE: ALL METERS SHOWN WILL BE  
REPLACED WITH NEW METER BASE  
WITH PRV AS SHOWN ON SHEET WL-1.



1	8/28/09	VDH COMMENTS
2	9/3/09	OWNER COMMENTS
4	3/14/12	ASBUILTS

**HURT & PROFFITT**  
INCORPORATED  
2574 LANGHORNE ROAD  
LYNCHBURG VA 24501  
800.242.4906 TOLL FREE  
434.847.7796 MAIN  
434.847.0047 FAX

\*ENGINEERING » SURVEYING » PLANNING



**METER MAP 5-ASBUILT**  
**FOR**  
**TOWN OF BOONES MILL WATER SYSTEM REPLACEMENT, VOLUME 1**  
**TOWN OF BOONES MILL, BOONE DISTRICT, FRANKLIN COUNTY, VA**

PROJECT NO.	20080815
G.L. NO.	297-03-A3.9
FILE NO.	G-12675
DATE:	8/28/09
DRAWN BY:	WCH
CHECKED BY:	BLC

**HURT & PROFFITT**

**SHEET NO.**  
**M5.0**

MATCHLINE  
(SEE SHEET M5.0)

MATCHLINE  
(SEE SHEET M3.0)

VICINITY MAP  
N.T.S.

100 50 0 100 200

GRAPHIC SCALE IN FEET

NORTH



**HURT & PROFFITT**

**METER MAP 6-ASBUILT**  
**FOR**  
**TOWN OF BOONES MILL WATER SYSTEM REPLACEMENT, VOLUME 1**  
**TOWN OF BOONES MILL, BOONE DISTRICT, FRANKLIN COUNTY, VA**


PROJECT NO.	20080815
G.L. NO.	297-03-A3.9
FILE NO.	G-12675
DATE:	8/28/09
DRAWN BY:	WCH
CHECKED BY:	BLC

SHEET NO.  
**M6.0**

1	8/28/09	VDH COMMENTS
2	9/3/09	OWNER COMMENTS
4	3/14/12	ASBUILTS




Mar 14, 2012 - 10:40am V:\LandProjects\20080815\dwg\Asbults-WL\ASBULT-Water Meter.dwg

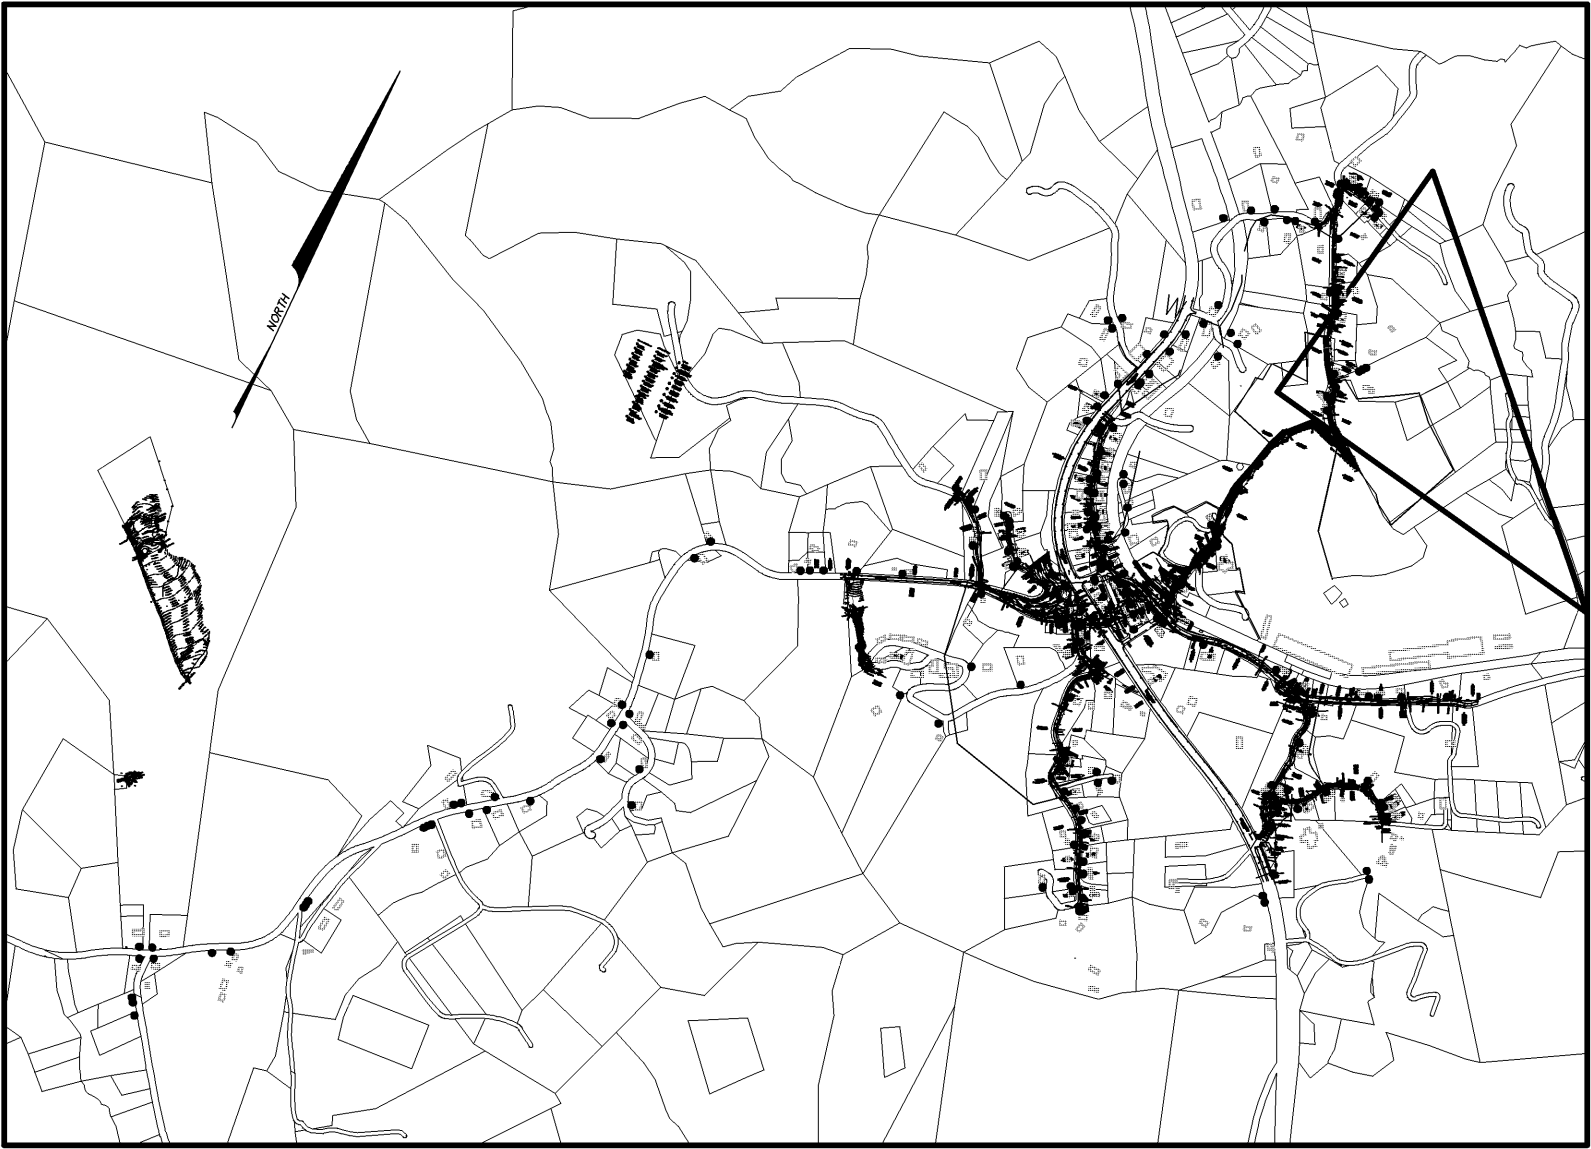

VICINITY MAP  
N.T.S.

NOTE: ALL METERS SHOWN WILL BE  
REPLACED WITH NEW METER BASE  
WITH PRV AS SHOWN ON SHEET WL-1.

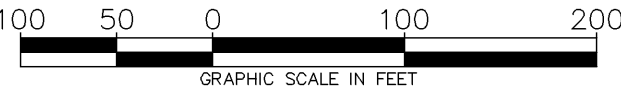

1	8/28/09	VDH COMMENTS
2	9/3/09	OWNER COMMENTS
4	3/14/12	ASBULTS

**METER MAP 7-ASBULT**  
FOR  
**TOWN OF BOONES MILL WATER SYSTEM REPLACEMENT, VOLUME 1**  
**TOWN OF BOONES MILL, BOONE DISTRICT, FRANKLIN COUNTY, VA**

PROJECT NO.	20080815
G.L. NO.	297-03-A3.9
FILE NO.	G-12675
DATE:	8/28/09
DRAWN BY:	WCH
CHECKED BY:	BLC

**HURT & PROFFITT**

SHEET NO.  
**M7.0**

**HURT & PROFFITT**  
INCORPORATED  
2524 LANGHORNE ROAD  
LYNCHBURG VA 24501  
800.242.4906 TOLL FREE  
434.847.7796 MAIN  
434.847.0047 FAX

\*ENGINEERING >> SURVEYING >> PLANNING