



UTILITY PLAN

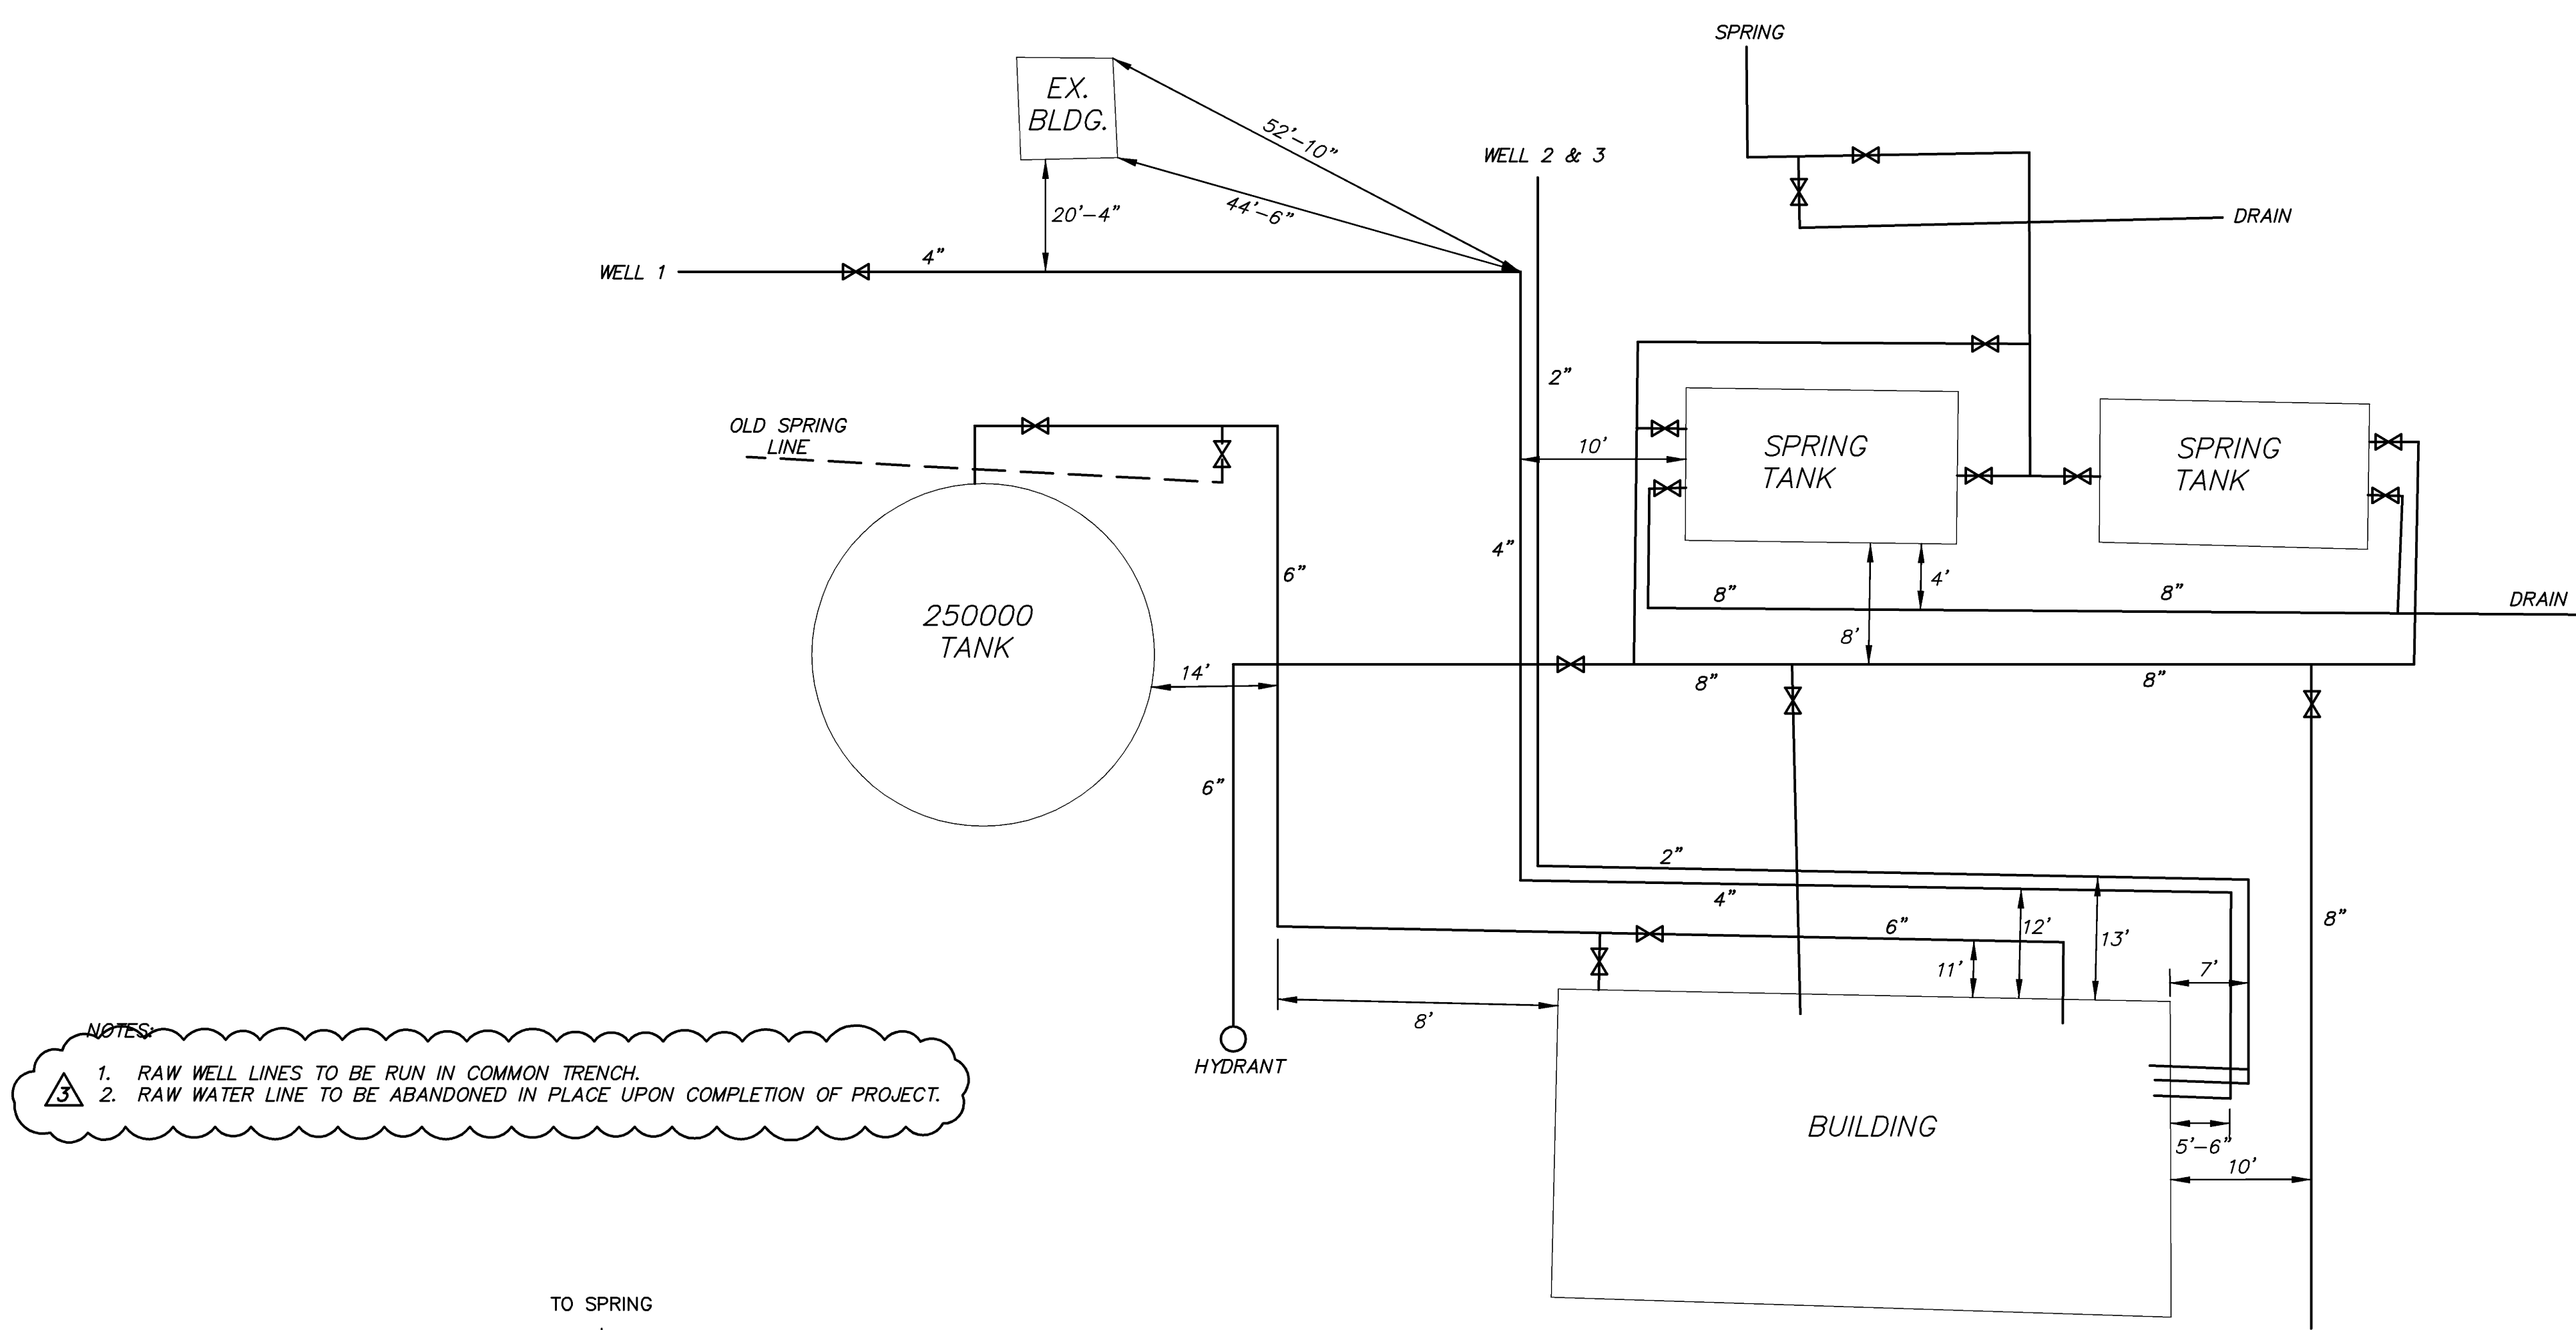


- NOTES:
- 1. RAW WELL LINES TO BE RUN IN COMMON TRENCH.
  - 2. RAW WATER LINE TO BE ABANDONED IN PLACE UPON COMPLETION OF PROJECT.

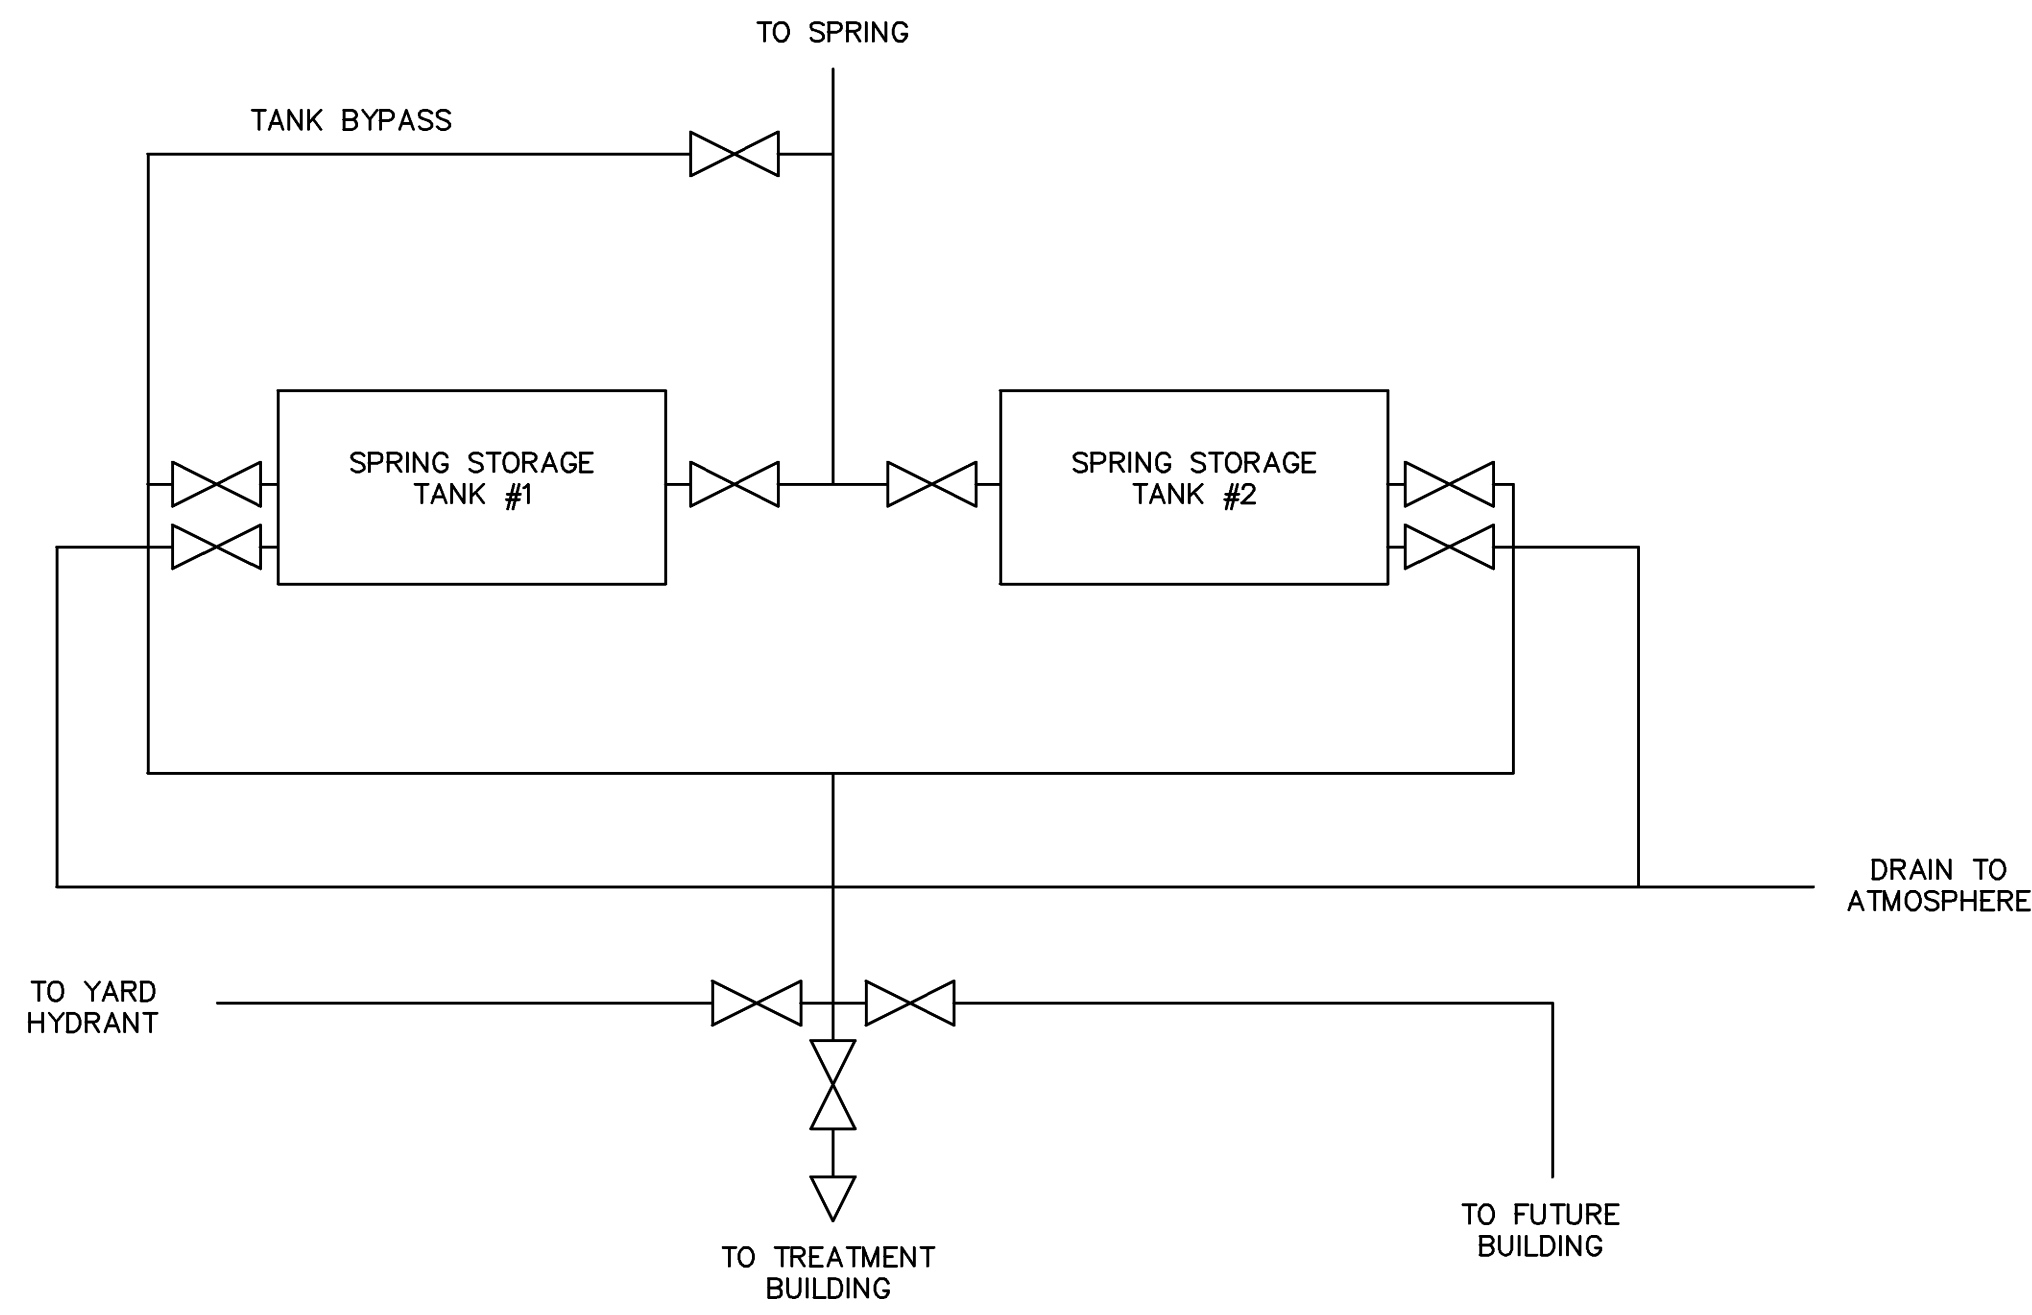

- NOTES:
- 1. ALL PIPING AND VALVES SHOWN ARE TO BE 8\"/>

INSET 1

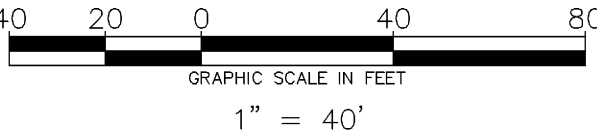

1	8/28/09	VDH/OWNER COMMENTS
2	9/3/09	VDH/OWNER COMMENTS
3	10/7/09	ADDENDUM #2
4	11/17/09	FRANKLIN COUNTY COMMENTS
5	3/14/12	ASBUILTS

**HURT & PROFFITT**  
INCORPORATED

2524 LANGHORNE ROAD  
LYNCHBURG VA 24501  
800.242.4906 TOLL FREE  
434.847.7796 MAIN  
434.847.0047 FAX

**TANK SITE UTILITY PLAN-ASBUILT**  
FOR  
**TOWN OF BOONES MILL WATER SYSTEM REPLACEMENT, VOLUME 2**  
**TOWN OF BOONES MILL, BOONE DISTRICT, FRANKLIN COUNTY, VA**

PROJECT NO. 20080815  
G.L. NO. 297-03-A3.9  
FILE NO. G-12675  
DATE: 7/31/09  
DRAWN BY: ASK  
CHECKED BY: BLC

**HURT & PROFFITT**

SHEET NO.  
**C1.2**