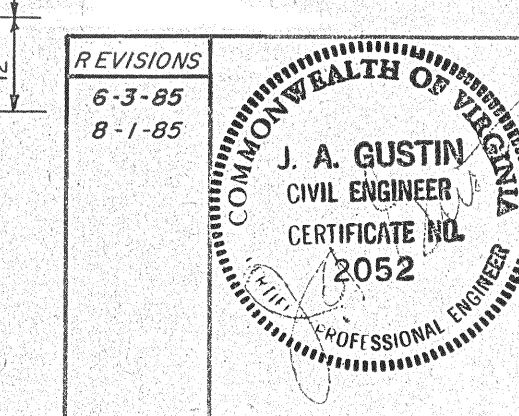
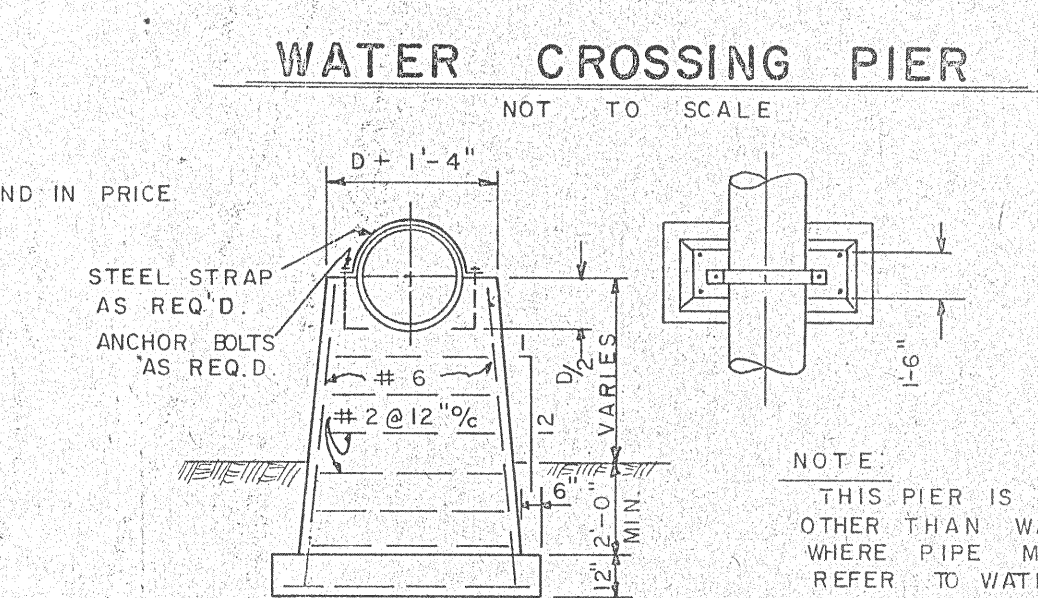
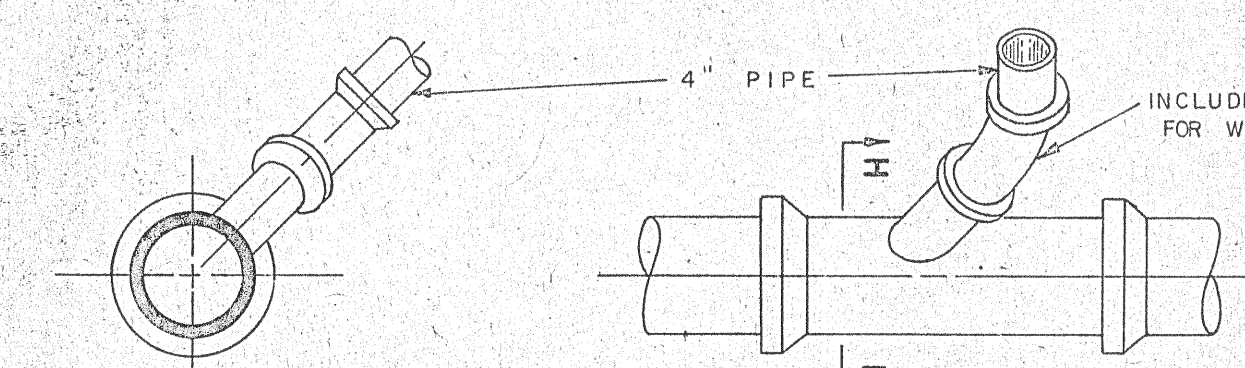
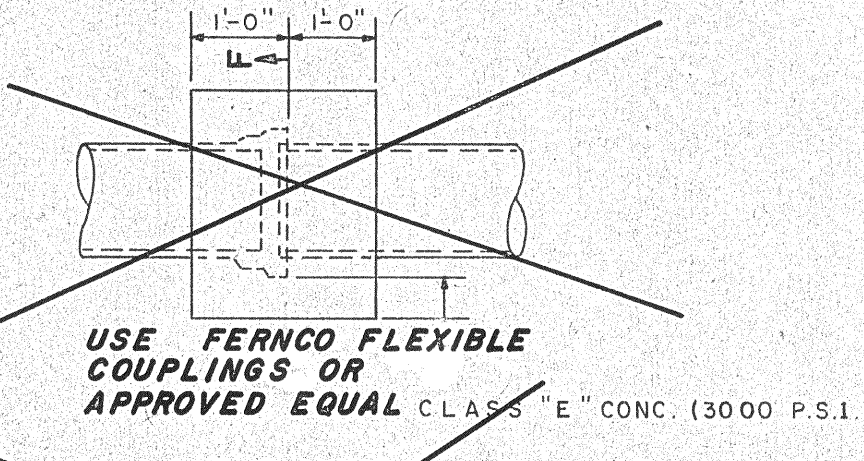
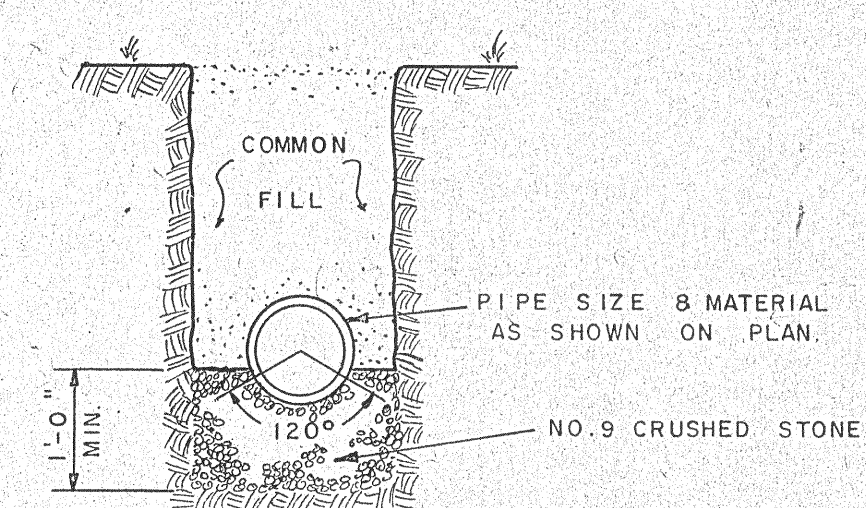
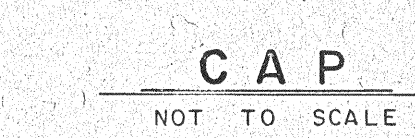
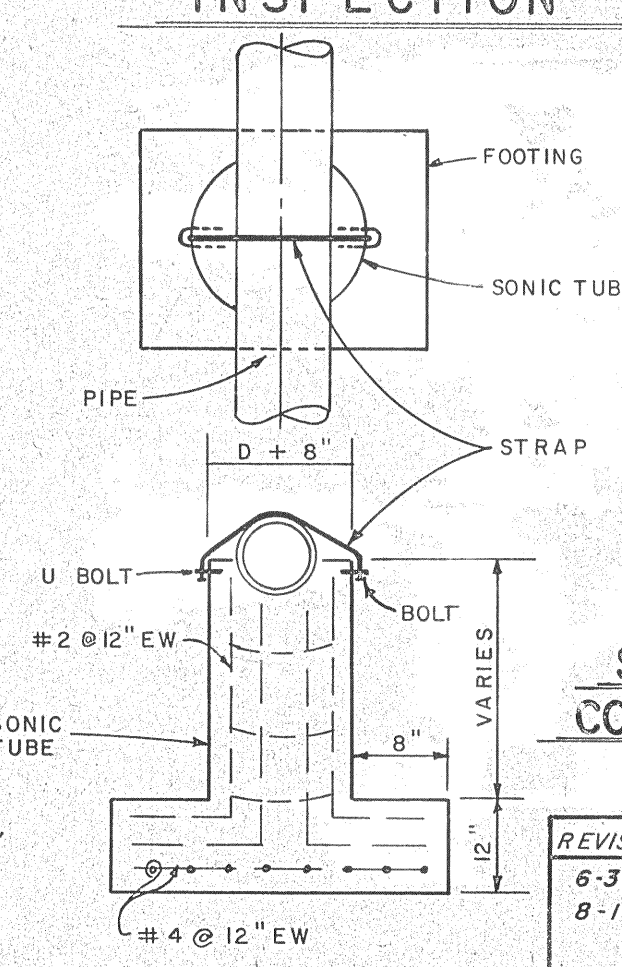
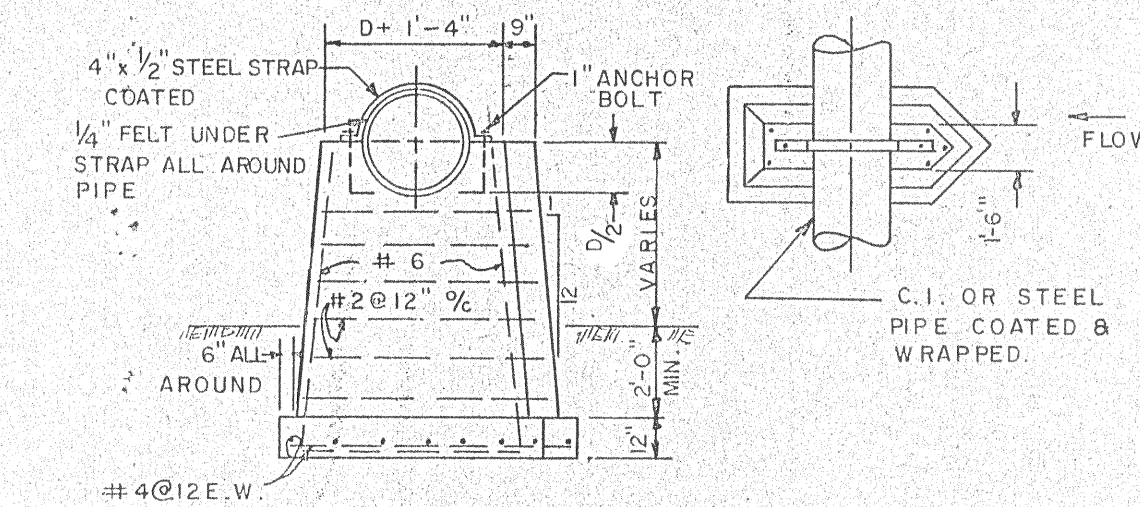
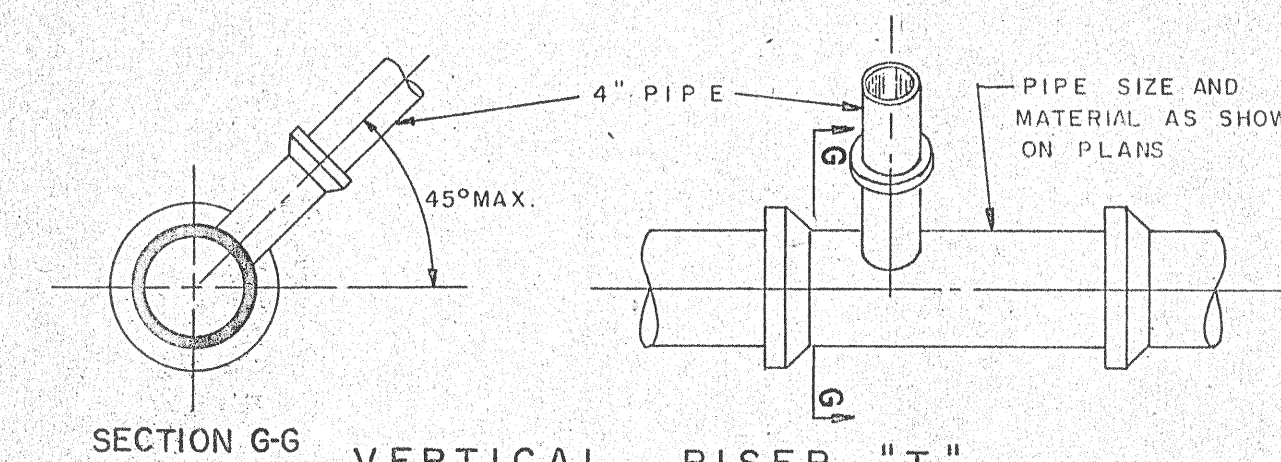
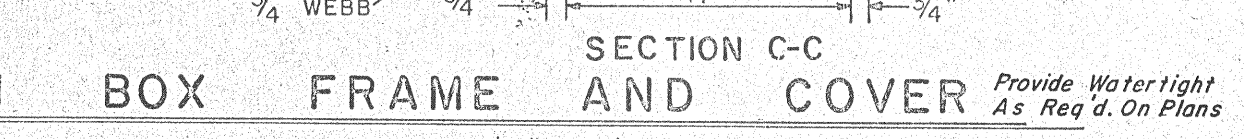
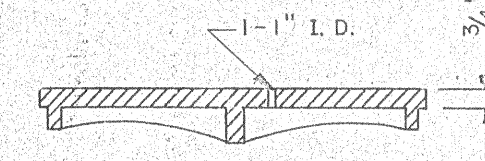
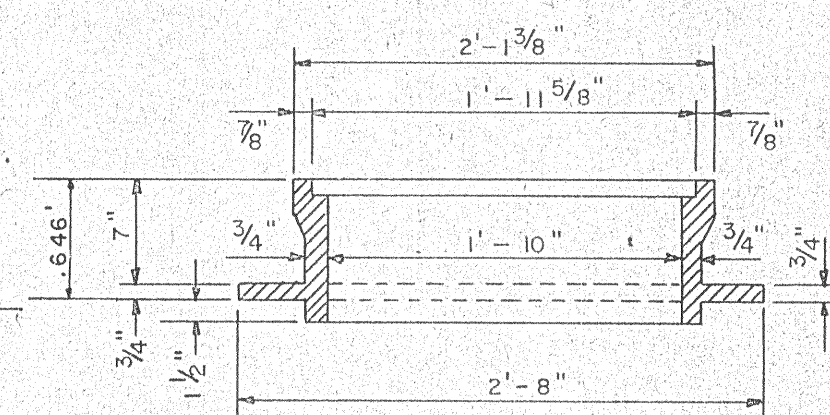
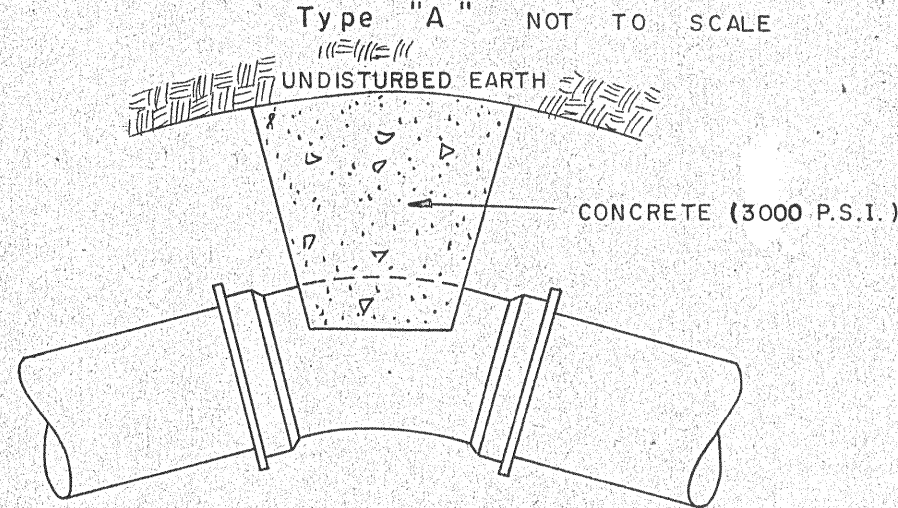
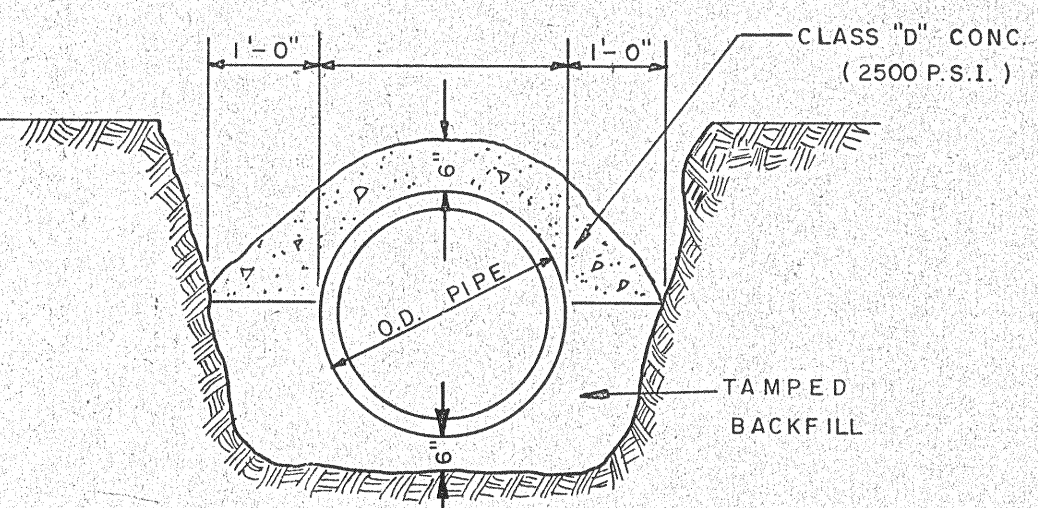
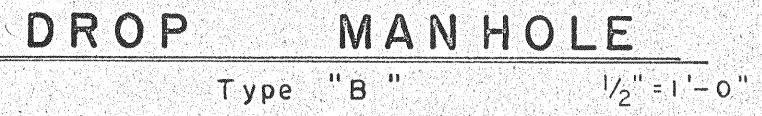
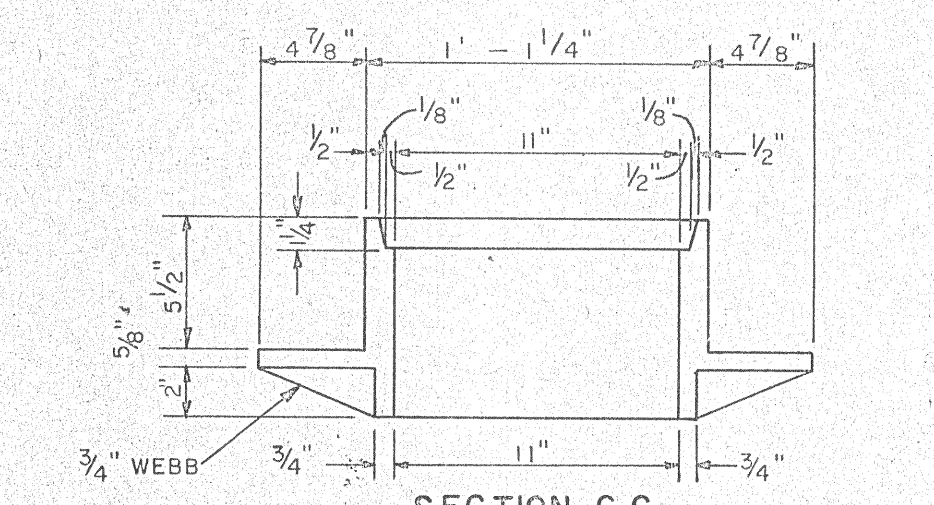
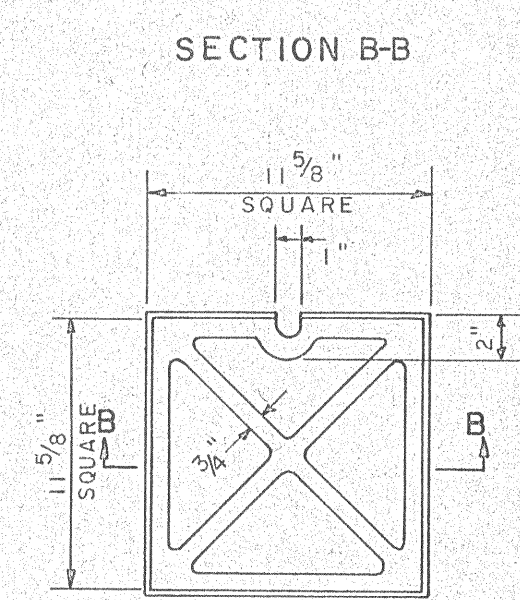
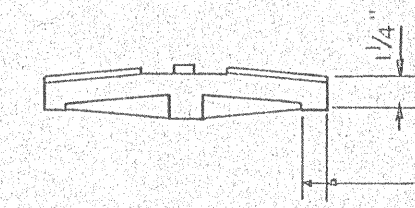
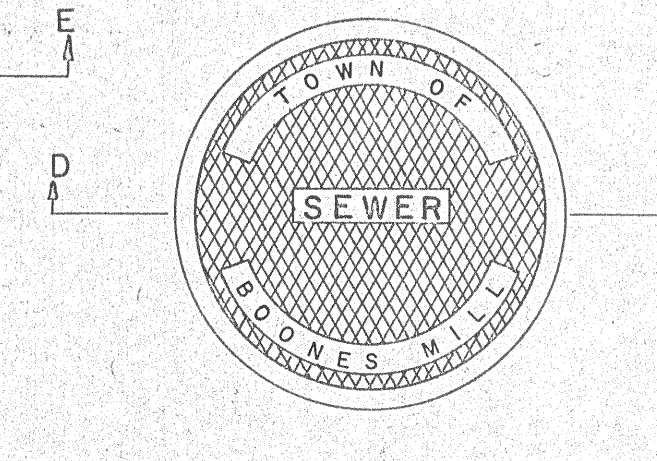
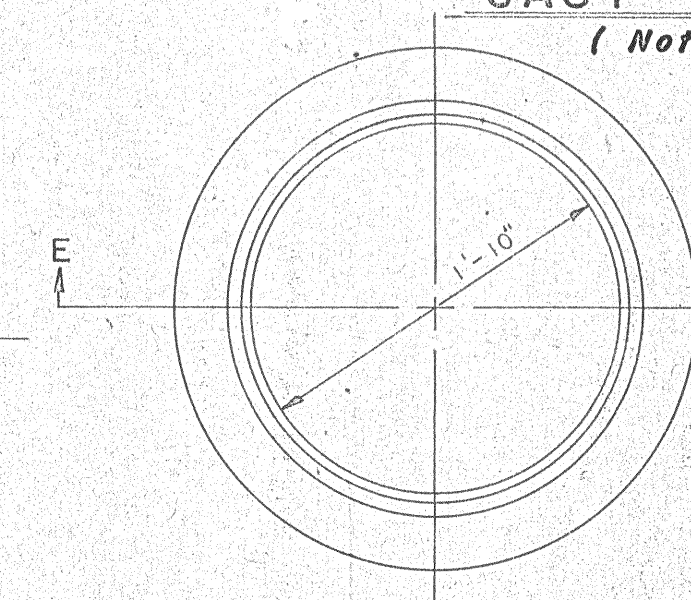
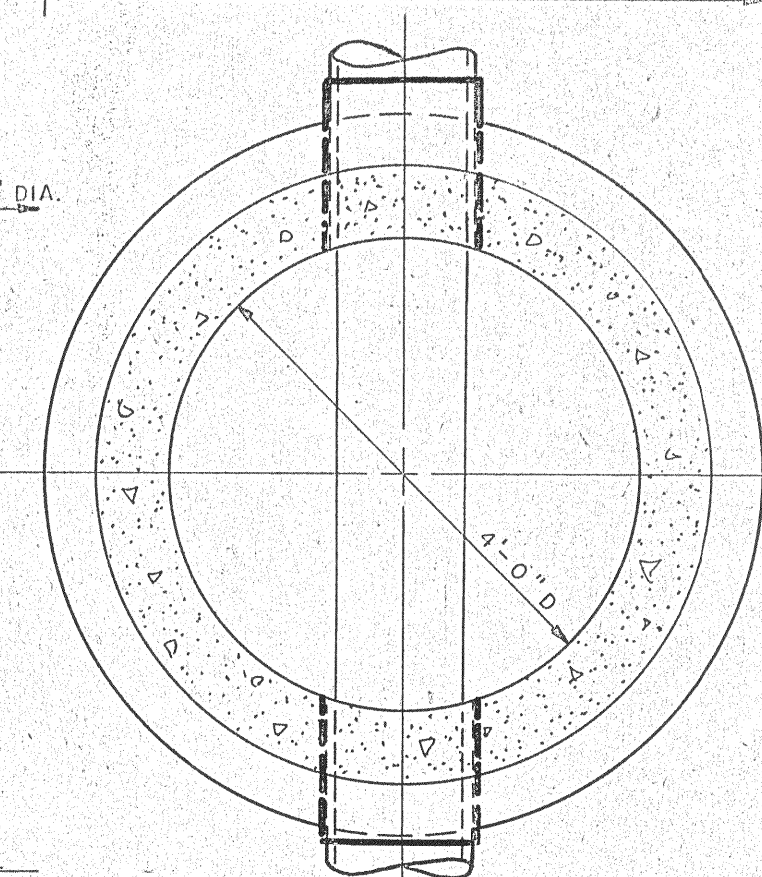
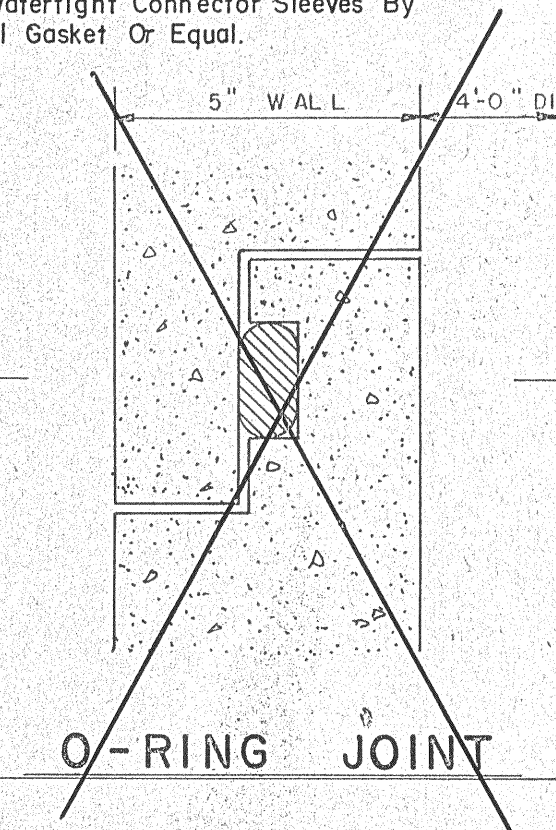
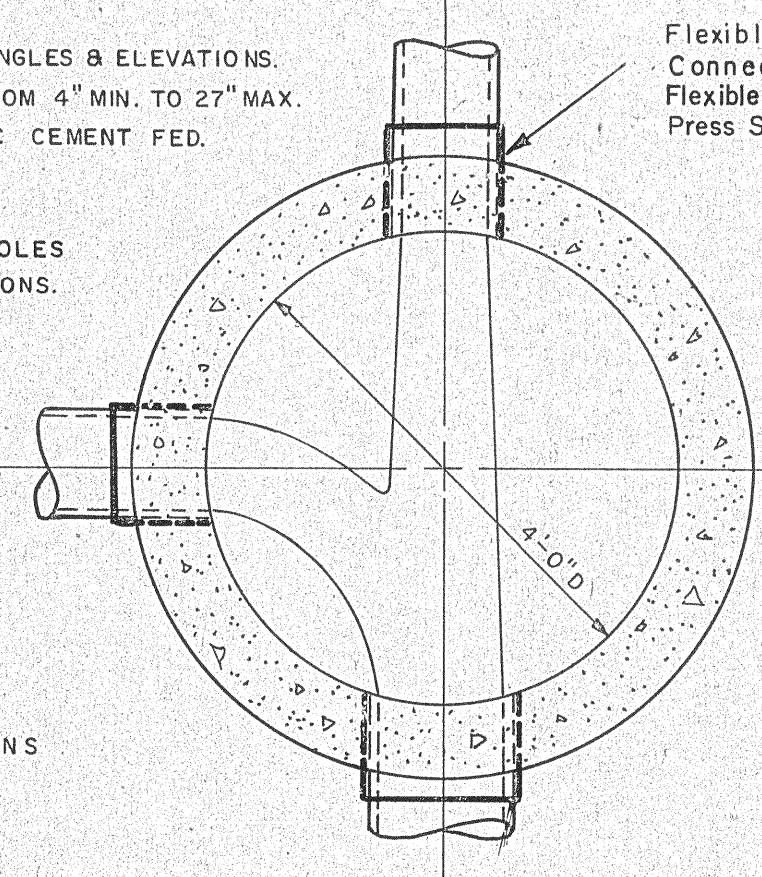
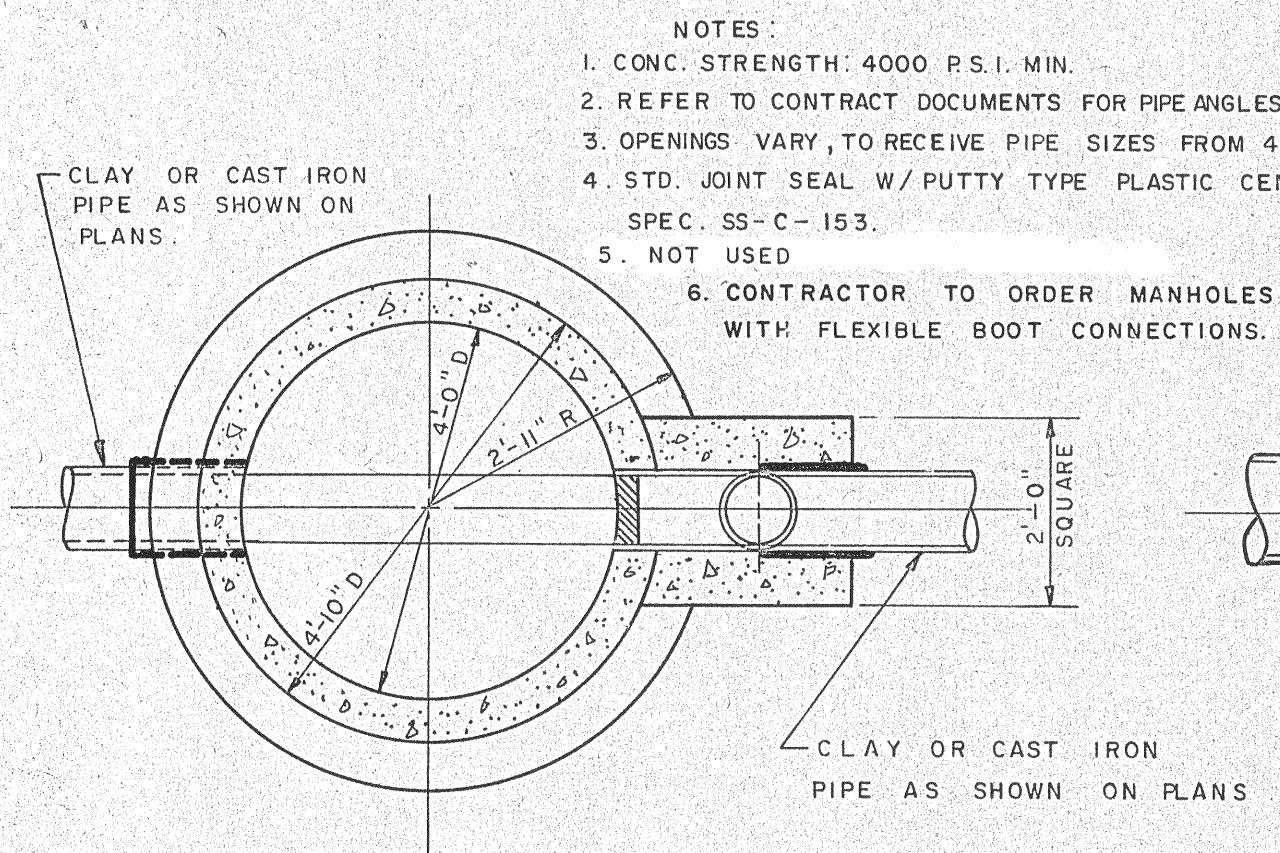
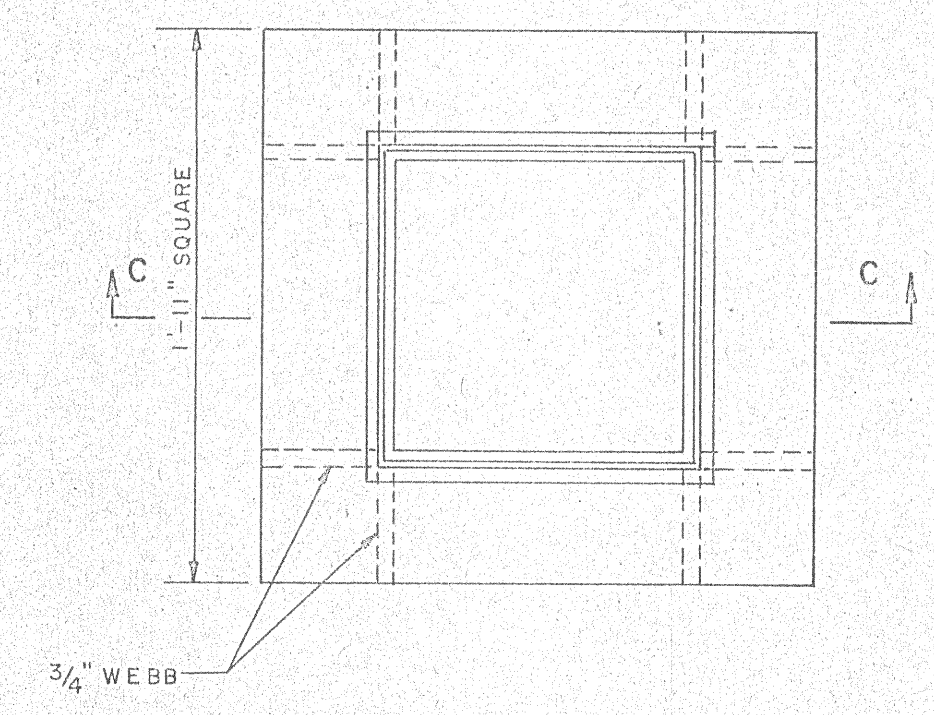
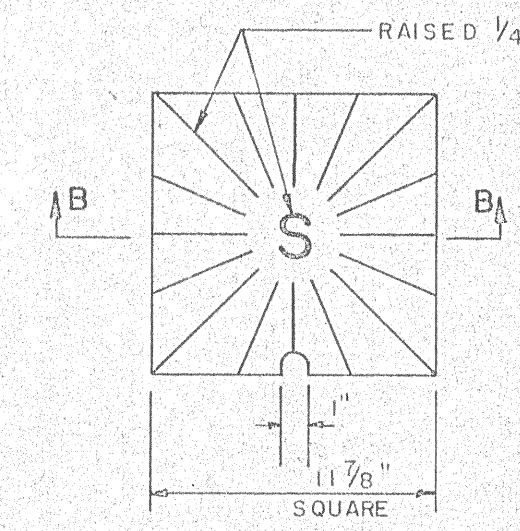
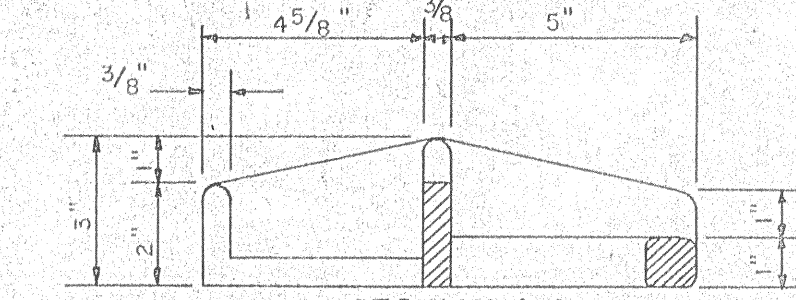
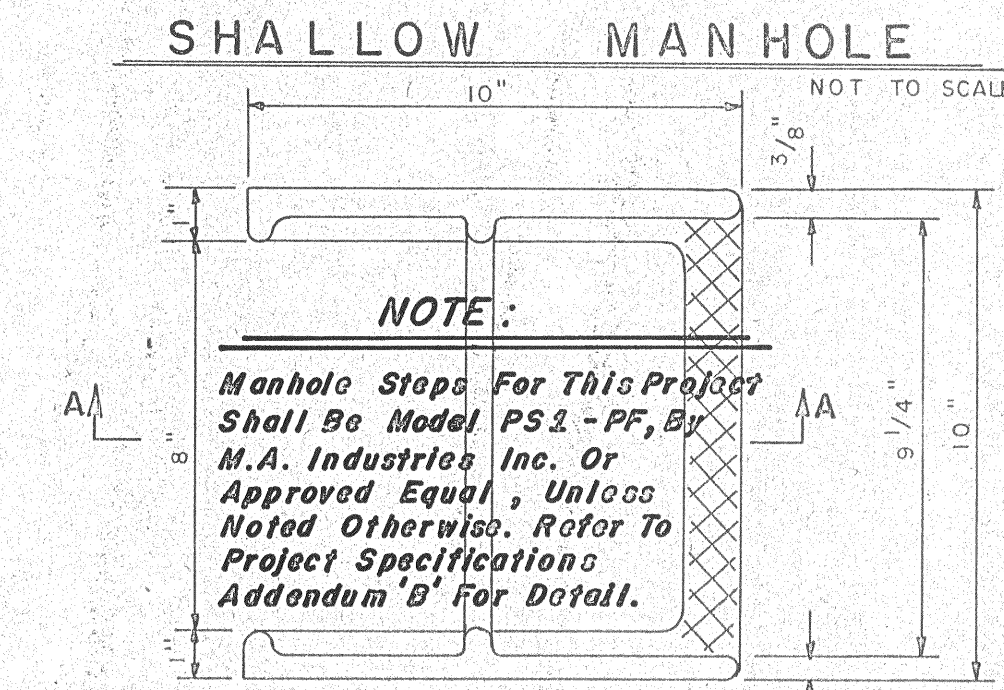
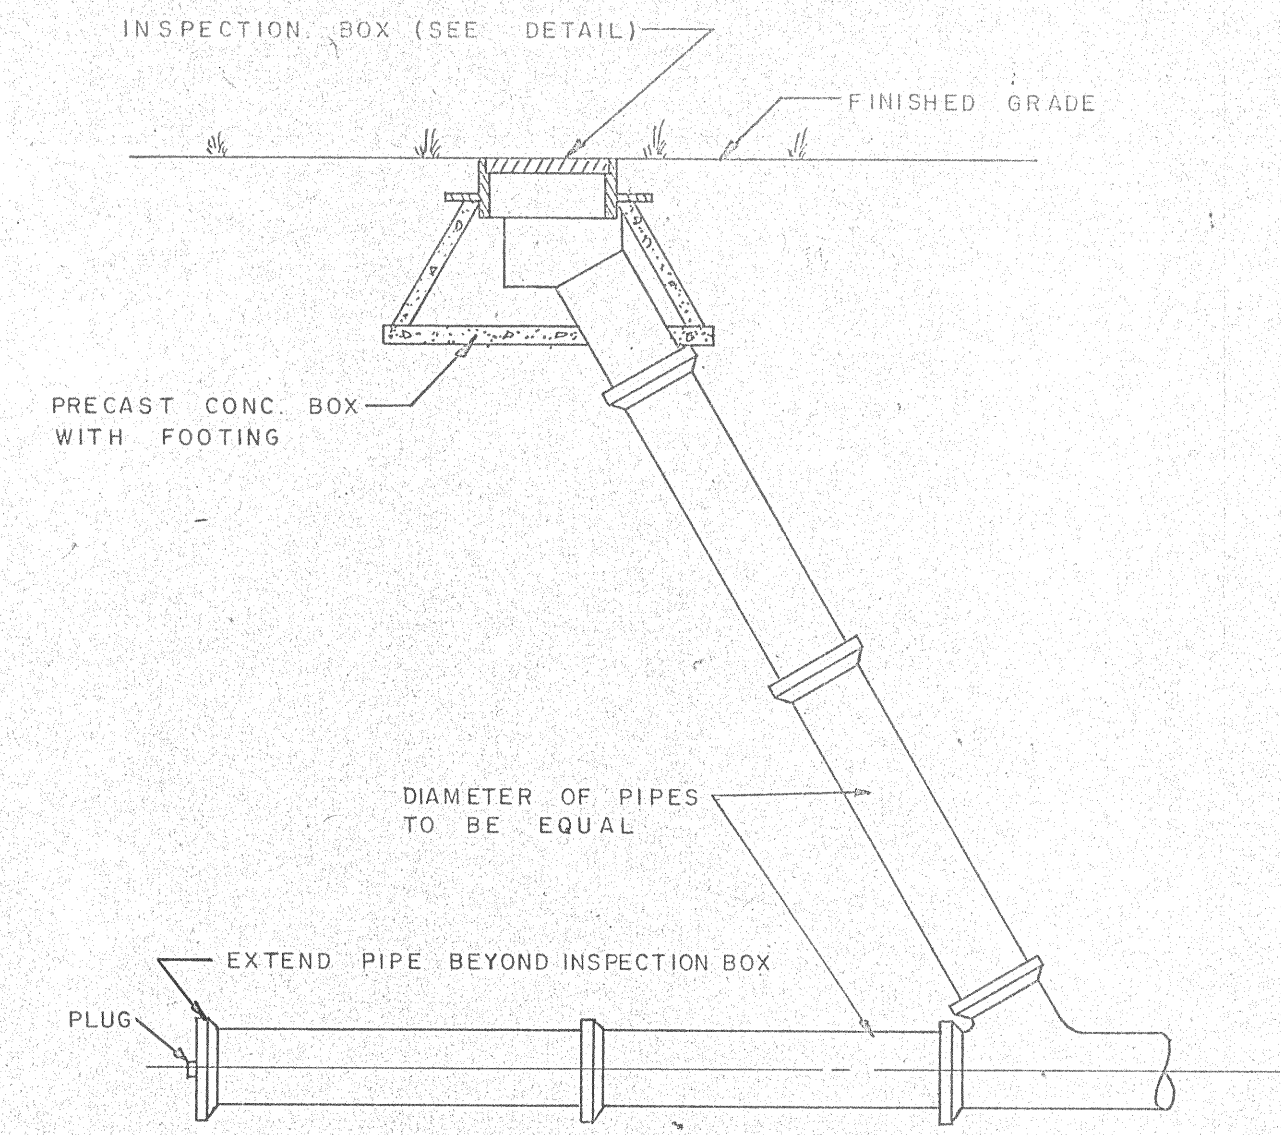
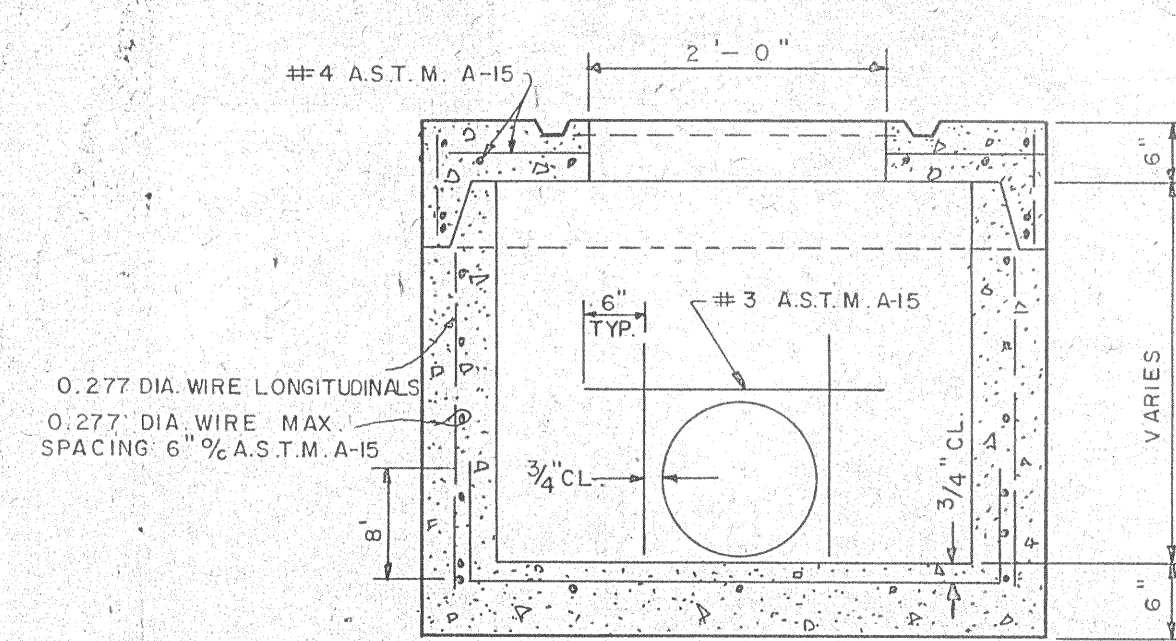
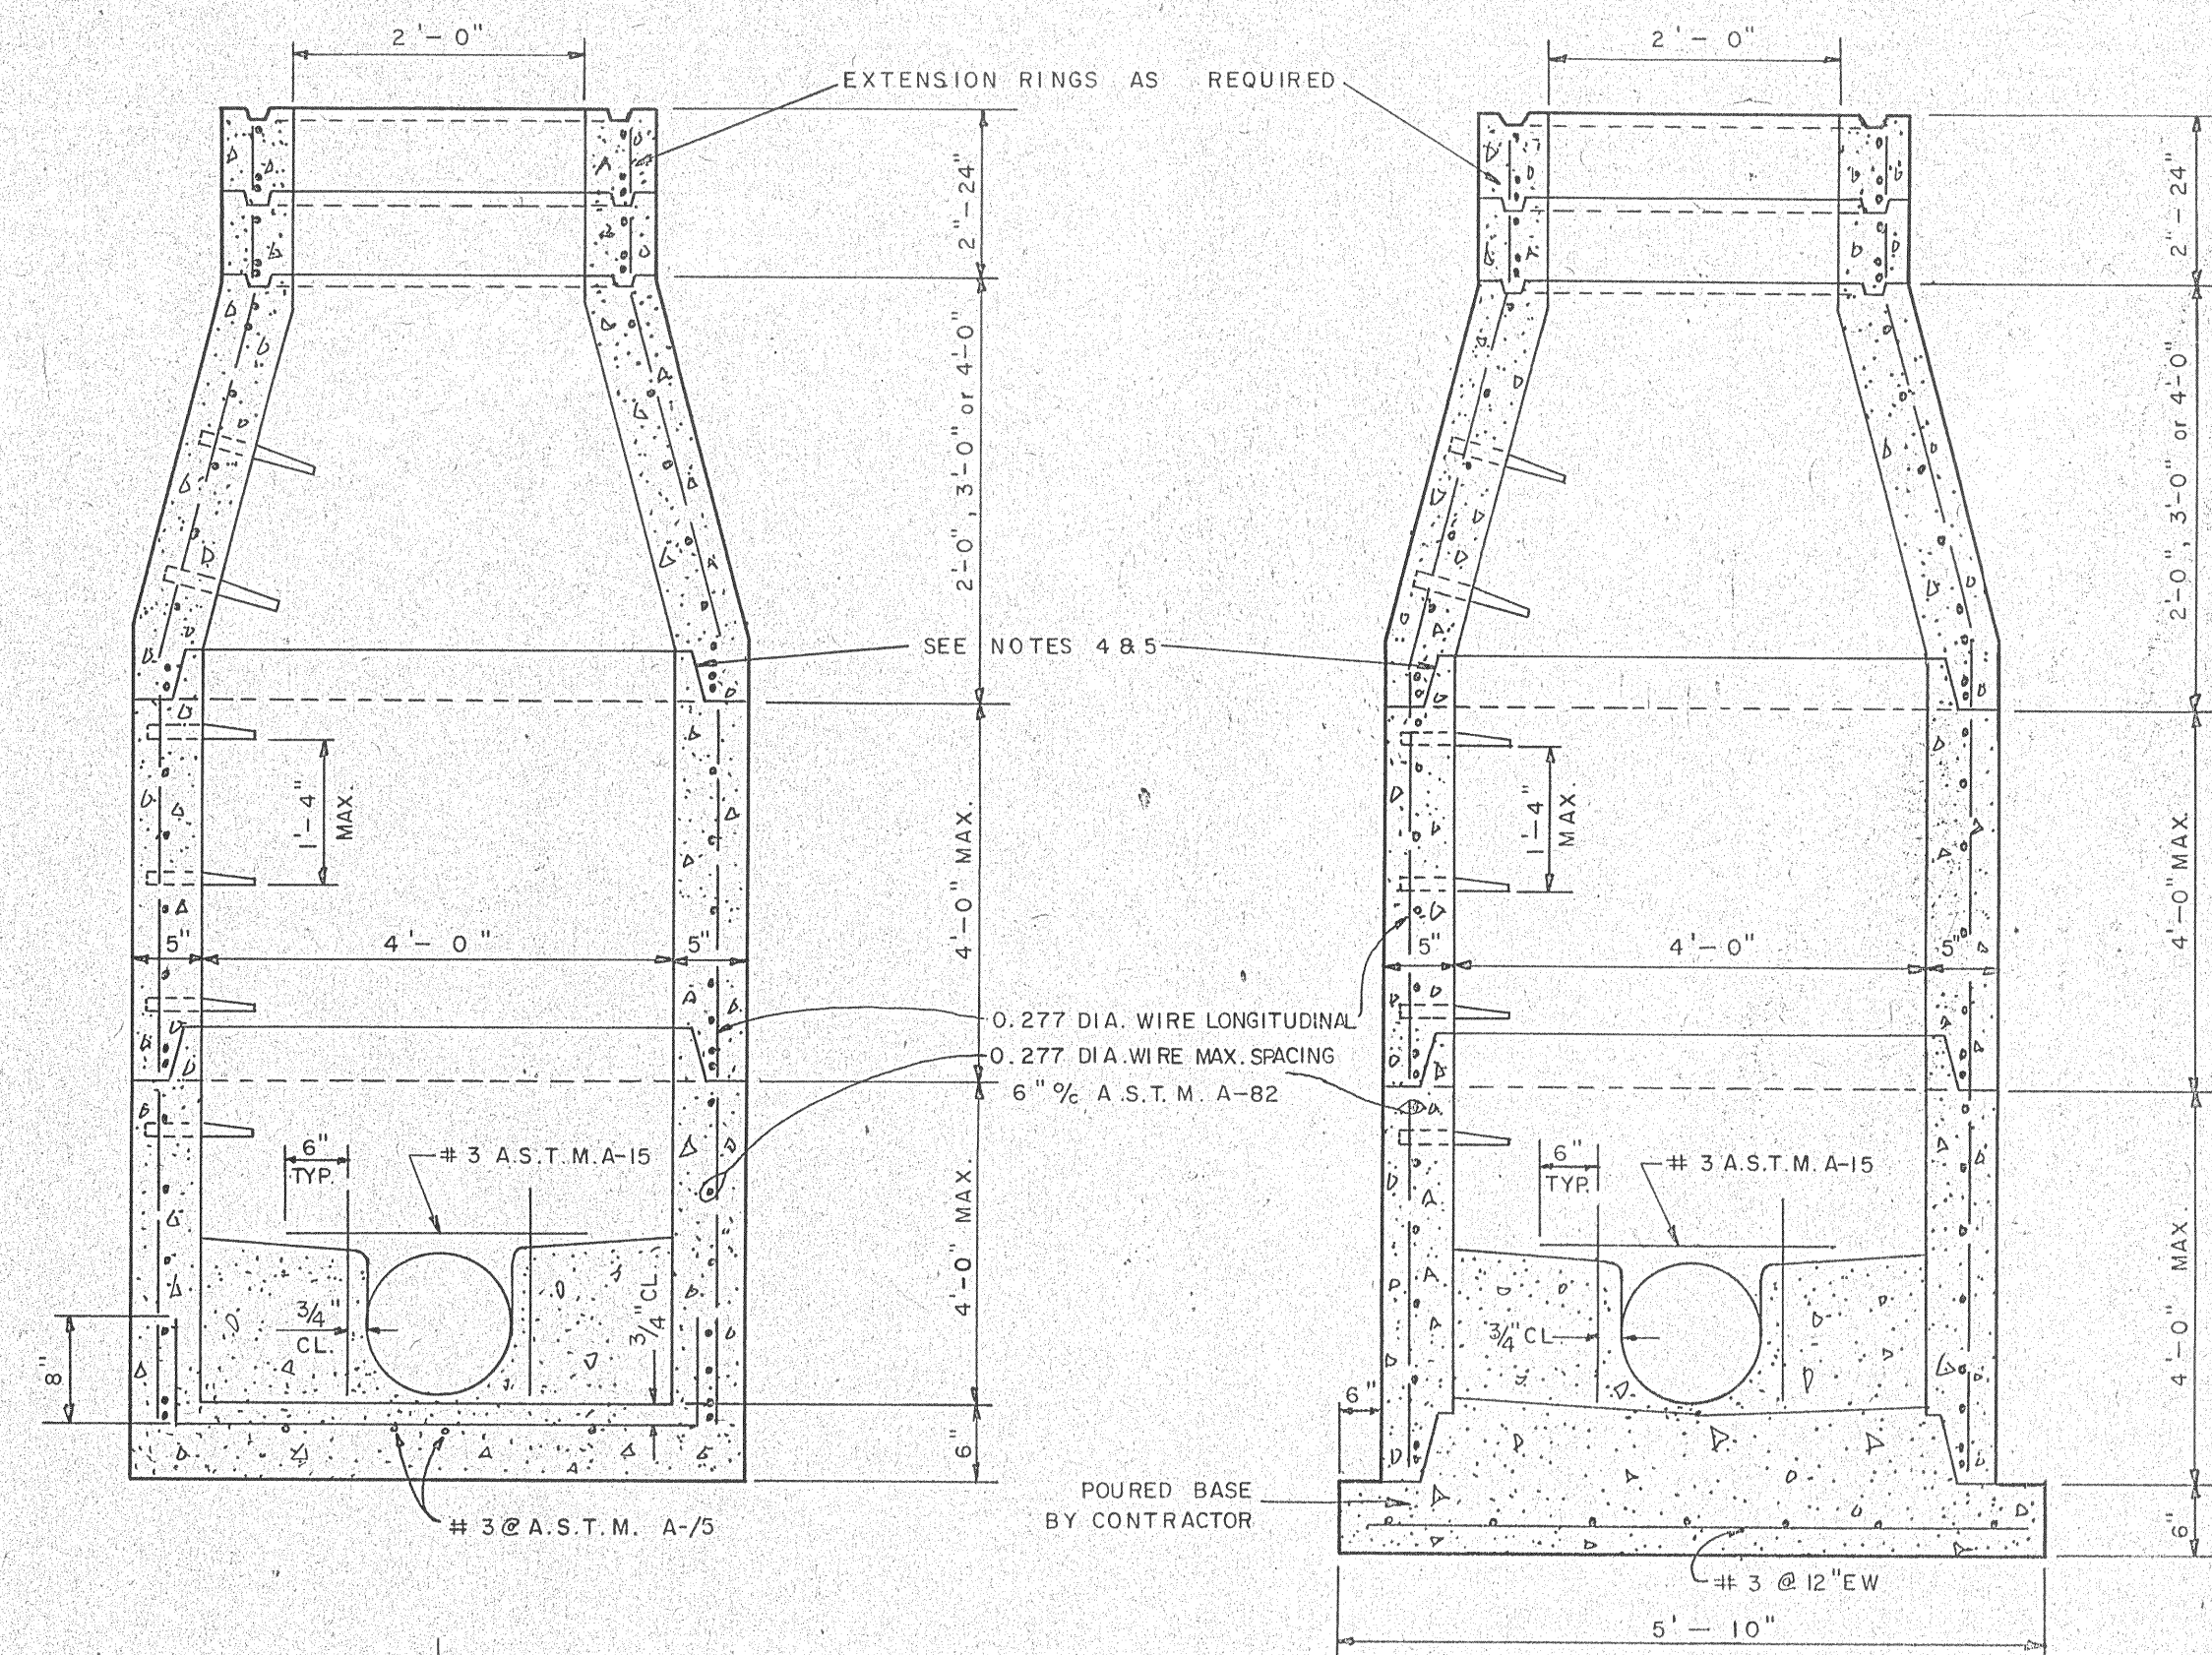


"AS BUILT PLANS"

TOWN OF BOONES MILL

CONSTRUCTION DETAILS

J. A. GUSTIN & ASSOCIATES
CONSULTING ENGINEERS
MARTINSVILLE, VIRGINIA

DESIGNED BY	SCALE
JAG	As Noted
DRAWN BY	DATE

DRAWN BY <i>TAW</i>	DATE <i>11-23-81</i>
CHECKED BY	DRAWING NO.

NRC, JAG	TF-23
----------	-------