


FRANKLIN COUNTY / WESTERN VIRGINIA
WATER AUTHORITY

BOOKER T WASHINGTON HWY

ROUTE 122 WATER EXTENSION
BURNT CHIMNEY, VIRGINIA

PREPARED FOR
FRANKLIN COUNTY
WESTERN VIRGINIA WATER AUTHORITY

VICINITY MAP

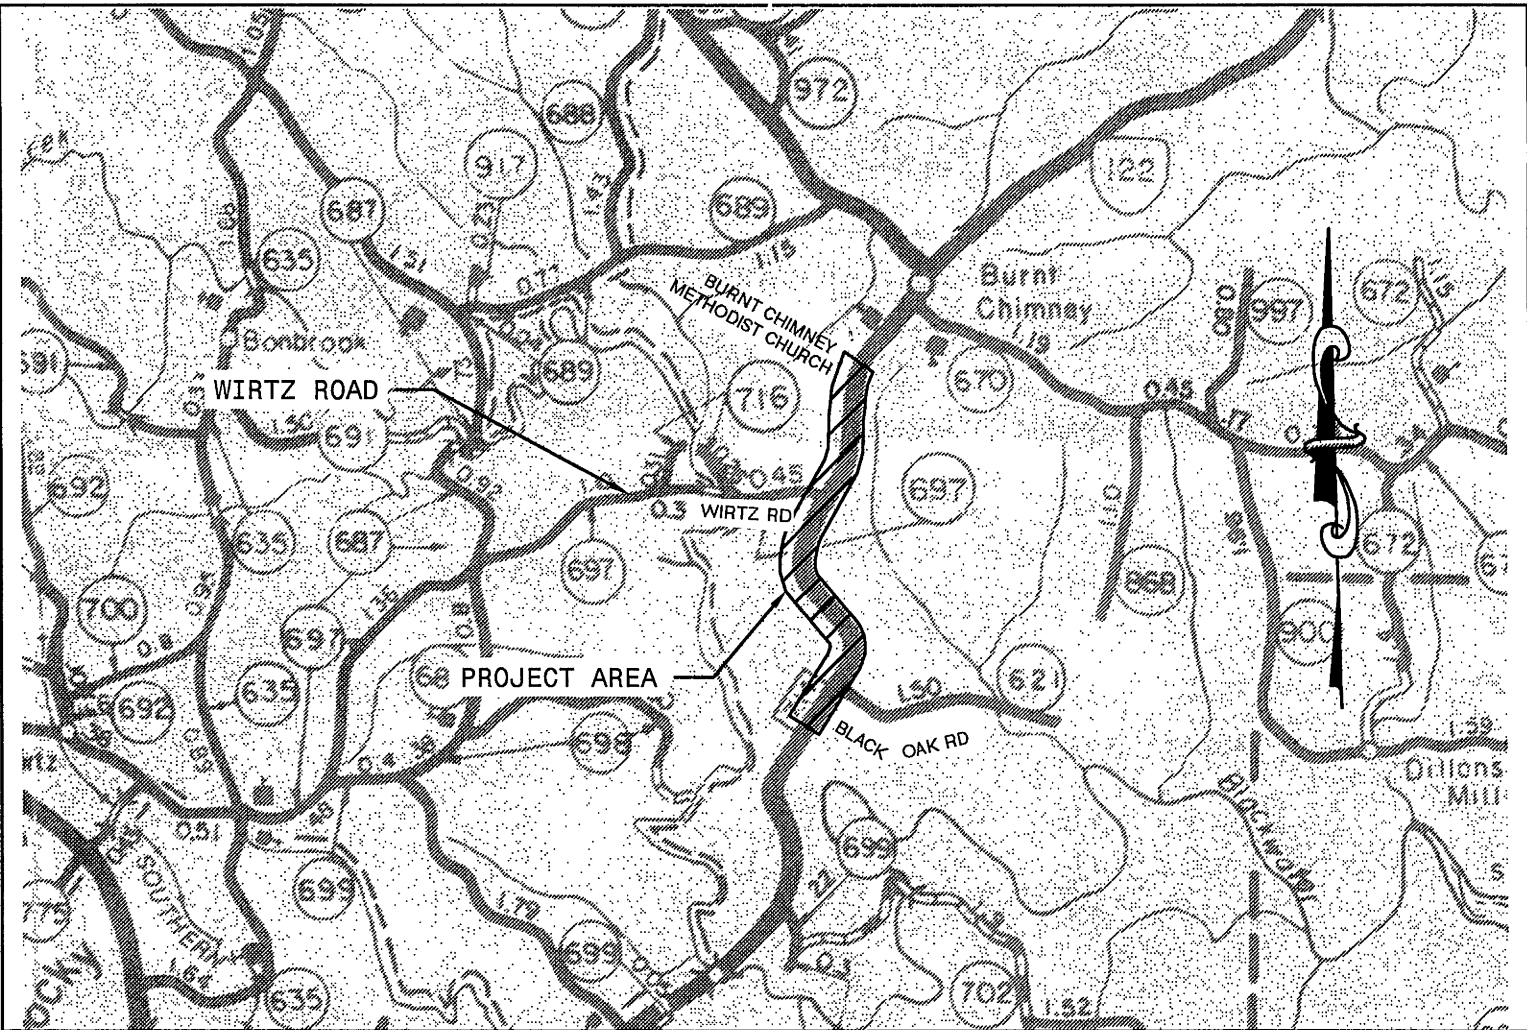

NO:	REVISIONS:	DATE:		OFFICE ADDRESS: 235 CLAIBORNE AVE. ROCKY MOUNT, VA 24151 NUMBERS: PHONE: 540-483-5975 FAX: 540-483-2221 WEBSITE WWW.EARTHENV.COM	FRANKLIN COUNTY / WESTERN VIRGINIA WATER AUTHORITY	DESIGN BY: JSW/CSF	PROJECT: ROUTE 122 WATER EXTENSION	DATE: 02/27/14
						DRAWN BY: JSW		
						REVIEWED BY: CSF	TITLE: TITLE	DRAWING NUMBER: G1
						PROJECT NUMBER: 13-084	DRAWING NAME: 13-084.DWG	SHEET NUMBER: 1 OF 7
							SCALE: N/A	

Contractor As-Builts 8.26.14 K. Winslow