




Received 6.26.14

**FRANKLIN COUNTY / WESTERN VIRGINIA
WATER AUTHORITY**

**LIBERTY HEIGHTS WATER EXTENSION
BURNT CHIMNEY, VIRGINIA**

PREPARED FOR
**FRANKLIN COUNTY
WESTERN VIRGINIA WATER AUTHORITY**

VICINITY MAP

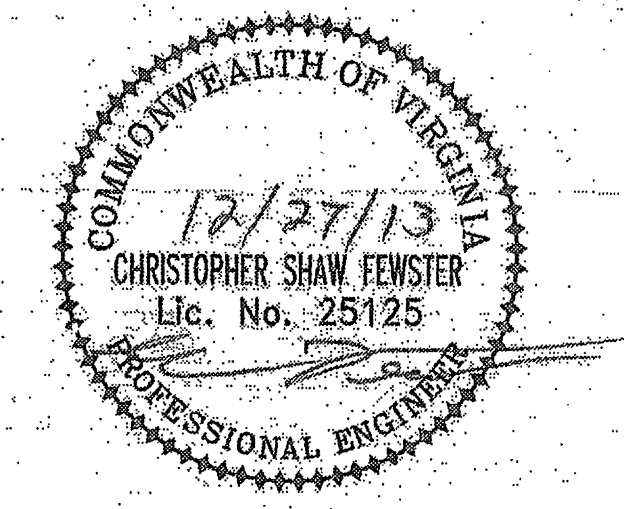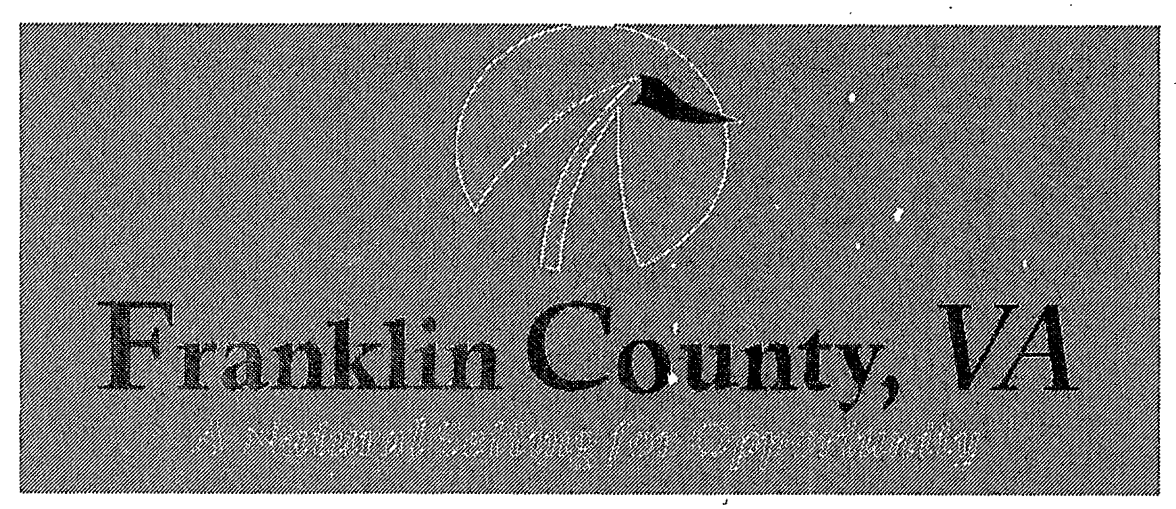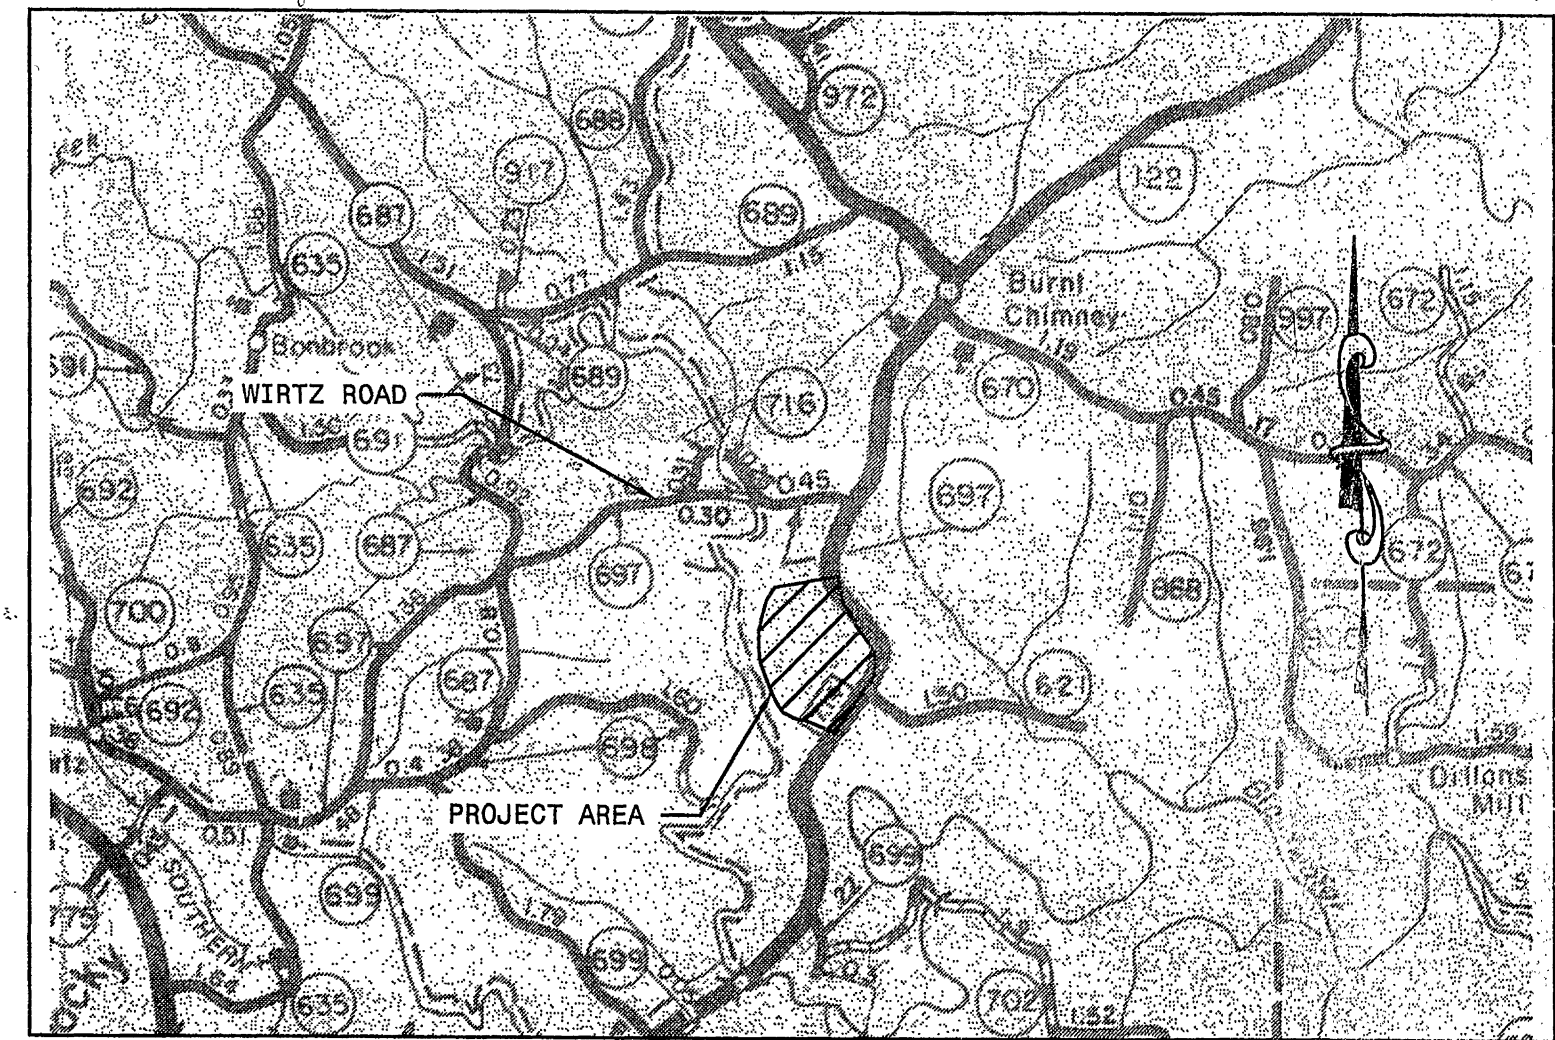

NO:	REVISIONS:	DATE:		OFFICE ADDRESS: 235 CLAIBORNE AVE. ROCKY MOUNT, VA 24151 NUMBERS: PHONE: 540-483-5975 FAX: 540-483-2221 WEBSITE WWW.EARTHENV.COM	FRANKLIN COUNTY / WESTERN VIRGINIA WATER AUTHORITY	DESIGN BY: JSW	PROJECT: LIBERTY HEIGHTS WATER EXTENSION	DATE: 12/27/13
						DRAWN BY: JSW		
						REVIEWED BY: CSF	TITLE:	DRAWING NUMBER: G1
						PROJECT NUMBER: 13-062	DRAWING NAME: 13-062.DWG	SHEET NUMBER: 1 OF 10
							SCALE: N/A	

Contractor As-Builts 6.26.14 C.Wells/K.Winslow