

"AS-BUILT" WATER FACILITIES

FOR


STORAGE TANK & BOOSTER STATION

SECTION No. 1, CHESTNUT CREEK

SITUATED IN
FRANKLIN COUNTY, VIRGINIA

DATE: 10 JANUARY 1991

PROPERTY OF
CHESTNUT CREEK PROPERTIES, INC.

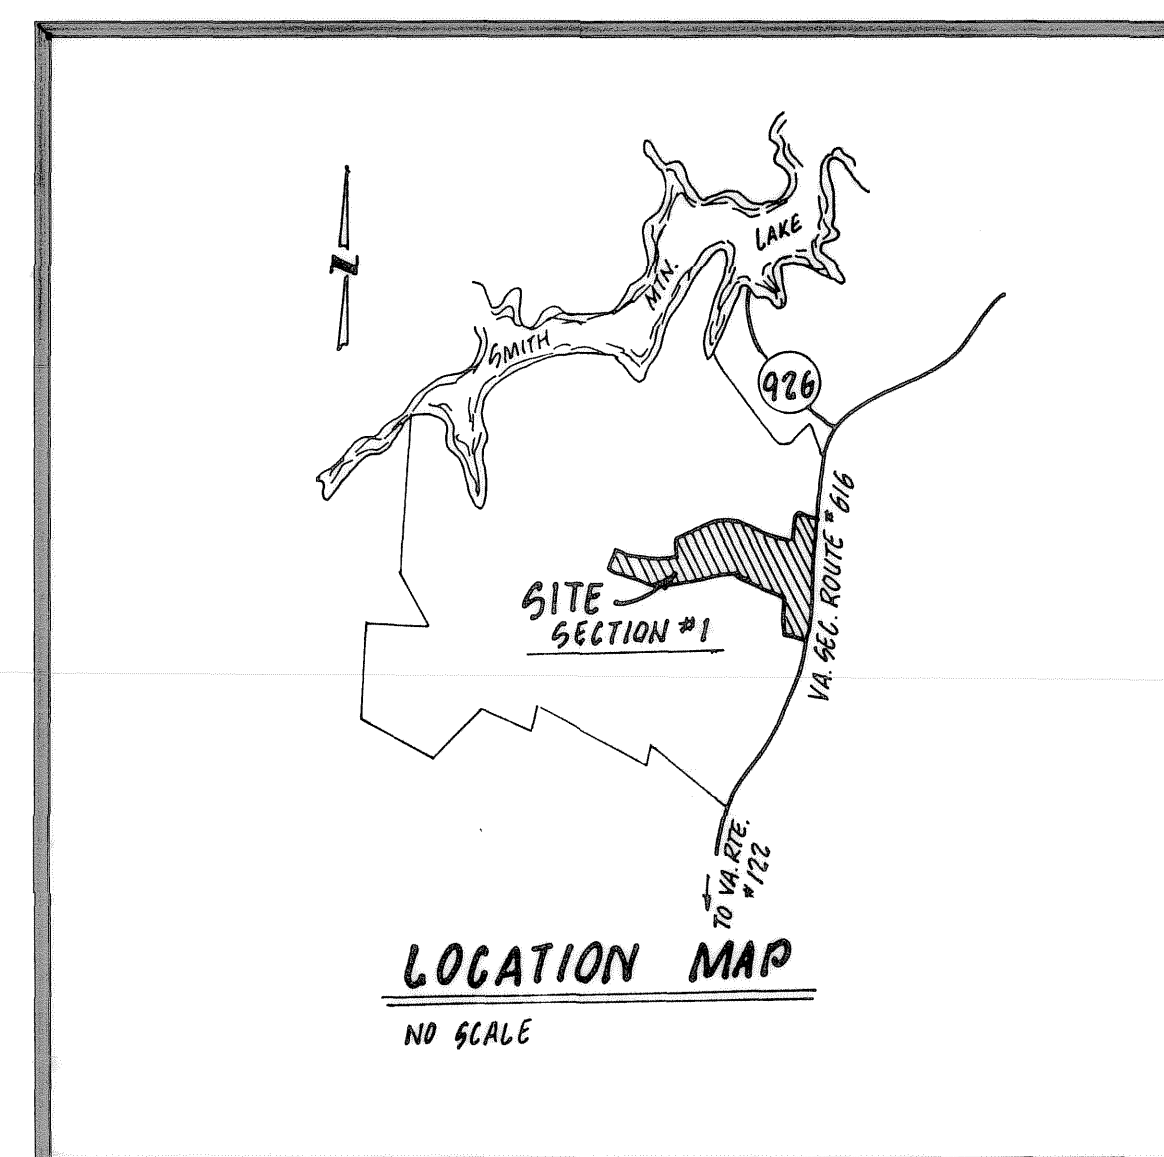

INDEX OF DRAWINGS

SHEET No.	DESCRIPTION
-----------	-------------

- | | |
|----|--------------------------------|
| 1. | LUMSDEN ASSOCIATES COVER SHEET |
| 2. | "AS-BUILT" WATER FACILITIES |

LUMSDEN ASSOCIATES, P.C.
ENGINEERS—SURVEYORS—PLANNERS
ROANOKE, VIRGINIA