

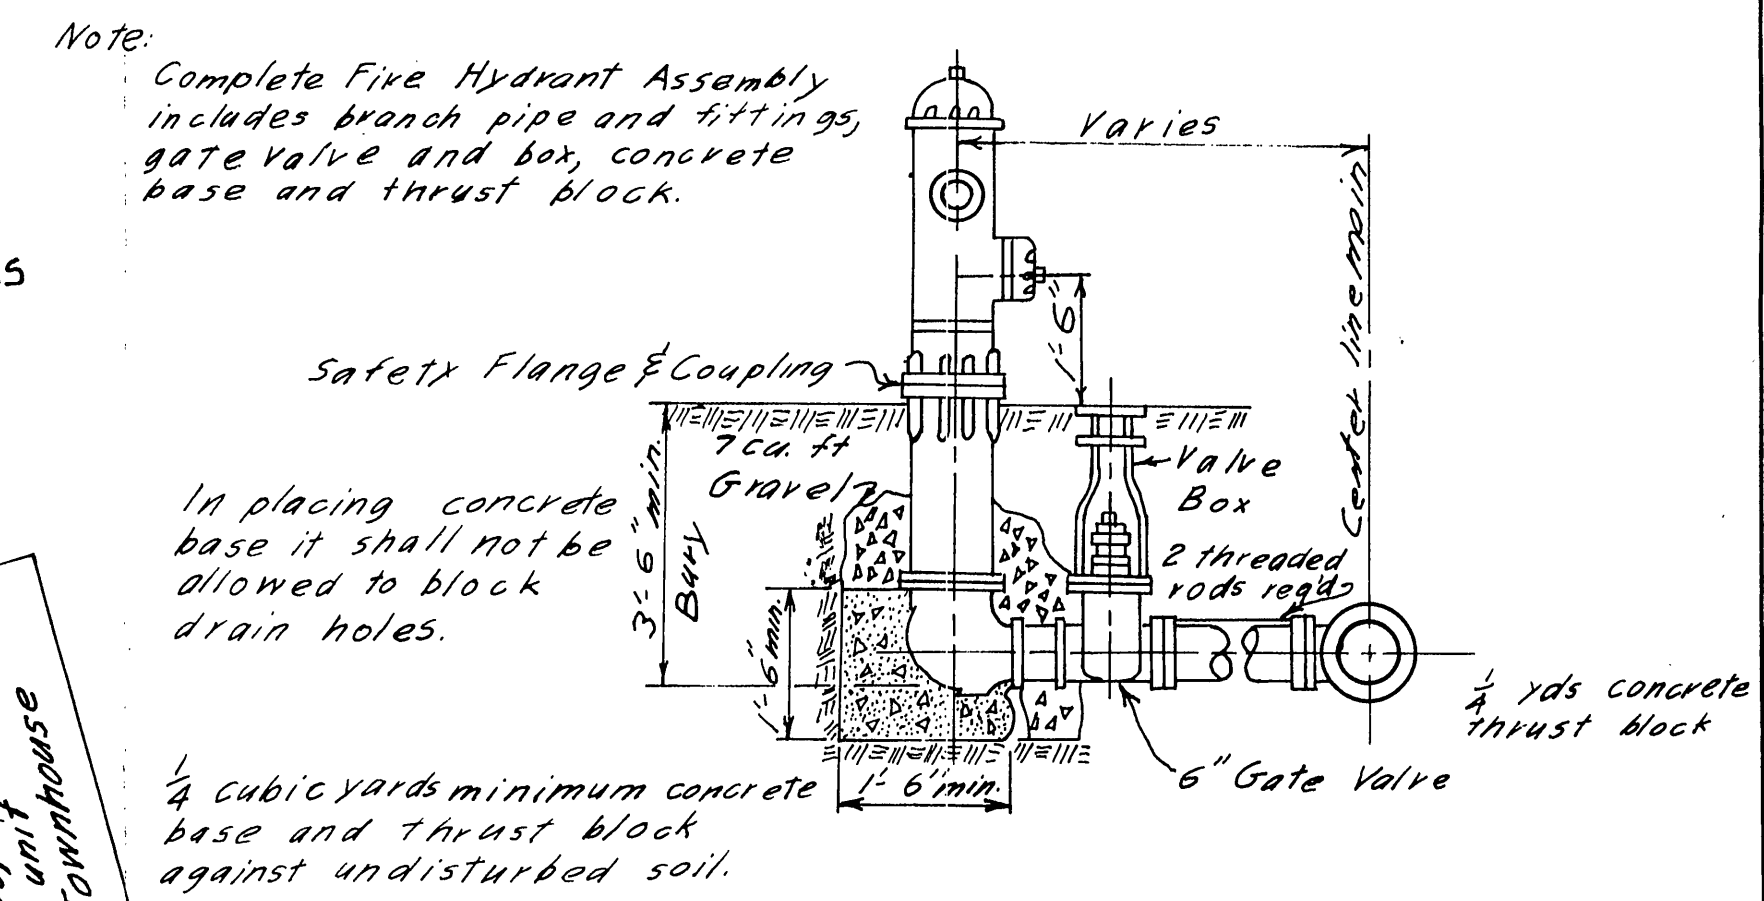


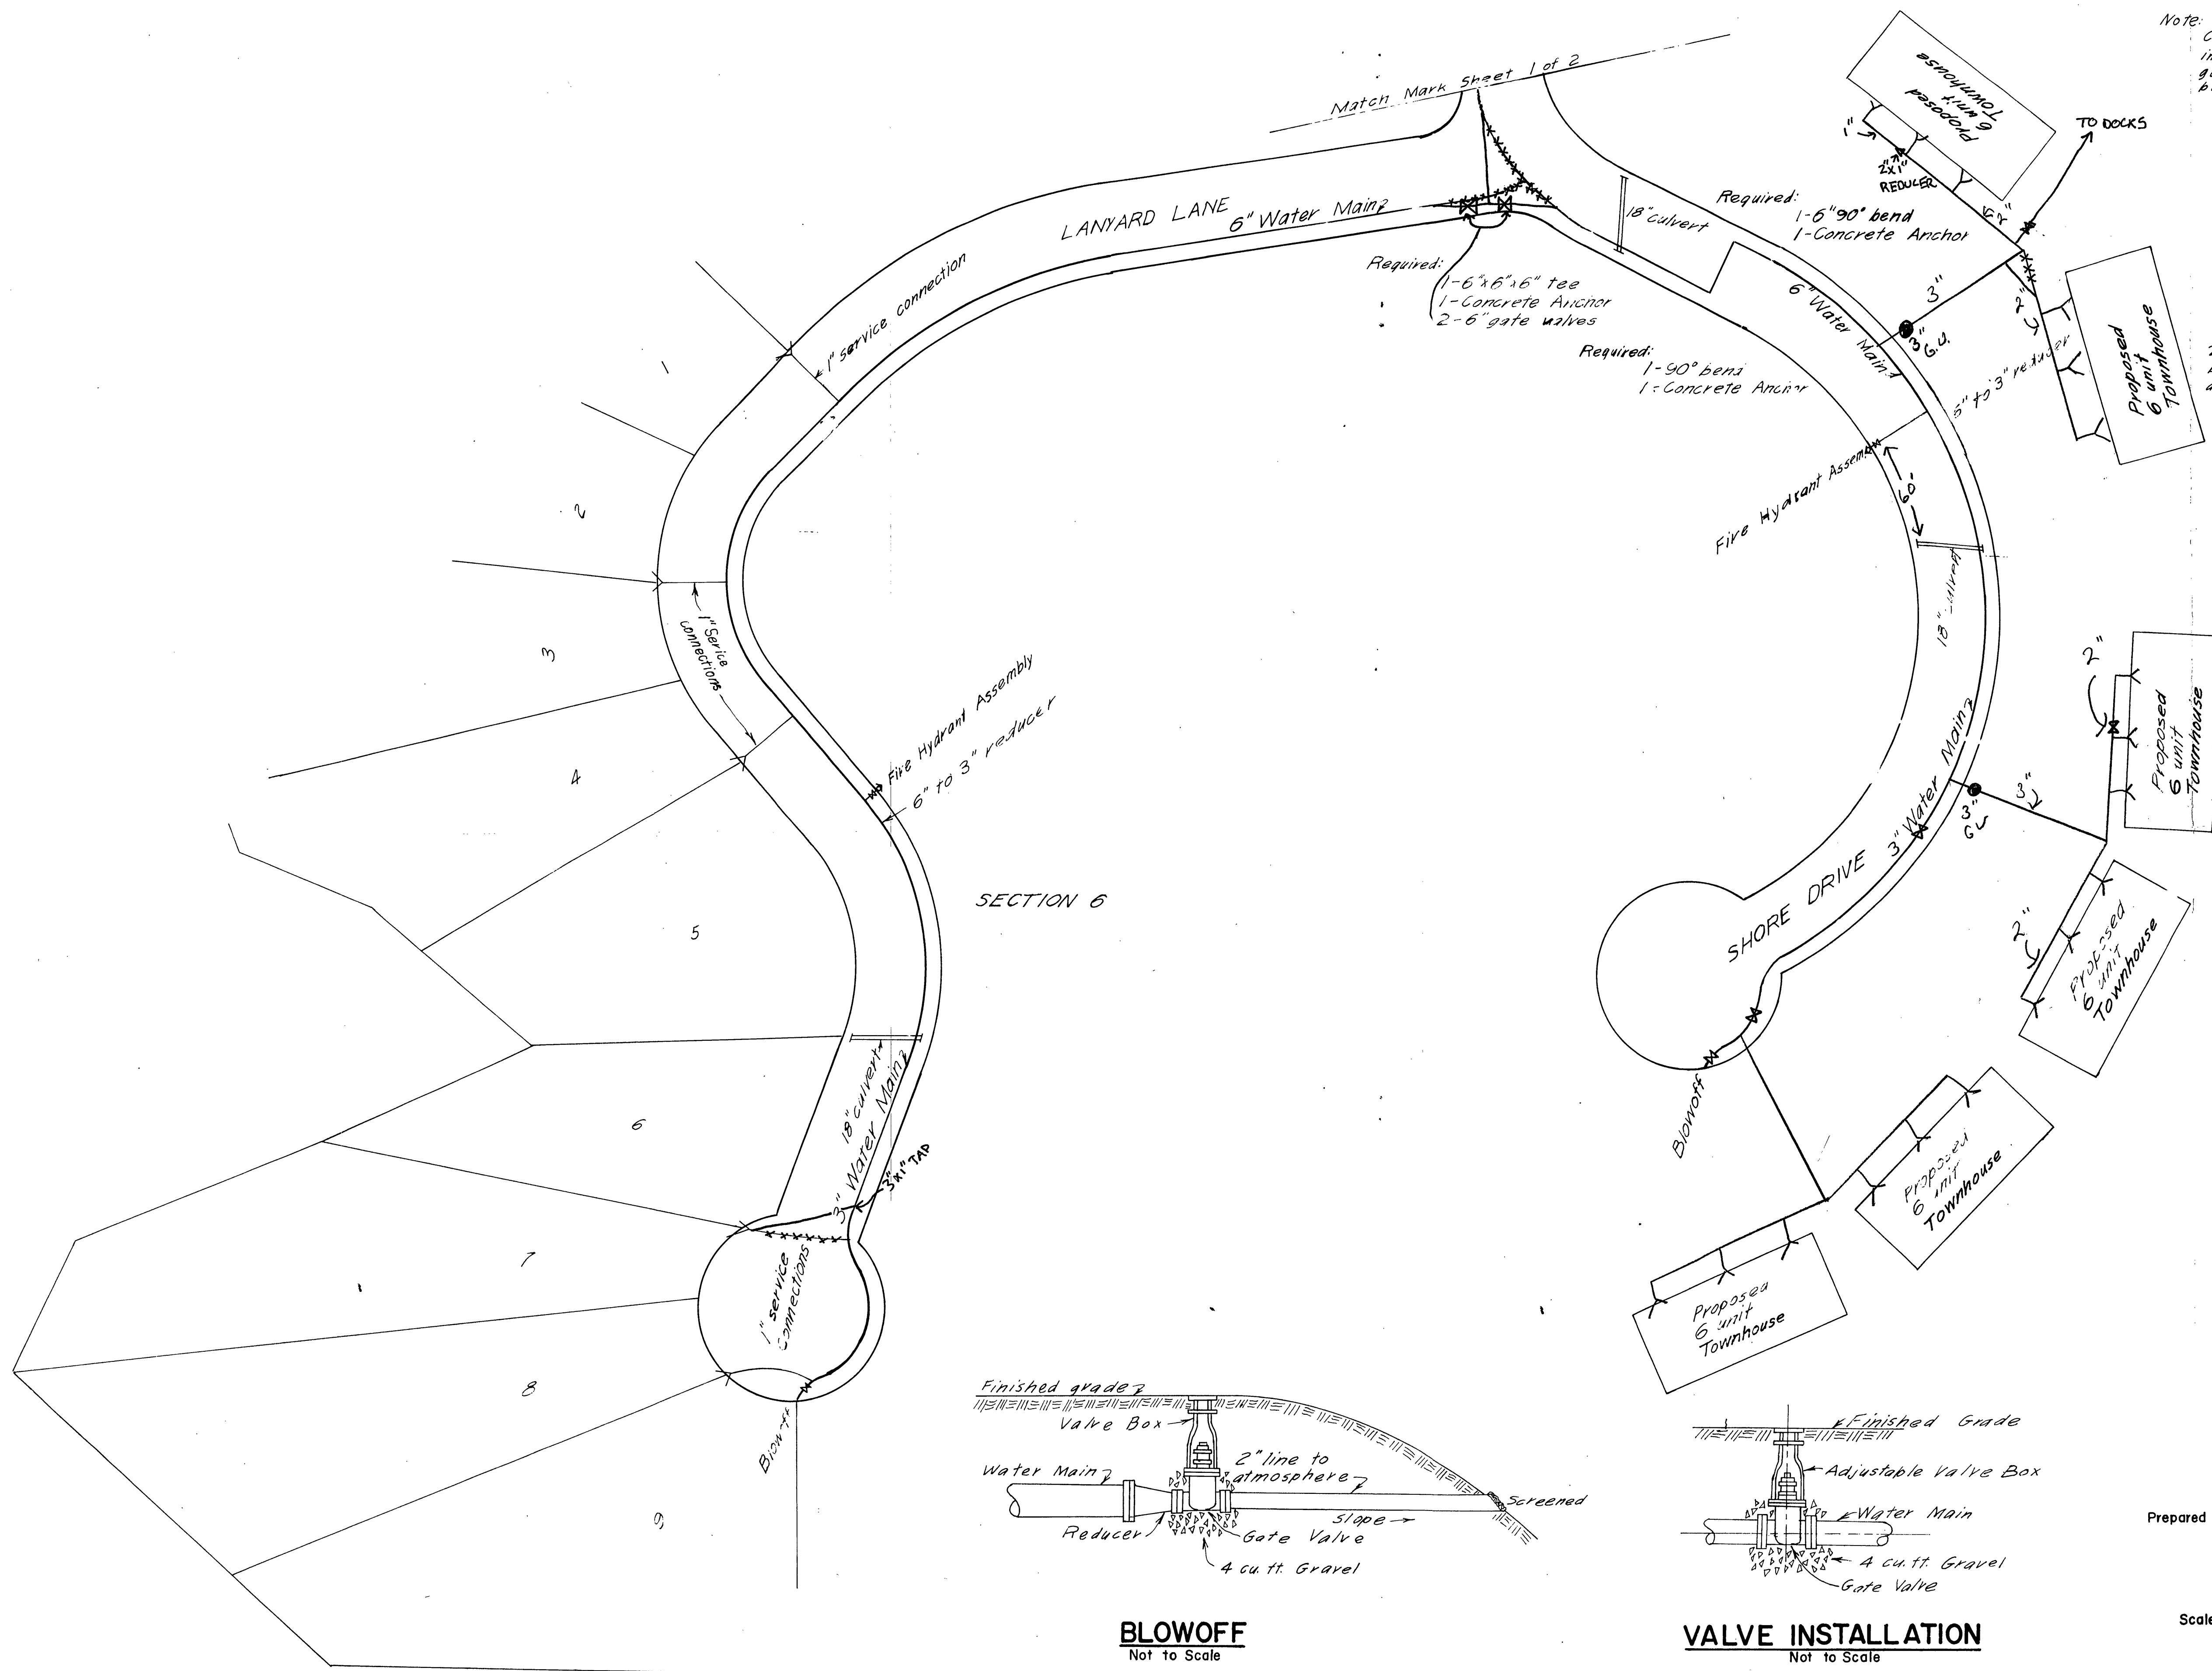

FIRE HYDRANT ASSEMBLY
Not to Scale

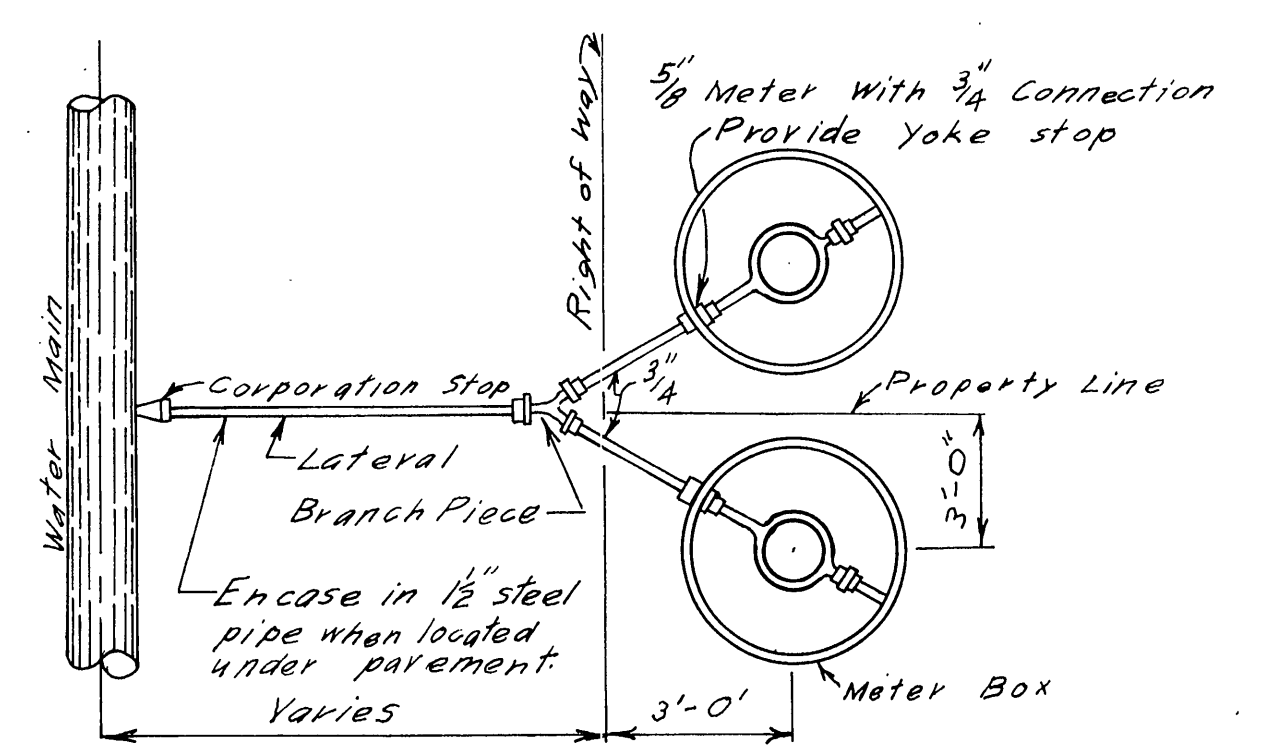


Note: Provide service saddle for all taps greater than 1/2". All taps shall be located so there is a minimum of at least 2' separation from main.

WATER SERVICE CONNECTIONS
Not to Scale


WATER SYSTEM
to serve
WATER FRONT SECTIONS 5 & 6
owned by
BREMBLE PROPERTIES, INC.
GILLS CREEK MAG. DIST.
FRANKLIN COUNTY, VIRGINIA

Prepared by:
William L. Law, Civil Engineer, Va. Cert. No. 1296
Box 420, Route 1, Bassett, Virginia 24055
December 15, 1981

Scale: 1 inch = 50 feet

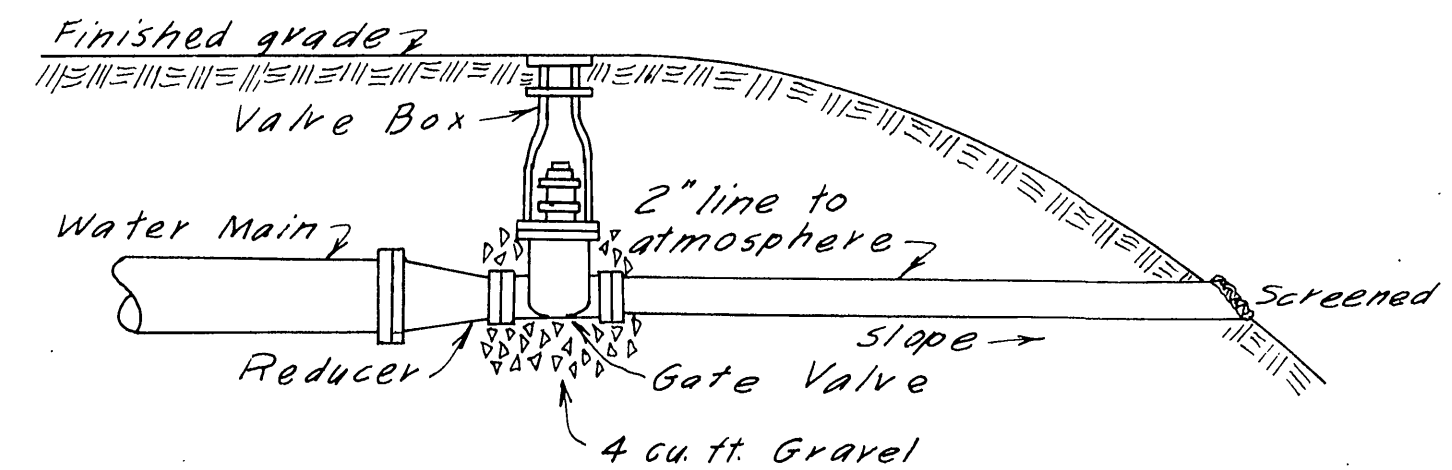

BLOWOFF
Not to Scale

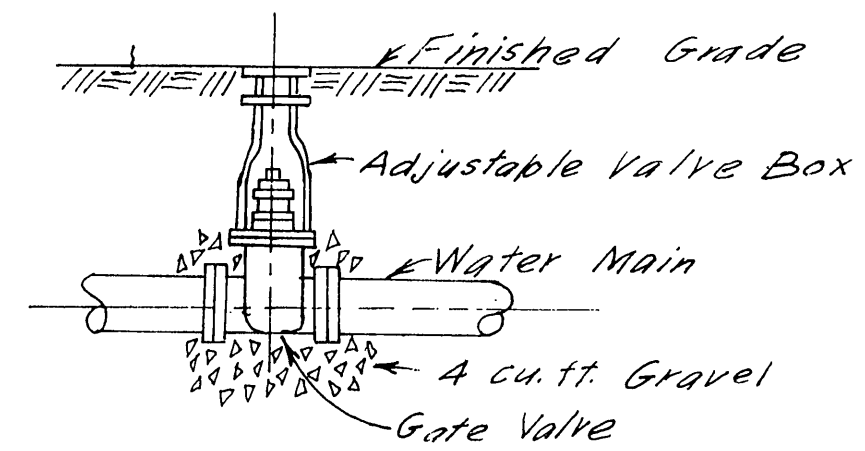

VALVE INSTALLATION
Not to Scale

