

MASTER METER VAULT
SEE DRAWING C02
 No Scale

Western Virginia Water Authority Notes

General Notes:

- i. All construction methods and materials shall conform to the Construction Standards and Specifications of Roanoke County, the Western Virginia Water Authority, and/or the Virginia Department of Transportation.
- ii. The contractor or developer is required to notify the Roanoke County Engineering Division and the Western Virginia Water Authority in writing at least three (3) days prior to any construction, including but not limited to the following.
- iii. A pre-construction conference should be scheduled with the Roanoke County Engineering Division and the Western Virginia Water Authority, to be held at least one (1) day prior to any construction.
- iv. The developer or contractor shall supply the County and the Western Virginia Water Authority with correct As-Built plans before final acceptance.
- v. All work shall be subject to inspection by Roanoke County, the Western Virginia Water Authority, and/or V.D.O.T. inspectors.
- vi. Field corrections shall be approved by the Roanoke County Engineering Division and the Western Virginia Water Authority prior to such construction.

Sewer Notes:


- i. All sanitary sewer connections to existing lines shall be coordinated with and performed by the Western Virginia Water Authority.
- ii. All sanitary sewer facilities are to be installed according to the Western Virginia Water Authority Design and Construction Standards.

Water Notes:


- i. All water connections to existing lines shall be coordinated with and performed by the Western Virginia Water Authority.
- ii. All water facilities are to be installed according to the Western Virginia Water Authority Design and Construction Standards.

WATER LINE "B" PROFILE

SCALE: HORZ. 1" = 50' VERT. 1" = 10'

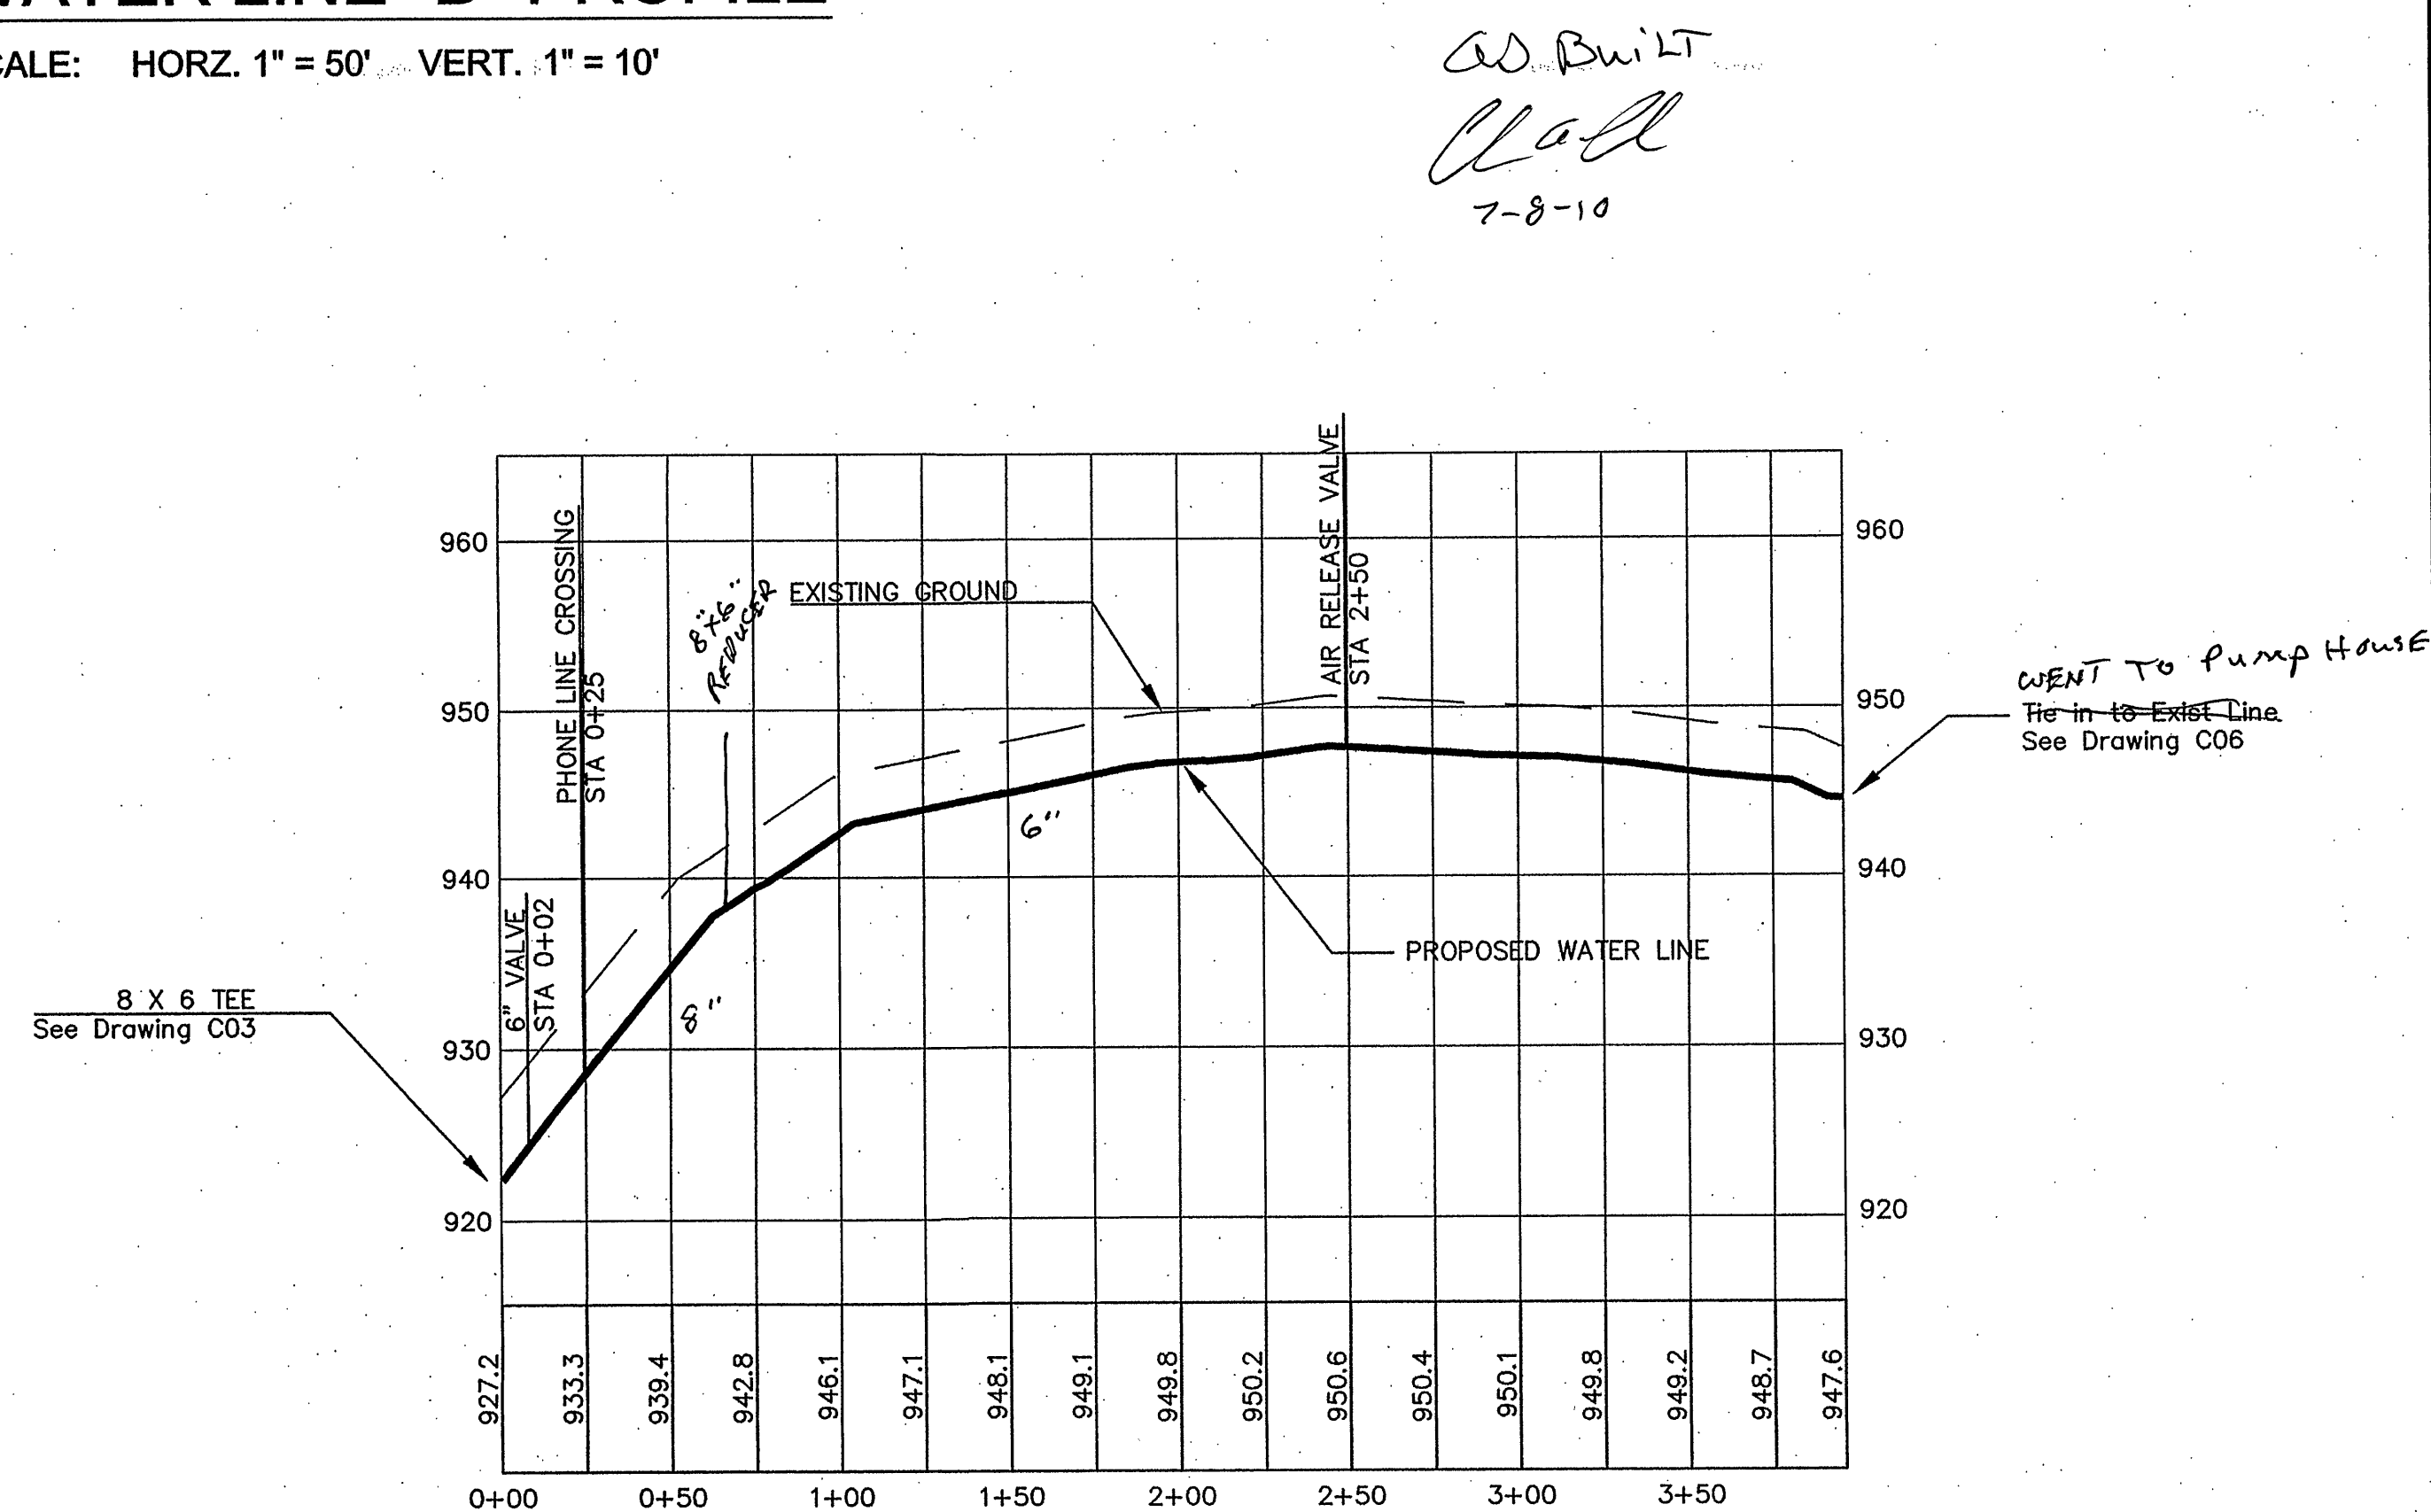

WATER LINE IS 6" DIP, CLASS 50
 WATER LINE TO BE BURIED A MINIMUM OF 36" TO TOP OF PIPE

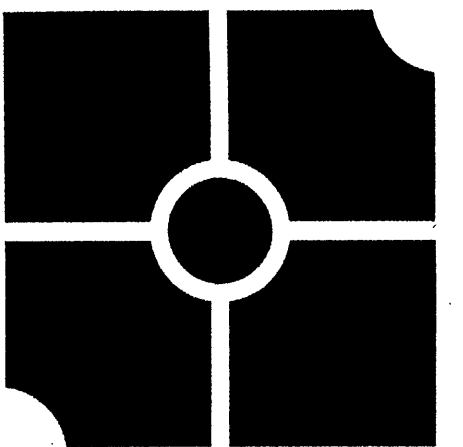

parker
 DESIGN GROUP

ENGINEERS • SURVEYORS • PLANNERS • LANDSCAPE ARCHITECTS
 816 Boulevard
 Salem, Virginia 24153
 Phone: 540-387-1153
 Fax: 540-389-5767
 www.parkerdg.com

These documents are the property of Parker Design Group (PDG) and may not be reproduced or used without the express permission of PDG. Any reuse of these documents without authorization of PDG will be at the sole risk of the individual or entity utilizing said documents.



Westlake Water Company
Water System Modifications
 Franklin County, Virginia

REVISIONS:

DESIGNED BY: GST

DRAWN BY: GST

CHECKED BY: GST

SCALE: As Noted

DATE: March 30, 2010

SHEET TITLE:

Water Line
 Details

C04

04 OF 07

PROJECT NUMBER:

09-0154-01