


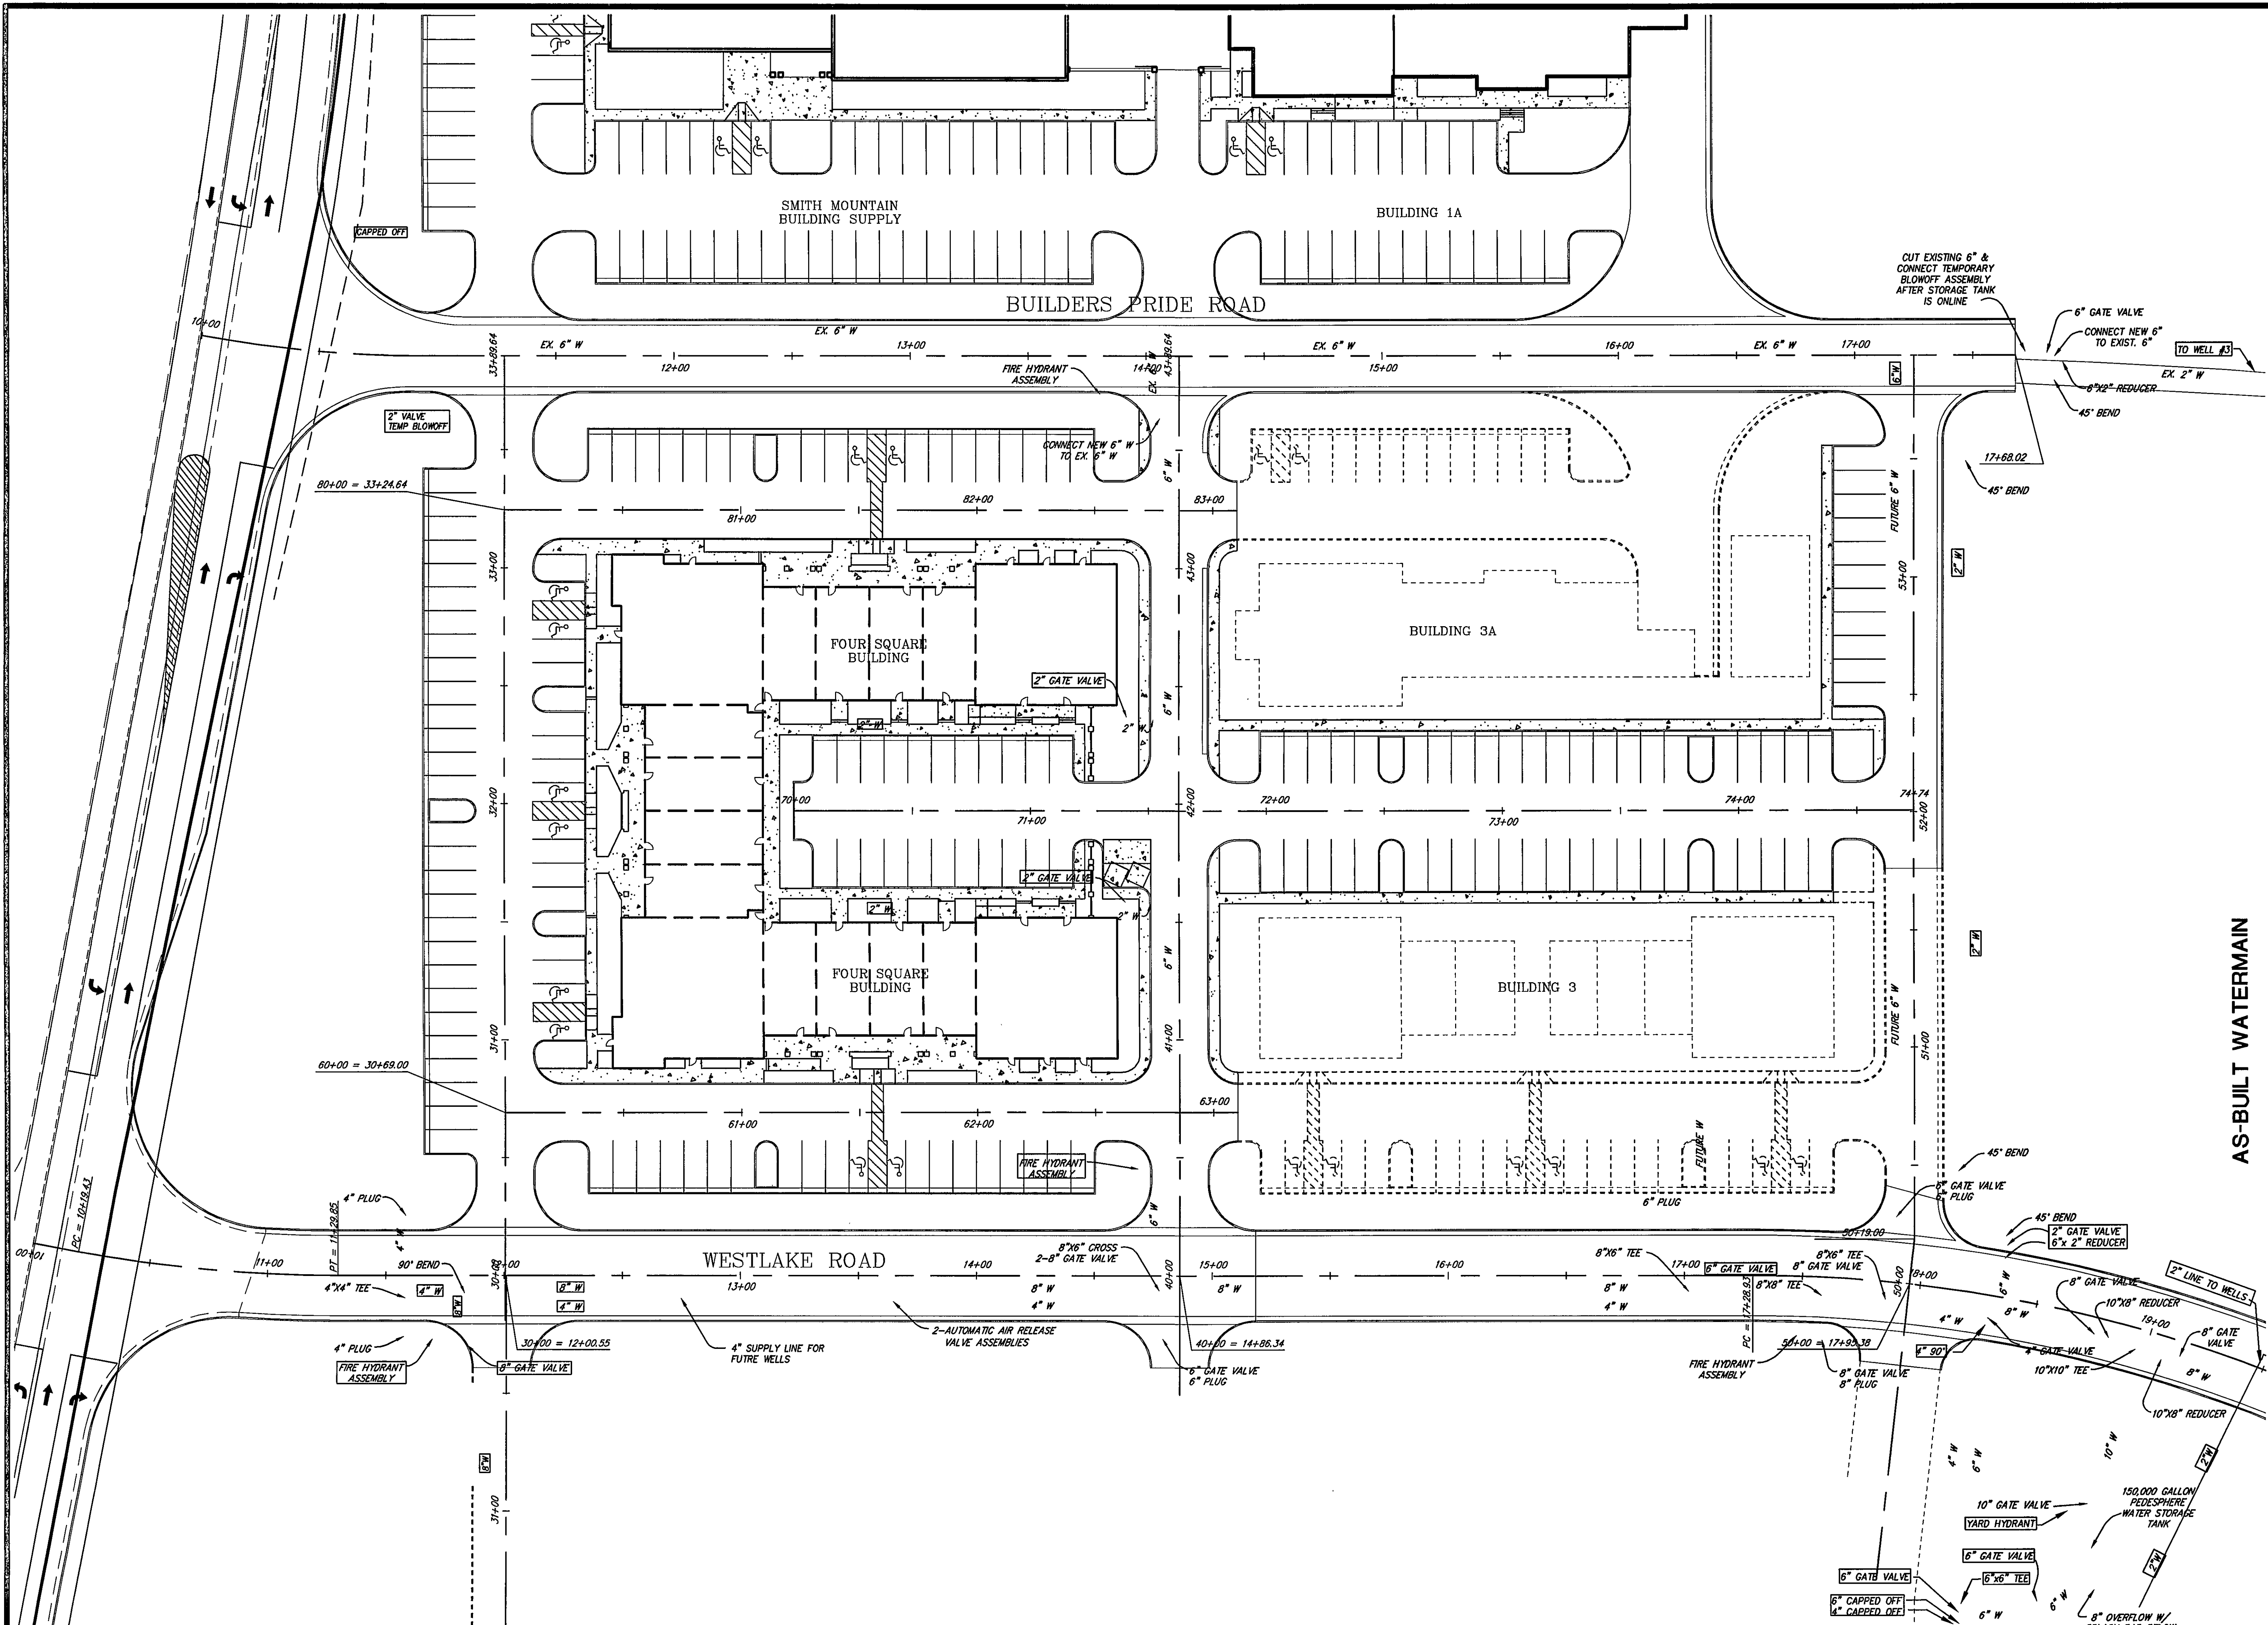

AS-BUILT WATERMAIN

LUMSDEN ASSOCIATES, P.C.
ENGINEERS-SURVEYORS-PLANNERS
ROANOKE, VIRGINIA

LA

COMMONWEALTH OF VIRGINIA
MICHAEL S. WEBB
No. 012556
PROFESSIONAL ENGINEER

PLAN

PHASE 2 WATER LINE PLANS FOR
"WESTLAKE TOWNE CENTER"
PREPARED FOR
WILLARD CONSTRUCTION OF
SMITH MOUNTAIN LAKE, LLC
GILLS CREEK MAGISTERIAL DISTRICT
FRANKLIN COUNTY, VIRGINIA

NO.	DATE	DESCRIPTION
1	02/15/06	AS-BUILT WATER MAINS
2		
3		
4		
5		

DATE: JANUARY 10, 2002
SCALE: 1" = 30'
COMMISSION NO.: 00-050
CARD FILE: WENGWATERNEWPHASE2CD-WPHW2
SHEET 3 OF 9