


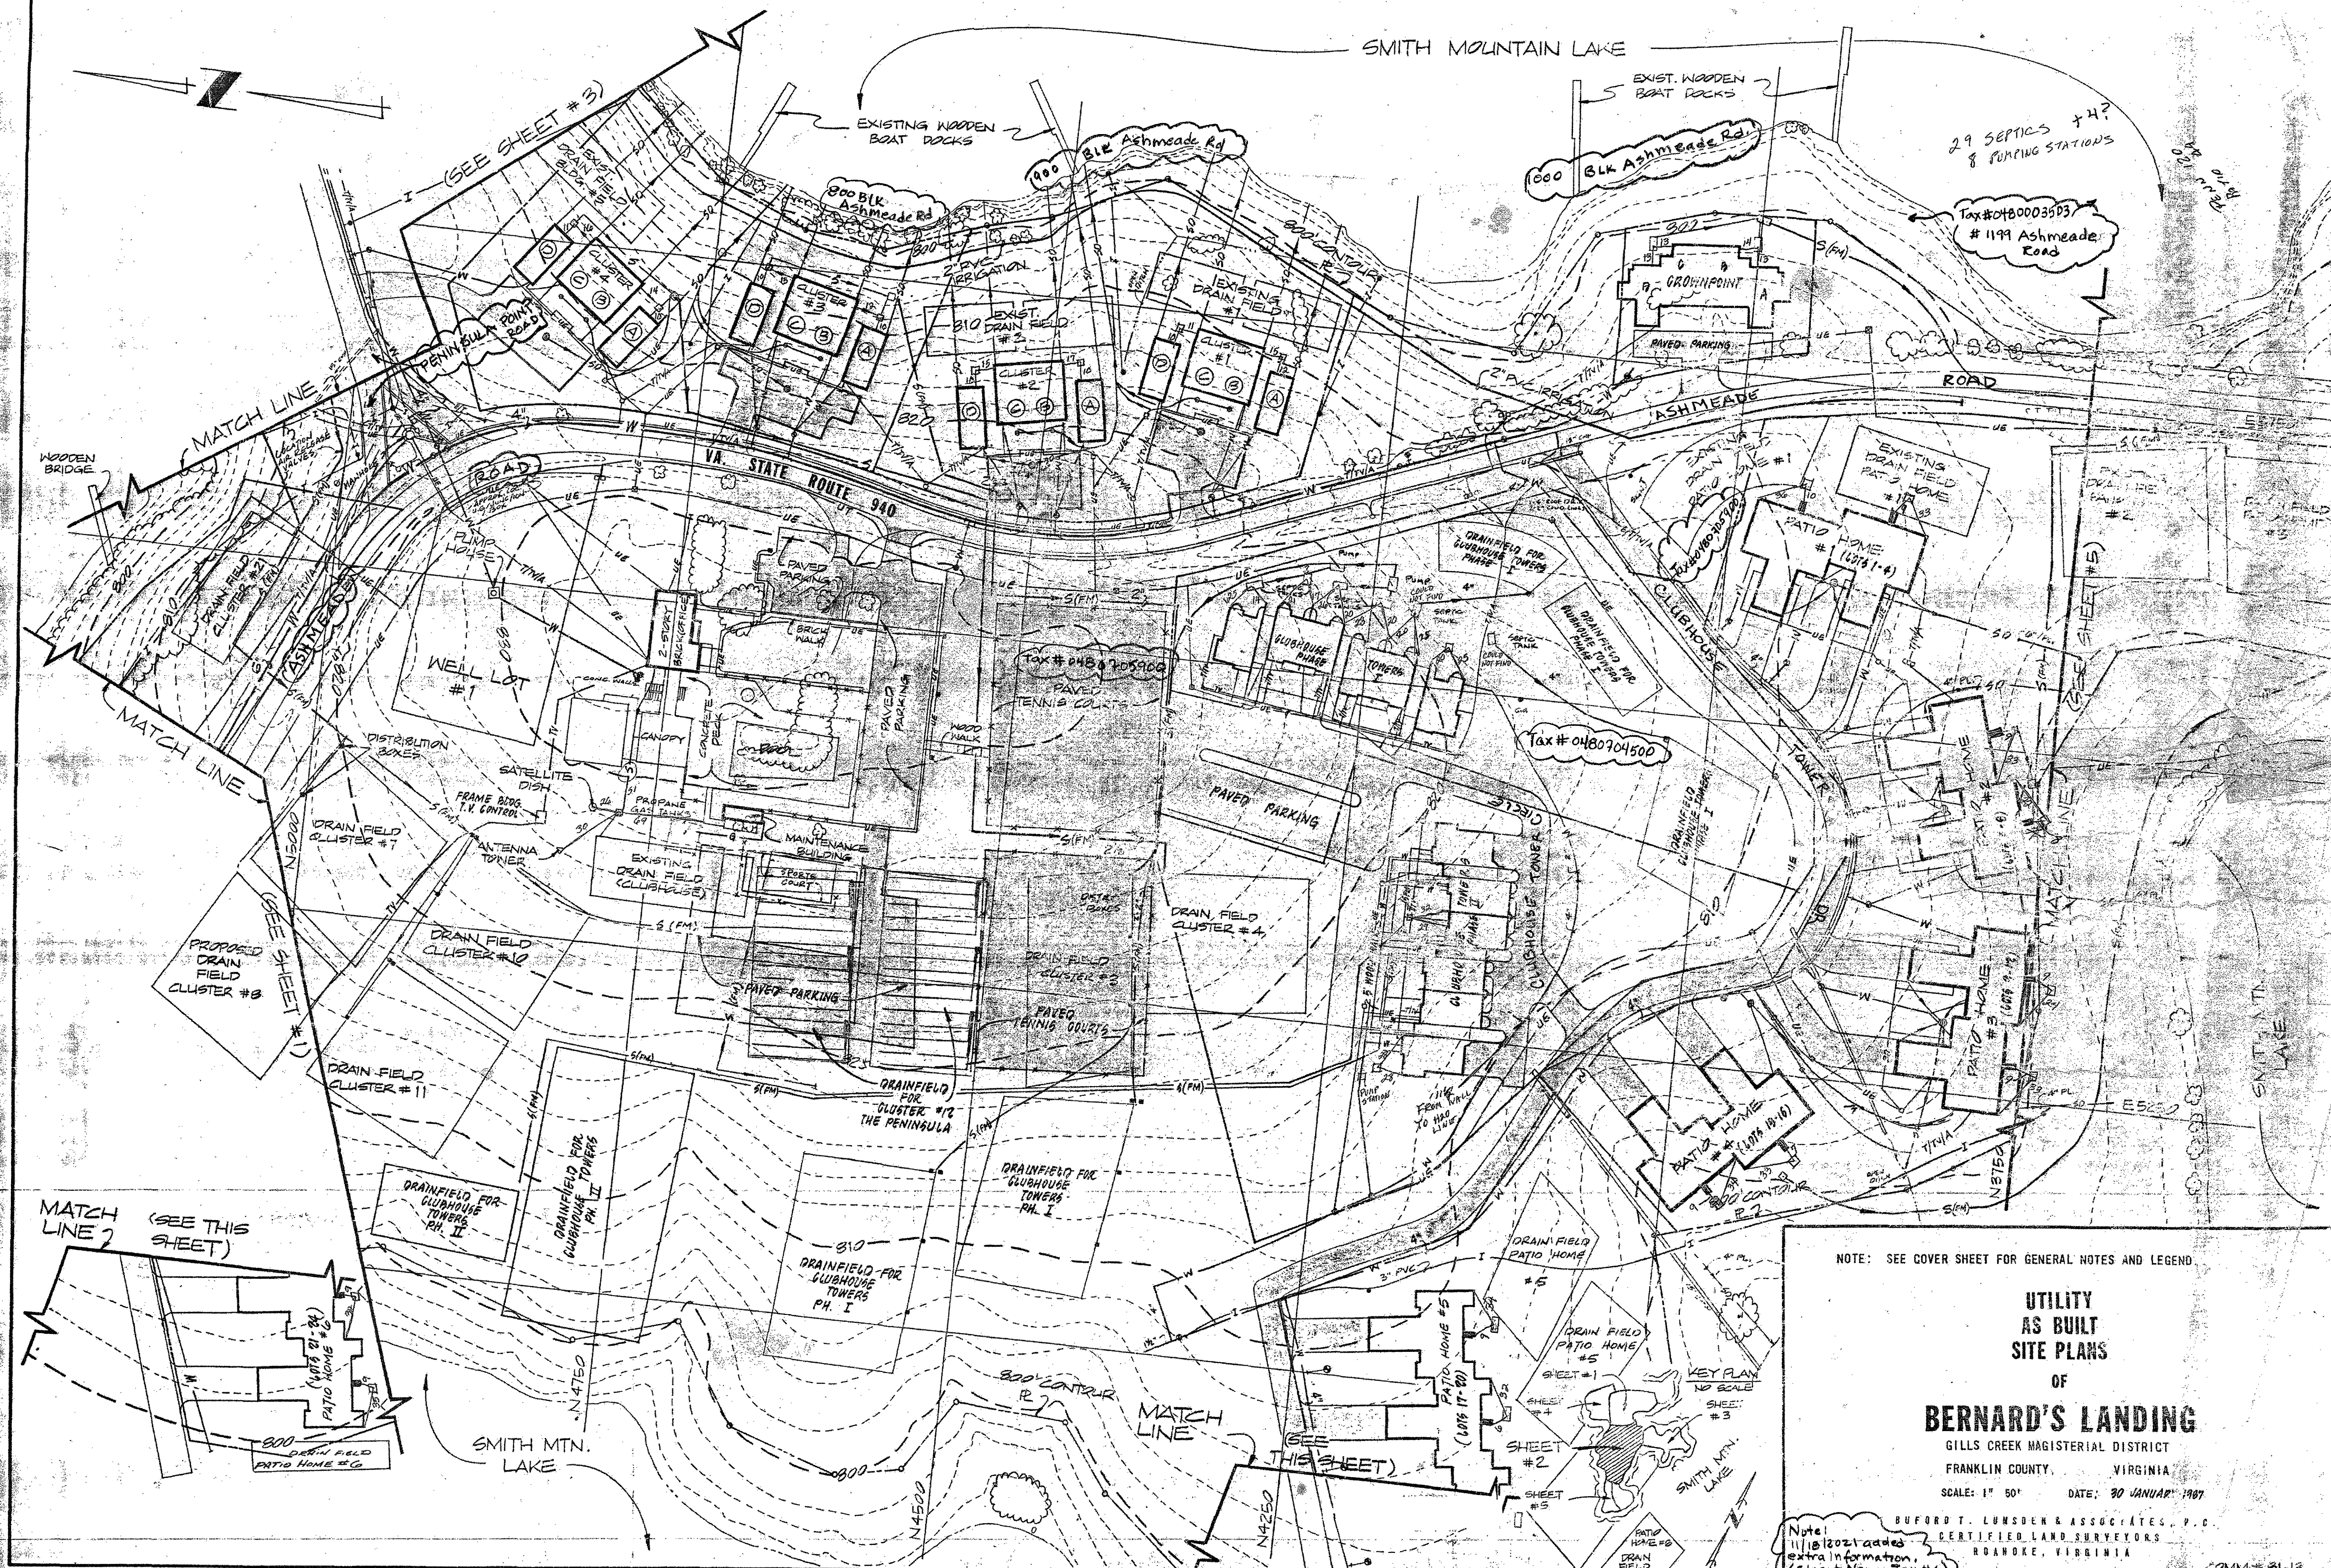

NOTE: SEE COVER SHEET FOR GENERAL NOTES AND LEGEND.

UTILITY
AS BUILT
SITE PLANS
OF

BERNARD'S LANDING

GILLS CREEK MAGISTERIAL DISTRICT
FRANKLIN COUNTY, VIRGINIA

SCALE: 1" = 50' DATE: 30 JANUARY 1987

BURFORD T. LUNSDEN & ASSOCIATES, P.C.
CERTIFIED LAND SURVEYORS
ROANOKE, VIRGINIA

Note:
11/18/2021 added
extra information
(street names, tax #s)

COMM# 31-13