


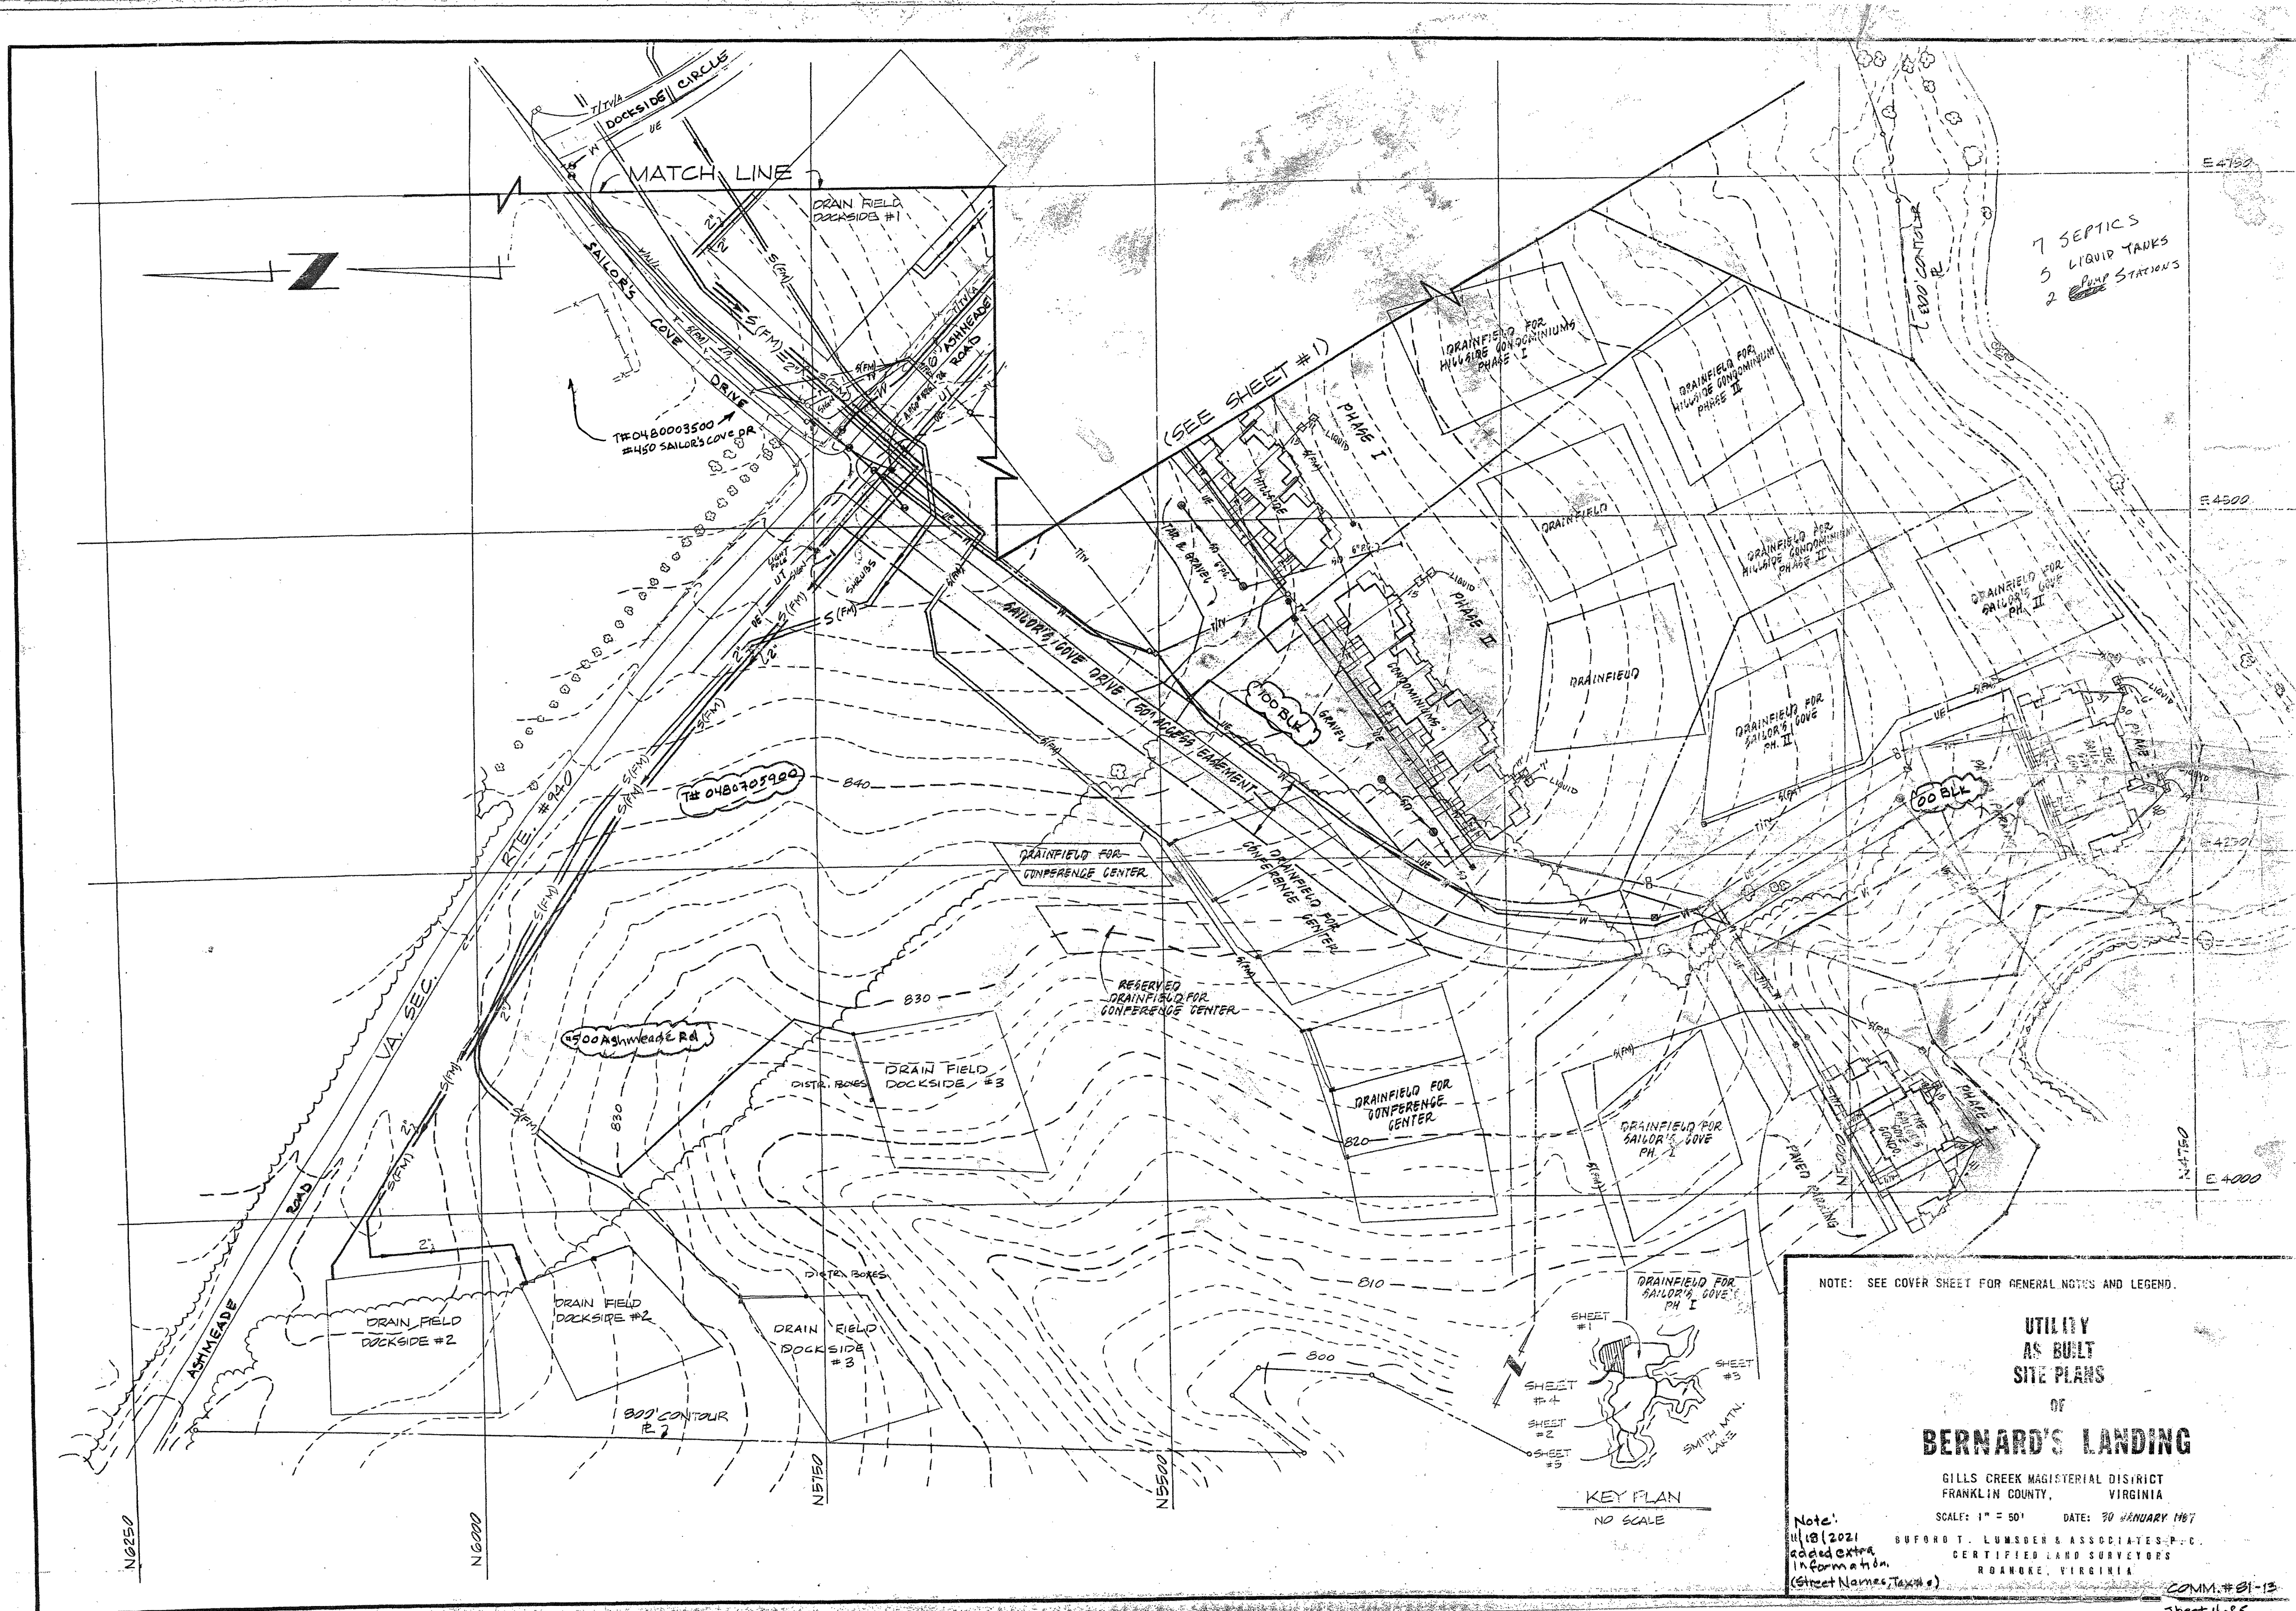

NOTE: SEE COVER SHEET FOR GENERAL NOTES AND LEGEND.

UTILITY
AS BUILT
SITE PLANS
OF
BERNARD'S LANDING

GILLS CREEK MAGISTERIAL DISTRICT
FRANKLIN COUNTY, VIRGINIA

SCALE: 1" = 50' DATE: 30 JANUARY 1987

Noted:
11/18/2021 added extra
information.
(Street Names, etc.)

ROBERT T. LUMBER & ASSOCIATES, P.C.
CERTIFIED LAND SURVEYORS
ROANOKE, VIRGINIA

COMM. # 81-13

Sheet 4 of 5