

PARKING SUMMARY

PARKING REQUIRED: 1 SPACE PER FOUR SEATS IN PROPOSED SANCTUARY
 PROPOSED SEATING: 742
 SPACES REQUIRED: 186
 SPACES PROVIDED: 267


ADA PARKING REQUIREMENTS: 301 TO 400 SPACES : 9 HANDICAP SPACES REQUIRED
 HANDICAP PROVIDED: 9

NOTIFY UTILITY COMPANIES BEFORE YOU DIG



THE LOCATIONS OF UNDERGROUND UTILITIES AS SHOWN HEREON ARE BASED ON ABOVE-GROUND STRUCTURES. LOCATIONS OF UNDERGROUND UTILITIES/STRUCTURES MAY VARY FROM LOCATIONS SHOWN HEREON. ADDITIONAL BURIED UTILITIES/STRUCTURES MAY BE ENCOUNTERED. NO EXCAVATIONS WERE MADE DURING THE PROGRESS OF THIS SURVEY TO LOCATE BURIED UTILITIES/STRUCTURES.

IT SHALL BE THE RESPONSIBILITY OF THE CONTRACTOR TO VERIFY ACTUAL LOCATION AND DEPTH OF ALL EXISTING UTILITIES. THE OWNER AND THE SURVEYOR SHALL NOT BE RESPONSIBLE FOR ANY OMISSION OR VARIATION FROM THE LOCATION SHOWN. THE CONTRACTOR SHALL NOTIFY MISS UTILITY AT 611 TWO (2) WORKING DAYS PRIOR TO THE START OF CONSTRUCTION.

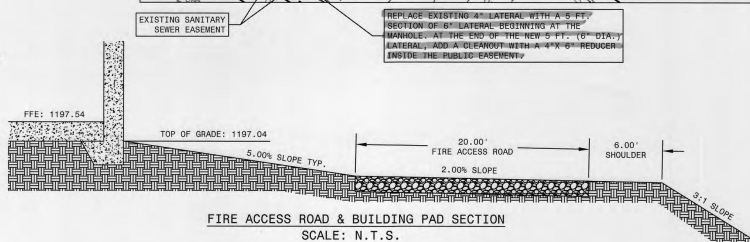

FIRE ACCESS ROAD & BUILDING PAD SECTION
 SCALE: N.T.S.

IF THIS DRAWING IS A REDUCTION
 GRAPHIC SCALE MUST BE USED
 SCALE: 1" = 50'
 50' 0 50'

Legend

- 1- Plastic 6" pipe (vertical) with 6" Cleanout cap to provide access to the 2" corp. stop on the existing service line
- 2- 12" x 6" reducer
- 3- 6" S
- 4- 6" g.v.
- 5- Fire Vault
- 6- Ex. domestic water
- 7- Ex. PRV
- 8- Ex. Private Valve Box

Water Not To Scale
 Pipe: 6" U.S. Pipe DIP, CL350
 Valve: 6" AFC

Sewer
 Pipe: 6" NAPCO SDR-26 PVC

DESIGN BY: TCH	PROJECT: FAITH FELLOWSHIP - NEW SANCTUARY	DATE: 1/13/2020
DRAWN BY: DBF	TITLE: SITE LAYOUT AND DIMENSIONAL PLAN	DRAWING NUMBER: C2
REVIEWED BY: TCH	DRAWING NAME:	SHEET NUMBER: 5
PROJECT NUMBER: 15-048	SCALE: 1"=50'	

No:	Revisions:	Date:
1	REVISED PER FRANKLIN COUNTY COMMENTS DATED 3-4-20	03/26/20
2	REVISED PUBLIC SECTION OF SEWER LATERAL TO 6" PER VWWA	04/10/20



ADDRESS:
 235 CLAIBORNE AVE.
 ROCKY MOUNT, VA 24151

PHONE NUMBERS:
 PHONE: (540) 483-5975

WEBSITE
 WWW.EARTHENV.COM

