

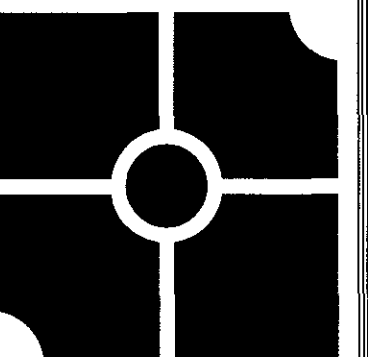
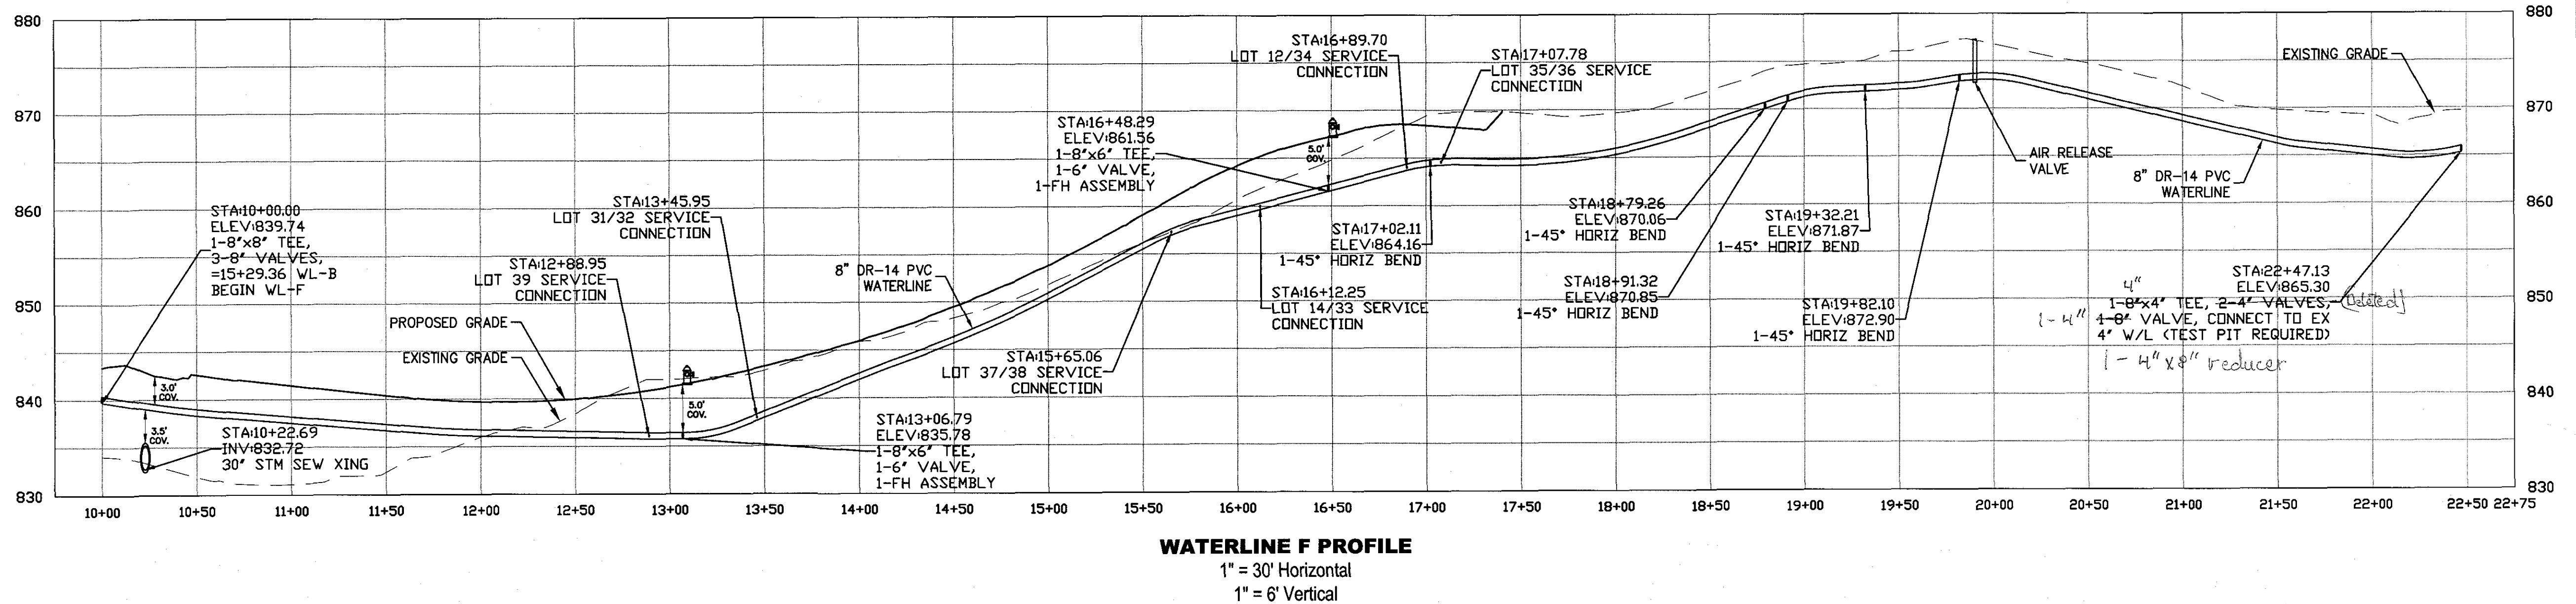
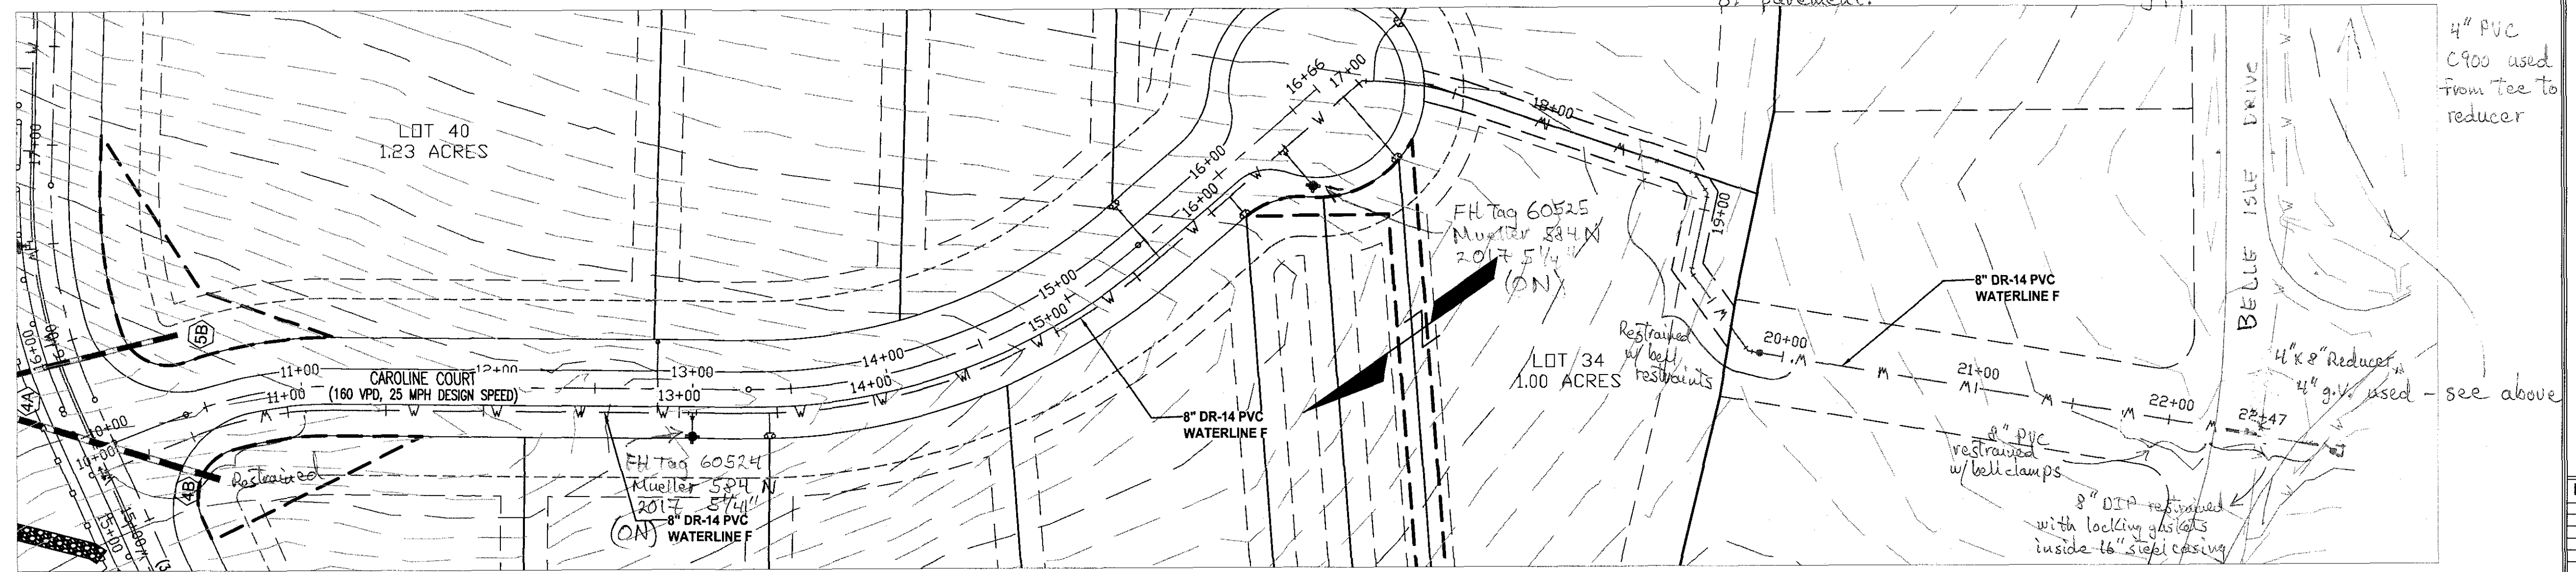
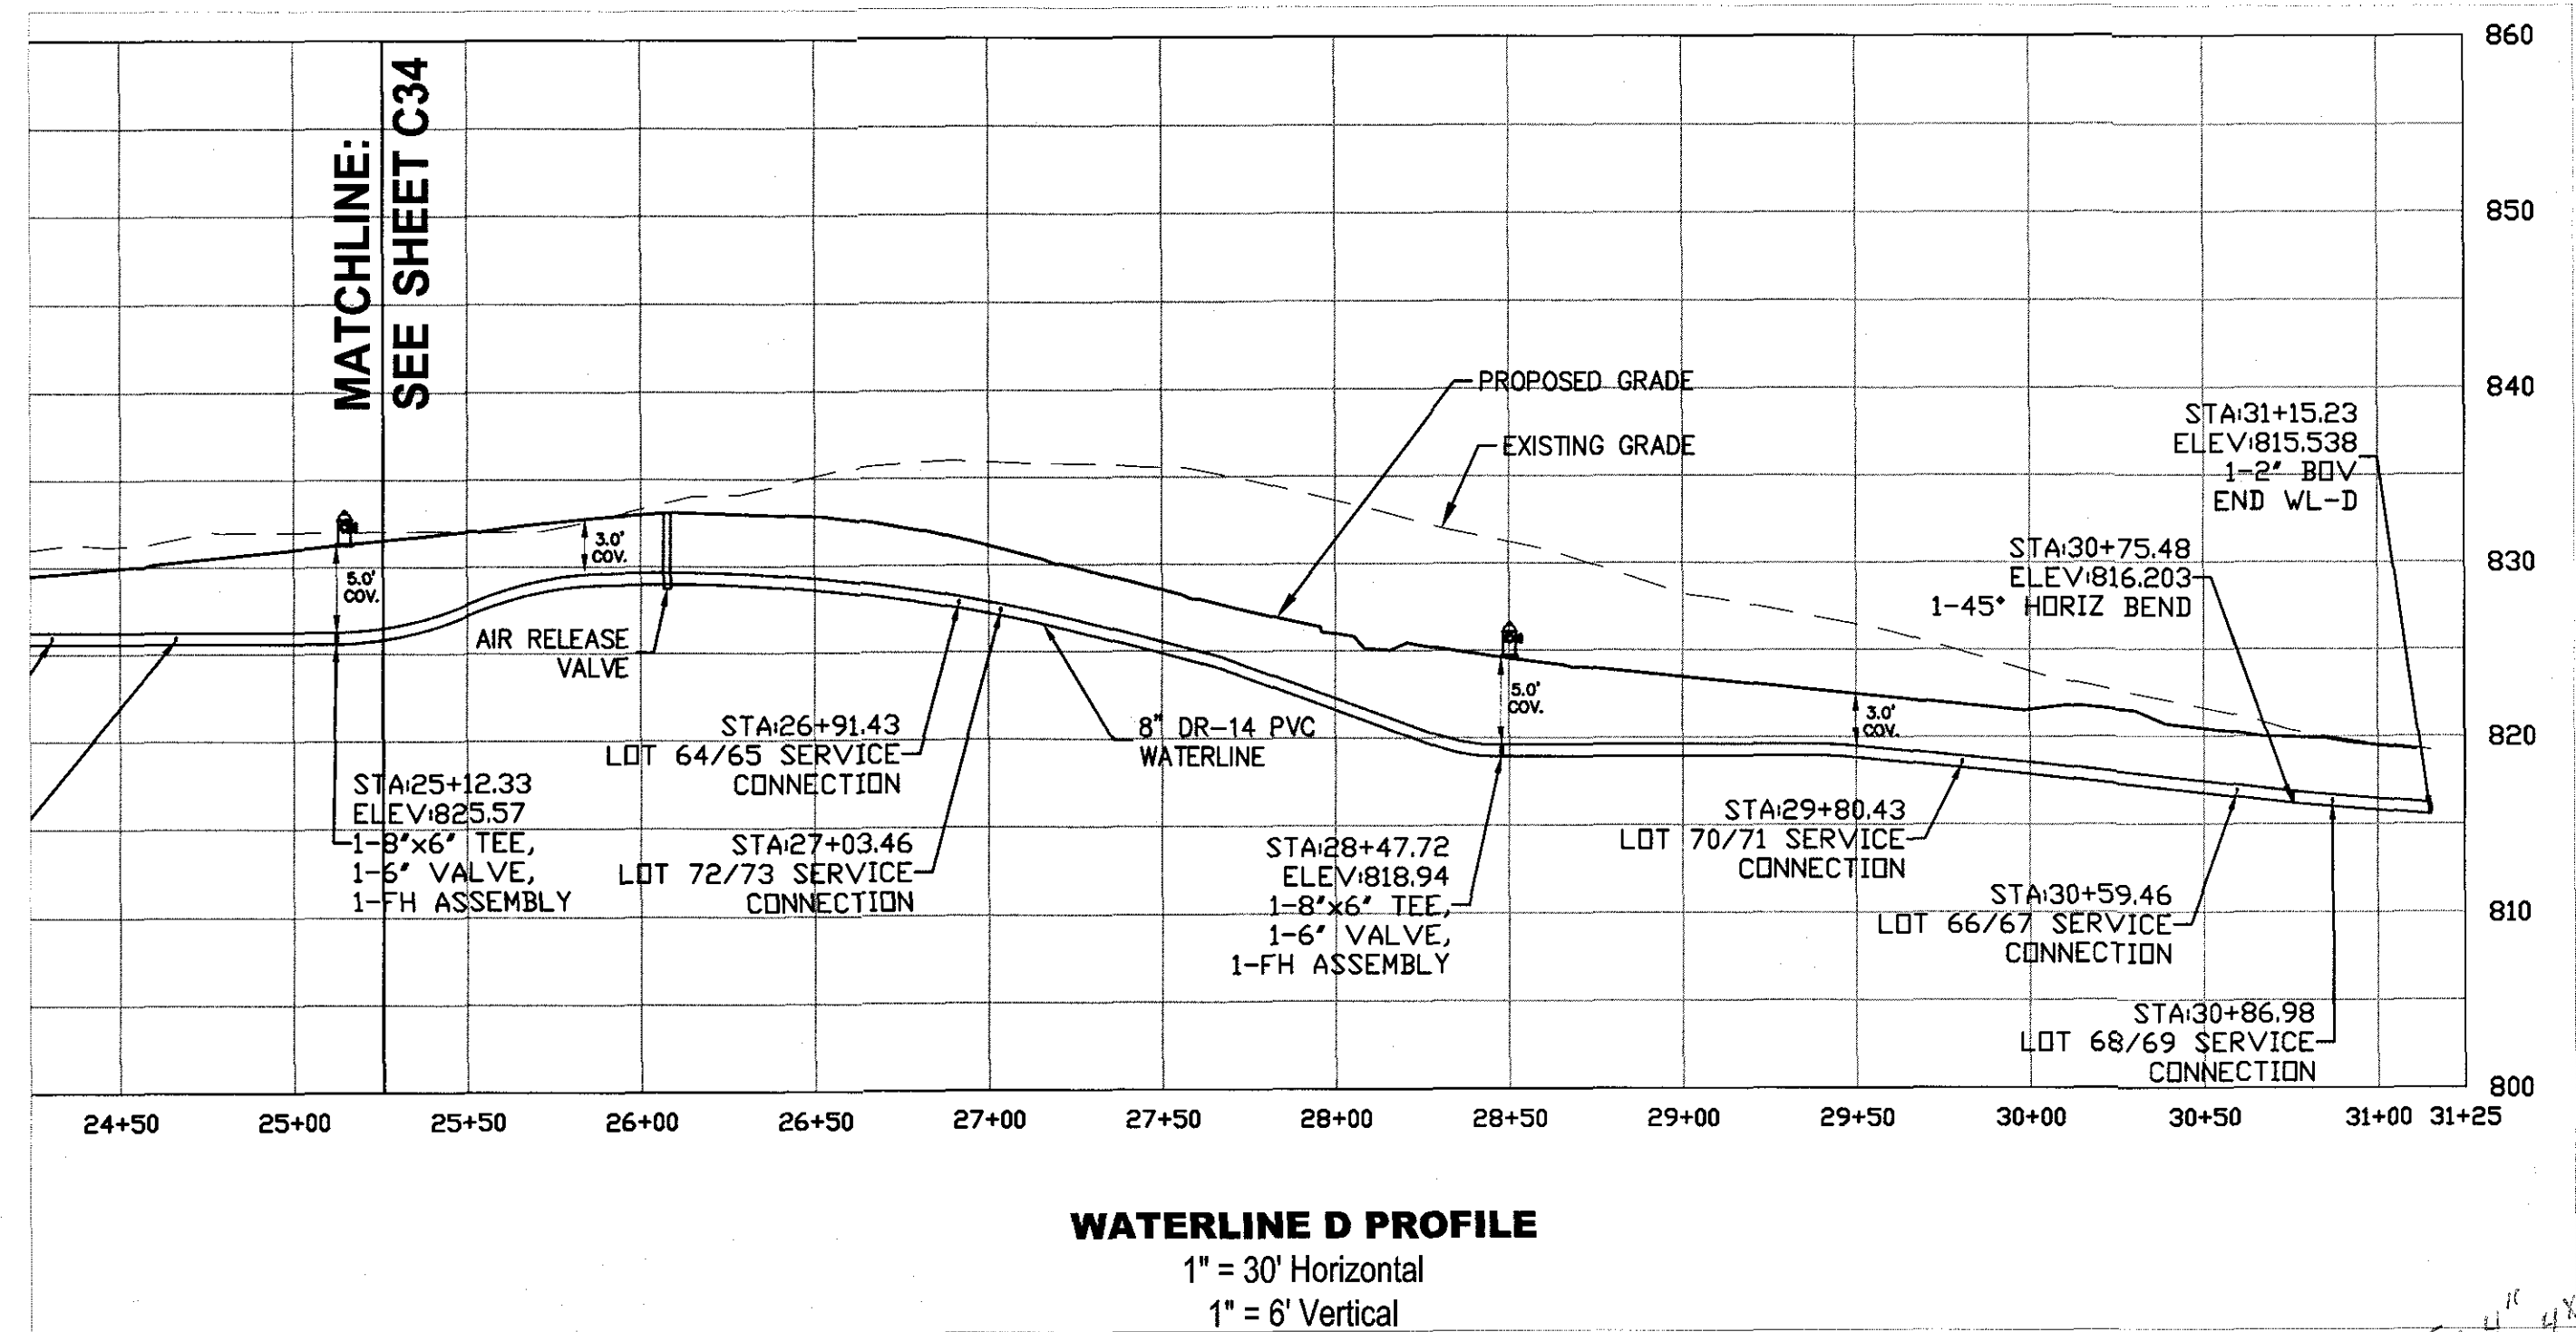


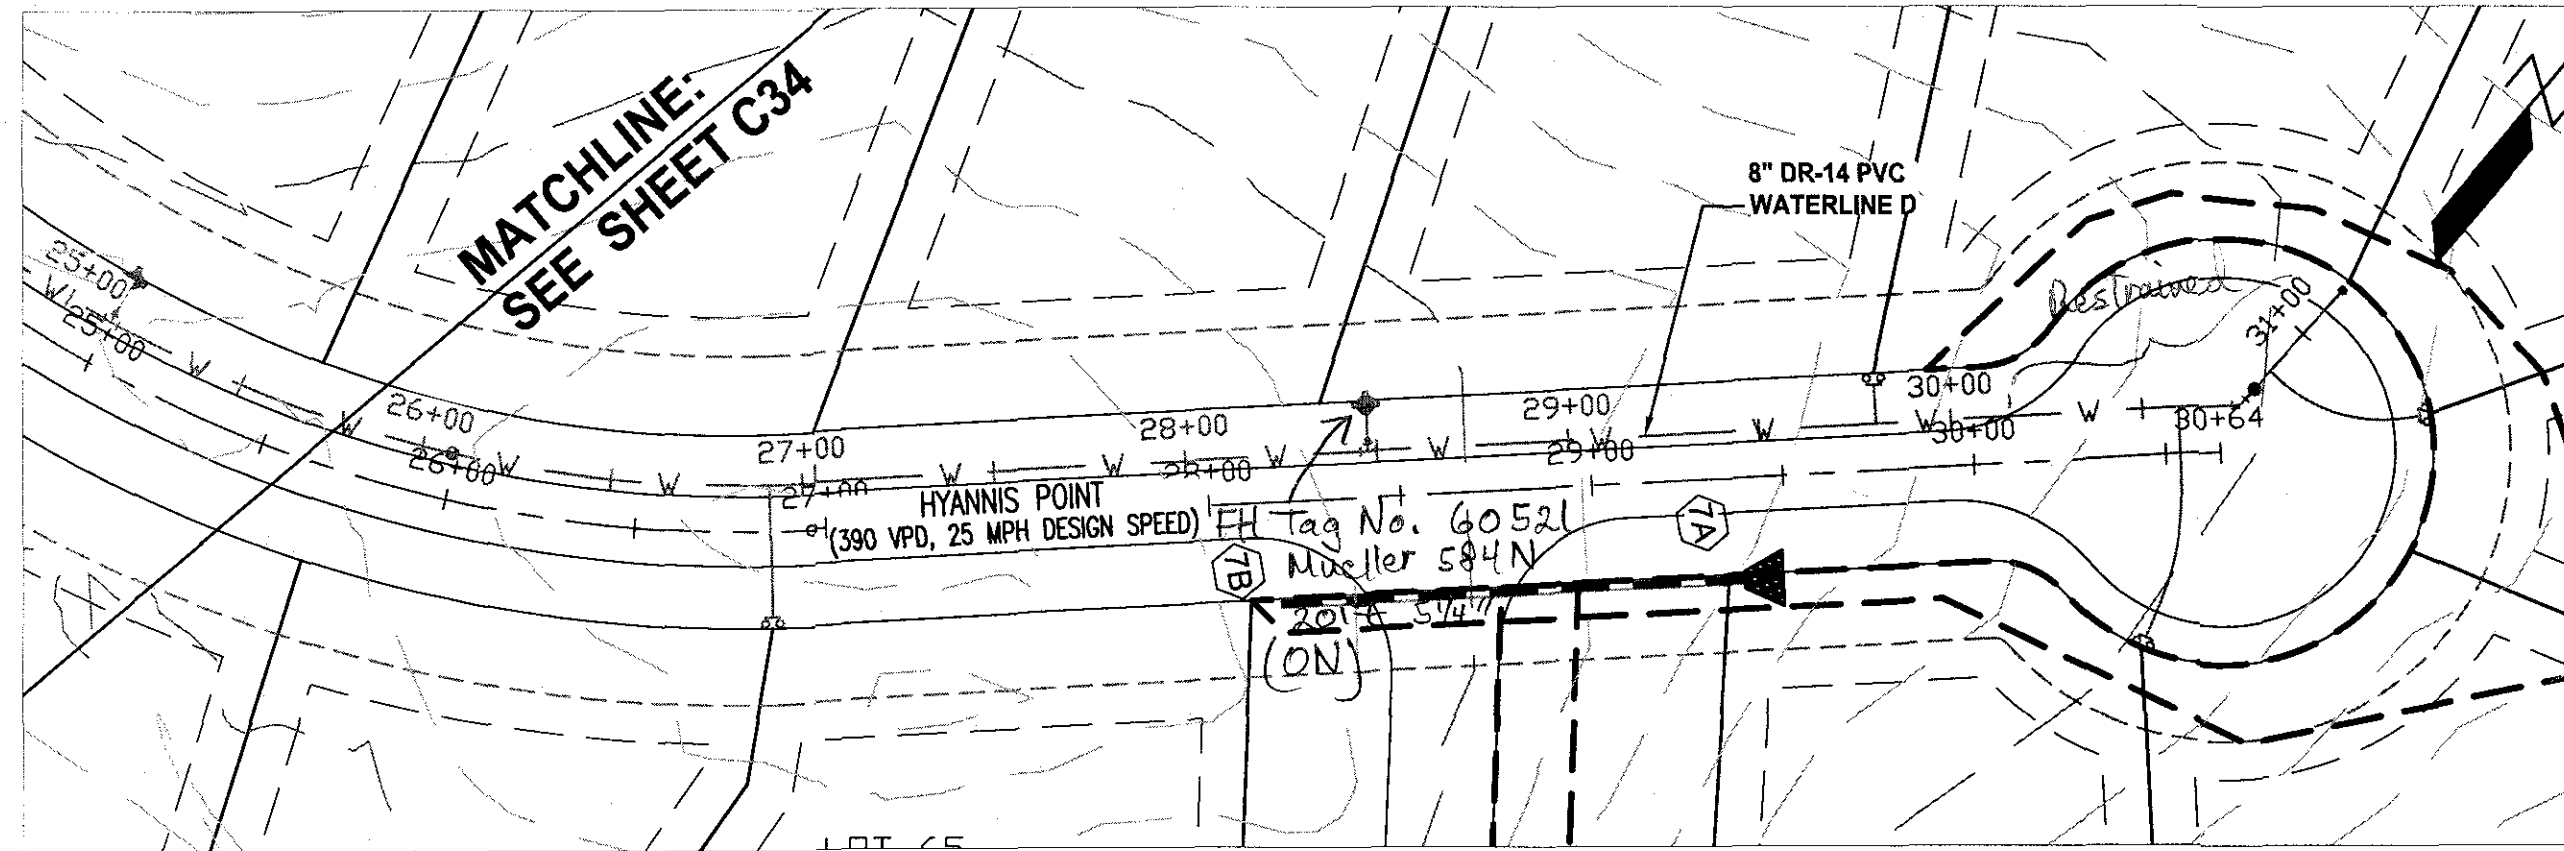

parker
 DESIGN GROUP
 2122 Carolina Ave, SW
 Roanoke, VA 24014
 Ph: 540-387-1153
 Fax: 540-389-5767
 1915-B W. Cary Street
 Richmond, VA 23220
 Phone: 804-358-2947
 Fax: 804-359-9645
 www.parkerdg.com

These documents are the property of Parker Design Group (PDG) and may not be reproduced or used without the express permission of PDG. Any reuse of these documents without authorization of PDG will be at the sole risk of the individual or entity utilizing said documents.

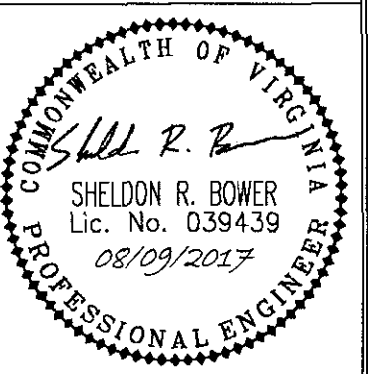

KENNEDY SHORES
SUBDIVISION DEVELOPMENT PLAN
 Tax # 0510001500
 Franklin County, Virginia

REVISIONS:
2/10/2017 - 1ST SUB COMMENTS
3/21/2017 - 2ND SUB COMMENTS
4/14/2017 - 3RD SUB COMMENTS
6/22/2017 - FIELD REVISION #1
7/6/2017 - FIELD REVISION #2
8/4/2017 - FIELD REVISION #3
8/22/2017 - FIELD REVISION #4

DESIGNED BY: JMM/SRB
 DRAWN BY: JMM/JLK
 CHECKED BY: SRB

DATE:
 6 JANUARY, 2017

SHEET TITLE:
 WATERLINE
 PLAN AND
 PROFILES

SCALE:
 H:1"=50' V:1"=10'

SHEET NO.

C35