


"AS-BUILT"

LAKESTONE CONDOMINIUMS

UNION HALL DIST. - FRANKLIN COUNTY
VIRGINIA

NOTES:

1. NO BENDS IN THE SEPTIC LINES ARE IN EXCESS OF 45°. DRAWINGS ARE SCHEMATIC.
2. NO GRAVITY OR PRESSURE CONVEYANCE LINES CROSS DRAIN FIELDS. DRAWINGS ARE SCHEMATIC.
3. PUMP STATION NO. 2 IS IN EXCESS OF 50' FROM SHORE LINE.

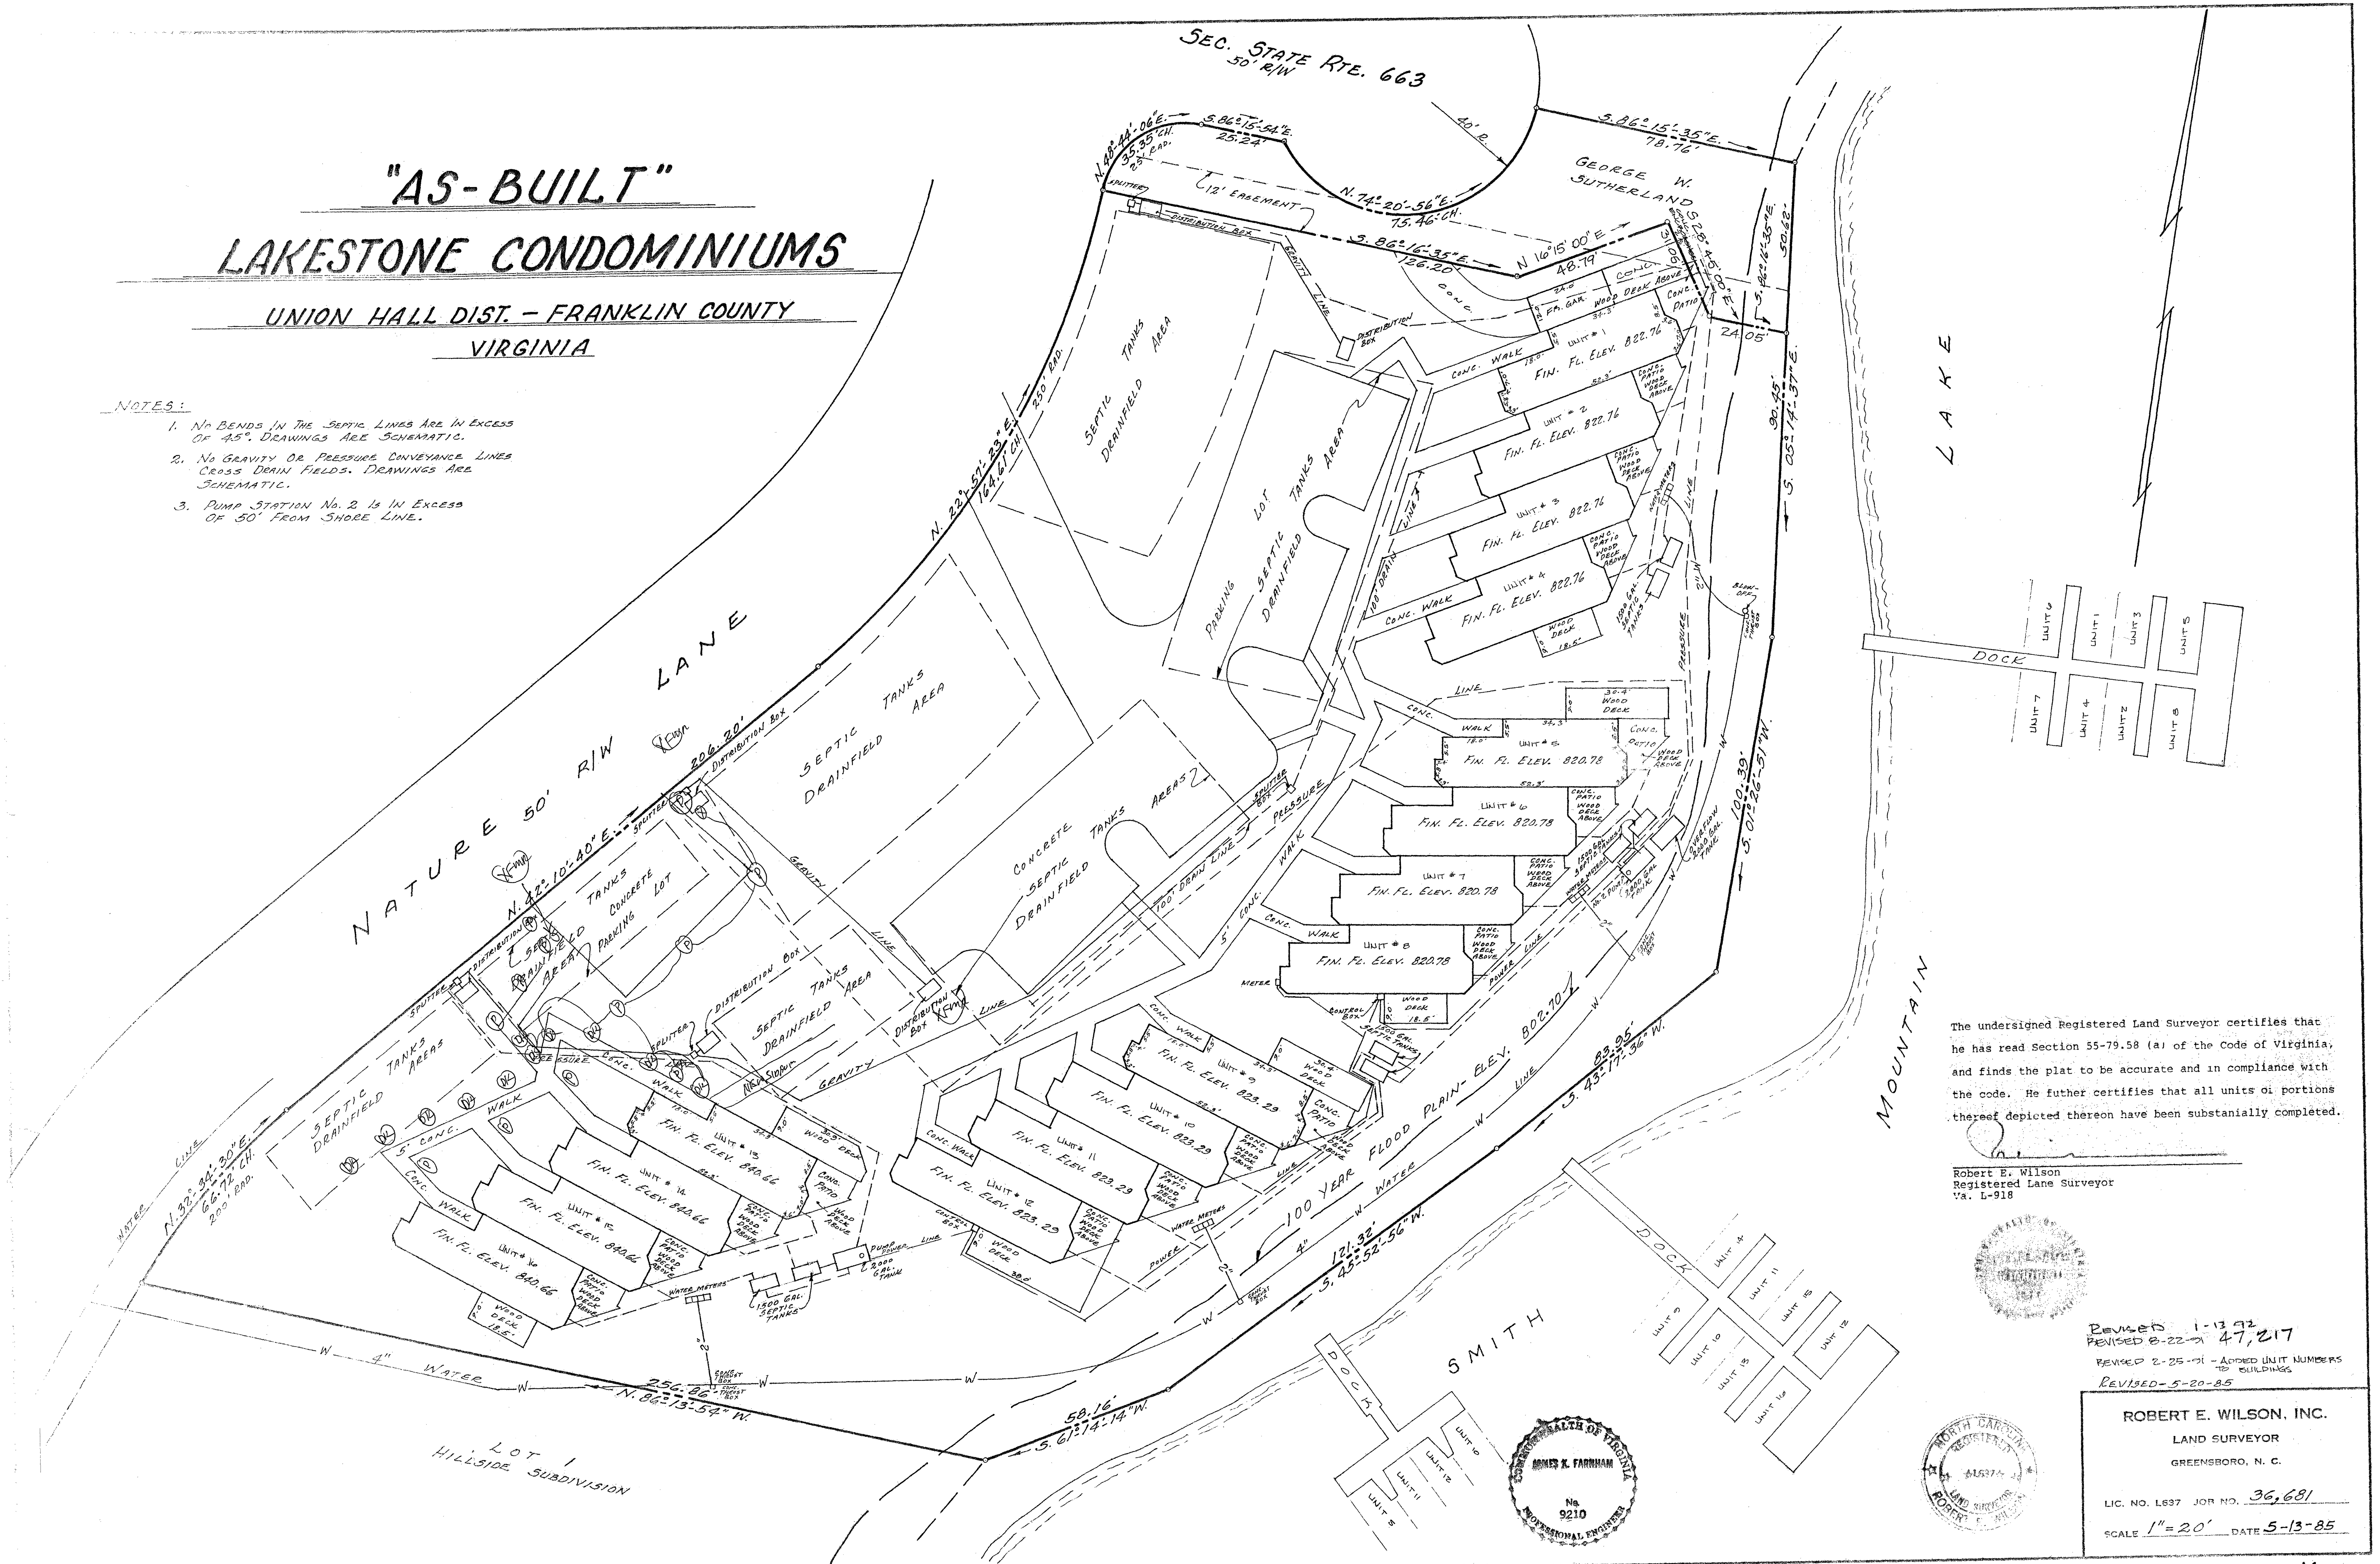

The undersigned Registered Land Surveyor certifies that he has read Section 55-79.58 (a) of the Code of Virginia, and finds the plat to be accurate and in compliance with the code. He further certifies that all units or portions thereof depicted thereon have been substantially completed.

Robert E. Wilson
Registered Land Surveyor
Va. L-918

Revised 1-13-92
REVISED 8-22-97 47,217
REVISED 2-25-98 - ADDED UNIT NUMBERS TO BUILDINGS
REVISED-5-20-85

ROBERT E. WILSON, INC.
LAND SURVEYOR
GREENSBORO, N. C.

LIC. NO. 1637 JOB NO. 36,681
SCALE 1" = 20' DATE 5-13-85