

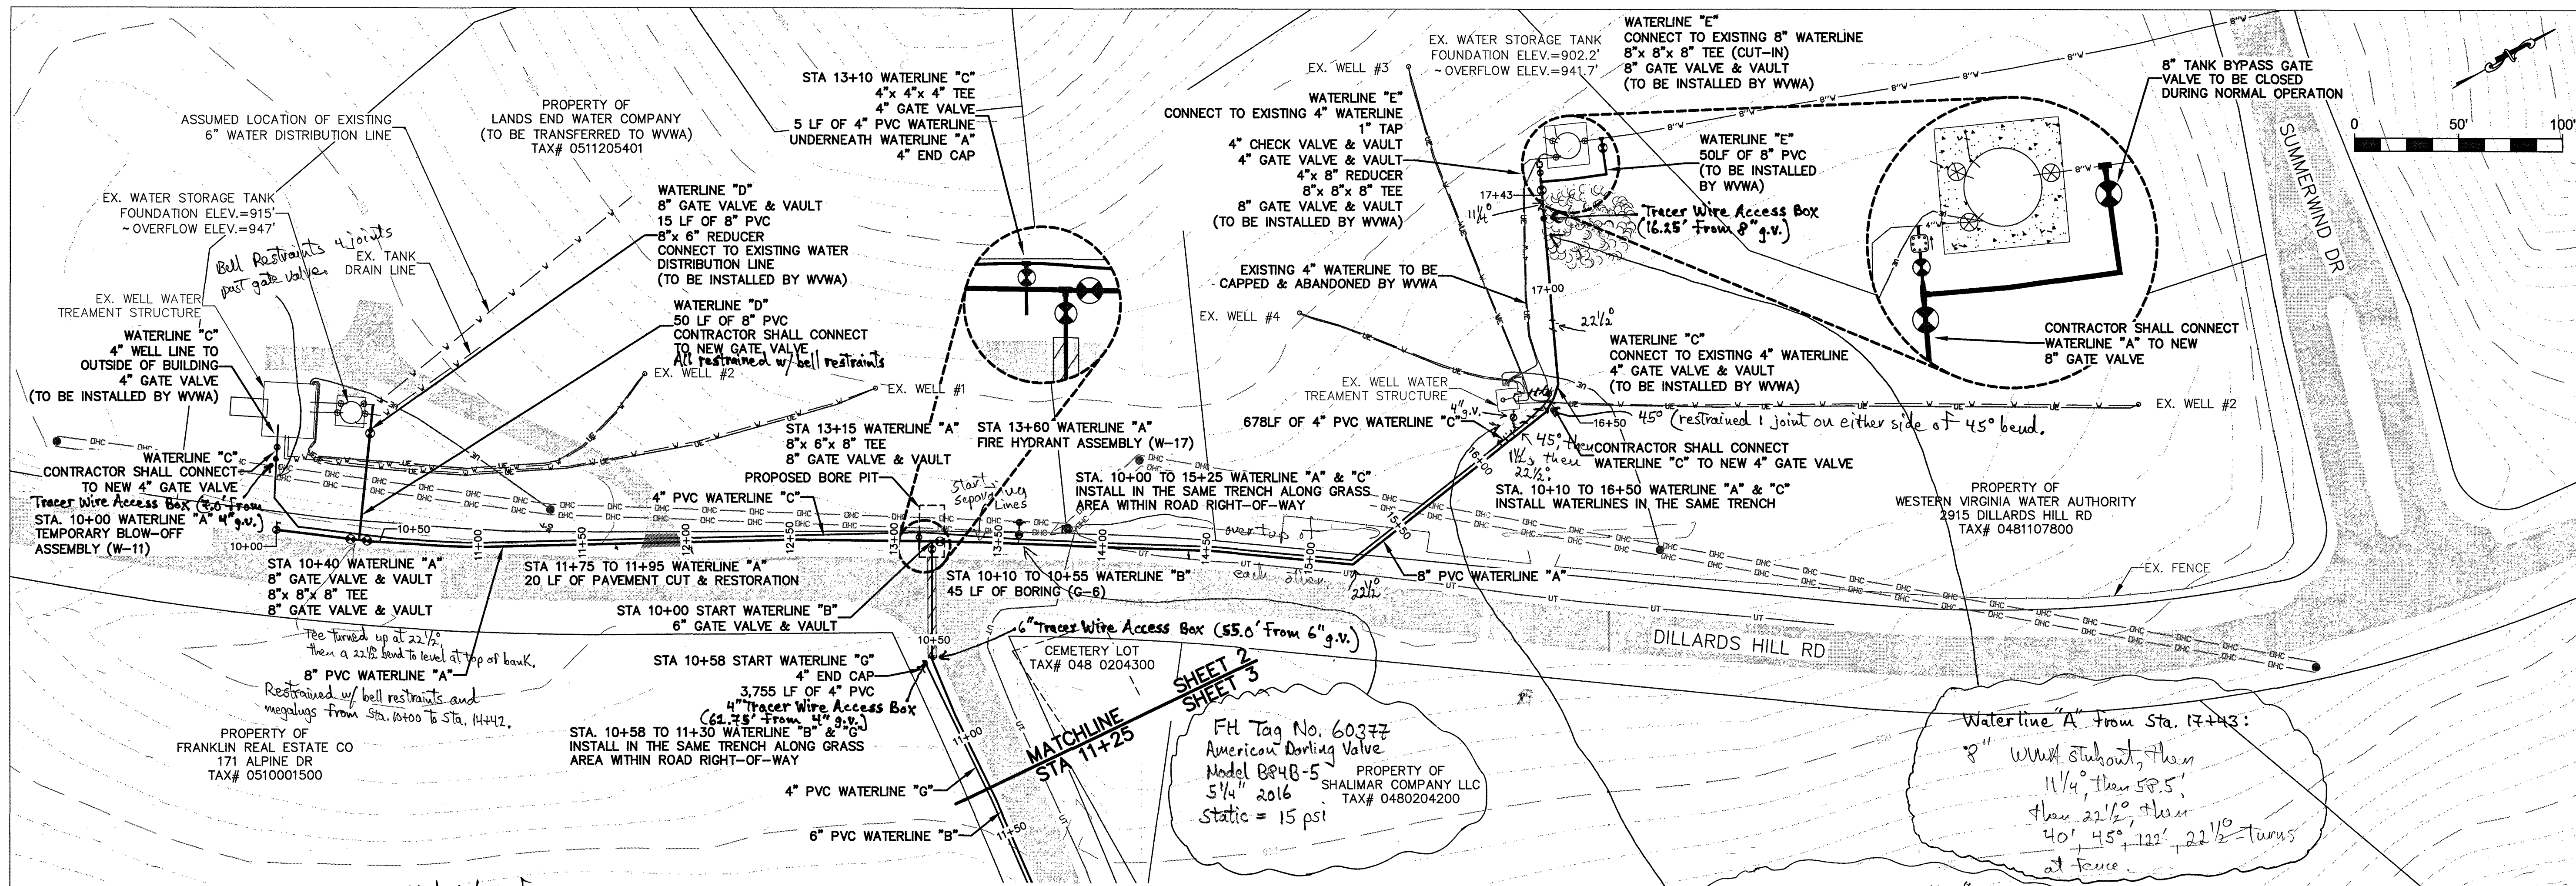


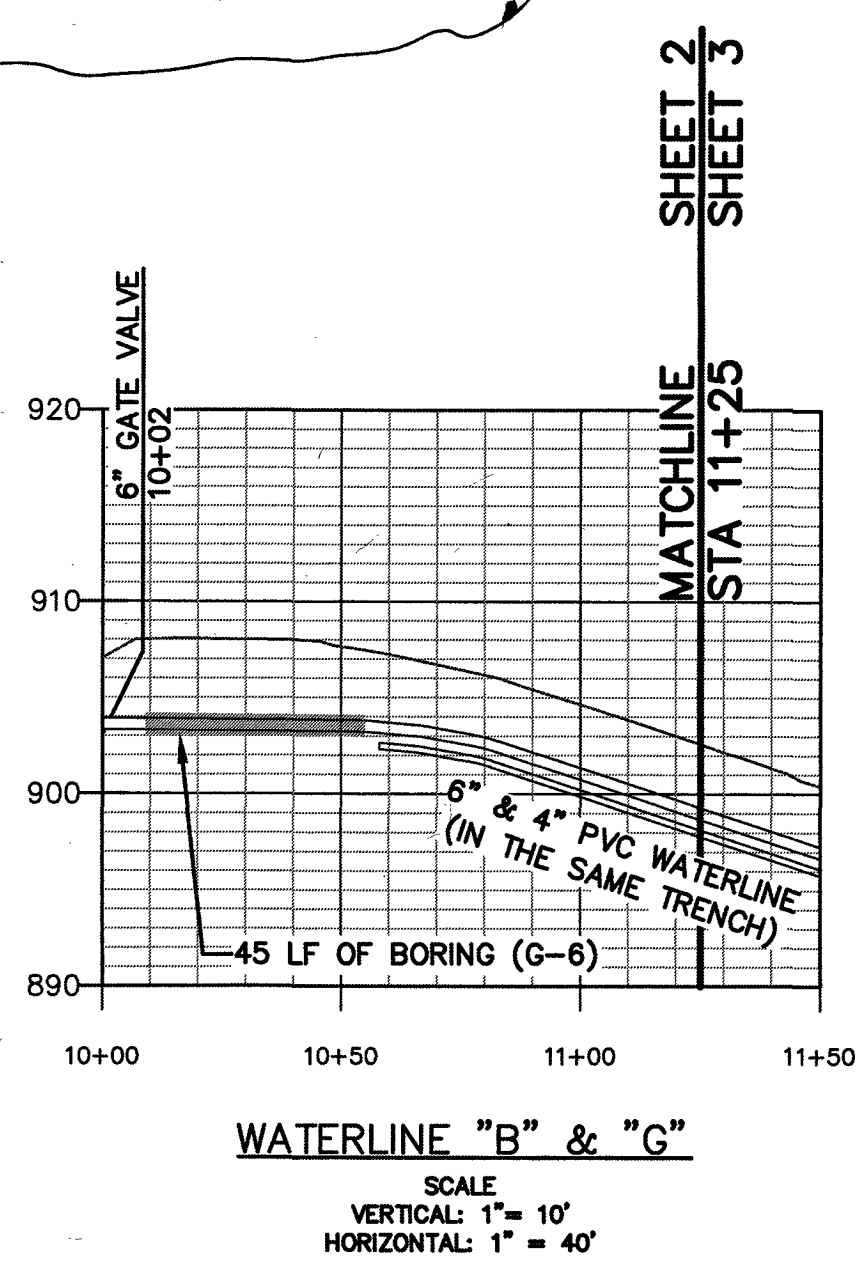

Material Info

Pipe: 6" Sanderson PVC C900 DR14
 4" DPC PVC C900 DR14 (1000' laid first at beginning of Lakestone Rd.)
 8" Sanderson PVC C900 DR14
 4" National PVC C900 DR14
 Casing Pipe: 8" HOPE SDR17
 Carrier Pipe: 6" Flying W HOPE SDR11
 Gate Valves: 8" American Flow Control 27 Turns, CCW open
 6" " " " 21 Turns, " "
 4" " " " 15 Turns, " "

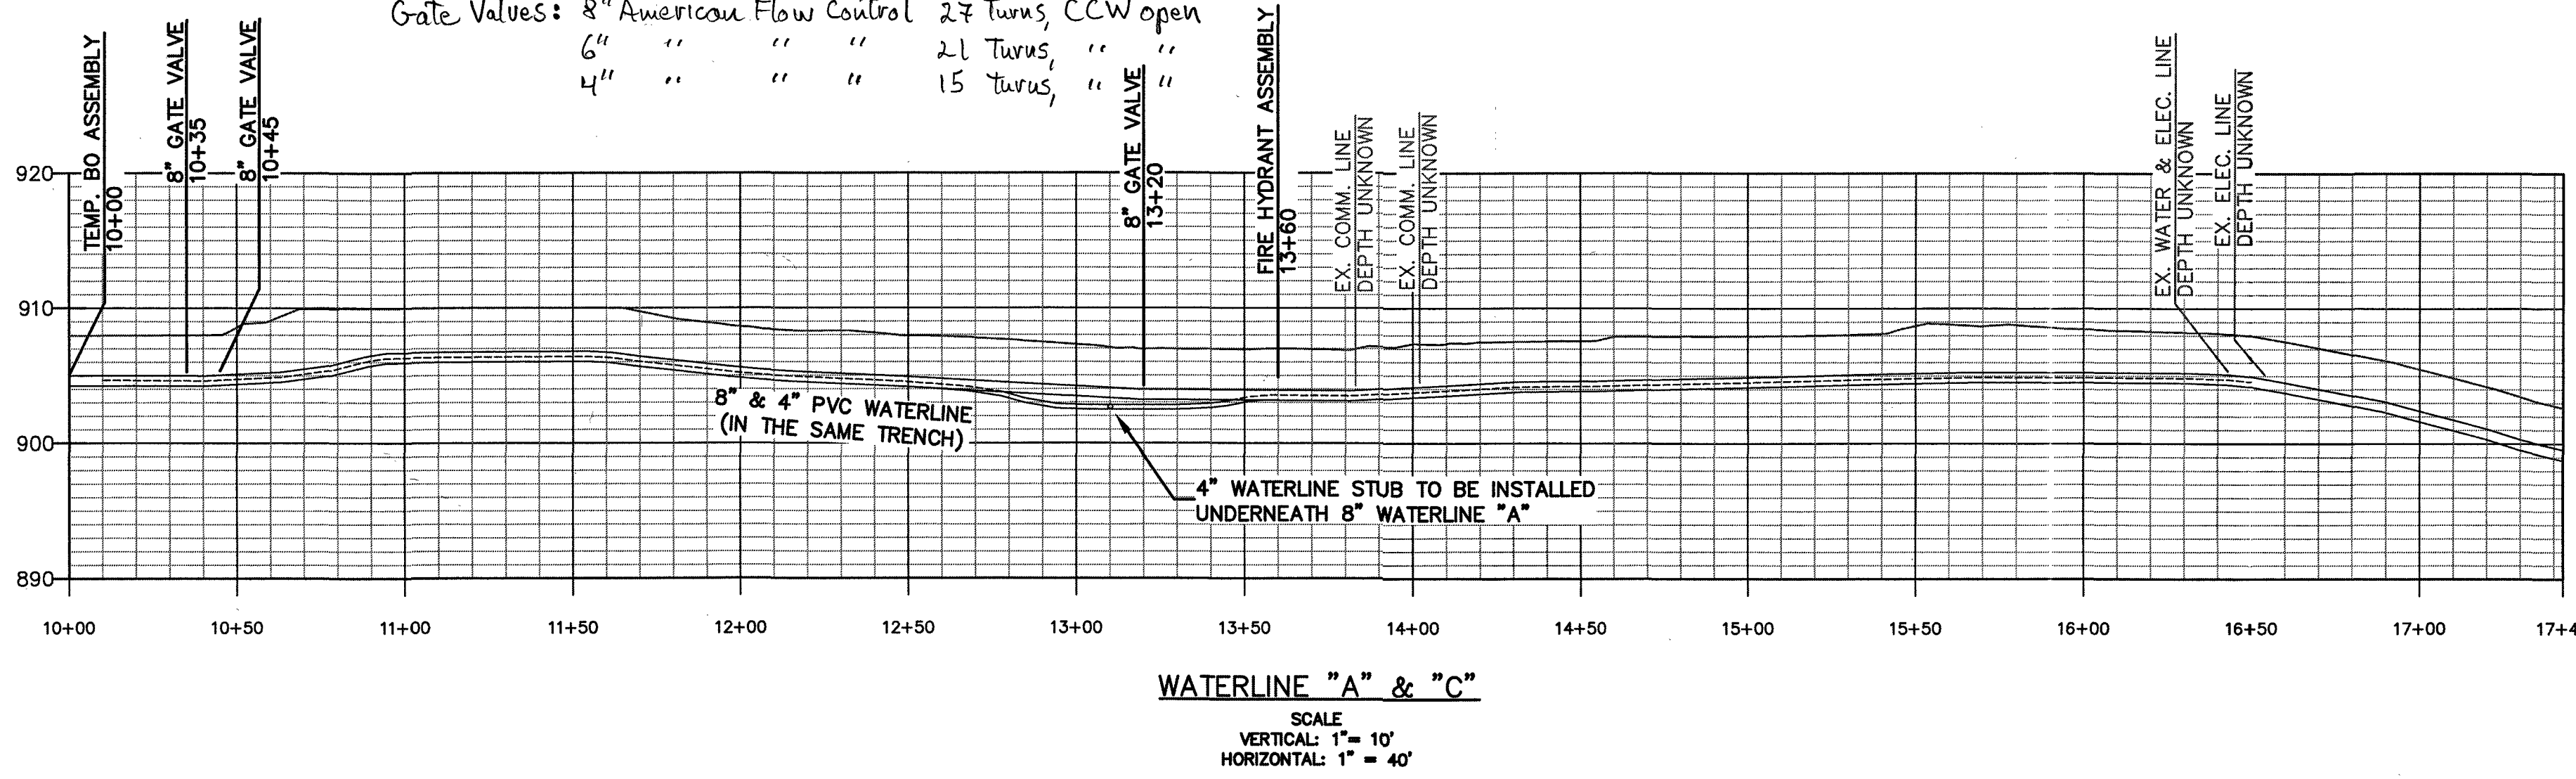

WESTERN VIRGINIA

WATER AUTHORITY

ENGINEERING SERVICES

601 S JEFFERSON ST, SUITE 300

ROANOKE, VA 24011

540-853-5641 or 540-853-5770

DAVID M. VOELSONG

Professional Engineer

License No. 023274

Professional Seal

LAKESTONE ROAD

WATER EXTENSION

PLAN & PROFILE

Rev	Description	Date	By
1	4" WELL LINE CHANGE ORDER 3-30-16 DRJ		

Designed: DMV

Drawn: DRJ

Checked:

Approved:

Date:

Project:

2

Sheet 2 of 7

As-Builts Substantial Completion 8.18.16 K.Winslow