
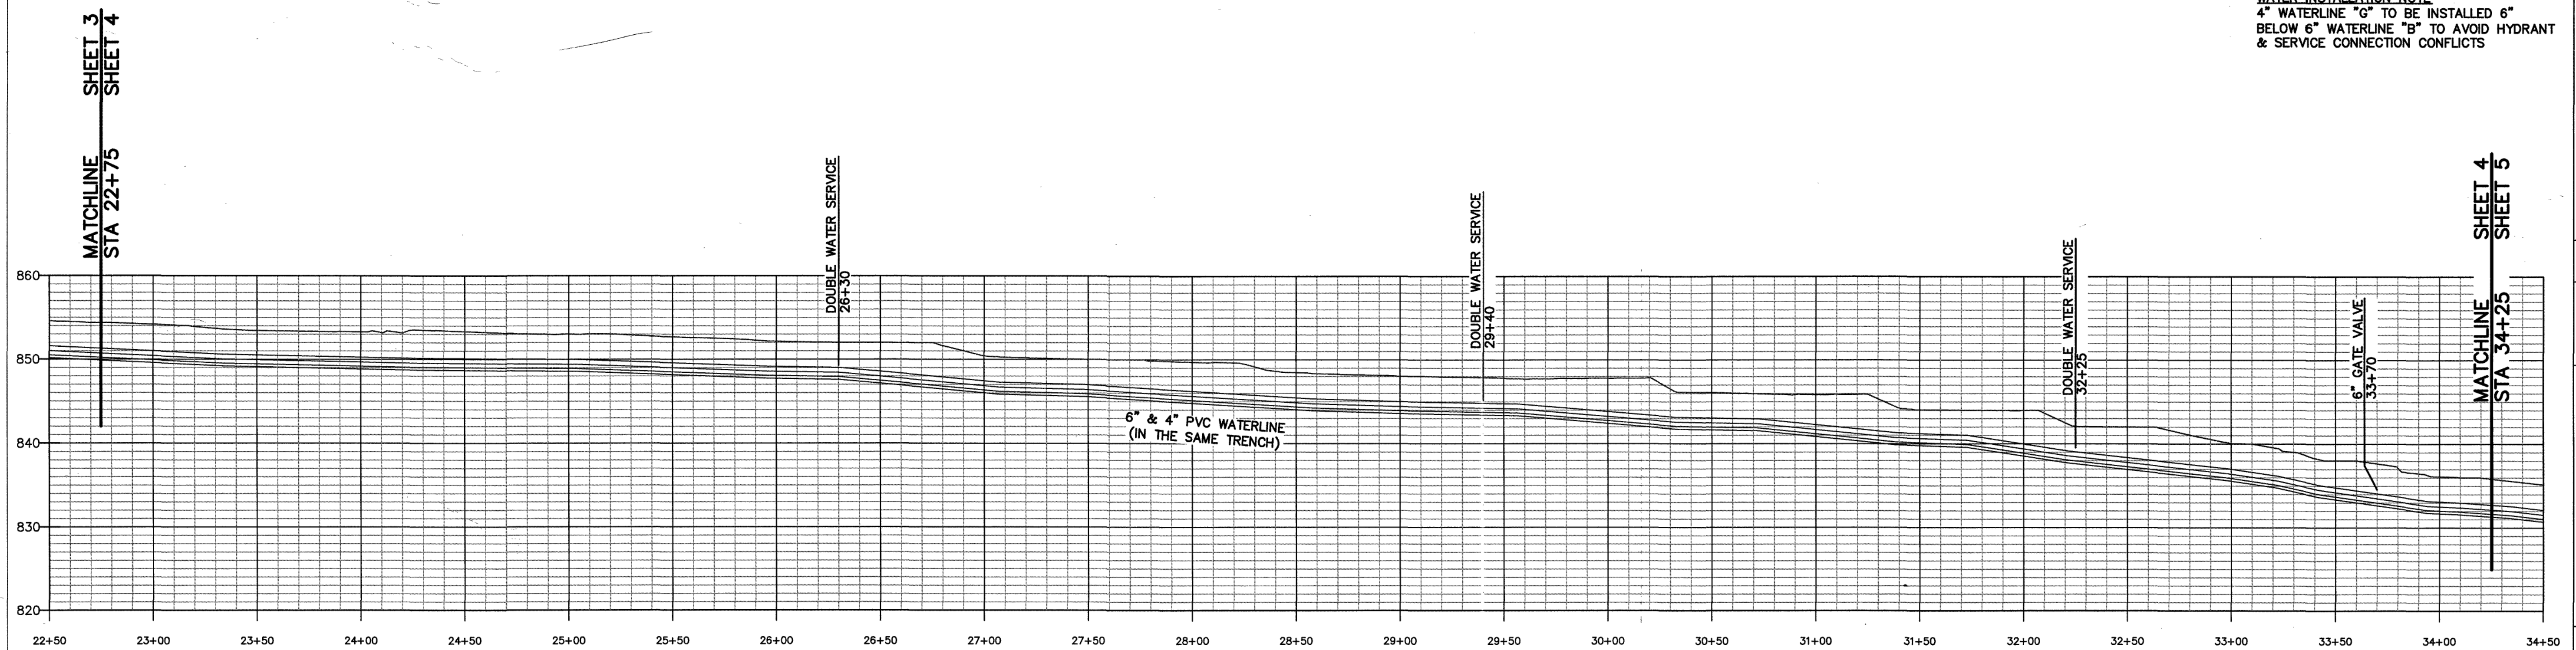


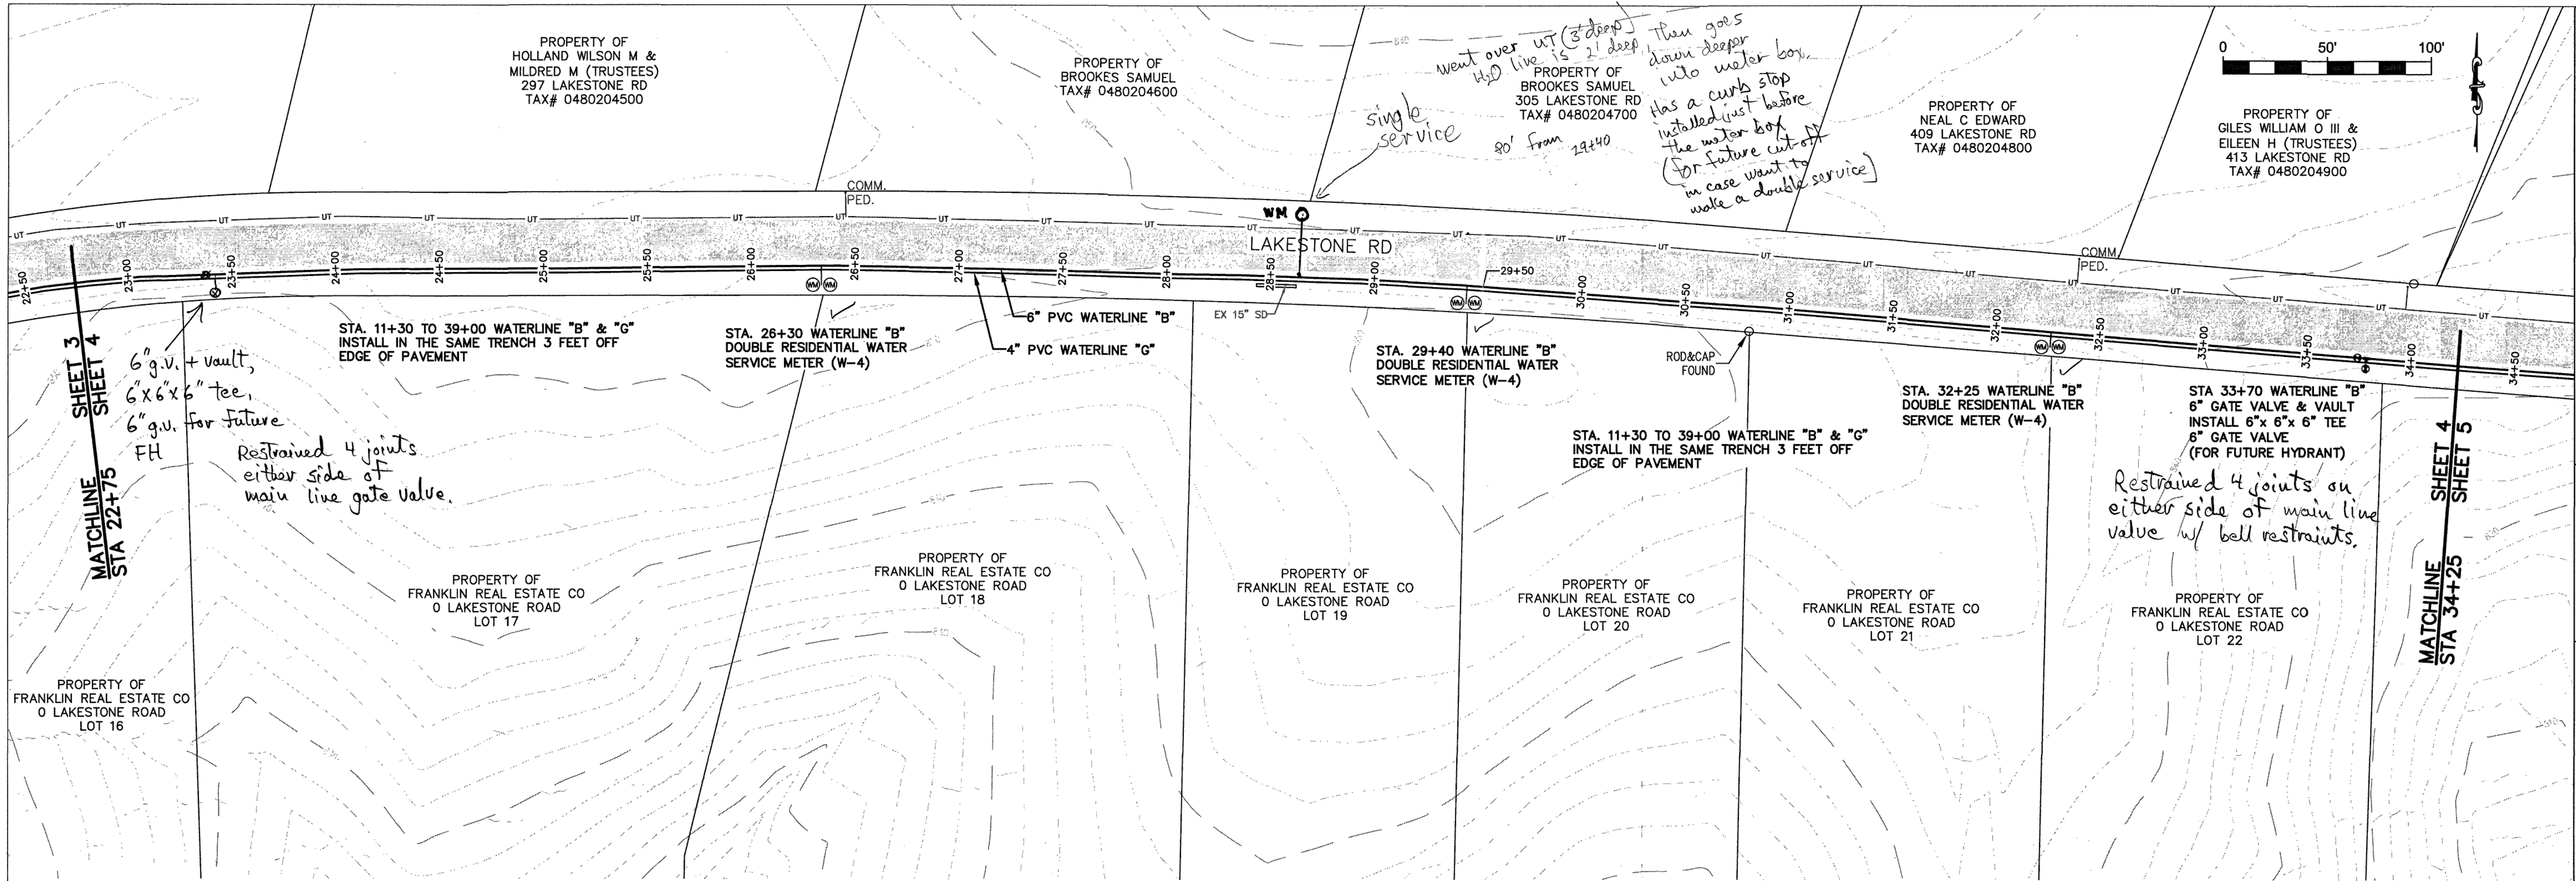

WATERLINE "B" & "G"
SCALE
VERTICAL: 1" = 10'
HORIZONTAL: 1" = 40'

WESTERN VIRGINIA

WATER AUTHORITY

ENGINEERING SERVICES
601 S JEFFERSON ST, SUITE 300
ROANOKE, VA 24011
540-853-5641 or 540-853-5770

DAVID M. VOGELSONG
Lic. No. 023274
PROFESSIONAL ENGINEER

LAKESTONE ROAD
WATER EXTENSION

PLAN & PROFILE

Rev	Description	Date	By
1	4" WELL LINE CHANGE ORDER 3-30-16	DRJ	

Designed: DMV
Drawn: DRJ
Checked:
Approved:
Date:
Project:

4
Sheet 4 of 7

As-Builts
K. Winslow