
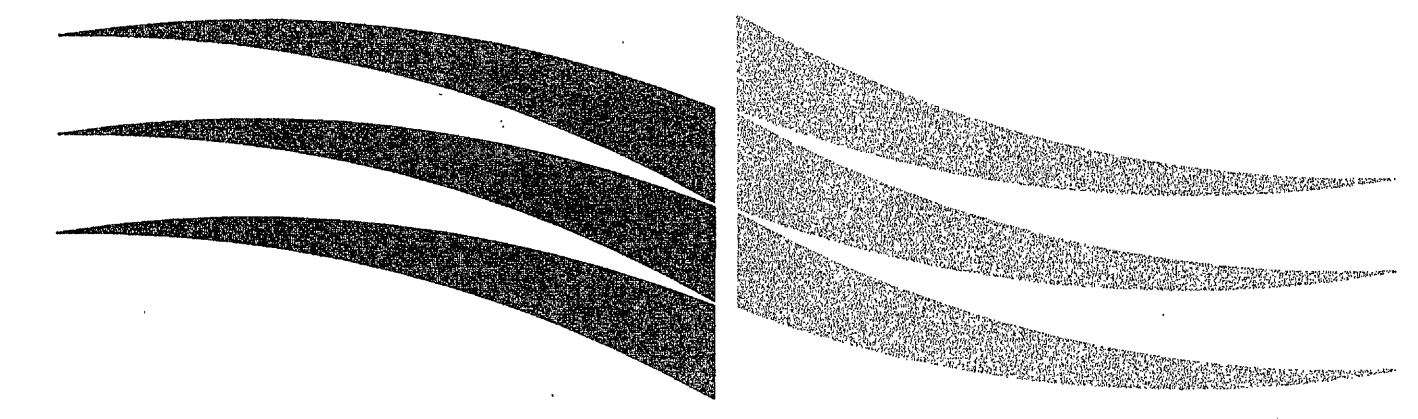


5, 7, 10
WVWA
AS-BUILT

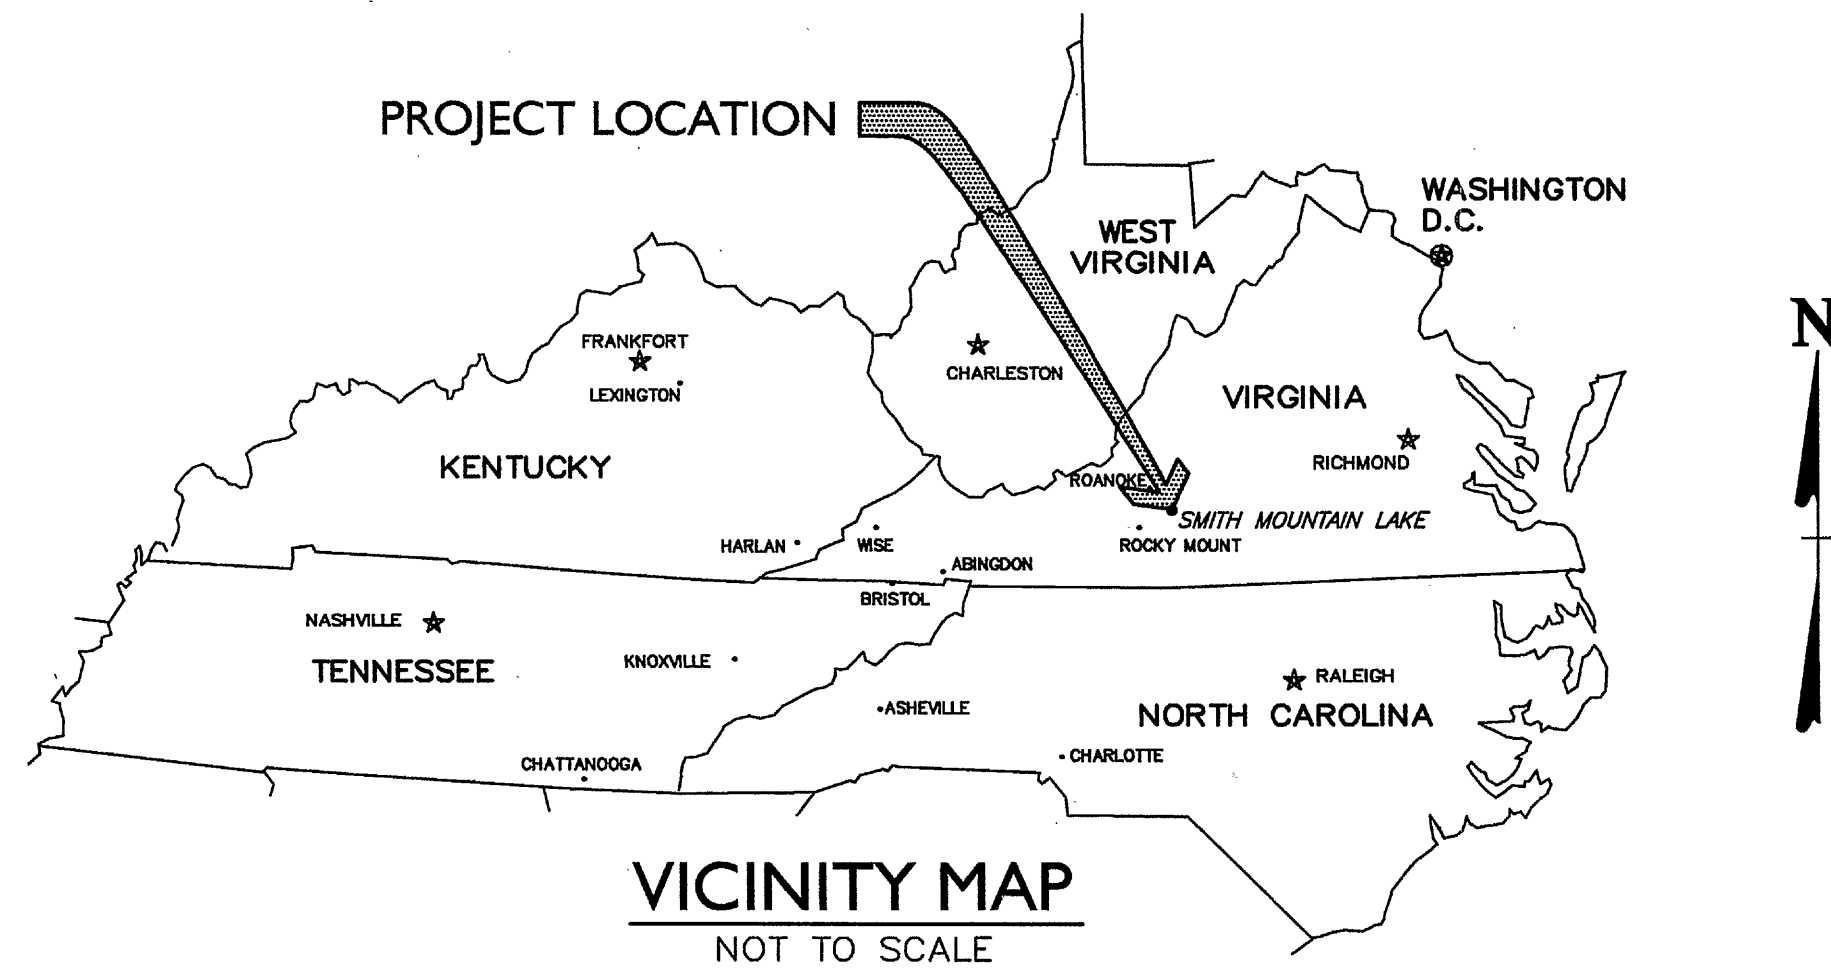

THOMPSON & LITTON

6226 University Park Drive
Suite 3100
Radford, Virginia 24141
(540) 633-1897


AS BUILT
HLL
8-25-10

STATE ROUTE 616 WATER LINE EXTENSION FOR THE FRANKLIN COUNTY BOARD OF SUPERVISORS AND WESTERN VIRGINIA WATER AUTHORITY

WESTERN VIRGINIA WATER AUTHORITY
GARY ROBERTSON, DIRECTOR OF UTILITIES
601 S JEFFERSON STREET
ROANOKE, VIRGINIA 24011
(540) 853-5700

T&L PROJECT NO.: 9343-02

JULY 2009

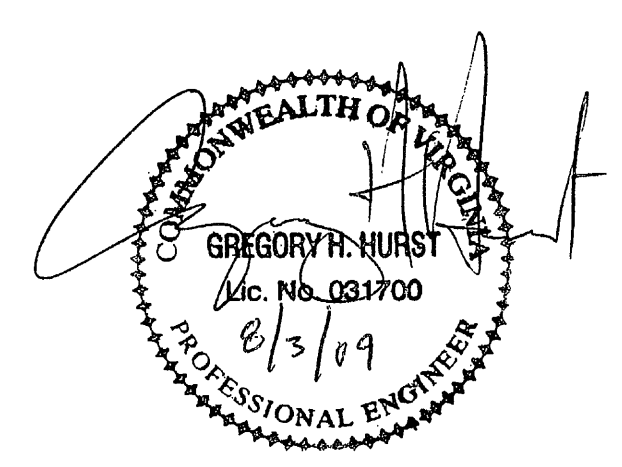

FINAL DOCUMENTS ISSUED JULY 22, 2009