




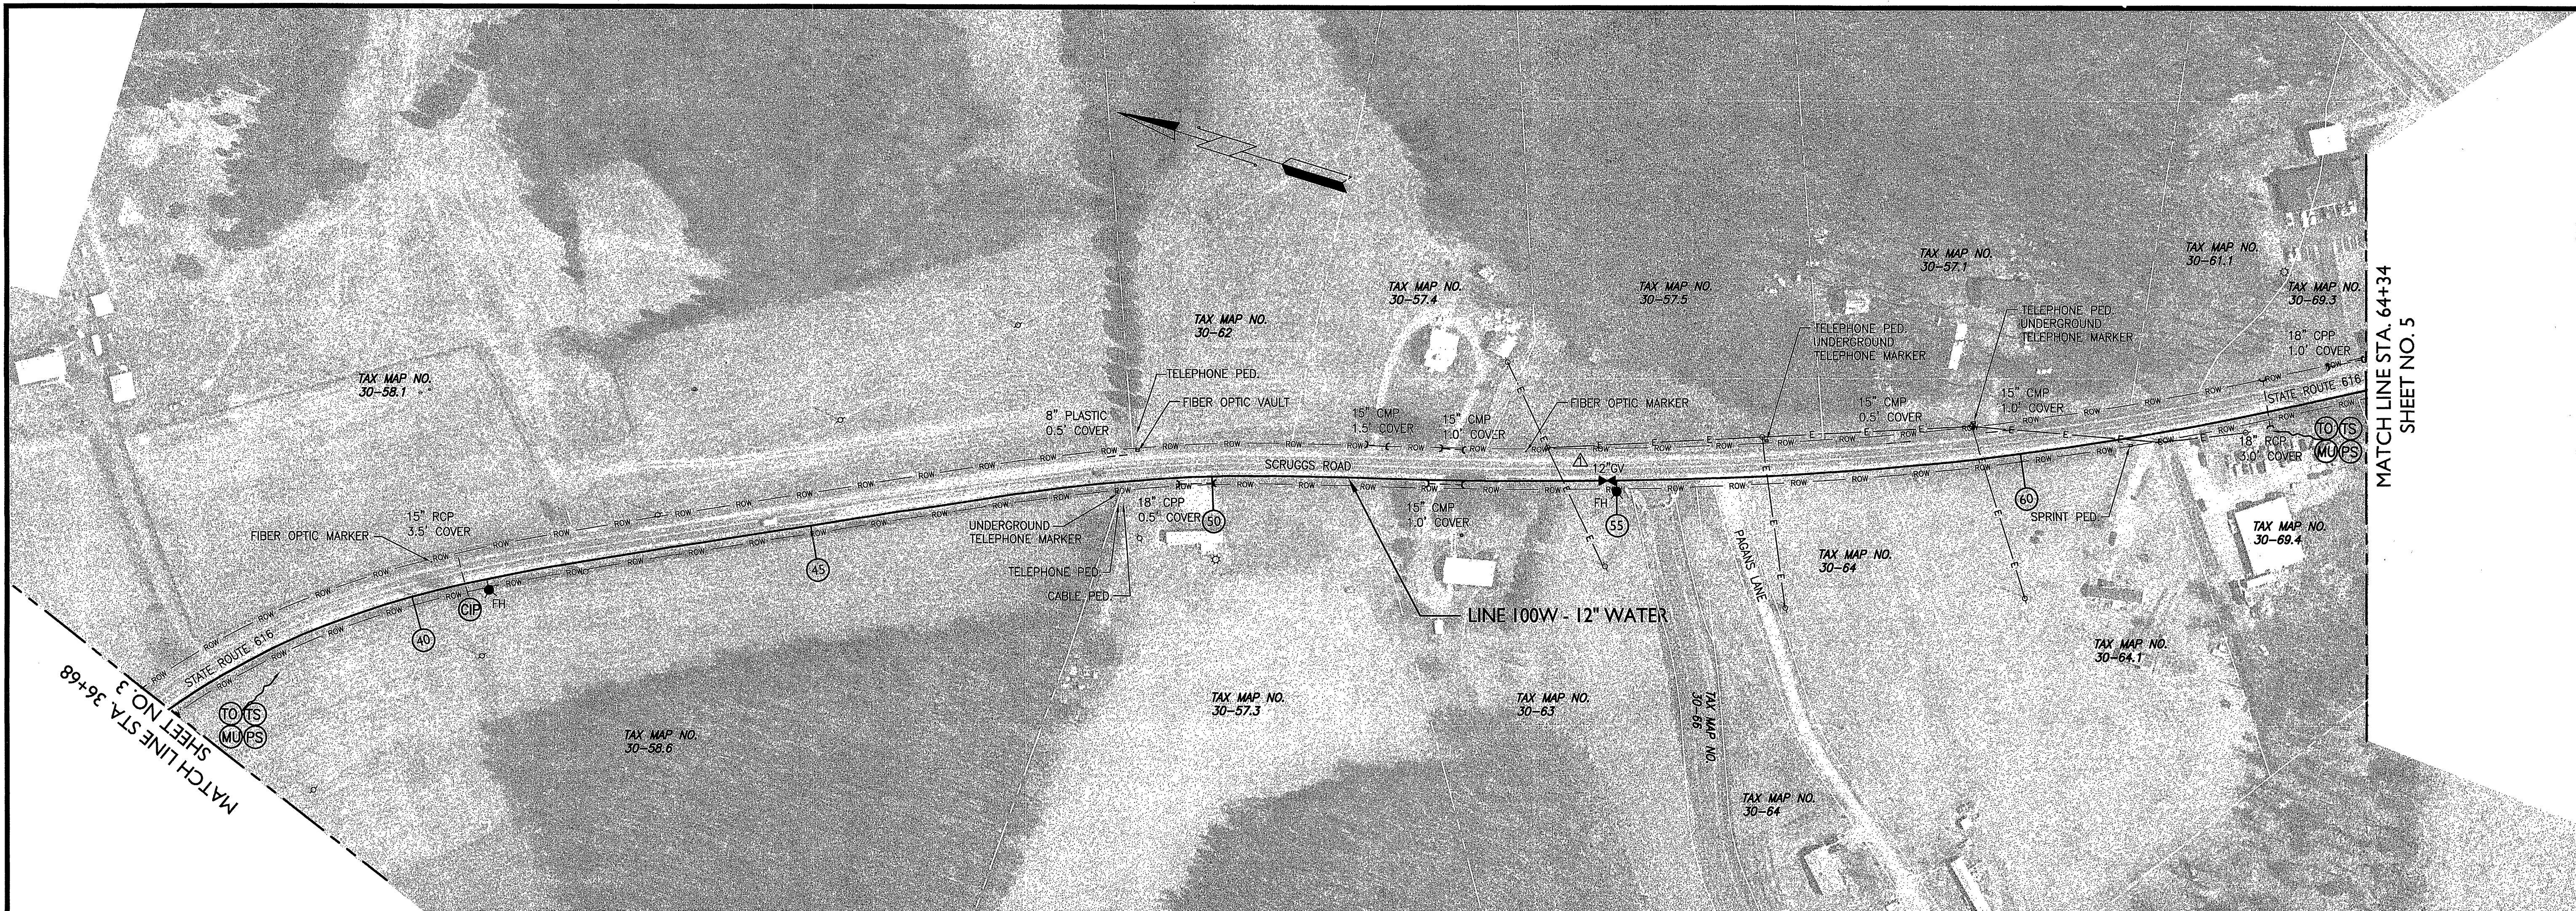

MATCH LINE STA. 64+34
SHEET NO. 5

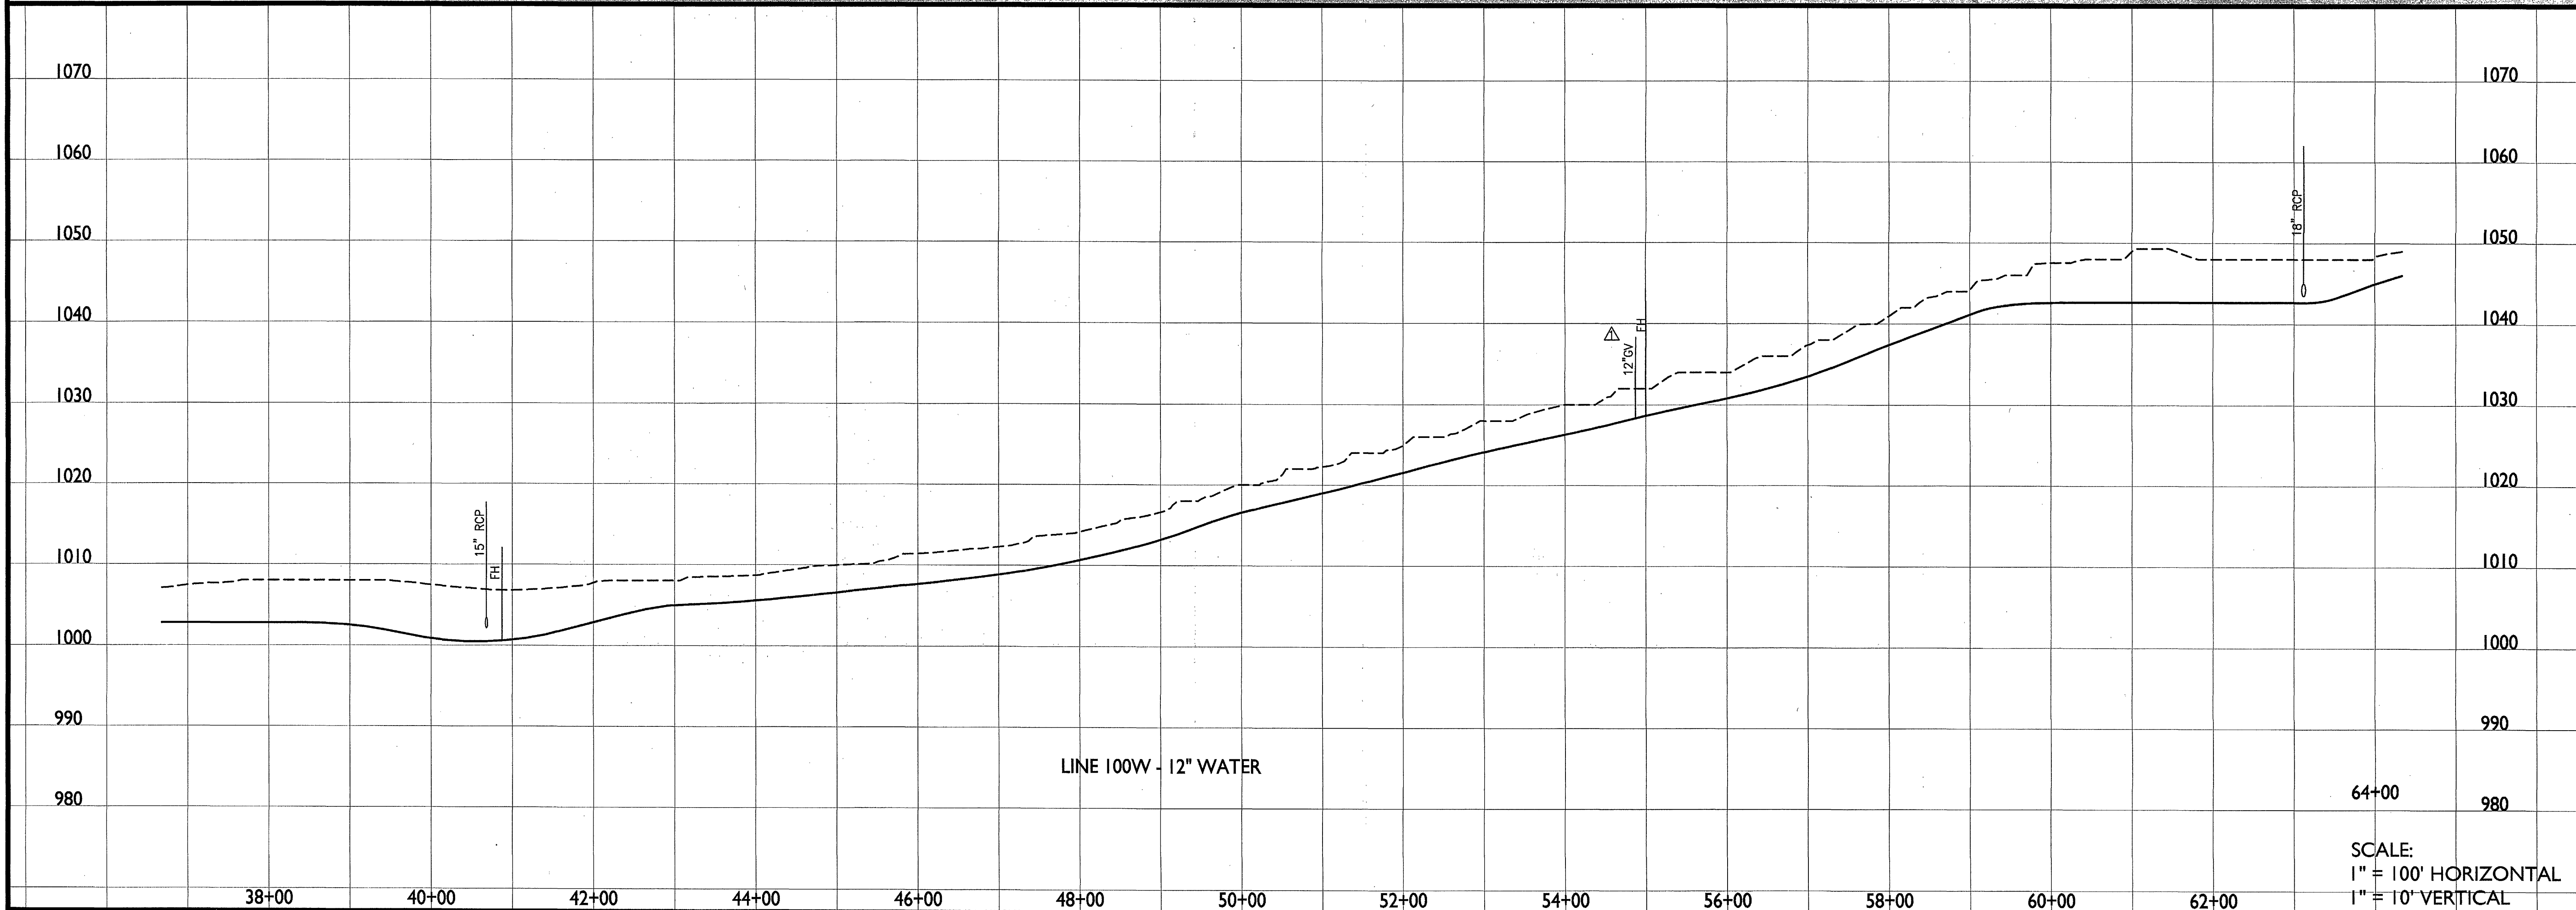

SCALE:
1" = 100' HORIZONTAL
1" = 10' VERTICAL

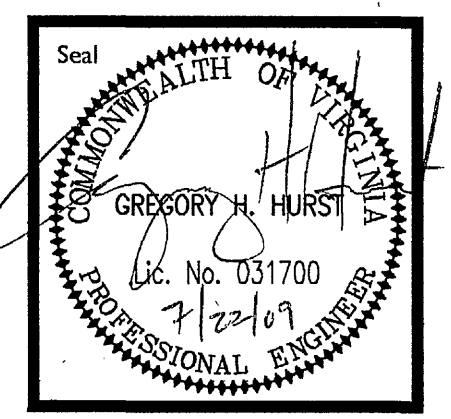

STATE ROUTE 616 WATER LINE EXTENSION
FOR THE
FRANKLIN COUNTY BOARD OF SUPERVISORS
AND
WESTERN VIRGINIA WATER AUTHORITY
PLAN & PROFILE - LINE 100W

Purpose of Document Issue			
Date	Review	Documents Issued	
07/02/09	REVIEW	DOCUMENTS ISSUED	
07/17/09	OWNER COMMENTS	07/13/09	
07/22/09	FINAL DOCUMENTS ISSUED		

Designed	
Drawn	
Checked	
Date	JULY 2009
File No.	WATER LINE PLANS

Project No.
9343-02



Sheet No.
4