
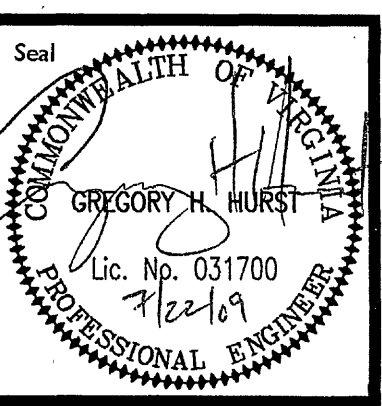
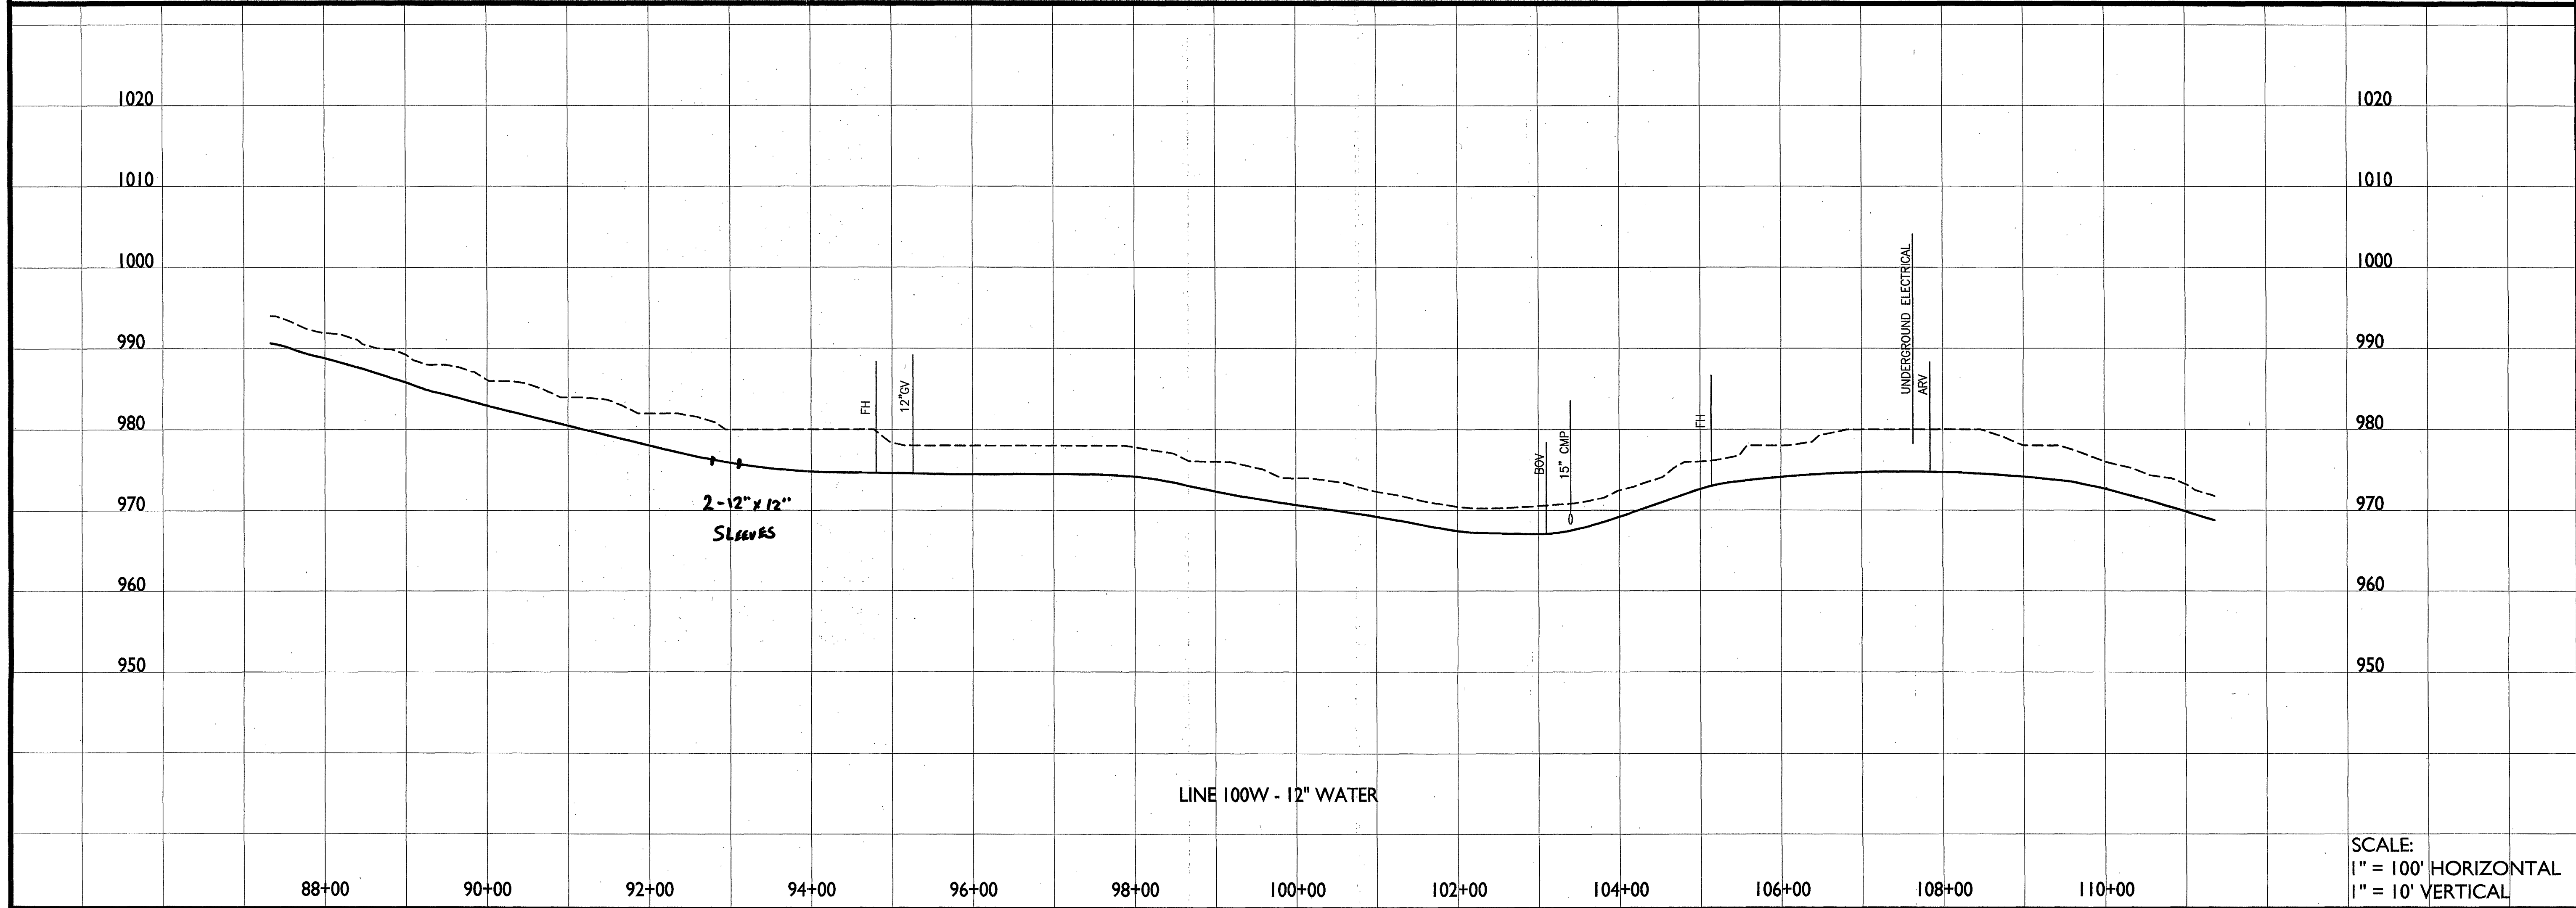


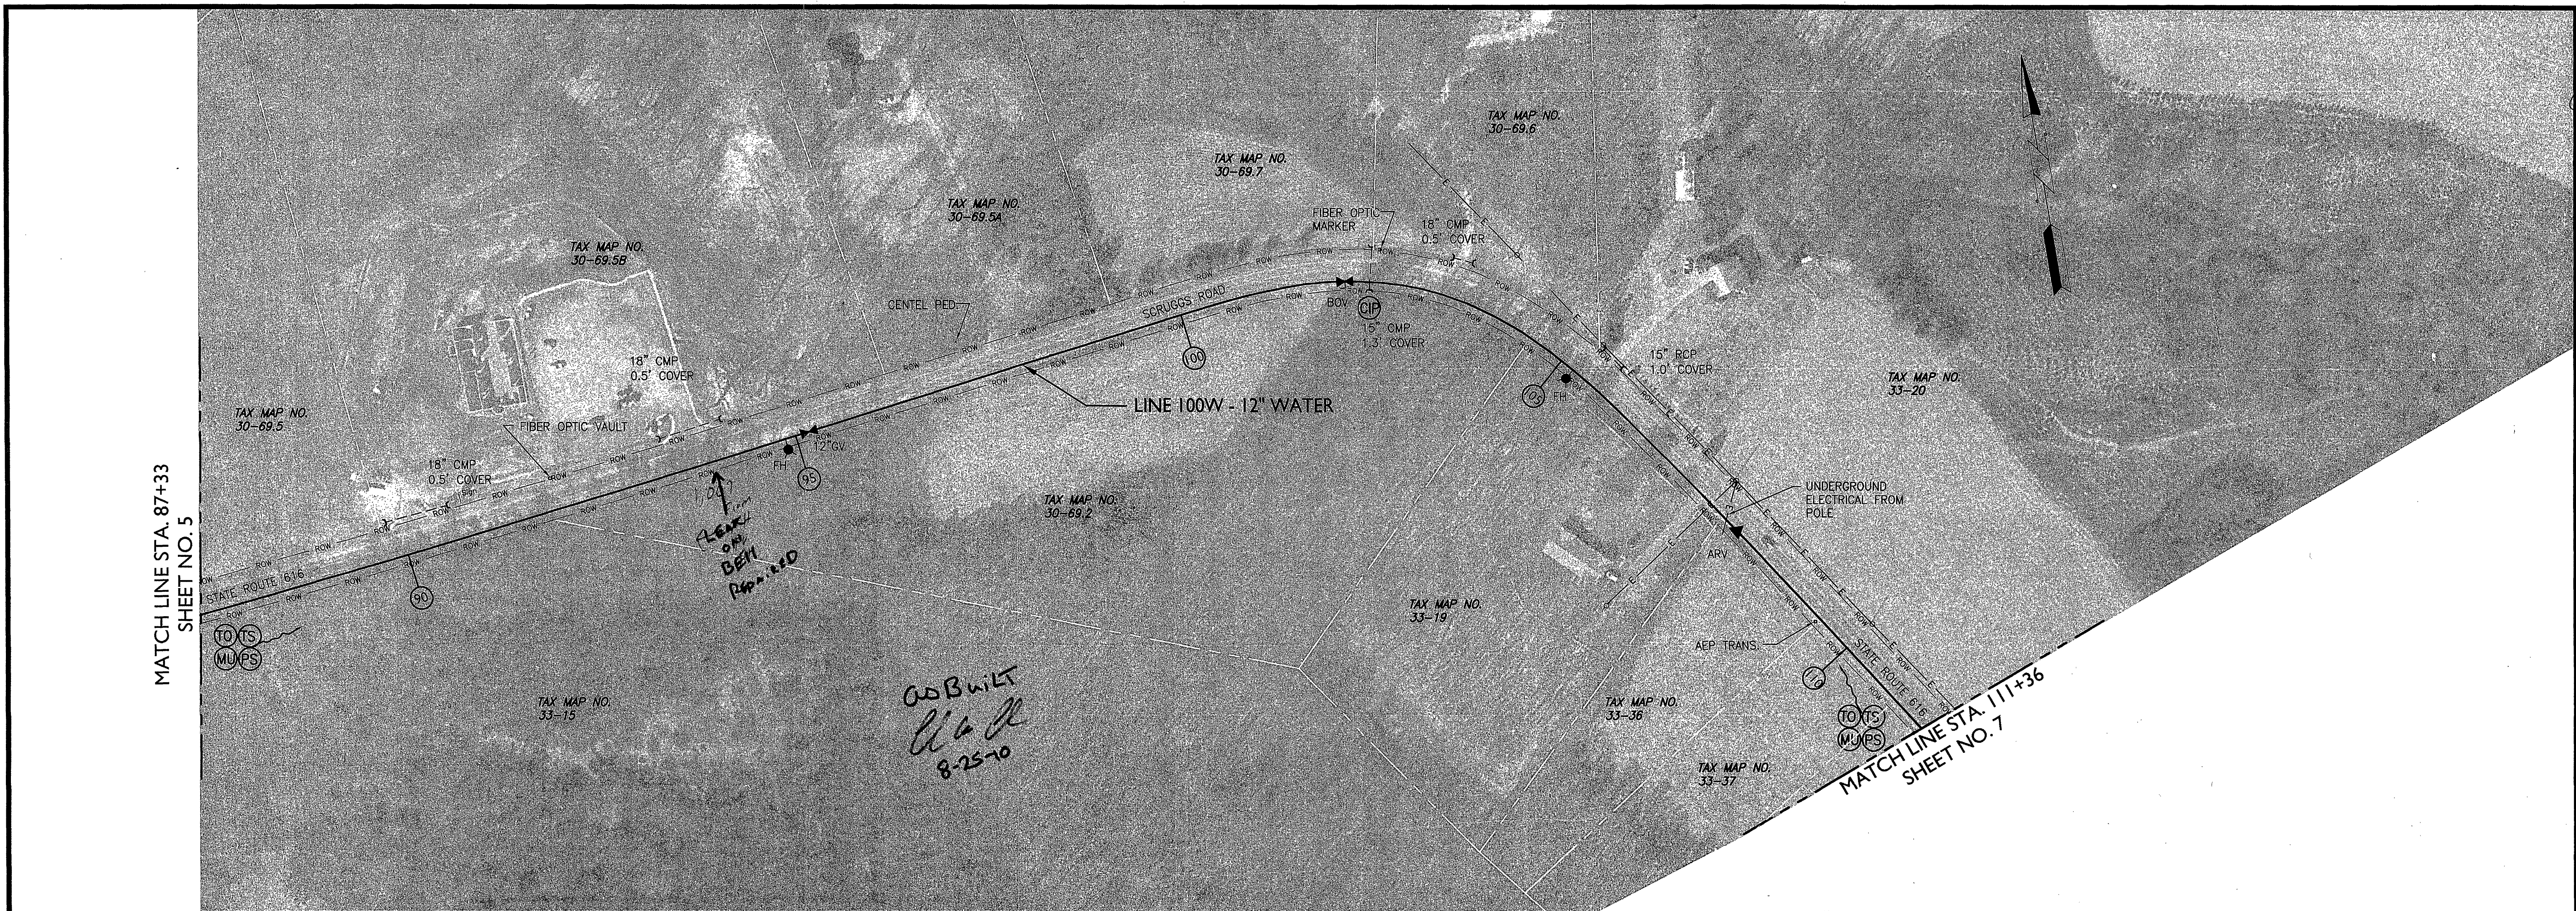

STATE ROUTE 616 WATER LINE EXTENSION
FRANKLIN COUNTY BOARD OF SUPERVISORS
AND
WESTERN VIRGINIA WATER AUTHORITY

PLAN & PROFILE - LINE 100W

No.	Date	Review of Document Issue	
		REVIEW DOCUMENTS ISSUED	FINAL DOCUMENTS ISSUED
	07/02/08		
	07/22/08		

Designed	<i>[Signature]</i>
Drawn	<i>[Signature]</i>
Checked	
Date	JULY 2009
File No.	WATER LINE PLANS

Project No.
9343-02



Sheet No.
6