
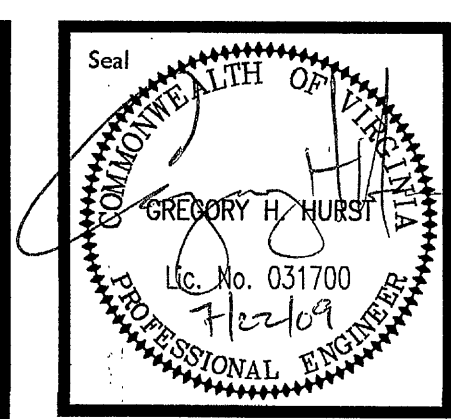
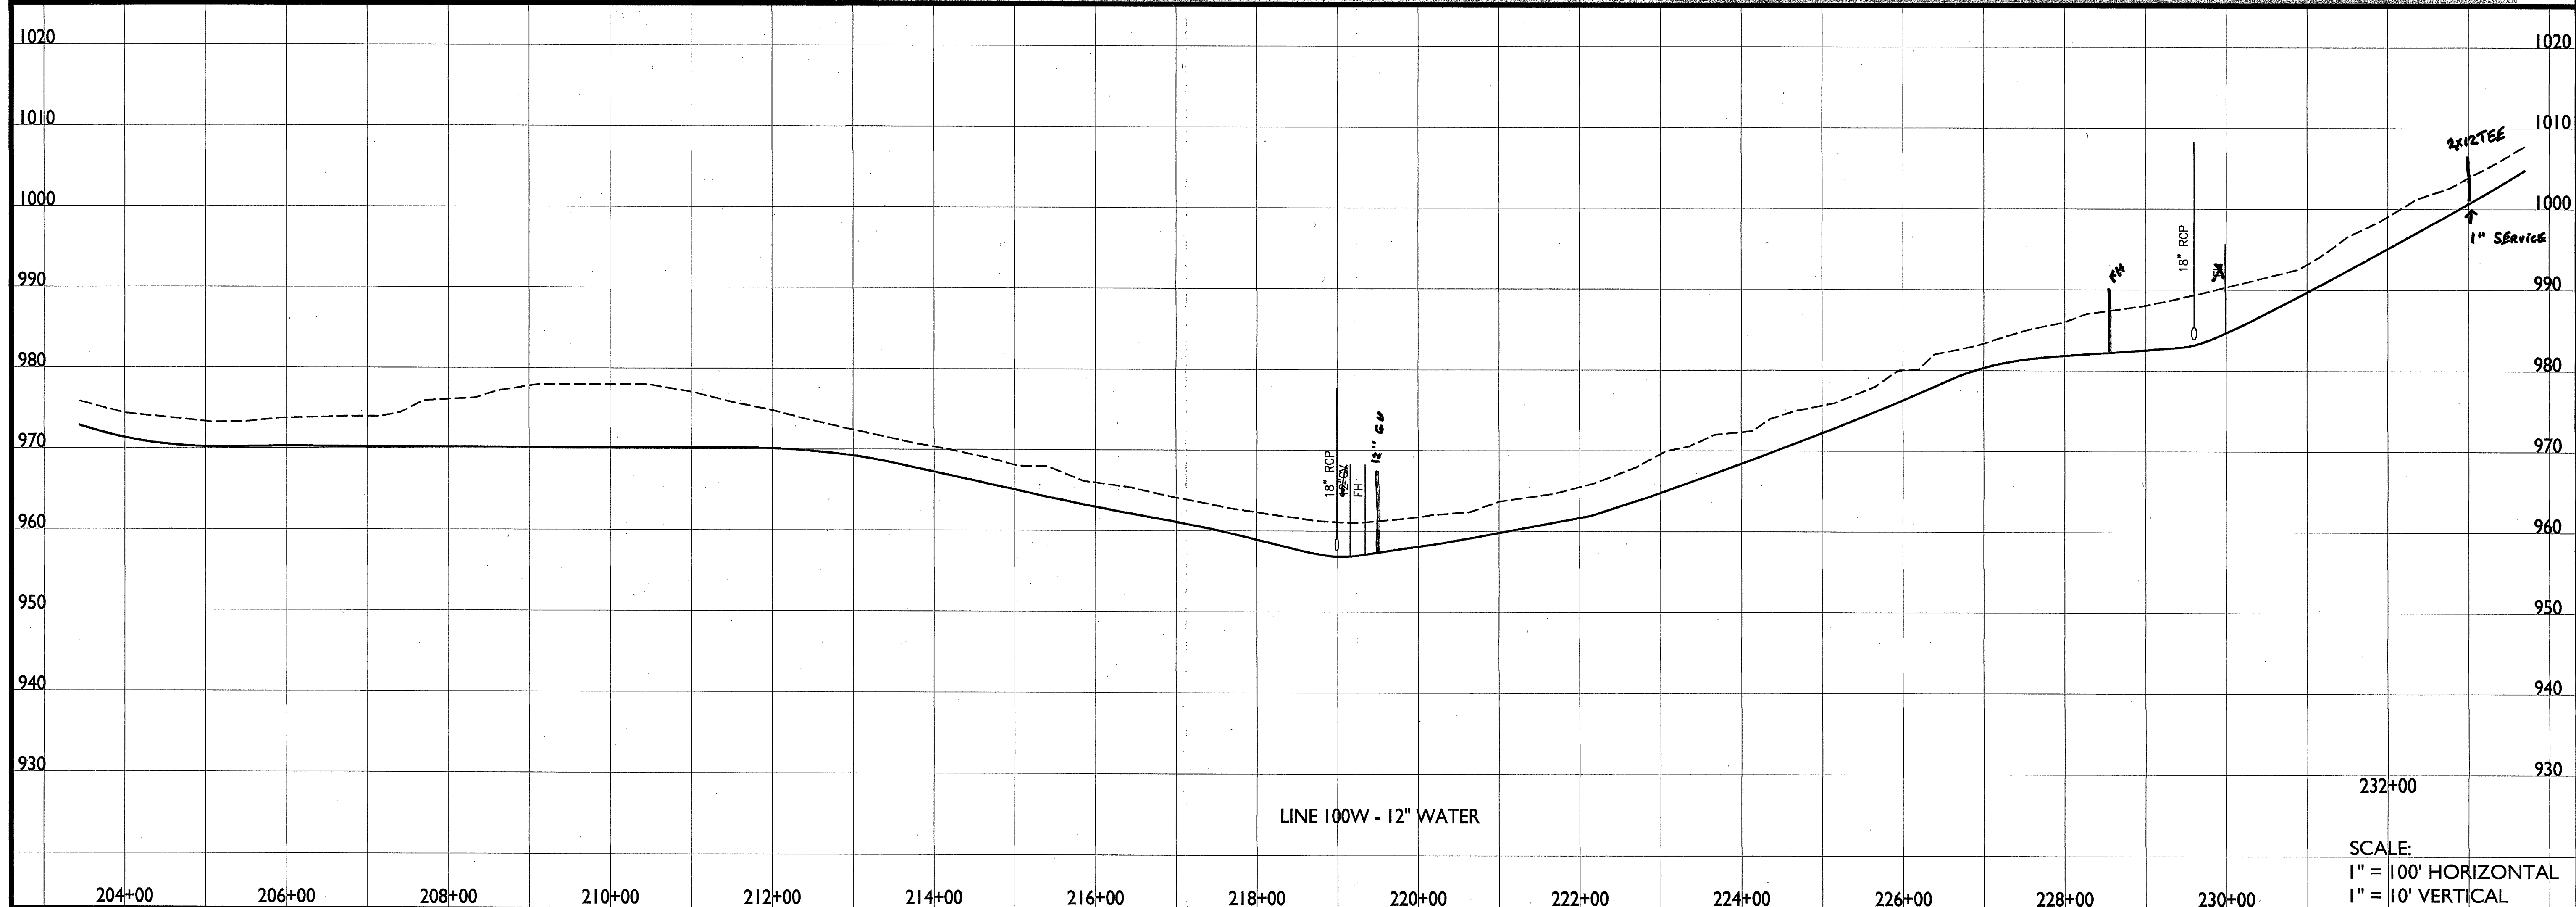


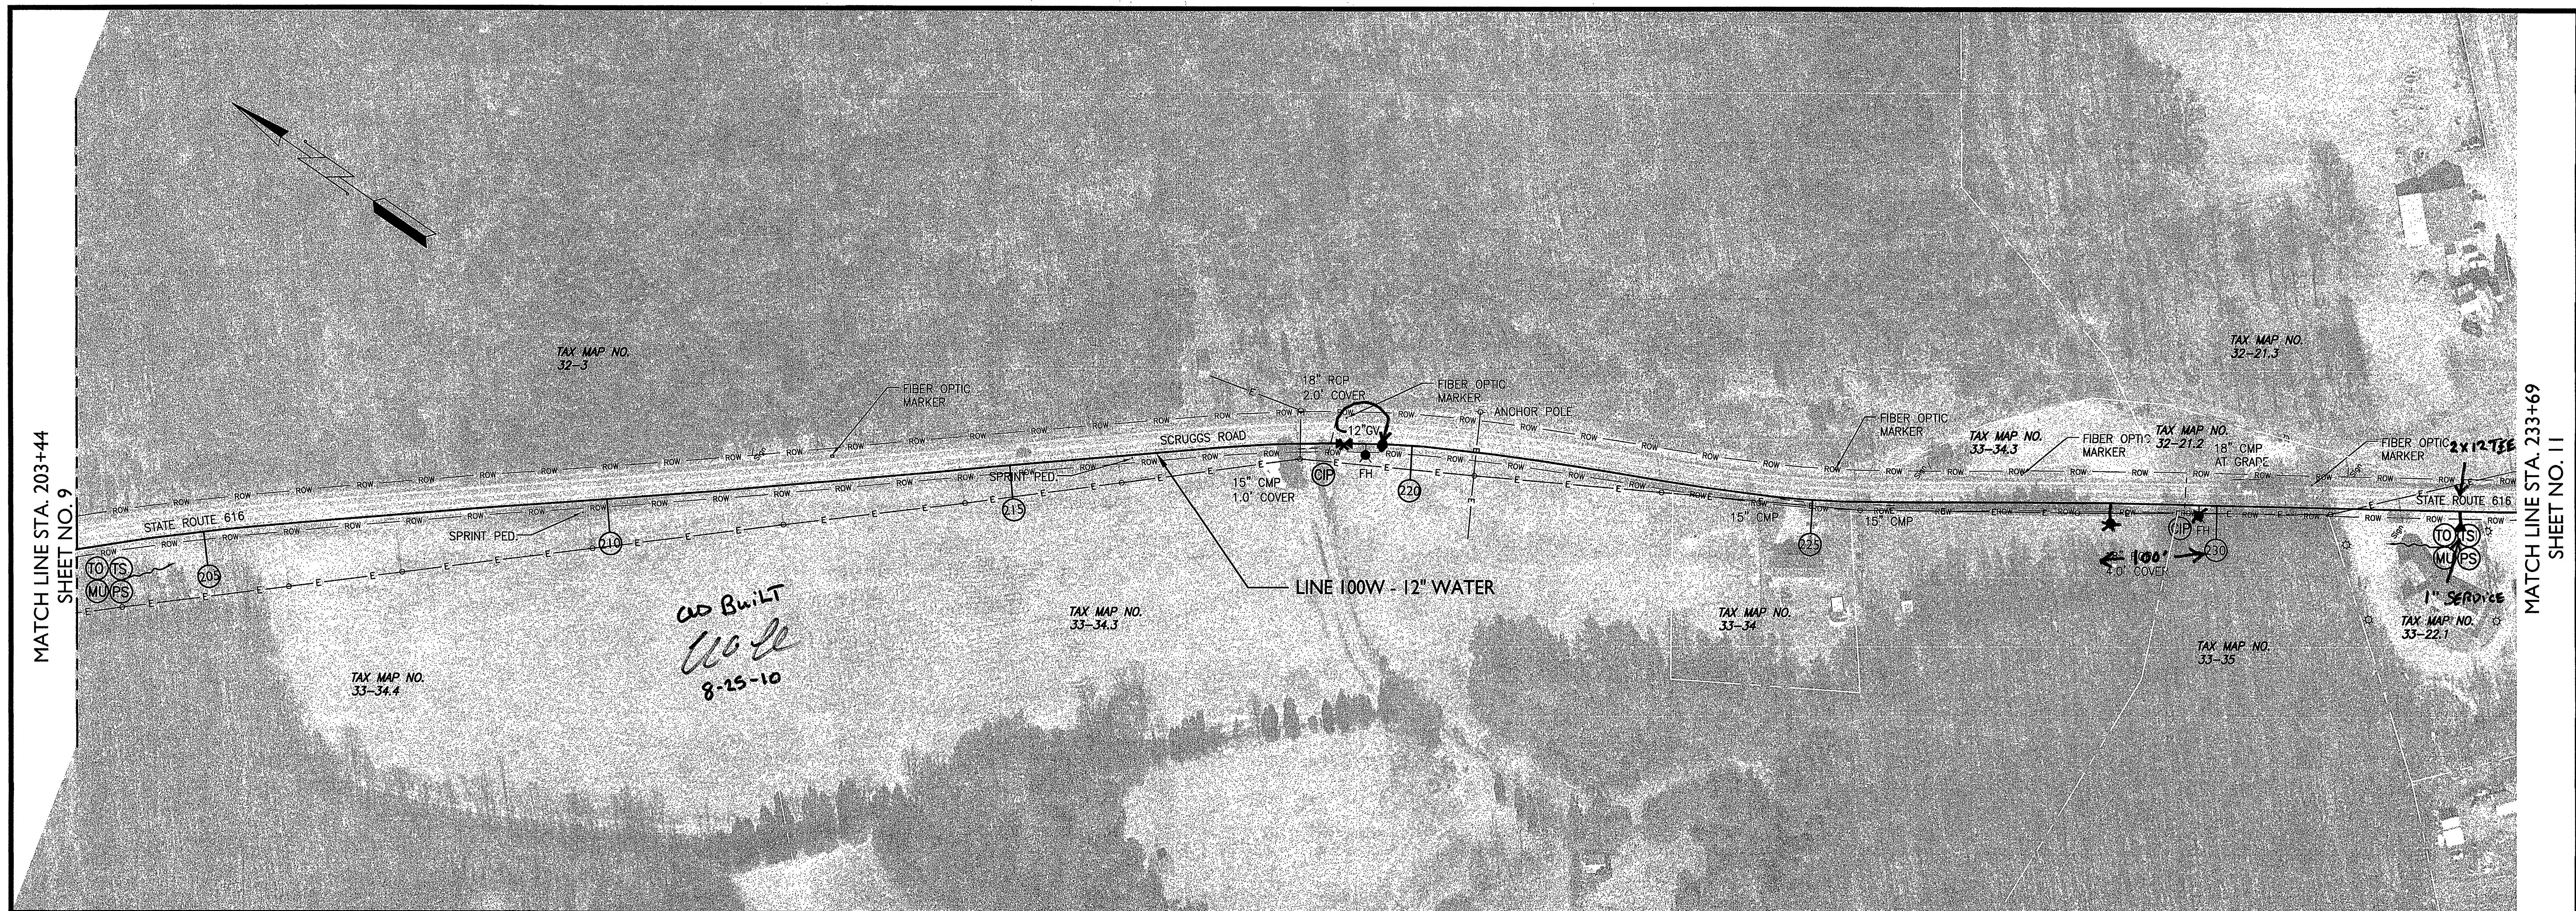


STATE ROUTE 616 WATER LINE EXTENSION
FOR THE
FRANKLIN COUNTY BOARD OF SUPERVISORS
AND
WESTERN VIRGINIA WATER AUTHORITY

PLAN & PROFILE - LINE 100W

No.	Date	Purpose of Document Issue
07/02/09	REVIEW DOCUMENTS ISSUED	
07/22/09	FINAL DOCUMENTS ISSUED	

Designed	<i>[Signature]</i>
Drawn	<i>[Signature]</i>
Checked	
Date	JULY 2009
File No.	WATER LINE PLANS

Project No.
9343-02

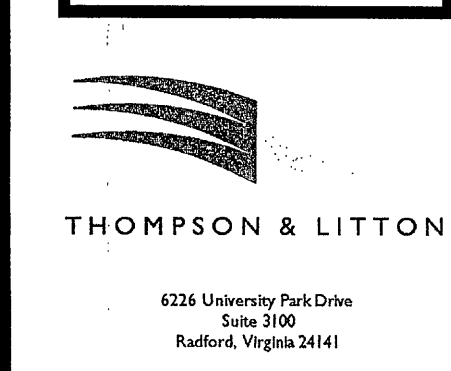

Sheet No.
10